
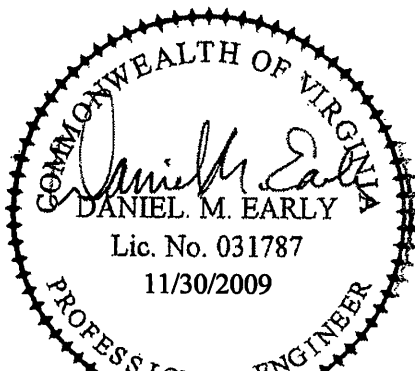


1	2	3	4	5	6	7	8	9	10	11	12	13	14
St. No.	Street	Suffix	Year Built	Foundation Type	First Floor FFE (at door threshold)	Basement Floor Elev (approx)	Elev at Wye on Main	Cleanout Invt Elev @ easement	Private Service Length	Service Entrance Elev (approx)	Elevation Change (7-11)	Basement Service Yes/No	Comments
1	1903	Barrington	DR	1954	Full Bsm	1110.55	1102.60	1101.33	1101.53	89.51	1102.43	13.00	NO
2	1915	Barrington	DR	1955	Full Bsm	1113.59	1105.59	1102.01	1102.21	91.00	1103.12	2.47	NO
3	1921	Barrington	DR	1953	Full Bsm	1114.24	1108.24	1102.55	1102.70	73.80	1103.44	2.80	NO
4	1927	Barrington	DR	1954	Full Bsm	1114.70	1103.70	1103.39	1103.54	73.62	1104.28	3.30	YES
5	1933	Barrington	DR	1956	Full Bsm	1117.66	1109.66	1104.46	1104.61	72.43	1105.33	4.33	YES
6	1939	Barrington	DR	1954	3/4 Bsm	1117.81	1109.81	1105.60	1105.75	65.39	1106.40	3.41	YES
7	1945	Barrington	DR	1956	3/4 Bsm	1117.95	1109.95	1103.75	1103.90	73.00	1107.63	3.20	YES
8	3710	Cove	RD	1955	Full Bsm	1121.21	1113.21	1107.90	1108.11	70.25	1108.81	4.40	YES
9	1903	Fairhope	RD	1953	Full Bsm	1109.84	1101.84	1102.86	1103.69	51.46	1104.20	-2.36	NO
10	1904	Fairhope	RD	1958	Full Bsm	1105.26	1097.26	1101.31	1101.46	75.40	1102.21	-4.95	NO
11	1906	Fairhope	RD	1958	Full Bsm	1107.84	1099.84	1102.33	1102.41	20.57	1102.62	-2.78	NO
12	1909	Fairhope	RD	1953	Full Bsm	1110.64	1102.64	1102.86	1102.98	36.20	1103.34	-0.70	NO
13	1915	Fairhope	RD	1952	Full Bsm	1111.14	1103.14	1103.13	1103.23	32.05	1103.55	-0.41	NO
14	1916	Fairhope	RD	1955	Full Bsm	1107.98	1099.98	1102.35	1102.42	18.00	1102.60	-2.62	NO
15	1921	Fairhope	RD	1958	Full Bsm	1109.97	1101.97	1103.16	1103.31	44.44	1103.75	-1.78	NO
16	1922	Fairhope	RD	1958	Full Bsm	1108.41	1100.41	1102.34	1102.46	91.67	1103.38	-2.97	NO
17	1927	Fairhope	RD	1954	Full Bsm	1112.71	1104.71	1103.45	1103.60	47.67	1104.08	0.63	NO
18	1928	Fairhope	RD	1955	Full Bsm	1110.55	1102.55	1103.35	1103.50	90.81	1104.46	-1.91	NO
19	1933	Fairhope	RD	1947	Full Bsm	1113.36	1105.36	1103.74	1103.89	45.91	1104.35	1.01	NO
20	1934	Fairhope	RD	1954	Full Bsm	1114.27	1106.27	1104.50	1104.70	90.29	1105.60	0.67	NO
21	1939	Fairhope	RD	1956	Full Bsm	1113.65	1105.65	1104.86	1104.94	21.94	1105.16	0.49	NO
22	1942	Fairhope	RD	1955	Full Bsm	1117.55	1109.55	1105.64	1105.84	88.18	1106.73	3.90	YES
23	1945	Fairhope	RD	1958	Full Bsm	1117.31	1109.31	1104.87	1104.94	11.88	1105.05	4.25	YES
24	1946	Fairhope	RD	1958	Full Bsm	1118.65	1110.65	1106.72	1106.92	89.46	1107.81	3.70	YES
25	1951	Fairhope	RD	1958	Full Bsm	1120.12	1112.12	1107.07	1107.22	55.82	1107.78	4.34	YES
26	1952	Fairhope	RD	1958	Full Bsm	1121.23	1113.23	1107.90	1108.08	87.49	1108.95	4.28	YES
27	1957	Fairhope	RD	1955	3/4 Bsm	1120.86	1112.86	1109.80	1109.91	32.32	1110.23	3.06	YES
28	2002	Lancaster	DR	1950	Full Bsm	1125.50	1117.50	1113.00	1113.00	68.21	1113.65	3.84	YES
29	2212	Lancaster	DR	1957	Full Crawl	1128.45	1106.41	1118.00	1118.00	55.91	1118.55	N/A	Assume 2.0' below grade, 19' from SW corner at rear of house

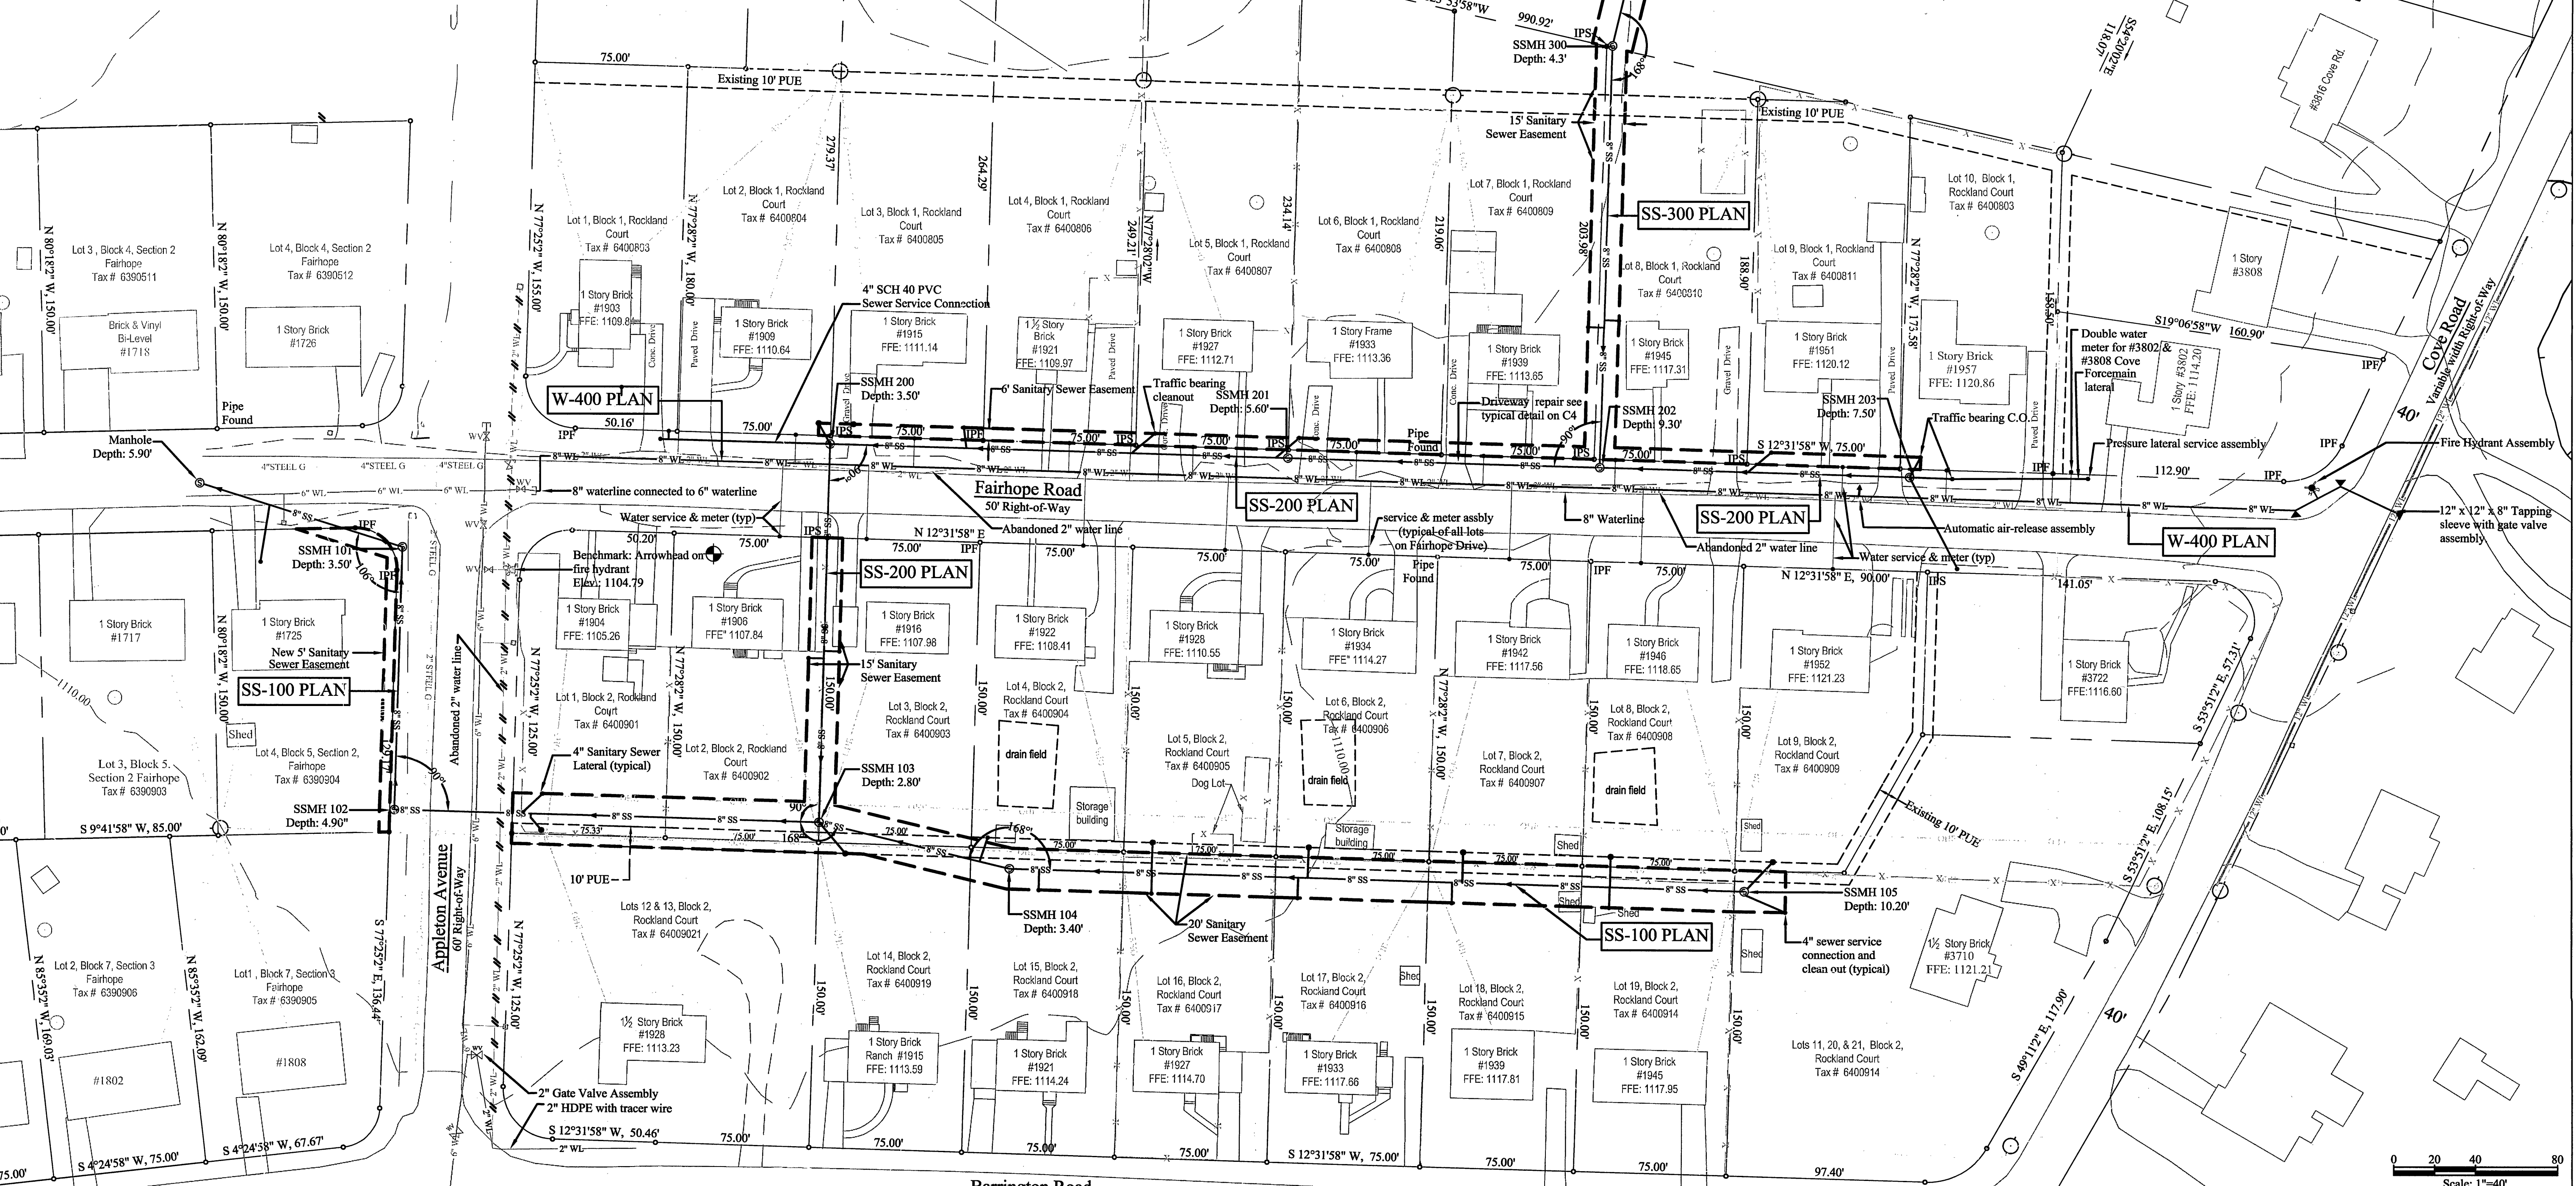

ACS DESIGN
 ENGINEERING • SURVEYING
 LANDSCAPE ARCHITECTURE
 CONSTRUCTION MANAGEMENT

2203 PETERS CREEK ROAD
 ROANOKE, VIRGINIA 24017
 P 540.562.2345 F 562.2344
 INFO@ACSDSIGNLLC.COM
 WWW.ACSDSIGNLLC.COM

**Fairhope Road Sewer Extension
 Record Drawing**
 Western Virginia Water Authority
 City of Roanoke, Virginia

© ACS DESIGN, LLC - Material included herein is covered by copyright. Use of this work in whole or in part is strictly forbidden without the expressed written consent of ACS DESIGN, LLC.

DRAWN BY: KMF
 DESIGNED BY: DME
 CHECKED BY:
 DATE: 30 NOVEMBER 2009
 JOB NUMBER: 07248C

REVISIONS:
No. 1
No. 2
No. 3
No. 4

SHEET NO.:

C2

UTILITY PLAN

RECORD DRAWING

1:07/27/2009 Fairhope Additional Services/07/27/2009 RECORD DWG C2/4/09, C2 Plan, 12/4/2009 11:06:31 AM KPMK, 11, ACS Design, LLC