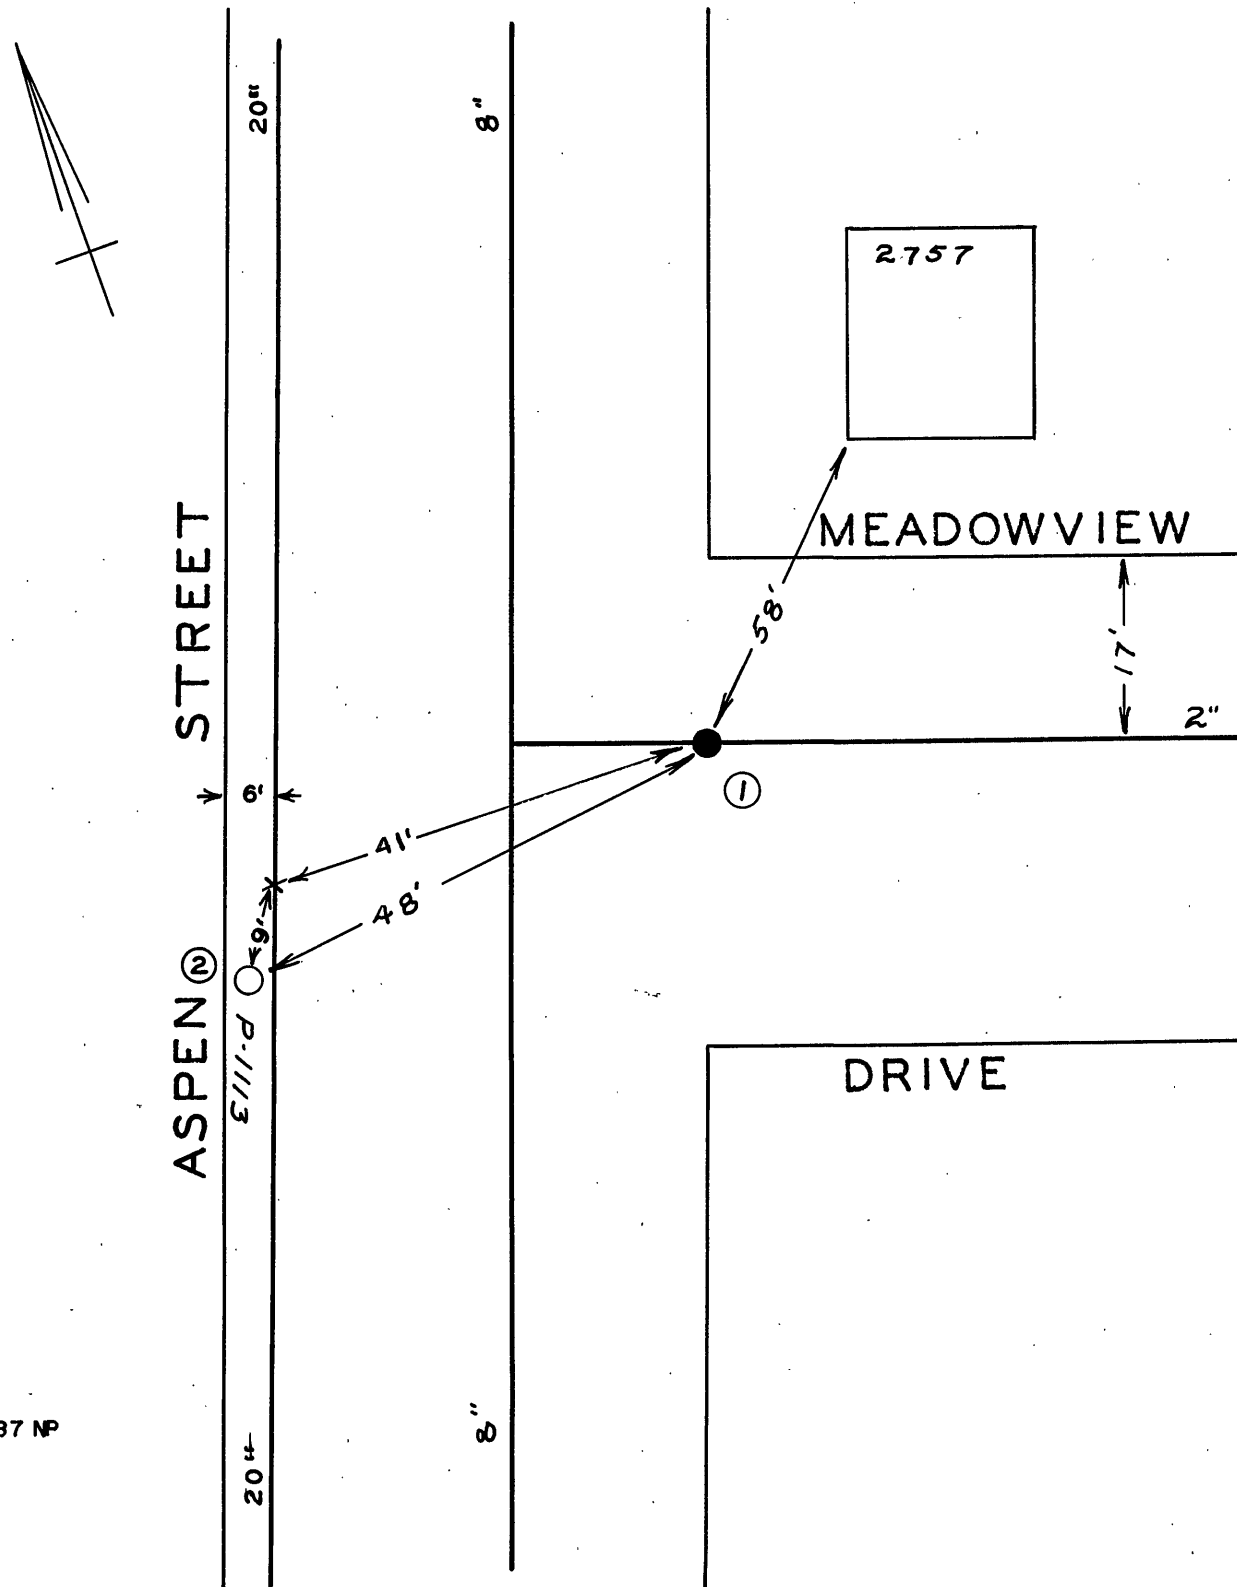


2/87 NP

[illegible]

CITY OF ROANOKE — WATER DEPT.	
VALVE DIAGRAM	
ASPEN STREET &	
MEADOWVIEW DRIVE N.W.	
SEC. MAP	247
DATE	PAGE NO.