


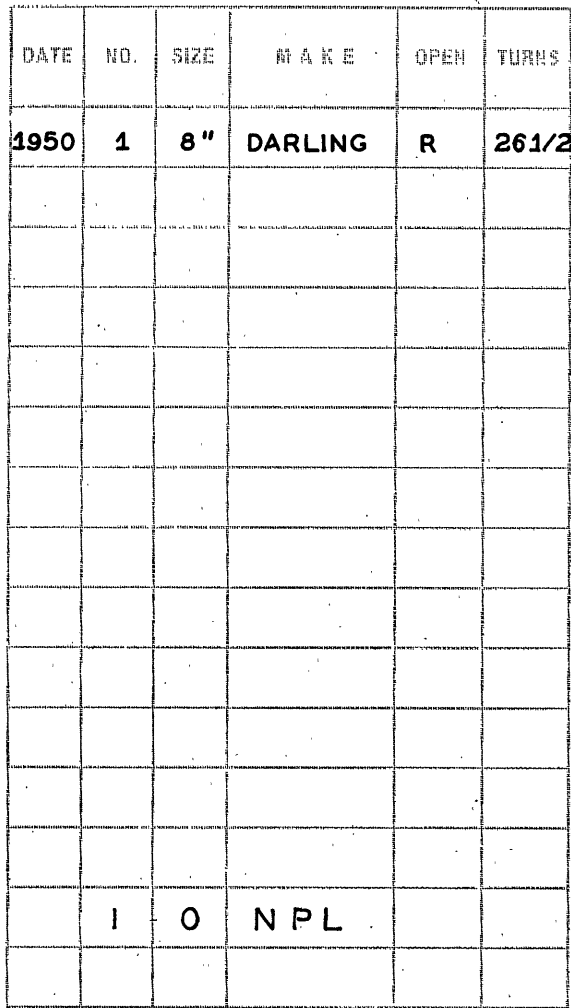

PAGE NO. N.W. 336