


SUMMARY OF QUANTITIES				
ITEM	UNIT	QUANTITY		AS BUILT
		ACTUAL	PROPOSAL	
<u>DIVISION I</u>				
8" PIPE IN PLACE COMPLETE	L.F.	7636	8399	7446.4
6" PIPE IN PLACE COMPLETE	L.F.	2,336	2,570	2286.5
MANHOLES, VIRGINIA DEPARTMENT OF HIGHWAYS STD. & CITY OF ROANOKE STANDARD DROP				
REGULAR - VA. DEPT. OF HWYS. STD. MH-2	EA.	46	46	47
DROP - CITY OF ROANOKE	EA.	2	2	1
8" DUCTILE IRON PIPE IN PLACE COMPLETE	L.F.	570	627	583.4
WYES, 45°-8"x6" IN PLACE COMPLETE	EA.	55	55	60
<u>DIVISION II</u>				
8" PIPE IN PLACE COMPLETE	L.F.	1,035	1,140	954.4
6" PIPE IN PLACE COMPLETE	L.F.	900	990	483
MANHOLES, VIRGINIA DEPARTMENT OF HIGHWAYS STD. MH-2	EA.	5	5	5
WYES, 45°-8"x6" IN PLACE COMPLETE	EA.	15	15	15
<u>DIVISION I</u>				
12"x12" REINFORCED CONCRETE PIERS IN PLACE COMPLETE	EA.	8	8	9

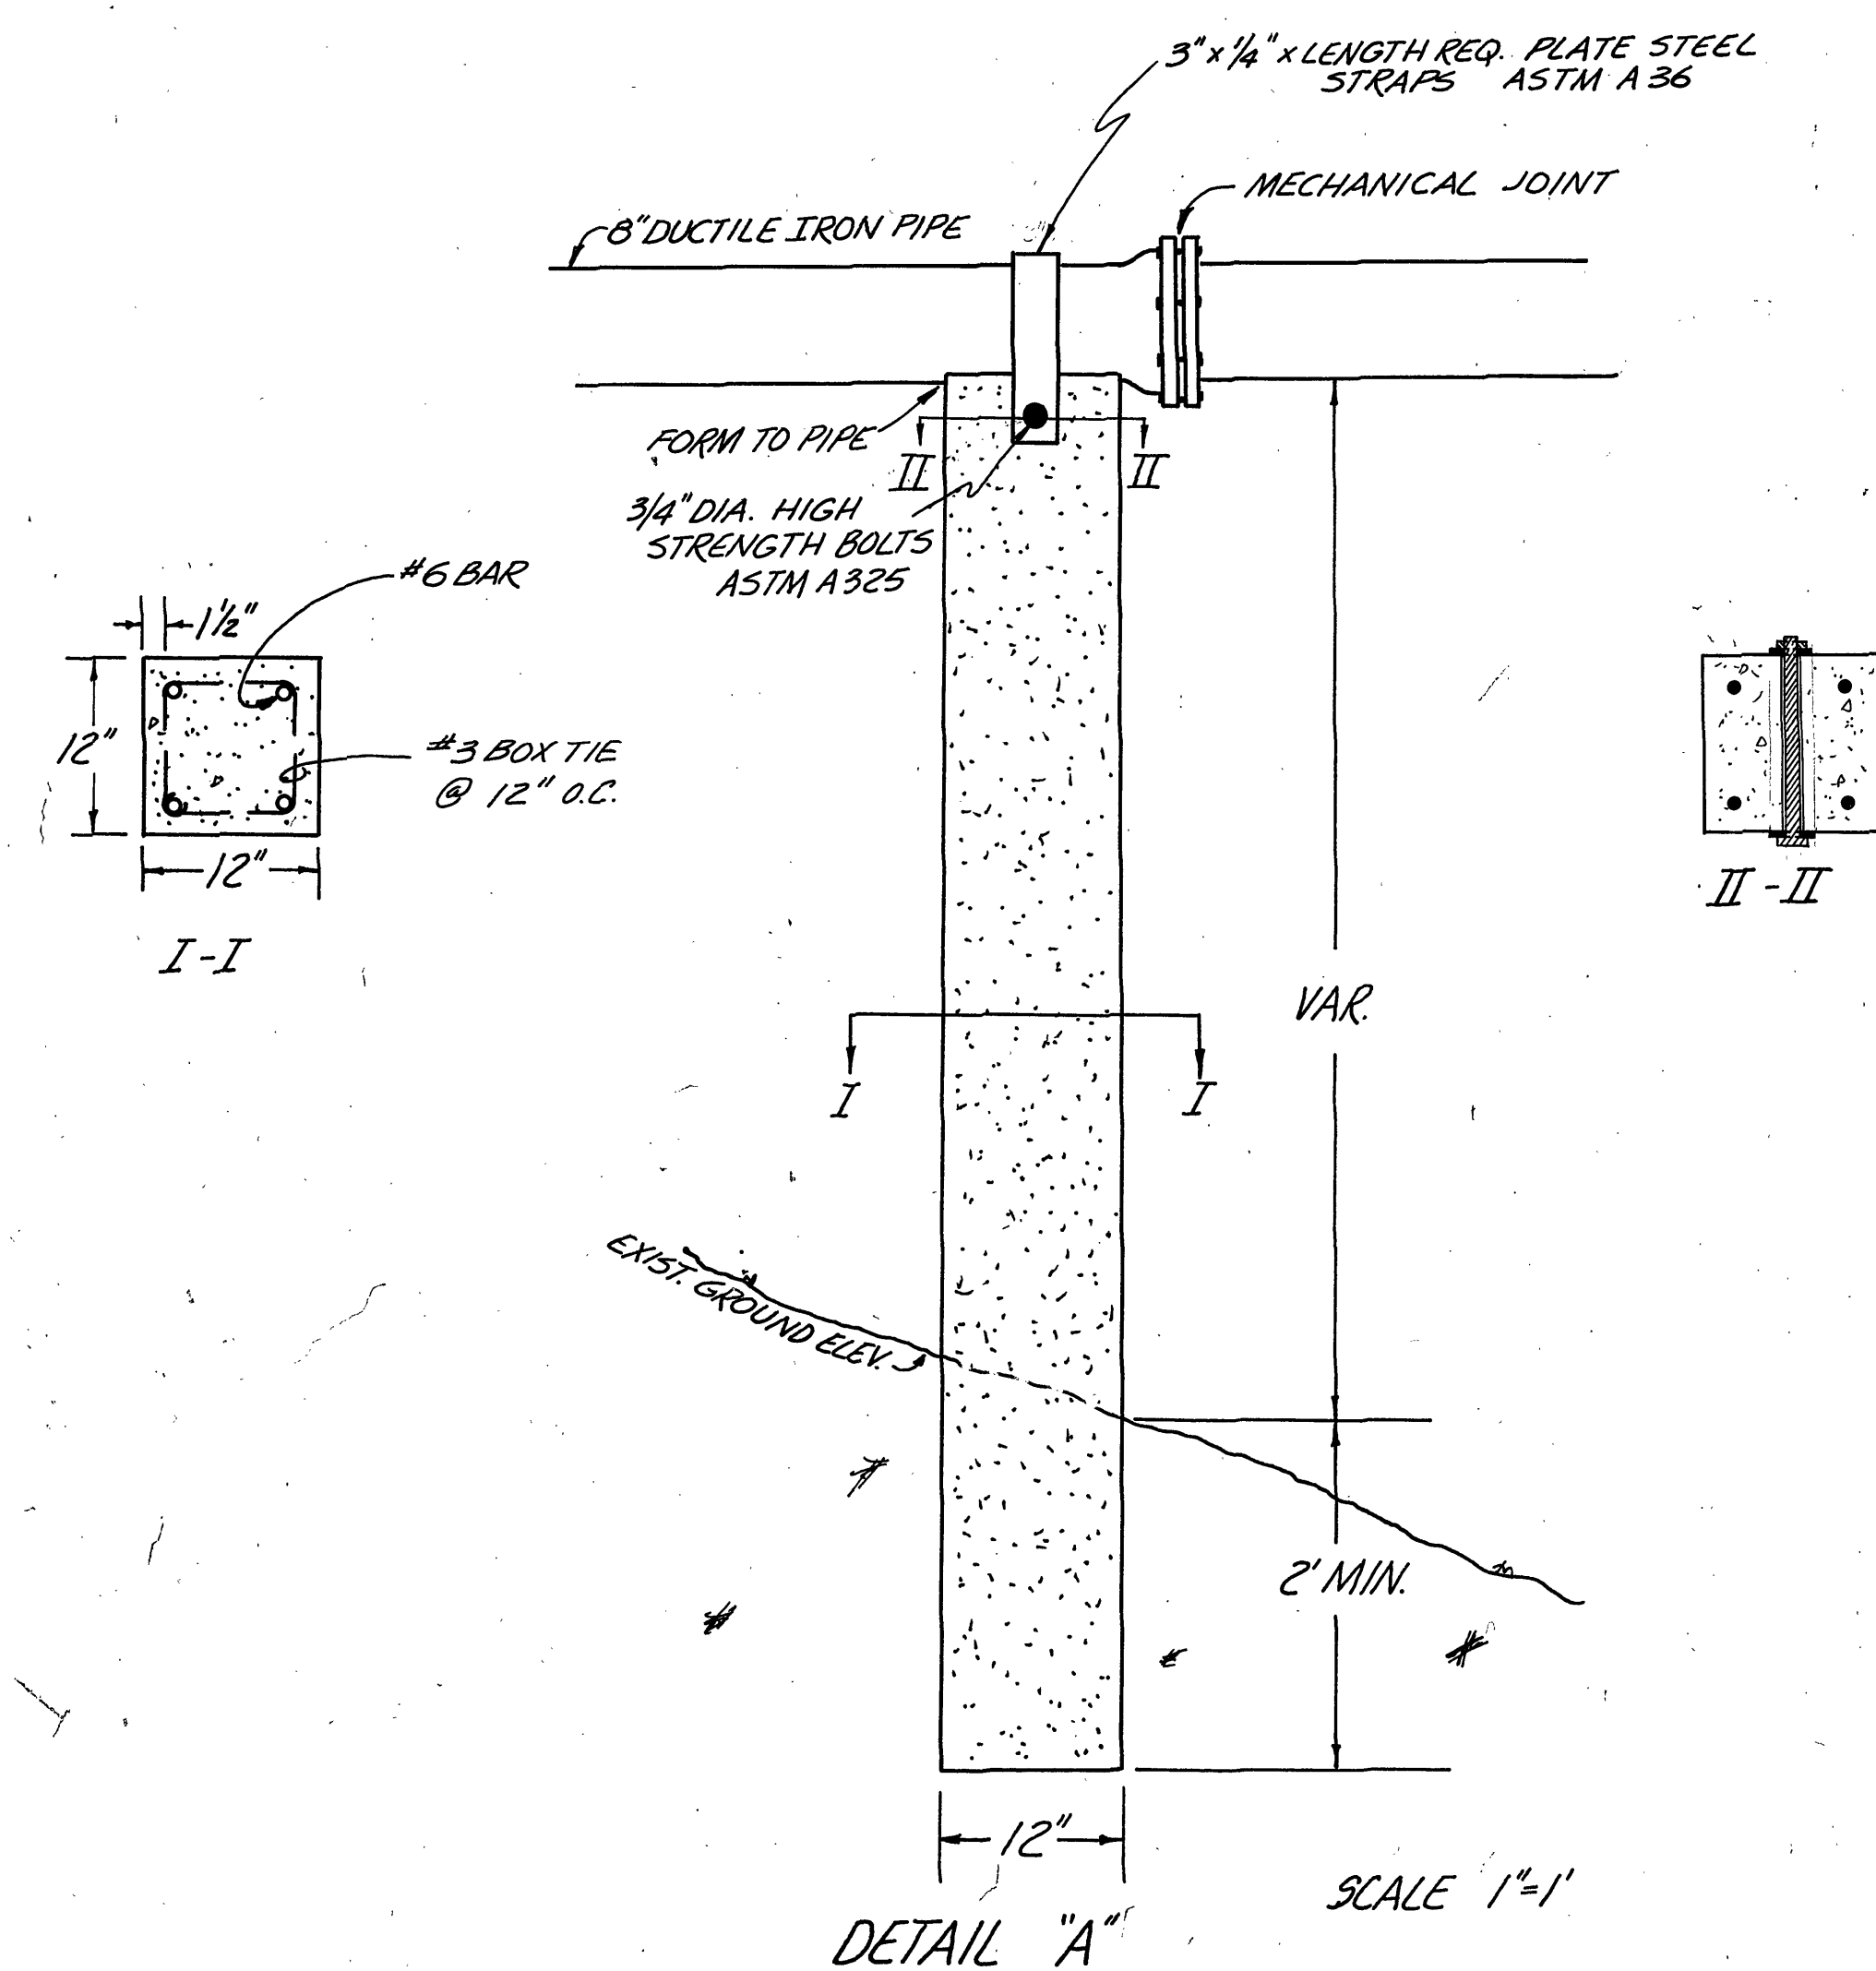

AS BUILT