


REVISED	FHWA REGION	STATE	FEDERAL AID PROJECT	ROUTE	STATE PROJECT	SHEET NO.
	3	VA.				

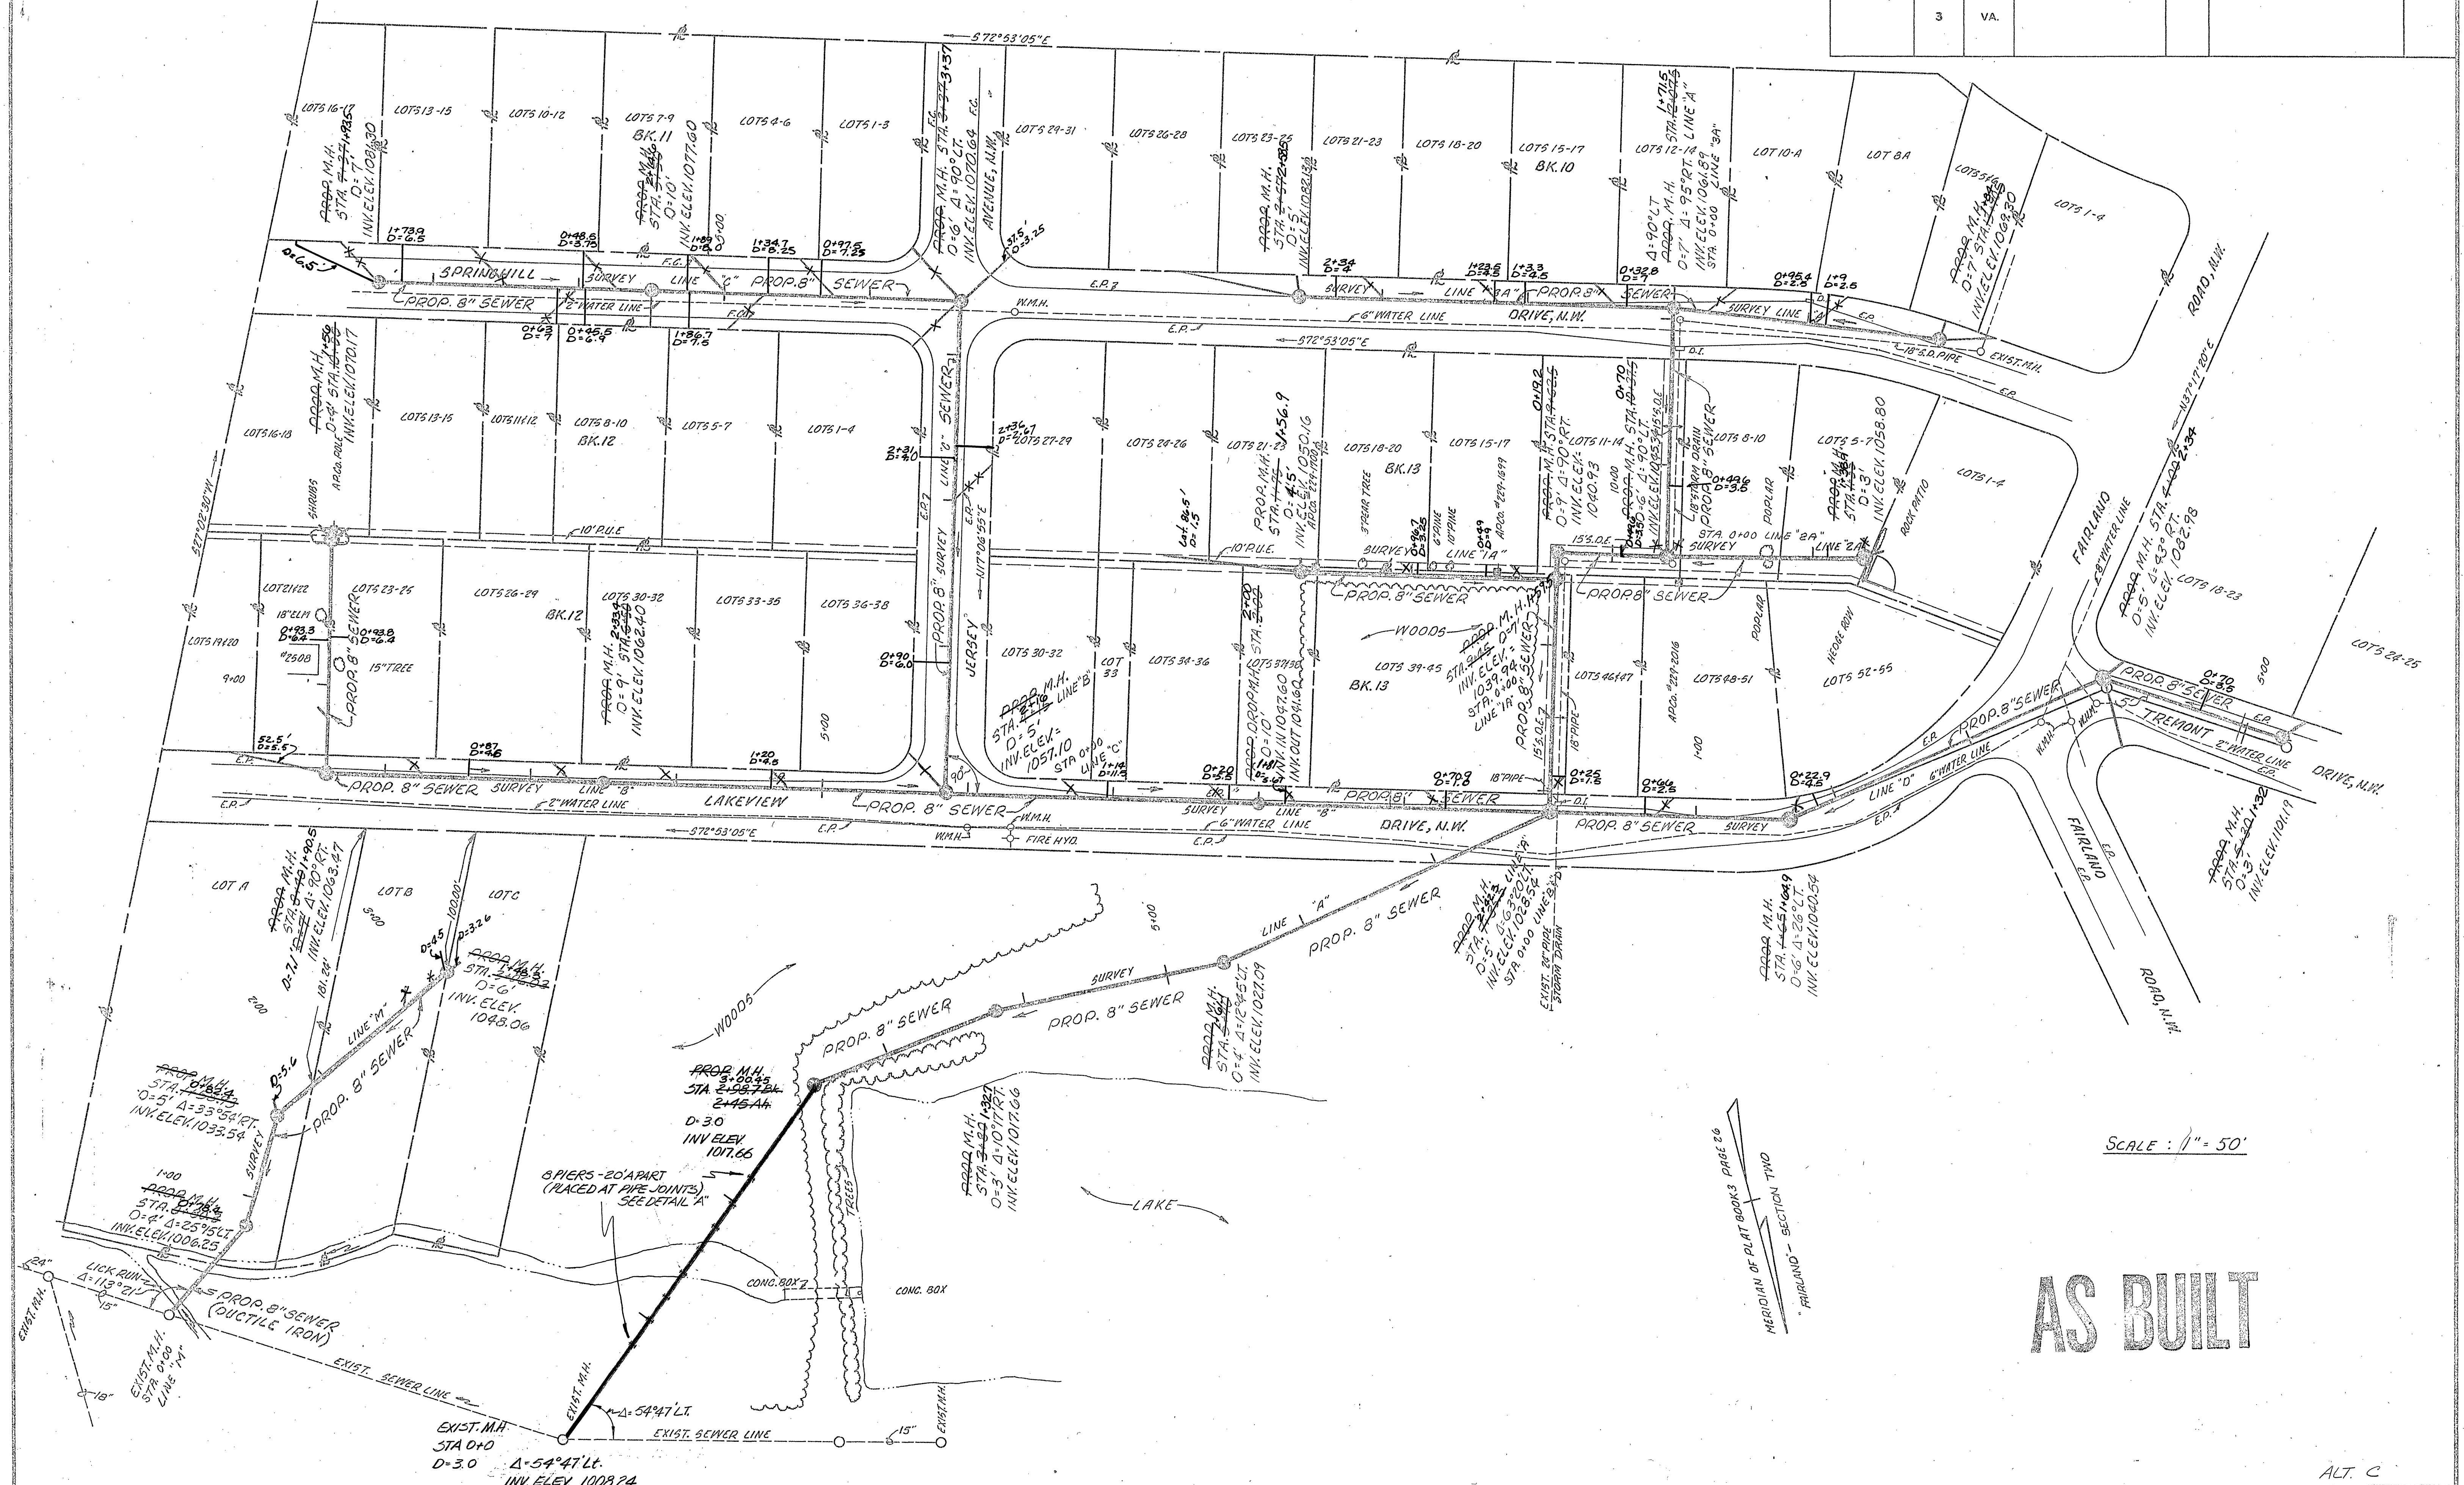

SCALE: 1" = 50'

AS BUILT

ALT. C

PLAN NO.	PROJECT	FILE NO.	SHEET NO.
A 5448-75			3 OF 9