


PROJECT NO. 73-1-S

AUTHORITY MEMBERS

L.S.	WALDROP	CHAIRMAN
F.R.	ANGELL	VICE CHAIRMAN
E.G.	BOWMAN	
R.H.	RICHARDSON	
B.W.	MAHONEY	

J.A. BEAVERS EXECUTIVE DIRECTOR

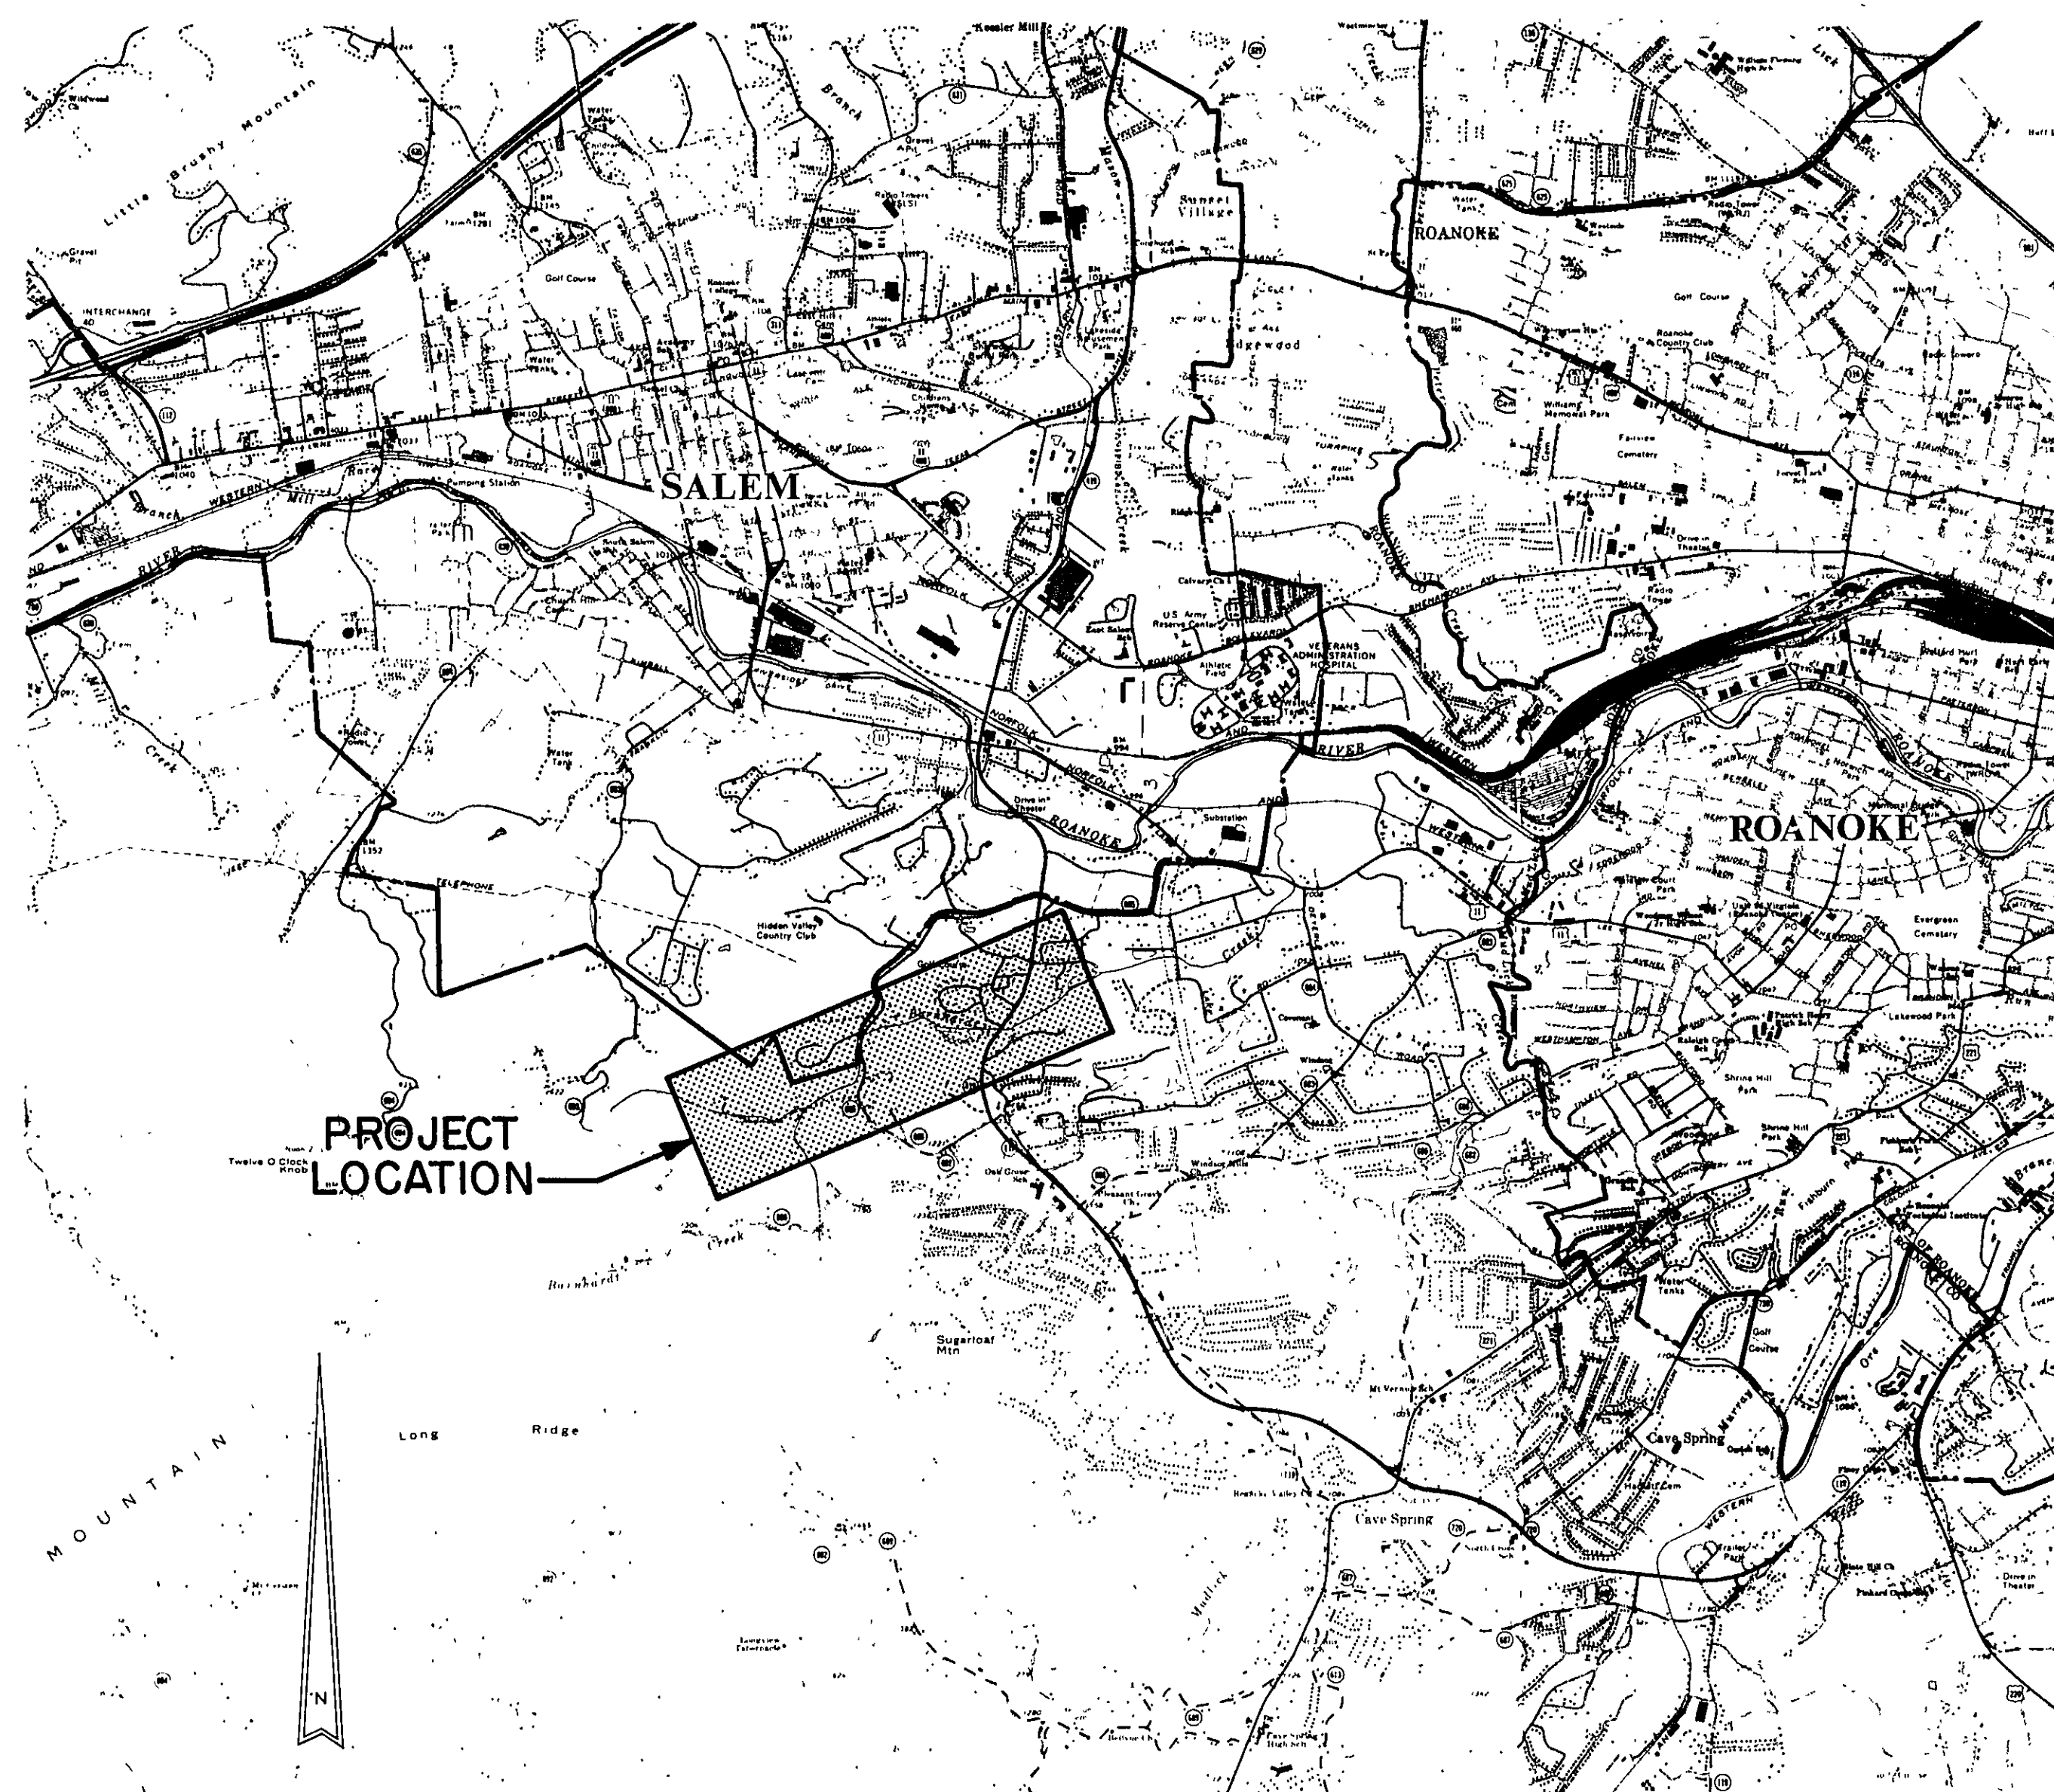

LEGEND

- | | |
|---|-----------------------------|
|  | SURVEY BASE LINE |
|  | PROPERTY LINE |
|  | EDGE OF PAVEMENT |
|  | EXISTING SANITARY SEWER |
|  | PROPOSED SANITARY SEWER |
|  | EXISTING MANHOLE |
|  | PROPOSED MANHOLE |
|  | PROPOSED CLEANOUT |
|  | PROPOSED METERING STATION |
|  | WATER MAIN |
|  | GAS LINE |
|  | ELECTRIC CABLE OR CONDUIT |
|  | TELEPHONE CABLE OR CONDUIT |
|  | RAILROAD TRACKS |
|  | DITCH |
|  | STREAM |
|  | FENCE |
|  | FIRE HYDRANT |
|  | POWER POLE |
|  | TELEPHONE POLE AND GUY WIRE |
|  | VALVE VAULT |
|  | WATER METER |
|  | TREE |
|  | SHRUB |
|  | HEDGE |
|  | ROCK OR STONE WALL |
|  | EXISTING GROUND |

S C H E D U L E , O F D R A W I N G S

<u>SHEET</u>	<u>TITLE</u>	<u>STATION</u>
1.	FAIRWAY FOREST INTERCEPTOR	0+00 — 9+00
2.	FAIRWAY FOREST INTERCEPTOR	9+00 — 24+00
3.	FAIRWAY FOREST INTERCEPTOR	24+00 — 39+00
4.	FAIRWAY FOREST INTERCEPTOR	39+00 — 54+00
5.	FAIRWAY FOREST INTERCEPTOR	54+00 — 65+68
6.	DETAILS	

SUMMARY OF QUANTITIES

[illegible]

SANITARY SEWERAGE SYSTEM **FAIRWAY FOREST INTERCEPTOR**

LANGLEY, McDONALD AND OVERMAN
CONSULTING ENGINEERS
NORFOLK, VIRGINIA

