
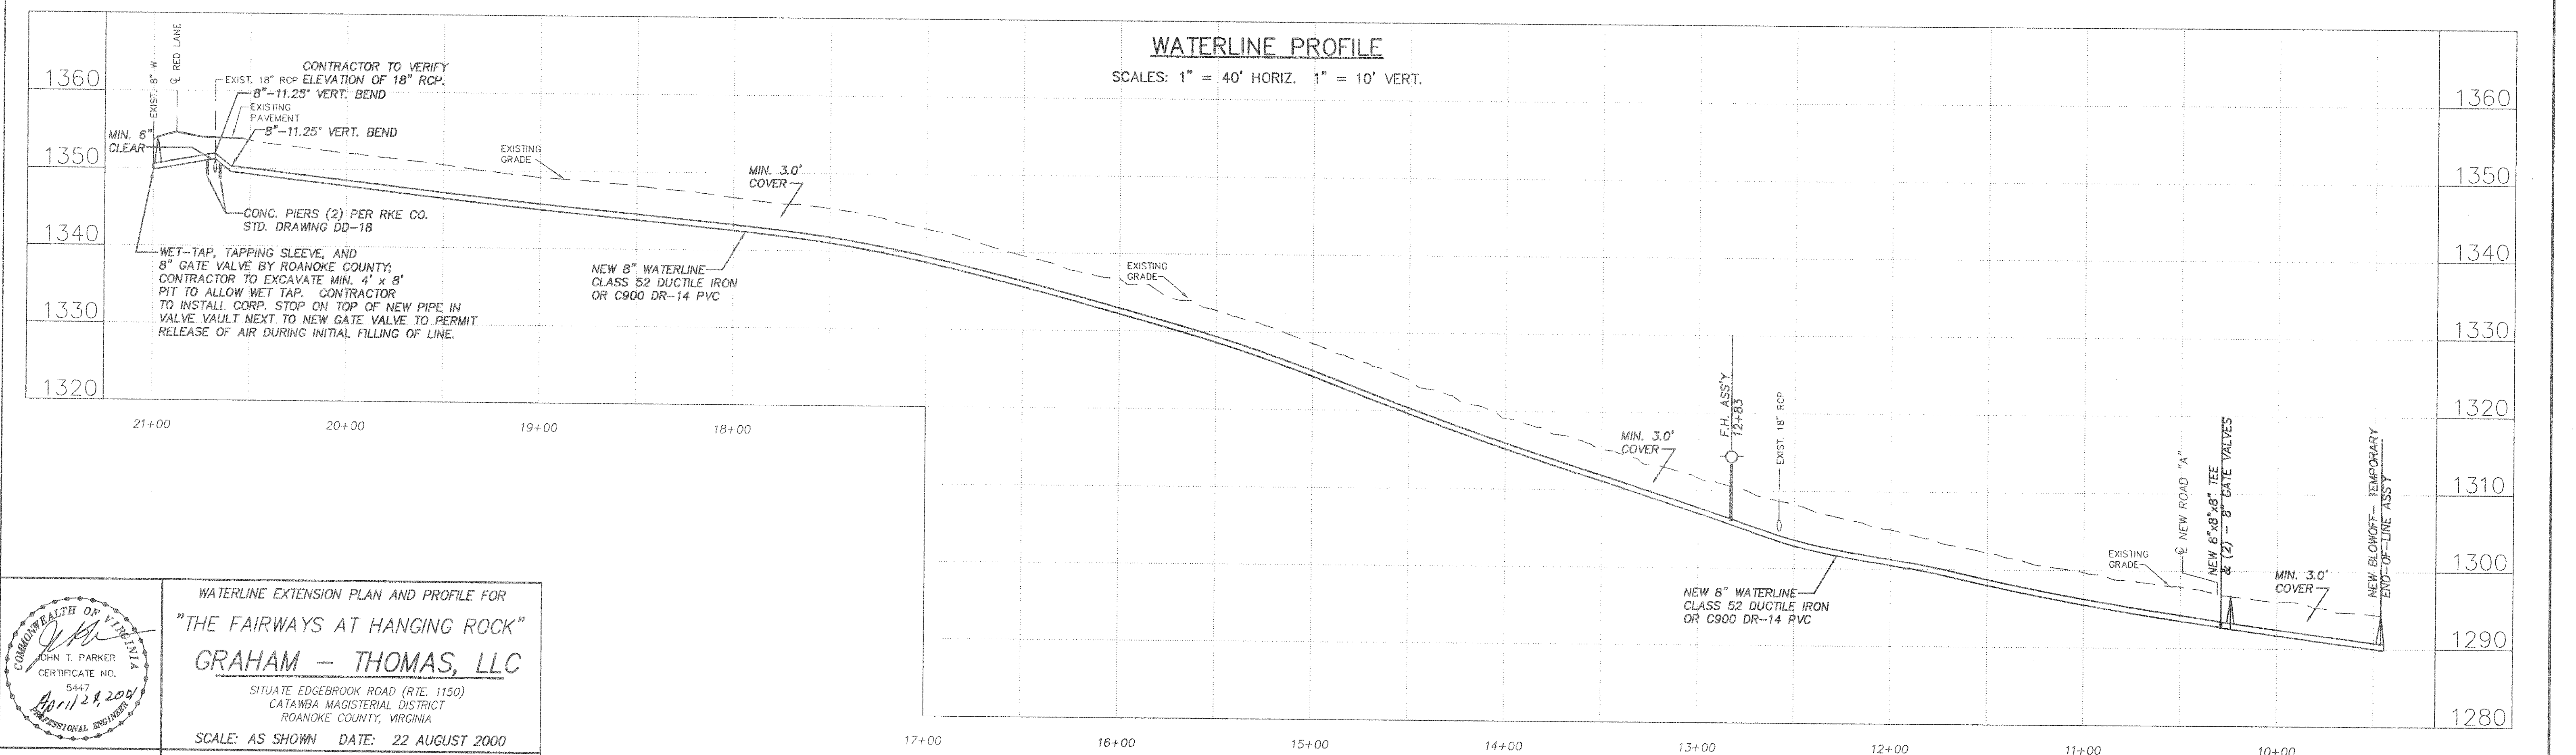


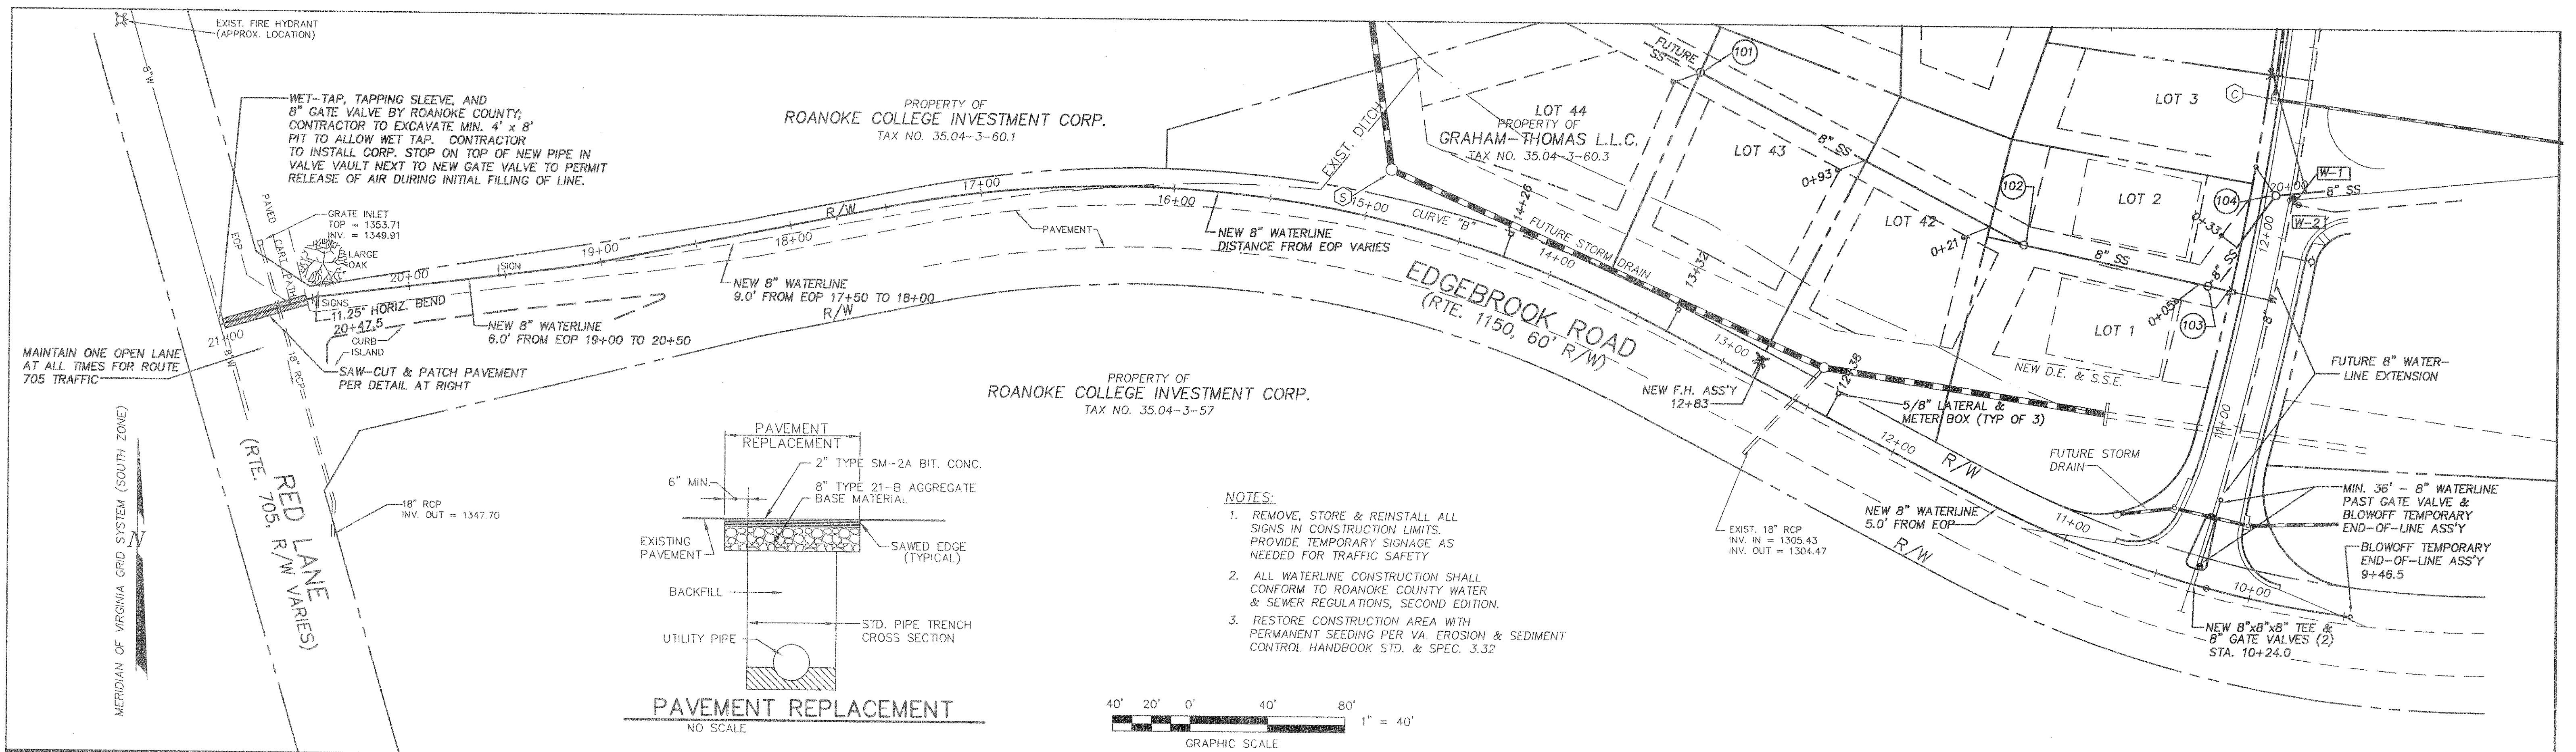

DESIGNED BY J.M. SCHULTHEIS  
DRAWN BY J.M.S.  
CHECKED BY J.T.P.  
W.O. # 99-1338  
N.B. JR-43, F-64  
TAX NO. 35.04-03-60.3

**WATERLINE EXTENSION PLAN AND PROFILE FOR**  
**"THE FAIRWAYS AT HANGING ROCK"**  
**GRAHAM - THOMAS, LLC**  
SITUATE EDGEBROOK ROAD (RTE. 1150)  
CATANBA MAGISTERIAL DISTRICT  
ROANOKE COUNTY, VIRGINIA  
SCALE: AS SHOWN DATE: 22 AUGUST 2000

**T. P. PARKER & SON**  
818 Boulevard  
Post Office Box 39  
Salem, Virginia 24153  
Telephone: 540-387-1153  
FAX: 540-388-6787

**TPP&S**  
ENGINEERS  
SURVEYORS  
PLANNERS

12/20/01 AS BUILT PLANS FOR WATER AND SEWER CONSTRUCTION BASED UPON INFORMATION PROVIDED BY THE CONTRACTOR