


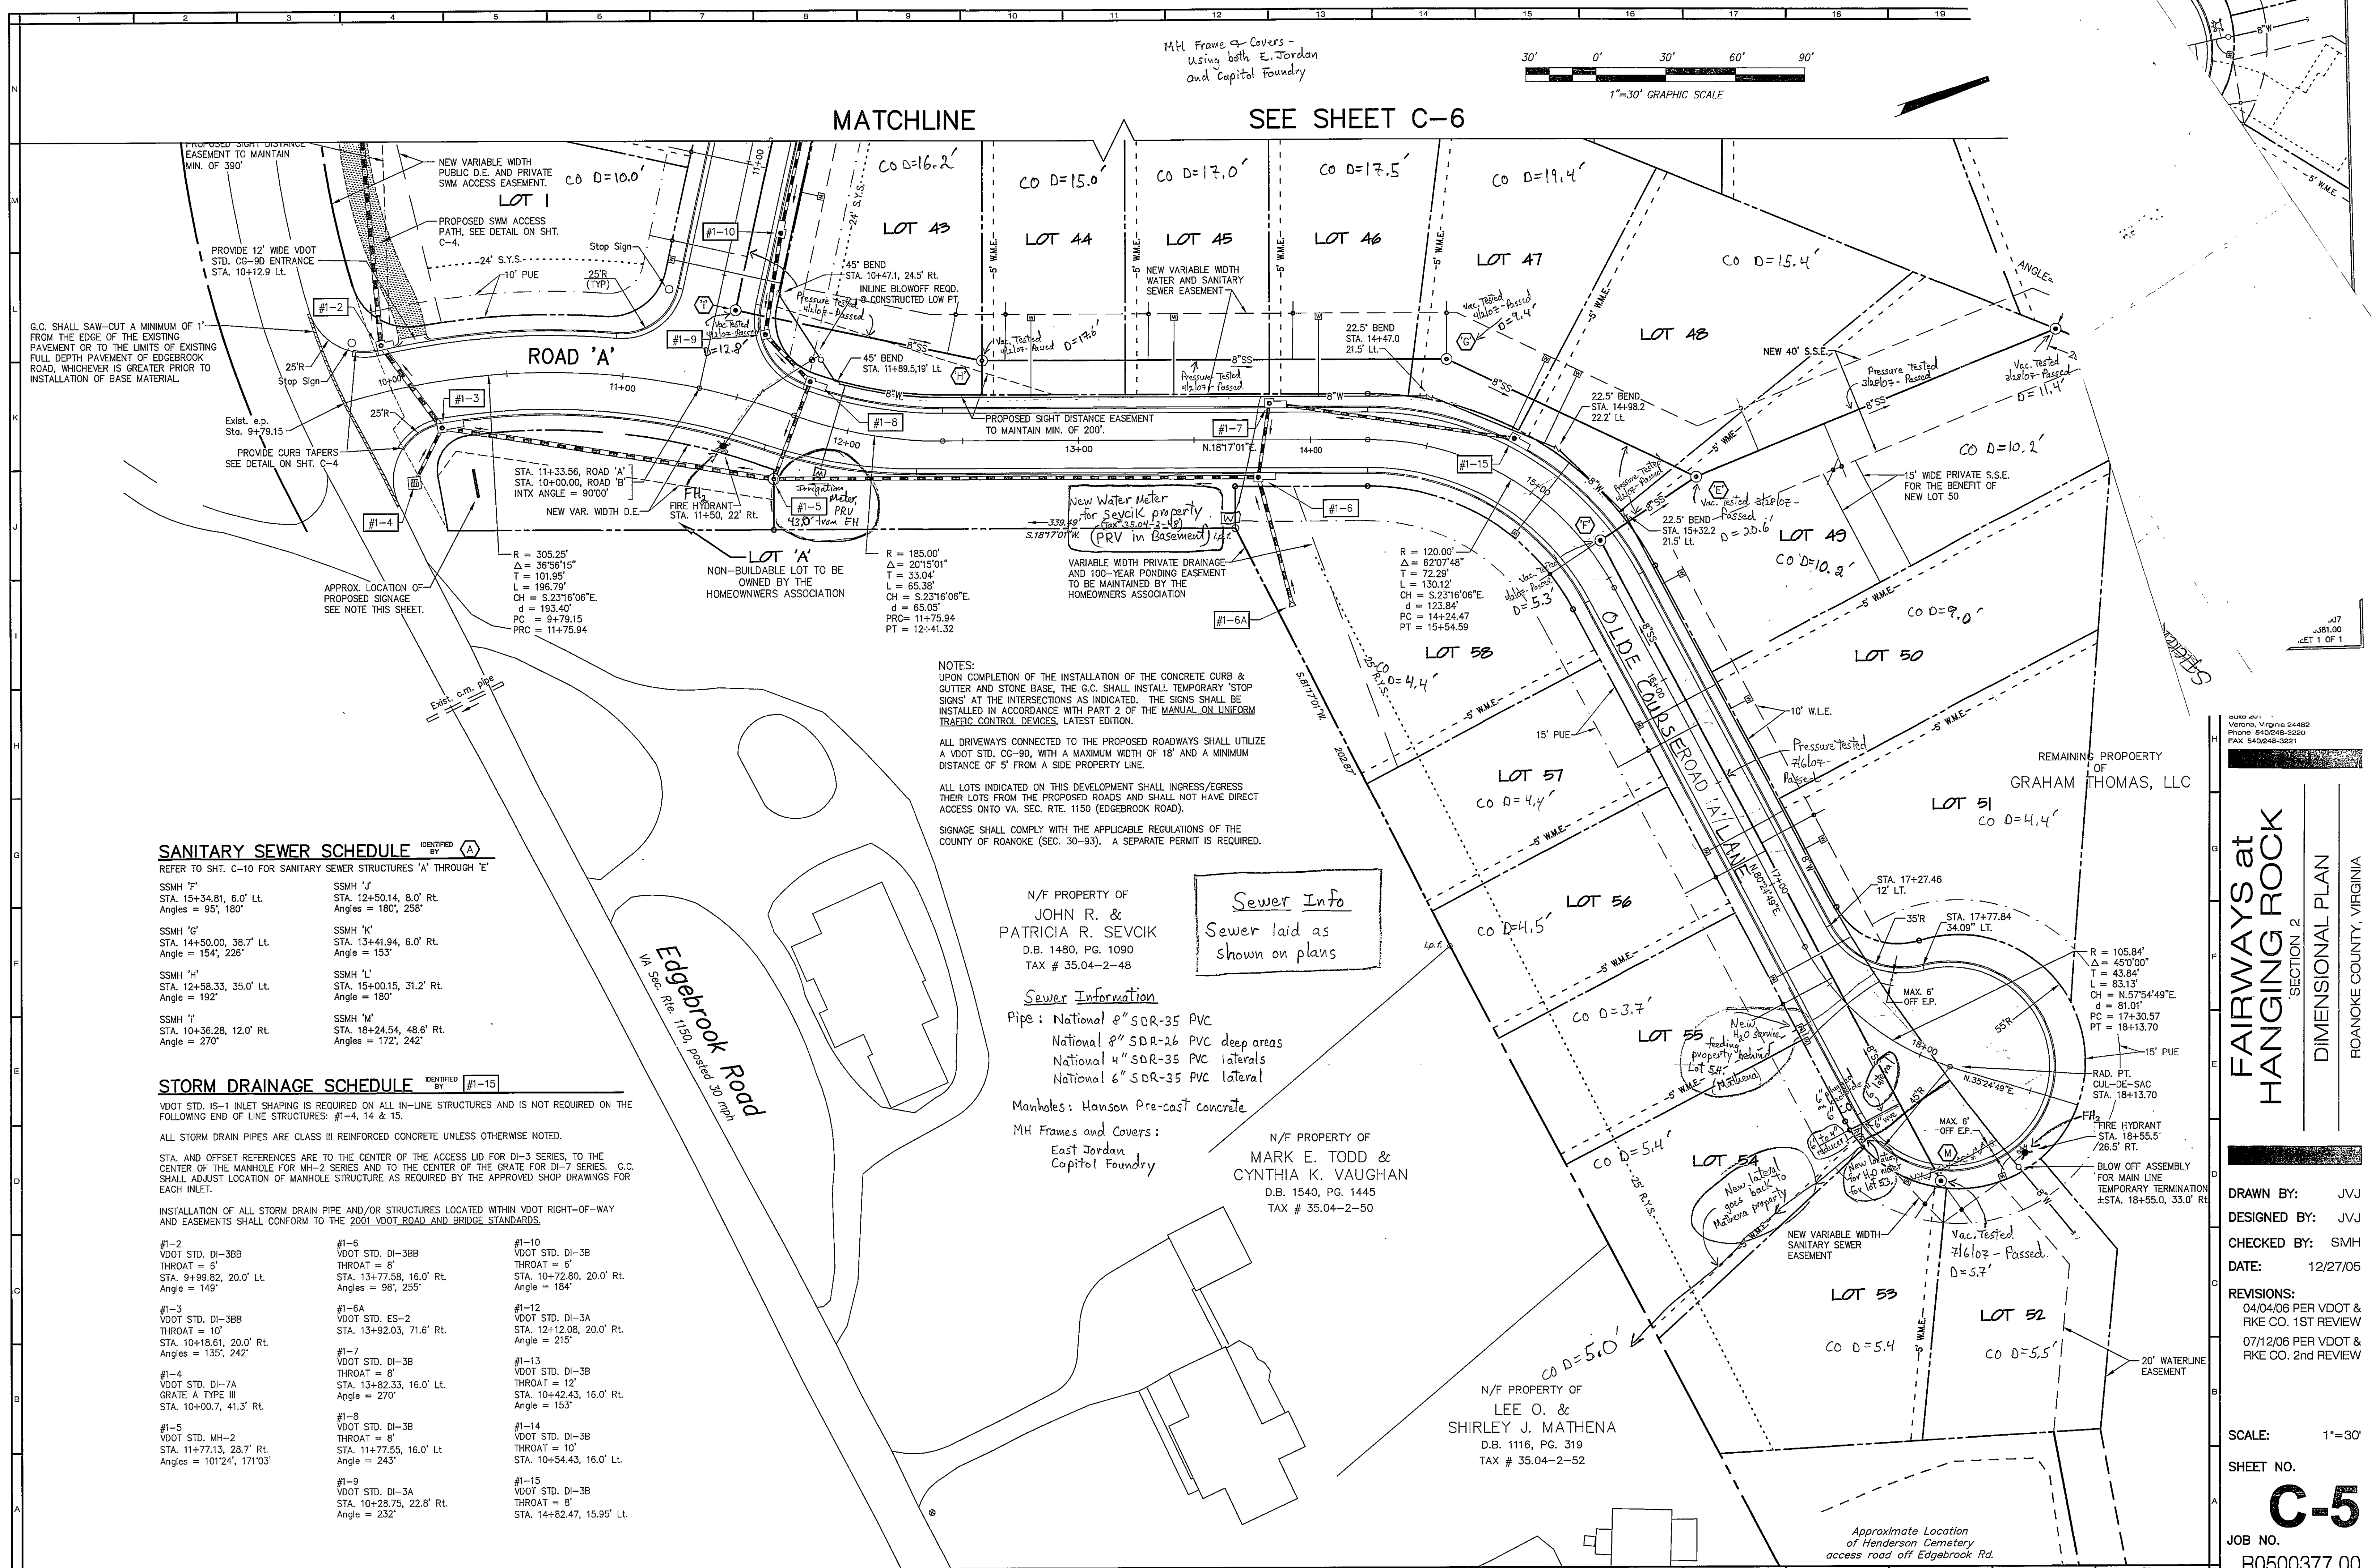

SANITARY SEWER SCHEDULE IDENTIFIED BY (A)

REFER TO SHT. C-10 FOR SANITARY SEWER STRUCTURES 'A' THROUGH 'E'

SSMH 'F' STA. 15+34.81, 6.0' LT. Angles = 95°, 180°	SSMH 'J' STA. 12+50.14, 8.0' RT. Angles = 180°, 258°
SSMH 'G' STA. 14+50.00, 38.7' LT. Angle = 154°, 226°	SSMH 'K' STA. 13+41.94, 6.0' RT. Angle = 153°
SSMH 'H' STA. 12+58.33, 35.0' LT. Angle = 192°	SSMH 'L' STA. 15+00.15, 31.2' RT. Angle = 180°
SSMH 'I' STA. 10+36.28, 12.0' RT. Angle = 270°	SSMH 'M' STA. 18+24.54, 48.6' RT. Angles = 172°, 242°

STORM DRAINAGE SCHEDULE IDENTIFIED BY (B)

VDOT STD. 15-1 INLET SHAPING IS REQUIRED ON ALL IN-LINE STRUCTURES AND IS NOT REQUIRED ON THE FOLLOWING END OF LINE STRUCTURES: #1-4, 14 & 15.

ALL STORM DRAIN PIPES ARE CLASS III REINFORCED CONCRETE UNLESS OTHERWISE NOTED.

STA. AND OFFSET REFERENCES ARE TO THE CENTER OF THE ACCESS LID FOR DI-3 SERIES, TO THE CENTER OF THE MANHOLE FOR MH-2 SERIES AND TO THE CENTER OF THE GRATE FOR DI-7 SERIES. G.C. SHALL ADJUST LOCATION OF MANHOLE STRUCTURE AS REQUIRED BY THE APPROVED SHOP DRAWINGS FOR EACH INLET.

INSTALLATION OF ALL STORM DRAIN PIPE AND/OR STRUCTURES LOCATED WITHIN VDOT RIGHT-OF-WAY AND EASEMENTS SHALL CONFORM TO THE 2001 VDOT ROAD AND BRIDGE STANDARDS.

#1-2 VDOT STD. DI-3BB THROAT = 6" STA. 9+99.82, 20.0' LT. Angle = 149°	#1-6A VDOT STD. ES-2 STA. 13+92.03, 71.6' RT. Angle = 270°	#1-10 VDOT STD. DI-3B THROAT = 6" STA. 10+72.80, 20.0' RT. Angle = 184°
#1-3 VDOT STD. DI-3BB THROAT = 10" STA. 10+18.61, 20.0' RT. Angles = 135°, 242°	#1-7 VDOT STD. DI-3B THROAT = 8" STA. 13+82.33, 16.0' LT. Angle = 270°	#1-12 VDOT STD. DI-3A STA. 12+12.08, 20.0' RT. Angle = 215°
#1-4 VDOT STD. DI-7A GRATE A TYPE III STA. 10+00.7, 41.3' RT.	#1-8 VDOT STD. DI-3B THROAT = 8" STA. 11+77.55, 16.0' LT. Angle = 243°	#1-13 VDOT STD. DI-3B THROAT = 12" STA. 10+42.43, 16.0' RT. Angle = 153°
#1-5 VDOT STD. MH-2 STA. 11+77.13, 28.7' RT. Angles = 101°24', 171°03'	#1-9 VDOT STD. DI-3A STA. 10+28.75, 22.8' RT. Angle = 232°	#1-14 VDOT STD. DI-3B THROAT = 10" STA. 10+54.43, 16.0' LT.
		#1-15 VDOT STD. DI-3B THROAT = 8" STA. 14+82.47, 15.95' LT.

NOTES:
UPON COMPLETION OF THE INSTALLATION OF THE CONCRETE CURB & GUTTER AND STONE BASE, THE G.C. SHALL INSTALL TEMPORARY 'STOP SIGNS' AT THE INTERSECTIONS AS INDICATED. THE SIGNS SHALL BE INSTALLED IN ACCORDANCE WITH PART 2 OF THE MANUAL ON UNIFORM TRAFFIC CONTROL DEVICES, LATEST EDITION.

ALL DRIVEWAYS CONNECTED TO THE PROPOSED ROADWAYS SHALL UTILIZE A VDOT STD. CG-9D, WITH A MAXIMUM WIDTH OF 18' AND A MINIMUM DISTANCE OF 5' FROM A SIDE PROPERTY LINE.

ALL LOTS INDICATED ON THIS DEVELOPMENT SHALL INGRESS/EGRESS THEIR LOTS FROM THE PROPOSED ROADS AND SHALL NOT HAVE DIRECT ACCESS ONTO VA. SEC. RTE. 1150 (EDGEBROOK ROAD).

SIGNAGE SHALL COMPLY WITH THE APPLICABLE REGULATIONS OF THE COUNTY OF ROANOKE (SEC. 30-93). A SEPARATE PERMIT IS REQUIRED.

N/F PROPERTY OF
JOHN R. &
PATRICIA R. SEVCIK
D.B. 1480, PG. 1090
TAX # 35.04-2-48

Sewer Information
Pipe: National 8" SDR-35 PVC
National 8" SDR-26 PVC deep areas
National 4" SDR-35 PVC laterals
National 6" SDR-35 PVC lateral

Manholes: Hanson Pre-cast concrete
MH Frames and Covers:
East Jordan
Capitol Foundry

N/F PROPERTY OF
MARK E. TODD &
CYNTHIA K. VAUGHAN
D.B. 1540, PG. 1445
TAX # 35.04-2-50

N/F PROPERTY OF
LEE O. &
SHIRLEY J. MATHENA
D.B. 1116, PG. 319
TAX # 35.04-2-52

1015107 K. Winslow

1015107 K. Winslow

FAIRWAYS at
HANGING ROCK

SECTION 2
DIMENSIONAL PLAN

ROANOKE COUNTY, VIRGINIA

DRAWN BY: JVV
DESIGNED BY: JVV
CHECKED BY: SMH
DATE: 12/27/05

REVISIONS:
04/04/06 PER VDOT &
RKE CO. 1ST REVIEW
07/12/06 PER VDOT &
RKE CO. 2ND REVIEW

SCALE: 1"=30'
SHEET NO. **C-5**
JOB NO. R0500377.00

As-Built 1015107 K. Winslow