



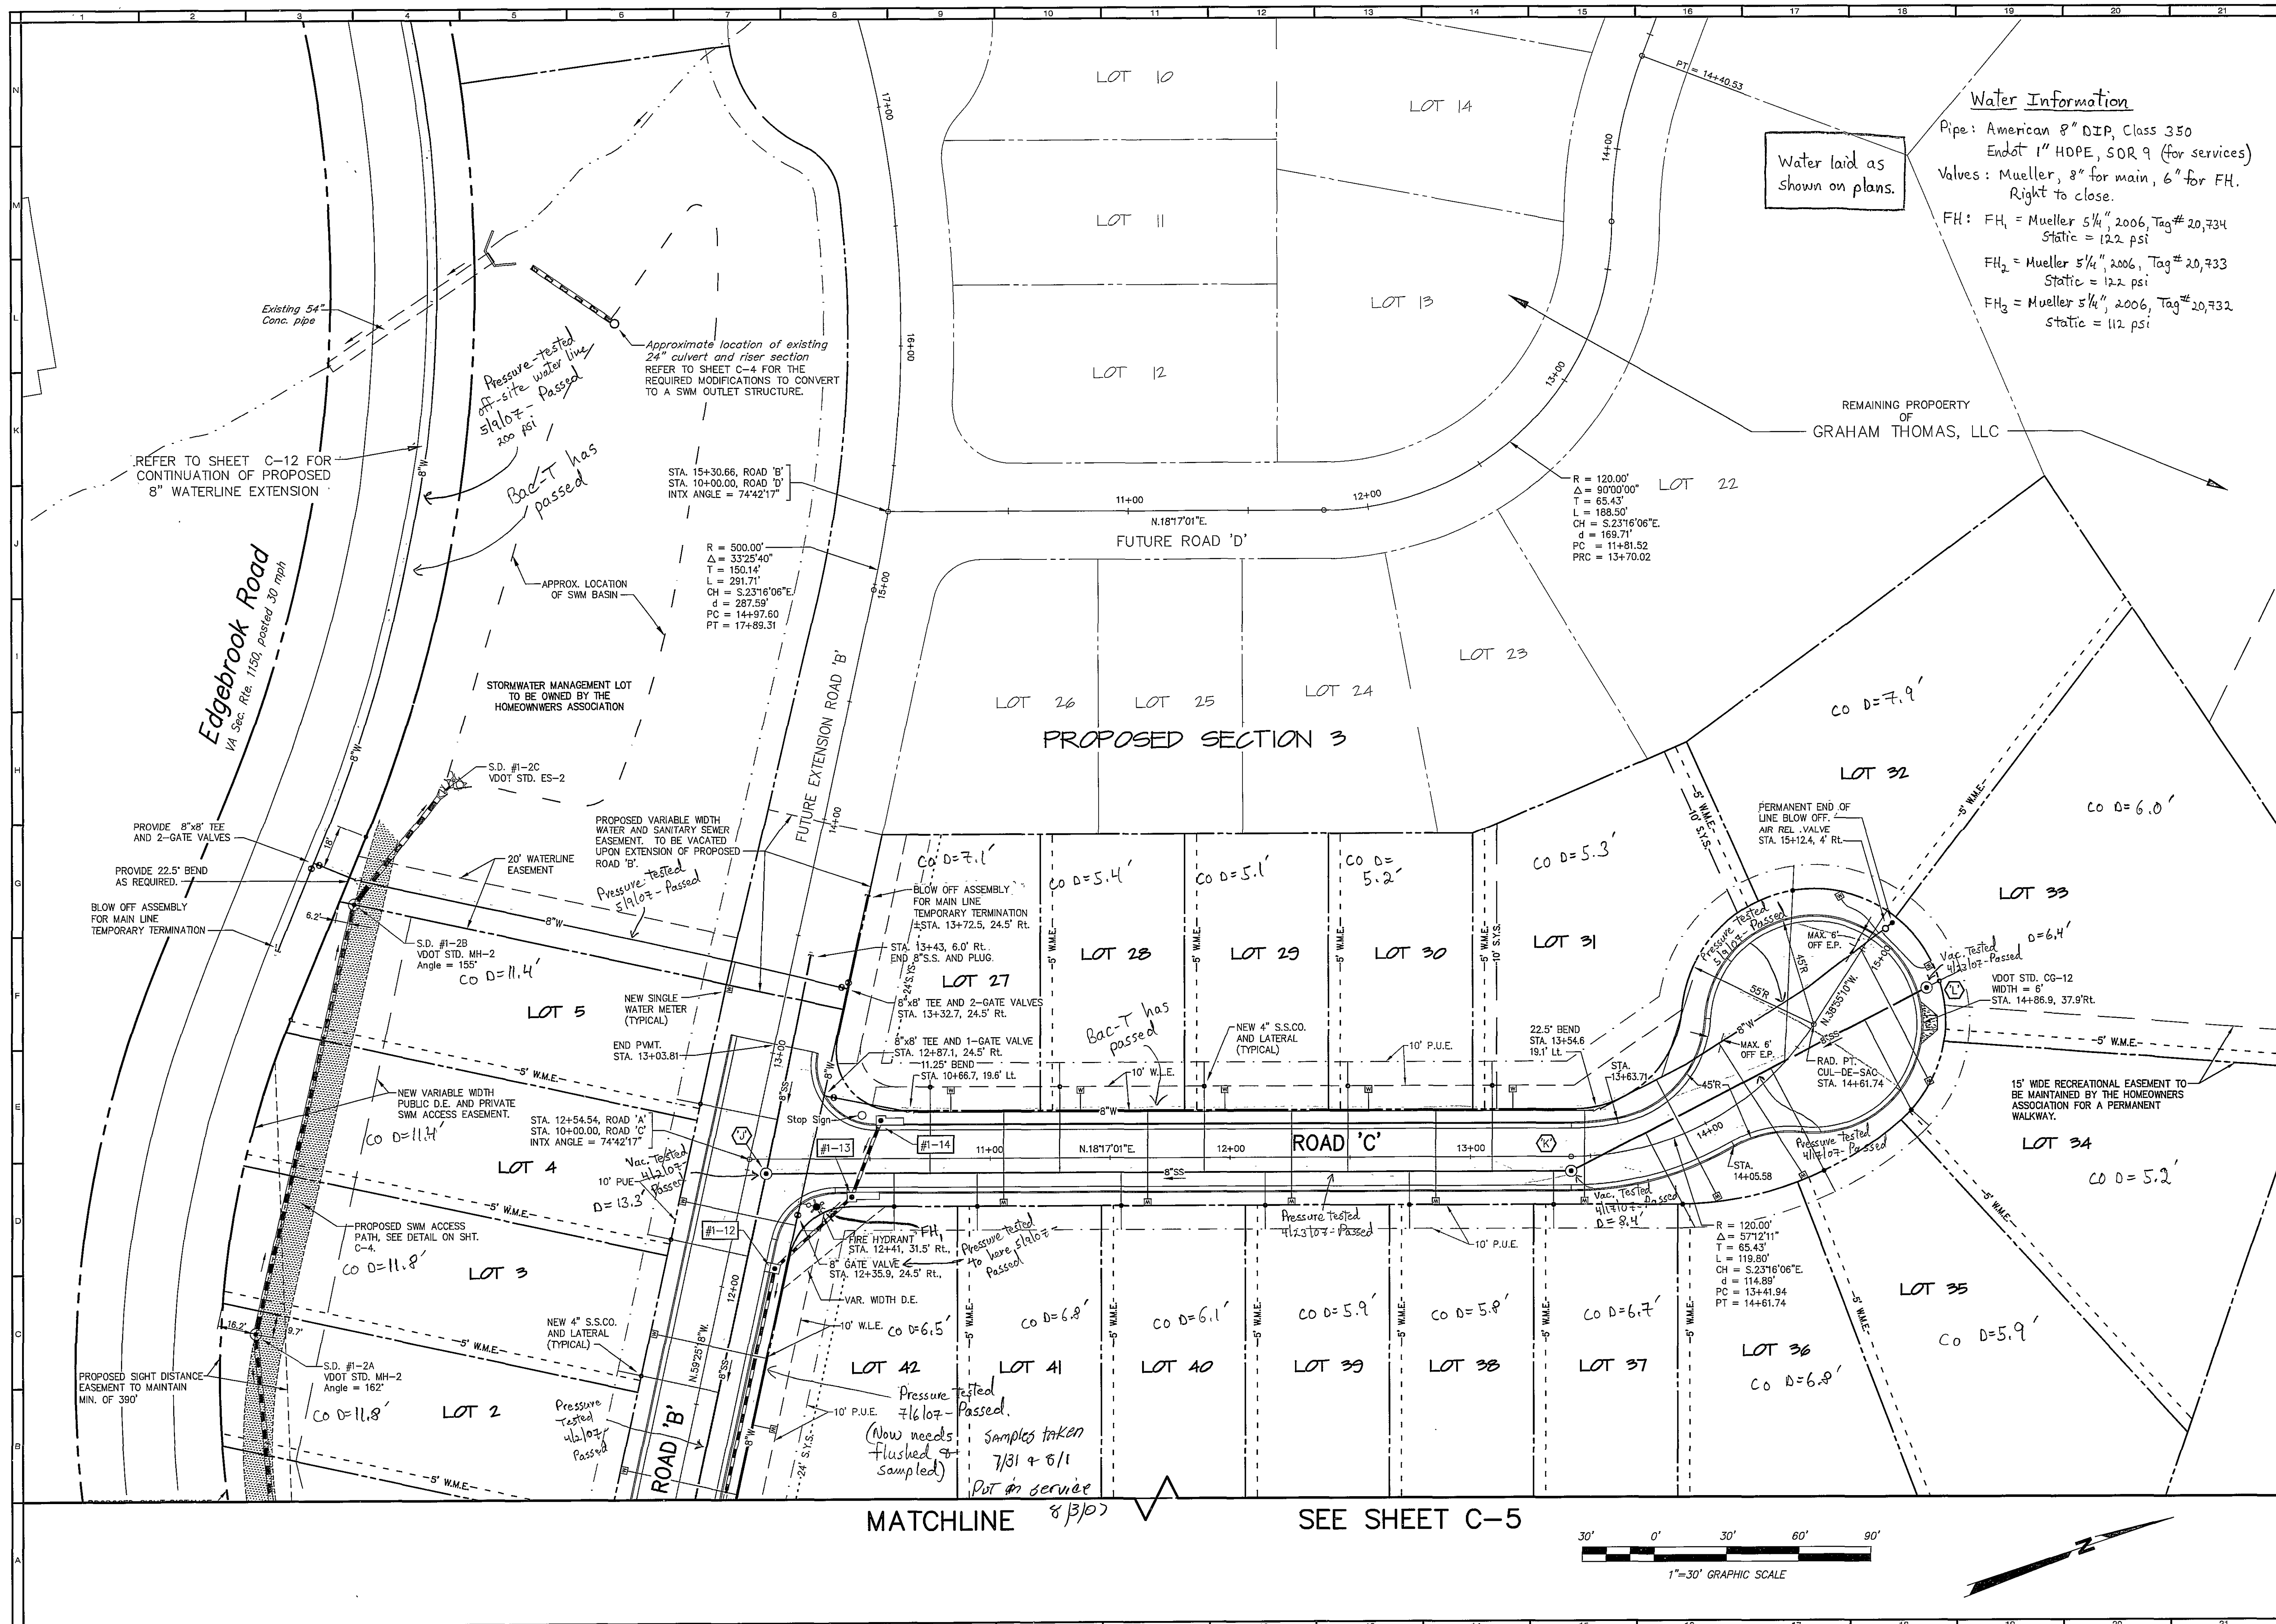

Water Information
Pipe: American 8" DIP, Class 350
Endot 1" HDPE, SDR 9 (for services)
Valves: Mueller, 8" for main, 6" for FH.
Right to close.
FH: FH₁ = Mueller 5 1/4", 2006, Tag# 20,734
Static = 122 psi
FH₂ = Mueller 5 1/4", 2006, Tag# 20,733
Static = 122 psi
FH₃ = Mueller 5 1/4", 2006, Tag# 20,732
Static = 112 psi

Water laid as shown on plans.

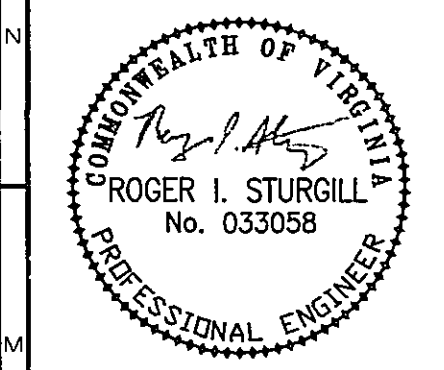

1208 Corporate Circle
Roanoke, Virginia 24018
Phone: 540/772-9580
FAX: 540/772-8050

501 Branchway Road
Richmond, Virginia 23268
Phone: 804/794-0571
FAX: 804/794-2635

880 Technology Park Drive
Suite 200
Glen Allen, Virginia 23059
Phone: 804/853-0132
FAX: 804/853-0133

102 Hubbard Street
Blackburg, Virginia 24030
Phone: 540/681-0981
FAX: 540/681-0982

1997 Commerce Road
Suite 201
Verona, Virginia 24482
Phone: 540/248-3220
FAX: 540/248-3221

FAIRWAYS at HANGING ROCK
SECTION 2
DIMENSIONAL PLAN
ROANOKE COUNTY, VIRGINIA

DRAWN BY: JVJ
DESIGNED BY: JVJ
CHECKED BY: SMH
DATE: 12/27/05
REVISIONS:
03/17/06 PER VDOT & RKE CO. 1ST REVIEW
07/12/06 PER VDOT & RKE CO. 2nd REVIEW

SCALE: 1"=30'
SHEET NO.
C-6
JOB NO.
R0500377.00

As-Built 10/5/07 K. Winslow