




57 Commerce Road
Suite 201
Falls Church, Virginia 22482
Phone: 540/248-3220
Fax: 540/248-3221

FAIRWAYS at
HANGING ROCK
SECTION 2
OFF-SITE WATERLINE EXTENSION
ROANOKE COUNTY, VIRGINIA

SHEET NO.

C-12
DB NO.
R0500377.00

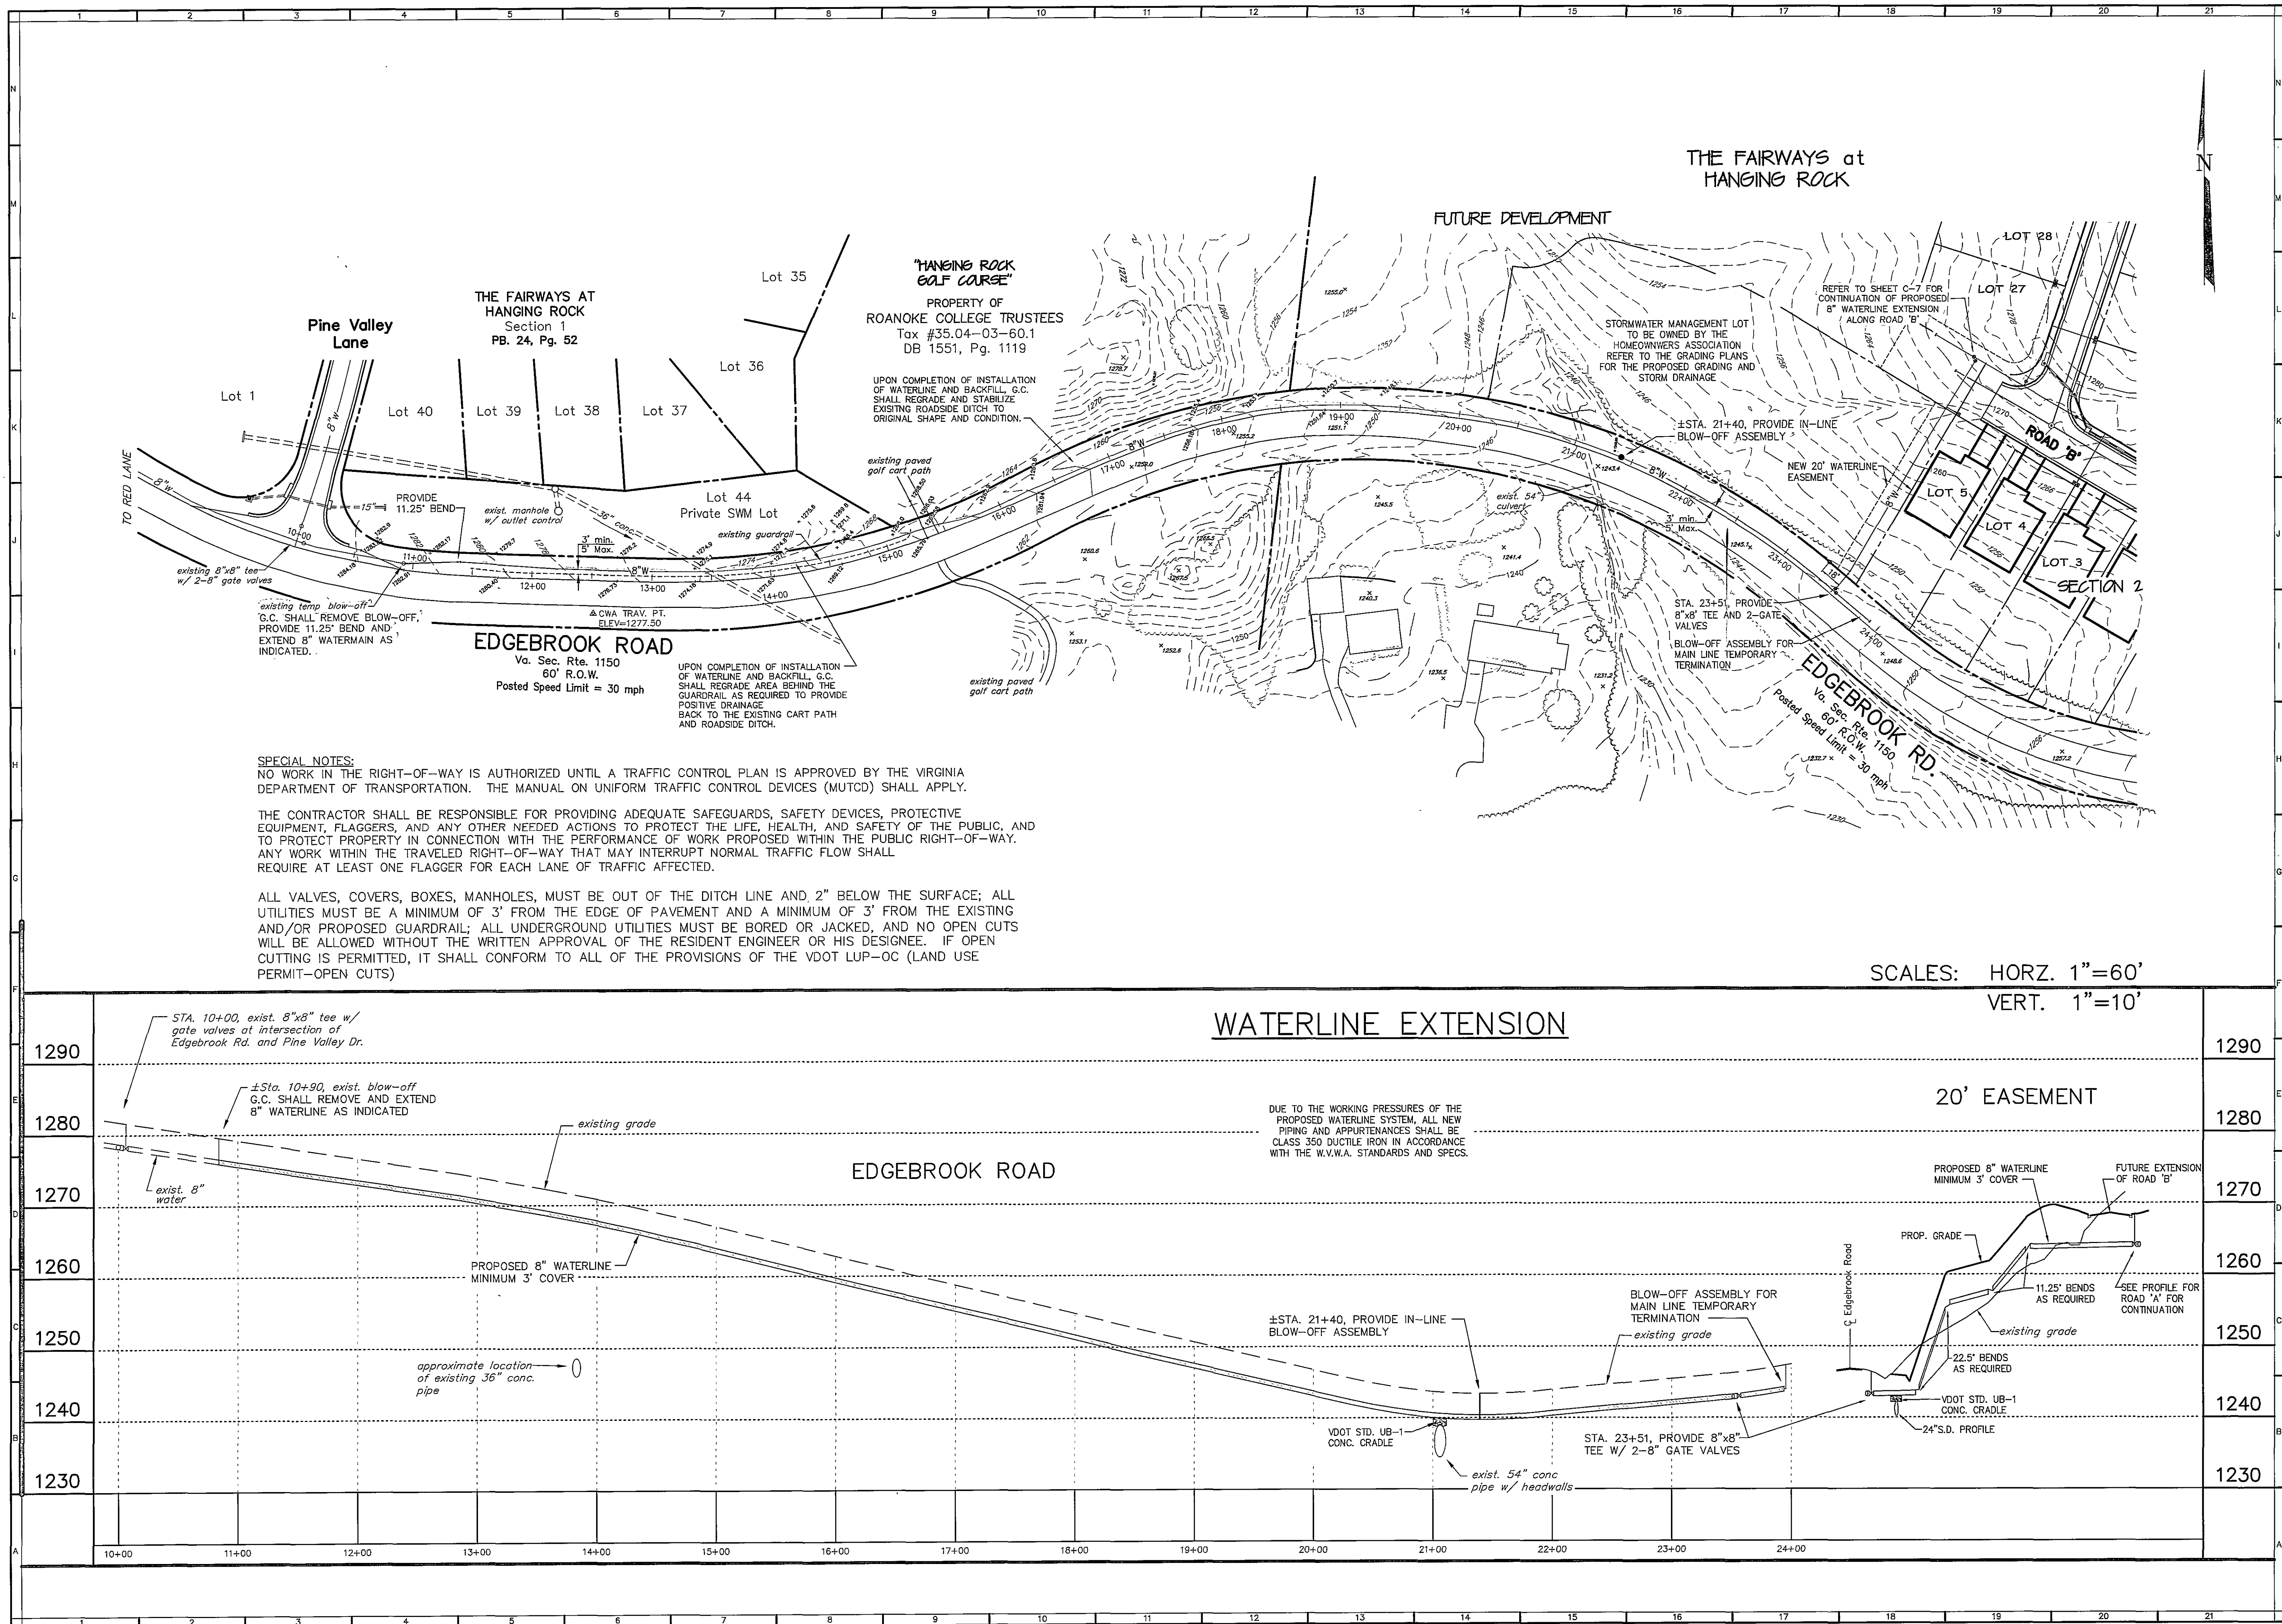

As-Built 10/5/07 K. Winslow