


ROBINDALE DRIVE

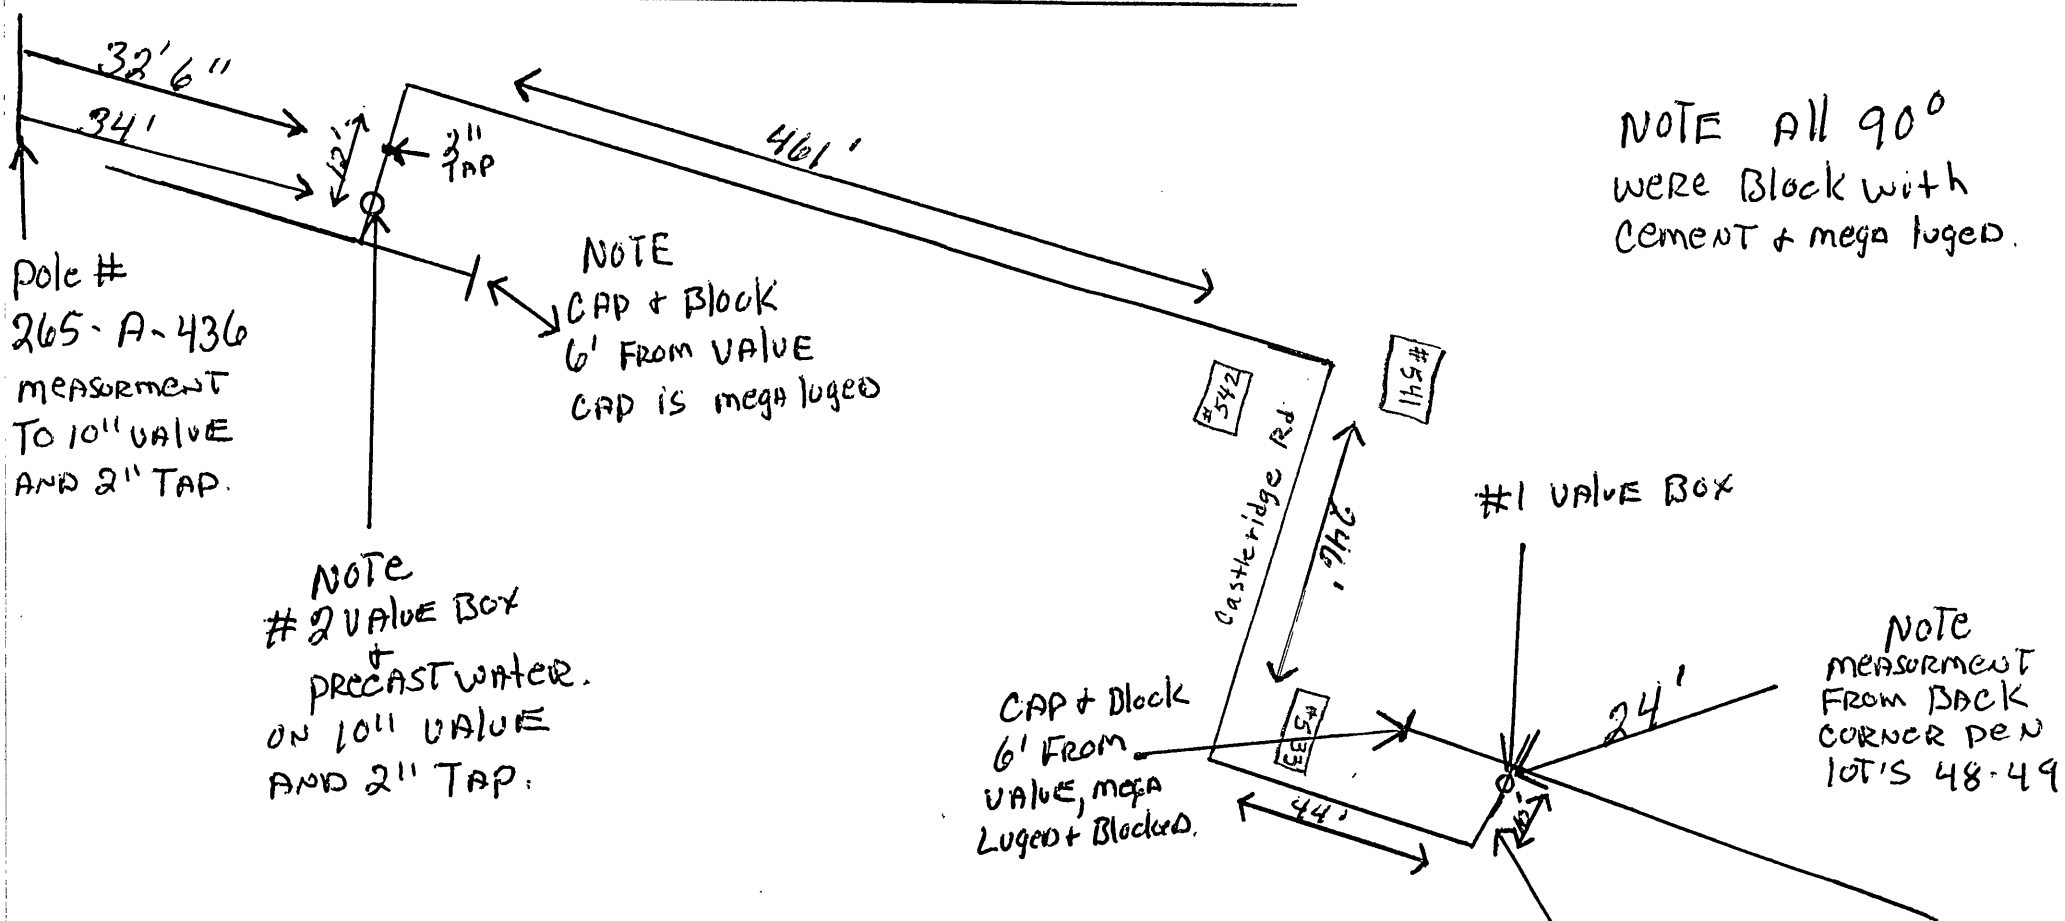

NOTE All 90°
were Block with
Cement + mega lugged.

Pole #
265-A-436
MEASUREMENT
TO 10" VALVE
AND 2" TAP.

NOTE
#2 VALVE BOX
+
PRECAST WATER.
ON 10" VALVE
AND 2" TAP.

NOTE
CAP + Block
6' FROM VALVE
CAP IS mega lugged

CAP + Block
6' FROM
VALVE, mega
Lugged + Blocked.

#1 VALVE BOX

NOTE
MEASUREMENT
FROM BACK
CORNER OF
LOT'S 48-49

NOTE
From 90° TO
VALVE THERE IS
A 11 1/4 Bend
1' FROM 90°

10/10/02
Carl Sisk brought me

KINGSTON ESTATES

SUBDIVISION. County

Replacement OF 10" WATER MAIN.

10-10-02

Jallins Creek area

main