


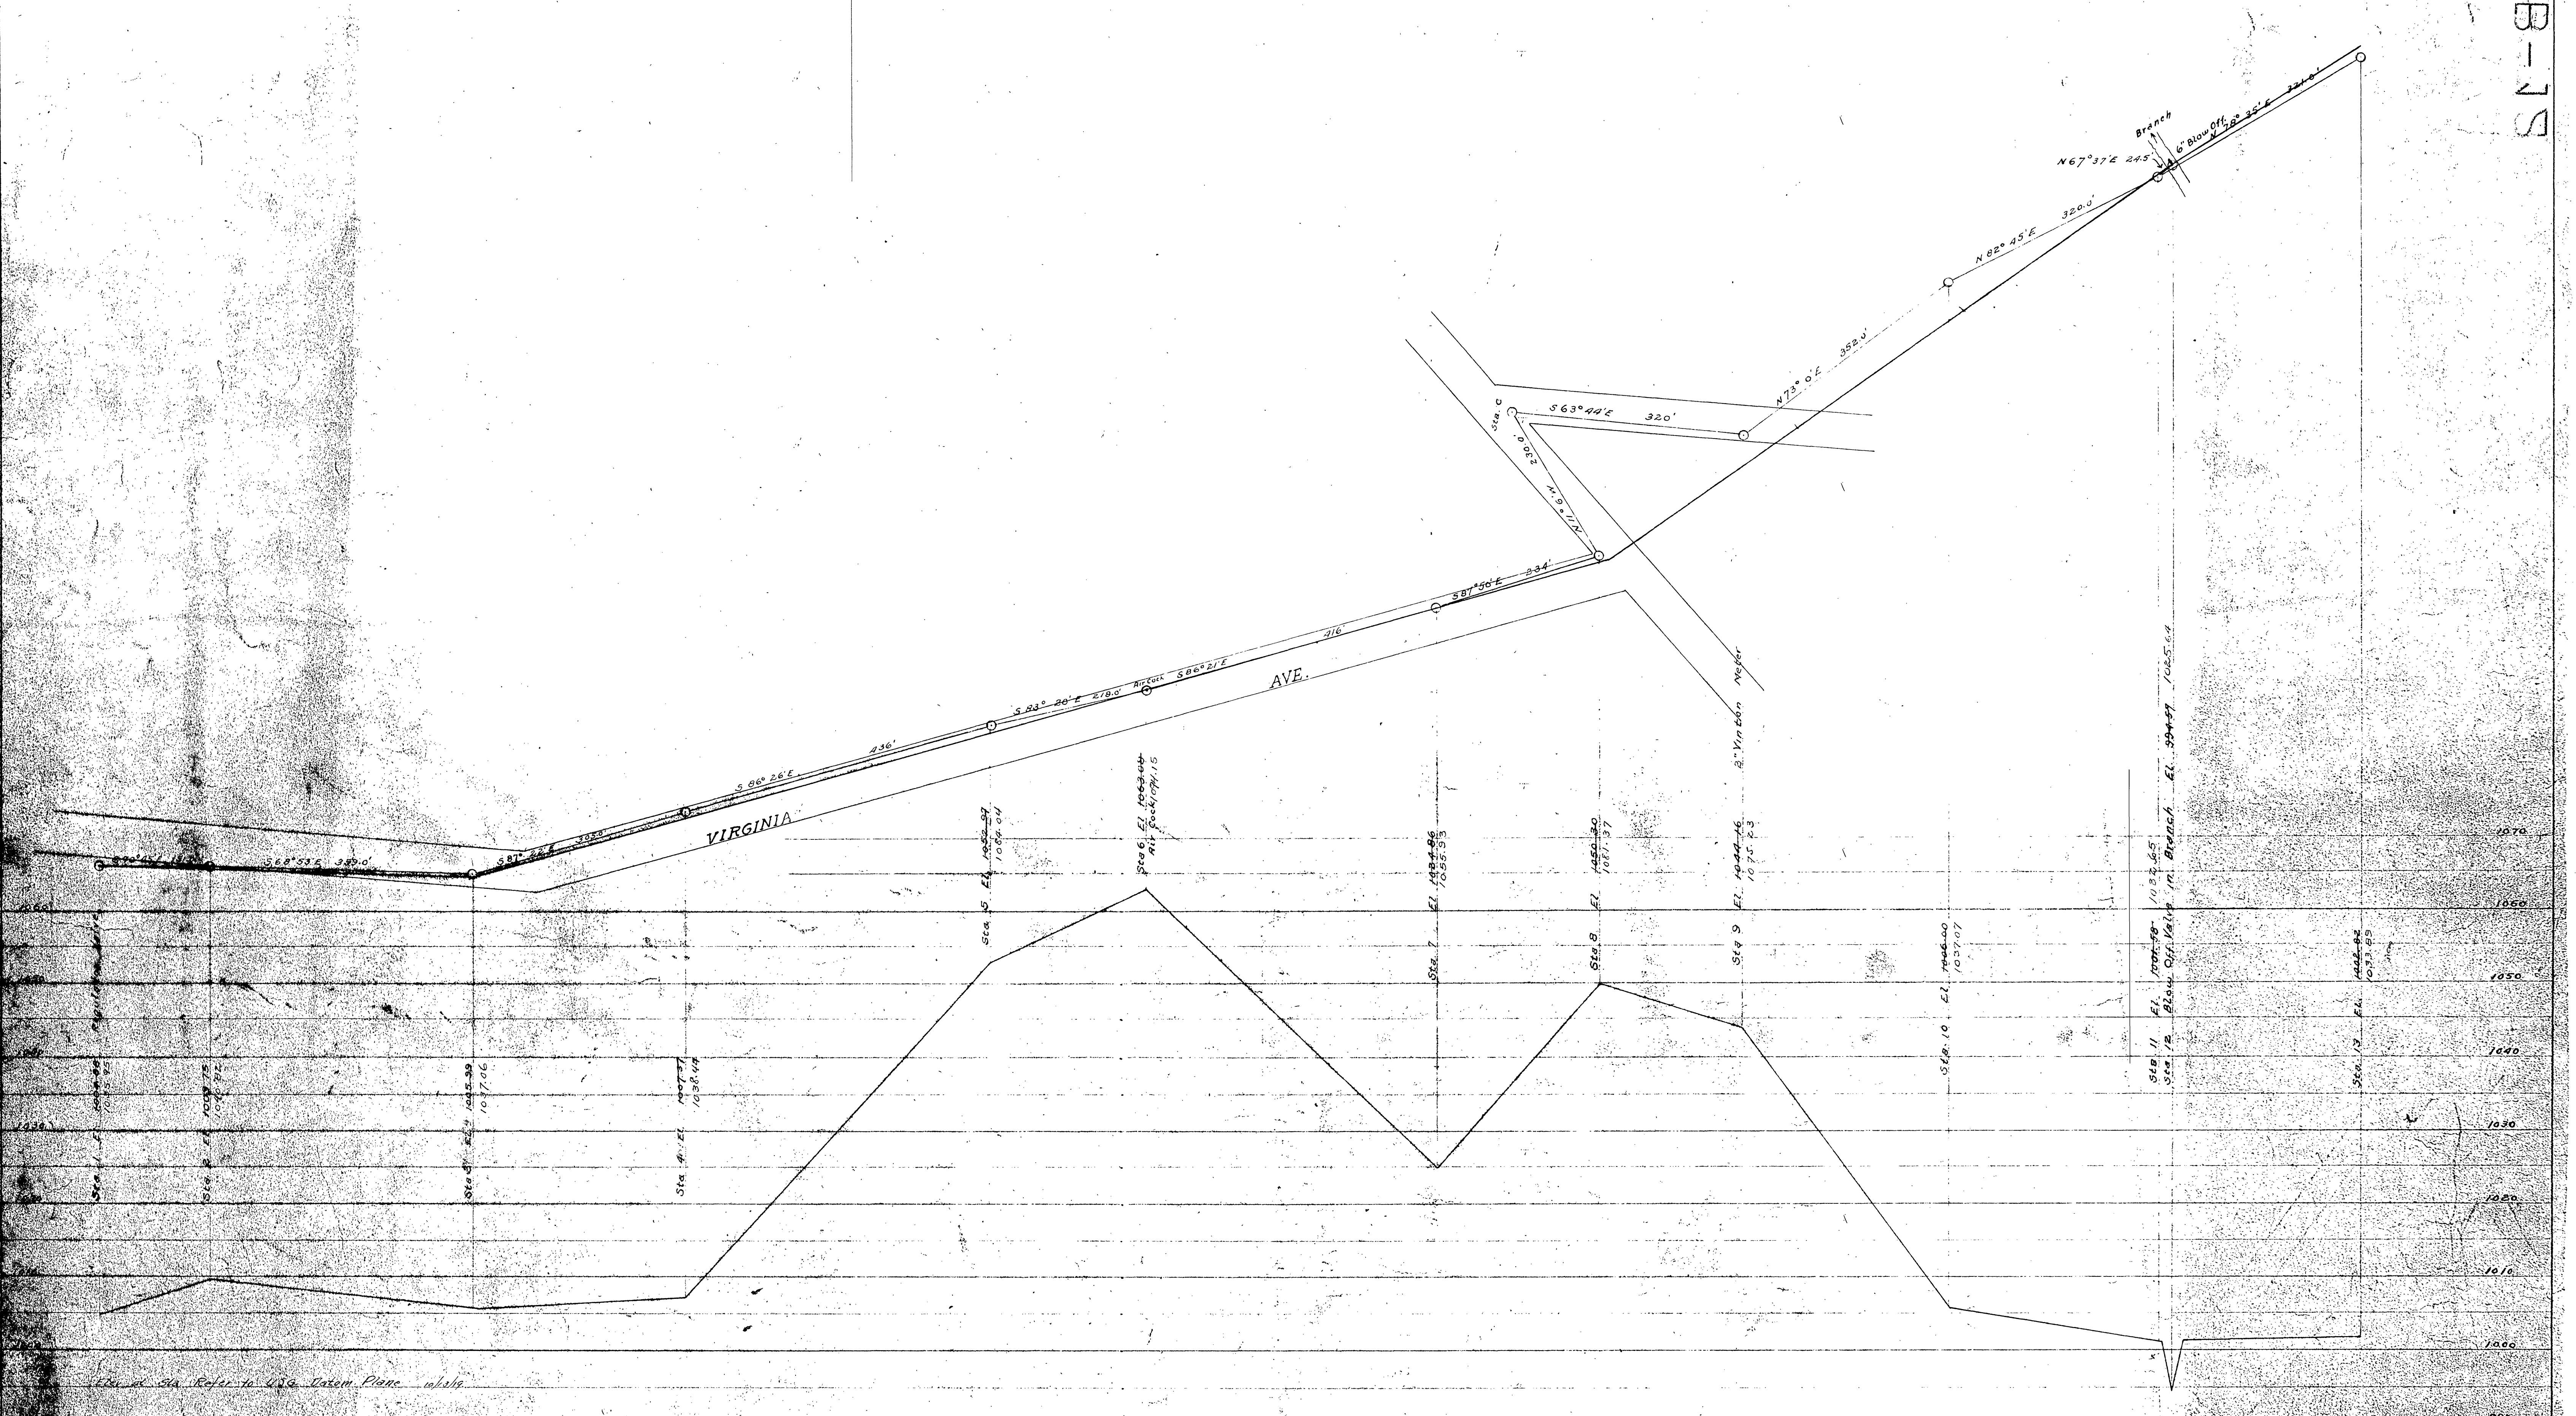

Station 1, center of regulating stem of 10" Regulating Valve, Virginia Ave., Vinton.
Necker Gable, Roman Catholic Church, Roanoke, Va. centre of bronze figure
from Station 1. Bearing N 61° 35' W. April 2, 1913.
Bench Mark, concrete entrance to Valve House, from Sta. 1 N 16° 25' W 8.0'
assumed elevation 1000.0. C.G. Elev. 1031.068. 10/31/19.
Red Line, Run by Transit & Stadia, April, 1919. C.E. Moore Transit, R.D. Stoner Rod.
Black Line, Approximate Location, 10" C.I. Transmission Main.
Profile is surface of ground. Stations are projected to base line.

10" TRANSMISSION MAIN
FALLING CREEK DAM TO
REGULATING VALVE - VINTON
VINTON-ROANOKE WATER CO.
ROANOKE VIRGINIA
SCALE 100' = 1" DATE 8-18-1919
DRAWN BY J. H. H. ISSUE
CHECKED BY

F3-D3
117

SECTION 1