


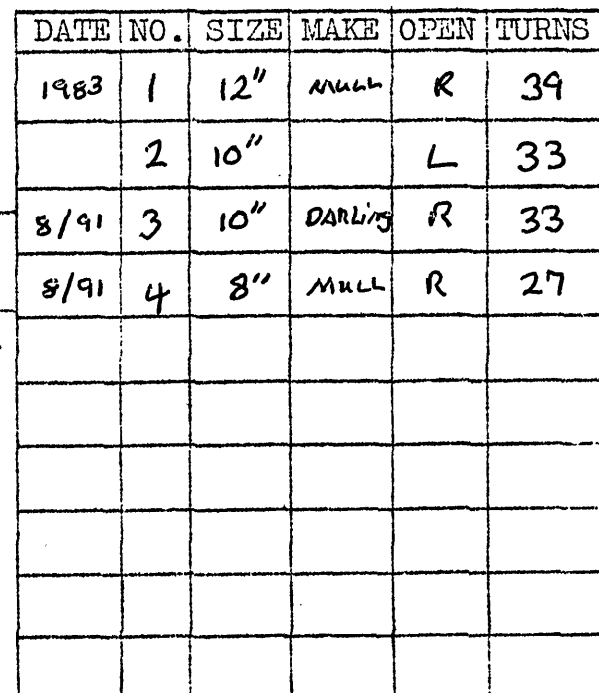

CITY OF ROANOKE - WATER DEPT.	
VALVE DIAGRAM	
FALLING CREEK FILTER PLANT	
Sec. Map	
Date 8-24-91	Page No.