

NEW WYWA WATER ASSETS INSTALLED:

GATE VALVE (6" WET TAP)
NORTHING: 3608939.37
EASTING: 11050085.48
ELEVATION: 1166.67 (VALVE TOP)
ELEVATION: 1163.61 (VALVE TOP OF NUT)

GATE VALVE (HYDRANT)
NORTHING: 3608949.07
EASTING: 11050064.77
ELEVATION: 1168.43 (VALVE TOP)
ELEVATION: 1163.42 (VALVE TOP OF NUT)

HYDRANT
NORTHING: 3608949.07
EASTING: 11050064.77
ELEVATION: 1168.43 (ARROW TOP)

METER VAULT
NORTHING: 3608948.01
EASTING: 11050055.79
ELEVATION: 1166.51 (METER TOP)

NEW WYWA SEWER ASSETS INSTALLED:

CLEANOUT No. 1
NORTHING: 3608887.85
EASTING: 11050008.19
ELEVATION: 1163.10 (SSCO TOP)

CLEANOUT No. 2
NORTHING: 3608742.05
EASTING: 11050123.69
ELEVATION: 1159.12 (SSCO TOP)

CLEANOUT No. 3
NORTHING: 3608741.66
EASTING: 11050127.38
ELEVATION: 1159.12 (SSCO TOP)

SANITARY SEWER MANHOLE No.
NORTHING: 3608892.76
EASTING: 11050018.59
ELEVATION: 1162.05 (SSMH TOP)

SANITARY SEWER MANHOLE No.
NORTHING: 3608844.94
EASTING: 11050048.37
ELEVATION: 1158.84 (SSMH TOP)

SANITARY SEWER MANHOLE No.
NORTHING: 3608760.12
EASTING: 11050107.89
ELEVATION: 1159.49 (SSMH TOP)

*SEE PROFILE SHEET FOR SSMH INVERTS


SURVEY CONTROL PROVIDED / UTILIZED

 CONTROL POINT No. 1
NORTHING: 3608879.84
EASTING: 11050013.40
ELEVATION: 1160.38

 CONTROL POINT No. 2
NORTHING: 3608721.24
EASTING: 11049908.18
ELEVATION: 1148.44

AS-BUILT

AS-BUILT INFORMATION SHOWN ON
THIS PLAN IS THE RESULT OF A FIELD
SURVEY PERFORMED
BY LUMSDEN ASSOCIATES, P.C. OR AS
SUPPLIED BY JOE BANDY & SON, INC.
(CONTRACTOR) FIELD MARKUPS.

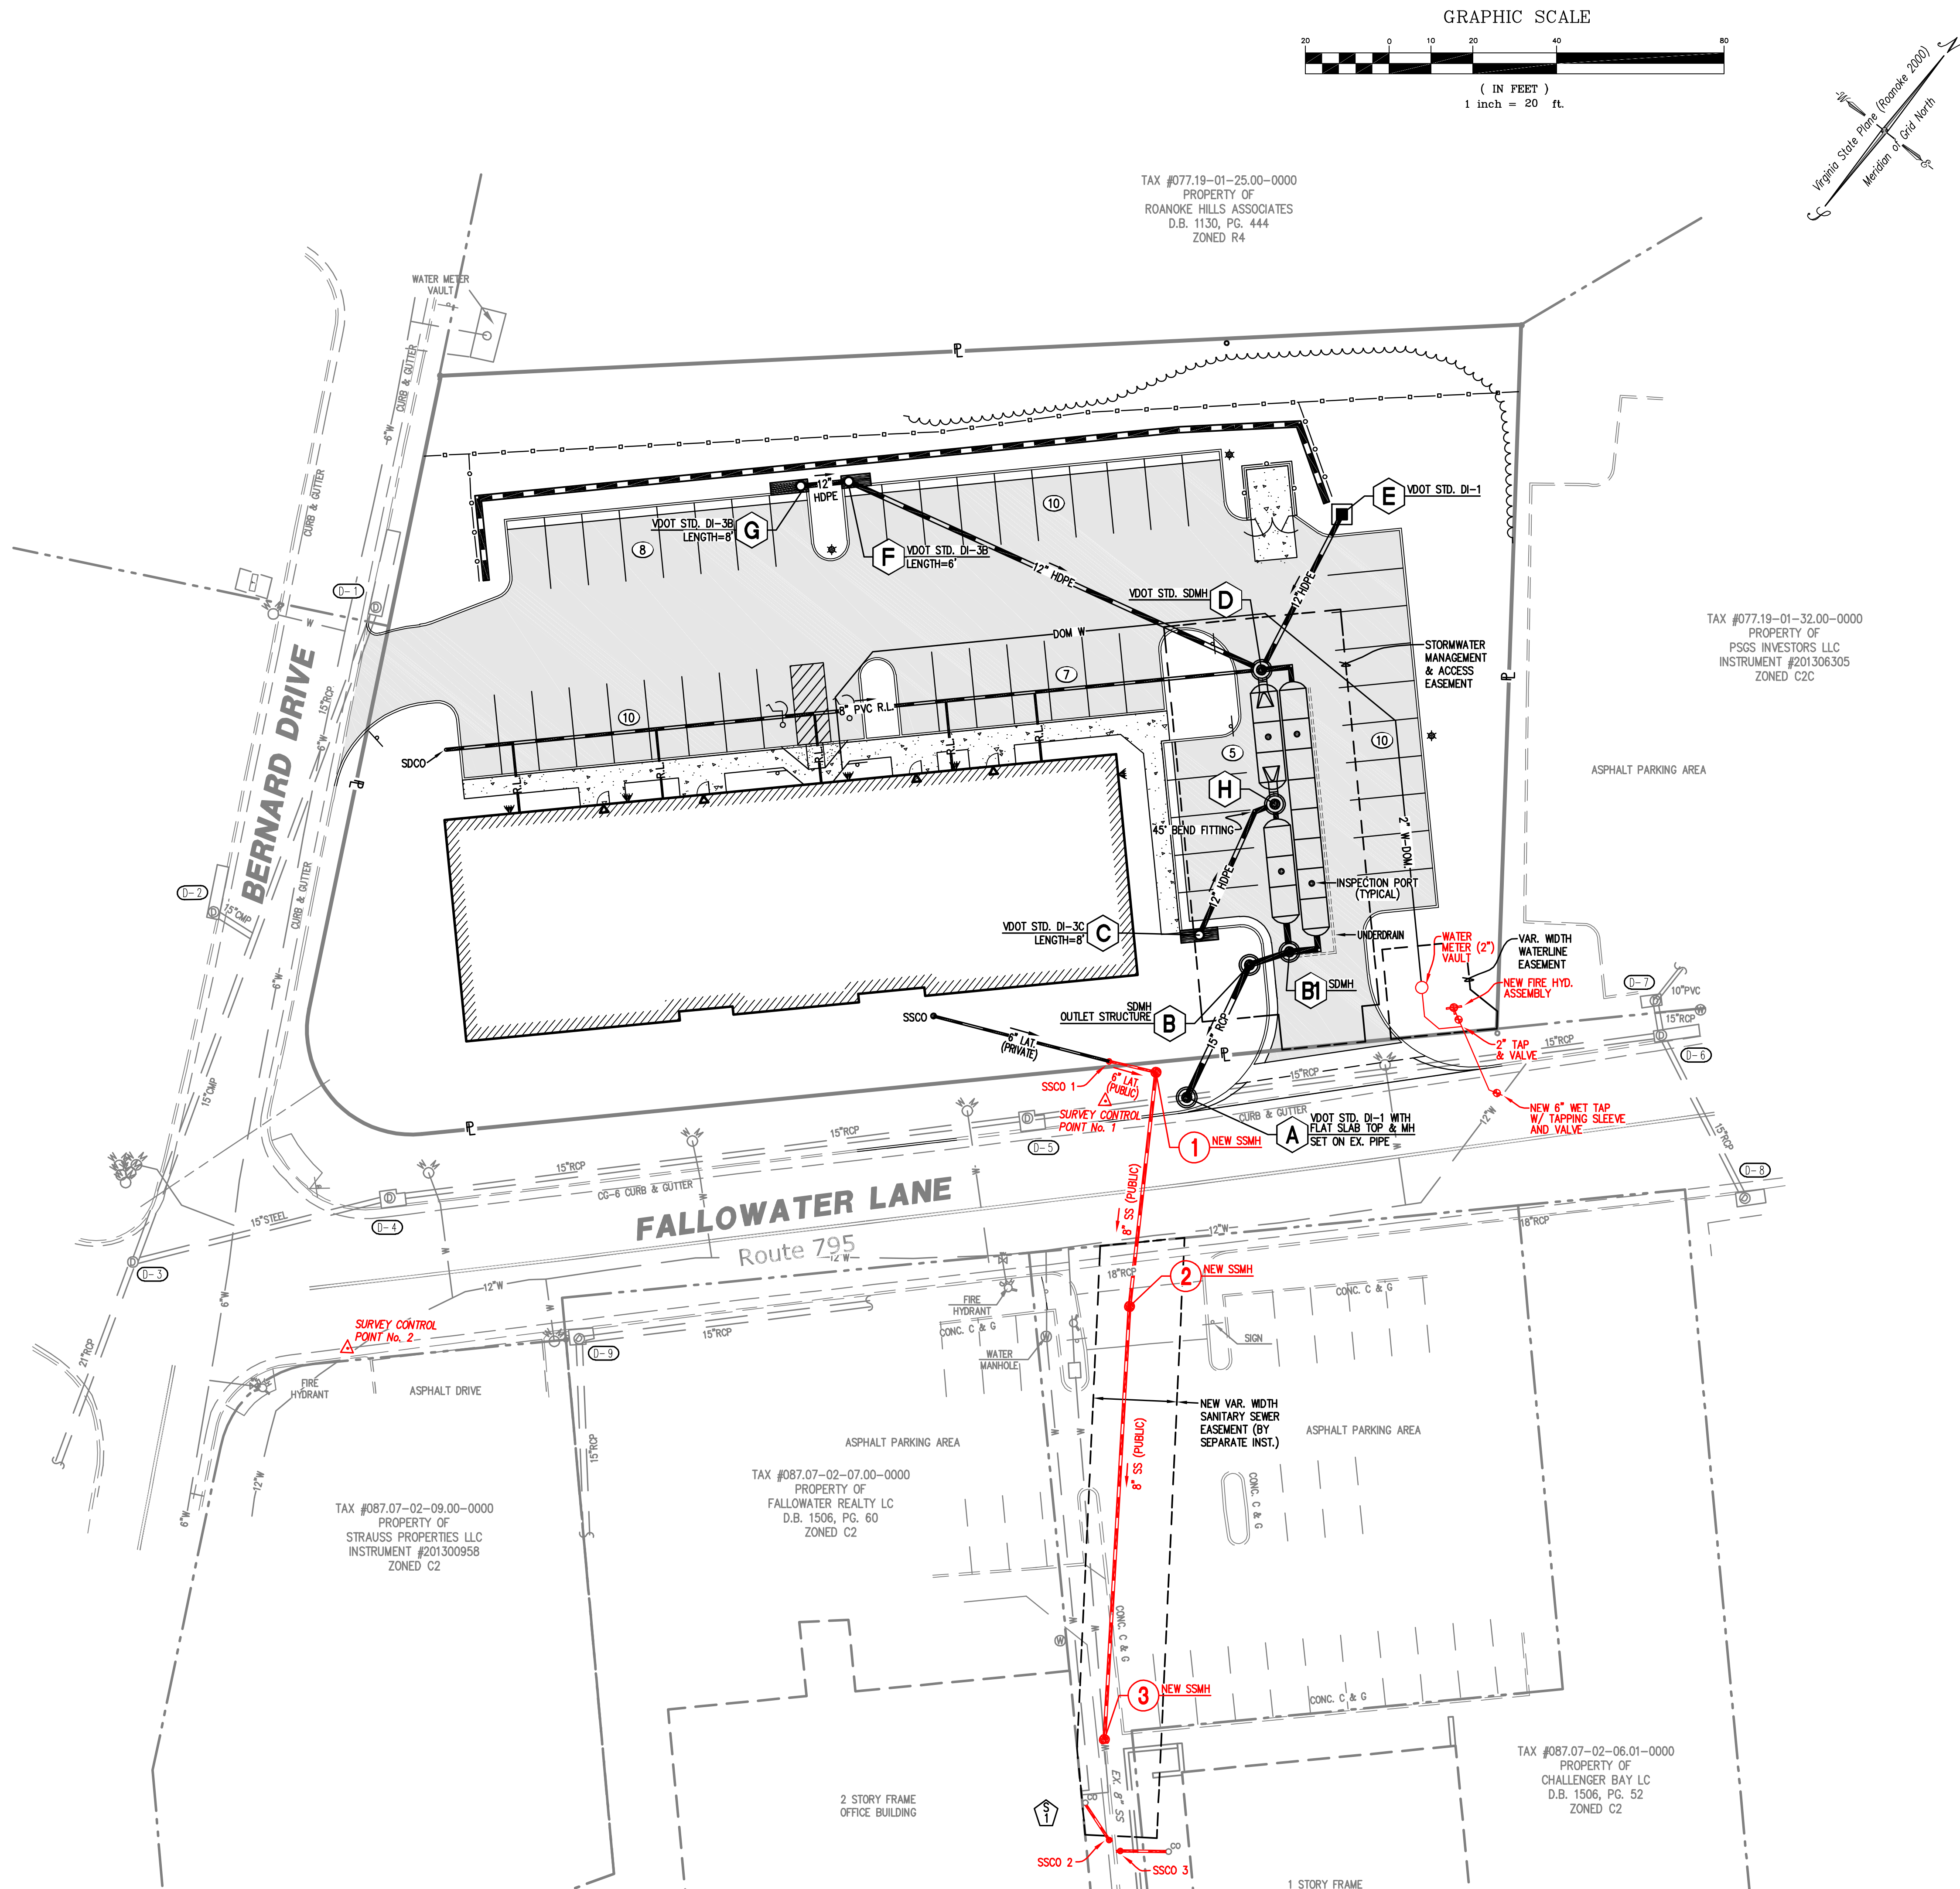


FALLOWATER SQUARE
OFFICE BUILDING

PREPARED FOR
ABRE Holdings, Inc.

ATED ALONG FALLOWATER LANE, SW
ROANOKE COUNTY, VIRGINIA

ATED ALONG FALLOWATER LANE, SW
ROANOKE COUNTY, VIRGINIA

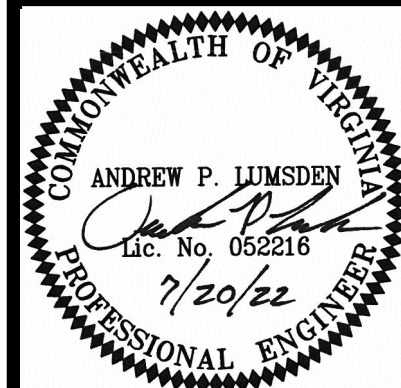

WVWA AS-BUILT PLAN

Lumsden Associates, P.C.
ENGINEERS | SURVEYORS | PLANNERS

4564 BRAMBLETON AVENUE
P.O. BOX 20669
ROANOKE, VIRGINIA 24018