



AS-BUILT INFORMATION SHOWN ON
THIS PLAN IS THE RESULT OF A FIELD
SURVEY PERFORMED
BY LUMSDEN ASSOCIATES, P.C. OR AS
SUPPLIED BY JOE BANDY & SON, INC.
(CONTRACTOR) FIELD MARKUPS.

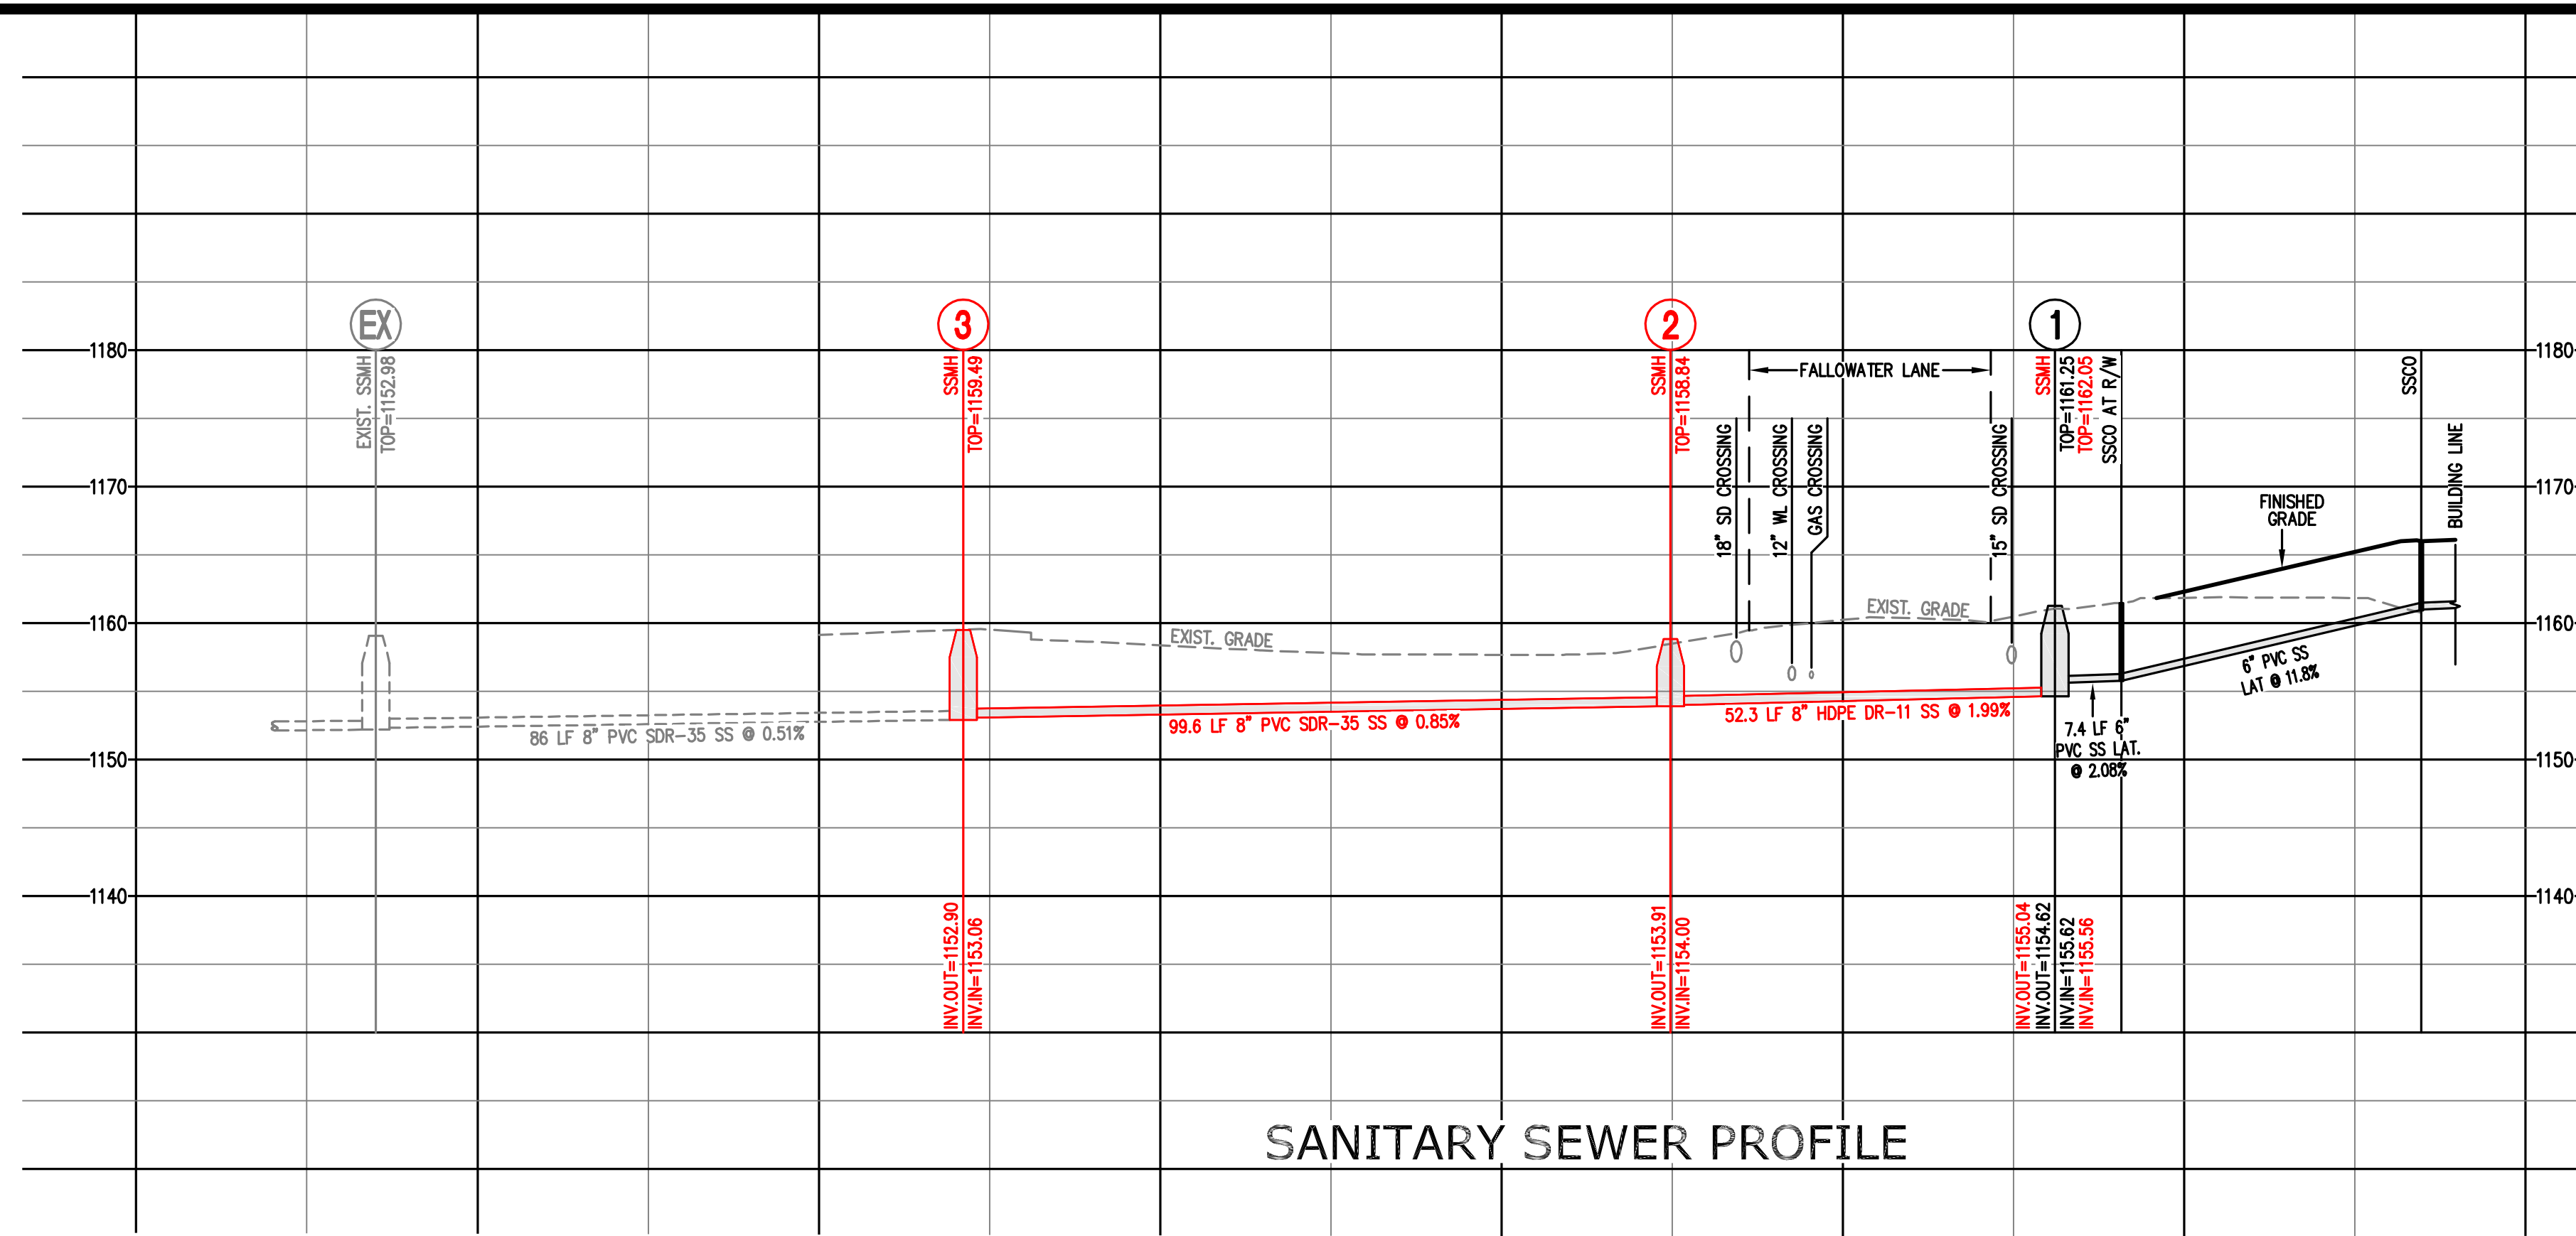

SANITARY SEWER PROFILE

PREPARED FOR
ABRE Holdings, Inc.
SITUATED ALONG FALLOWATER LANE, SW
ROANOKE COUNTY, VIRGINIA

WVWA PROFILES AS-BUILT PLAN

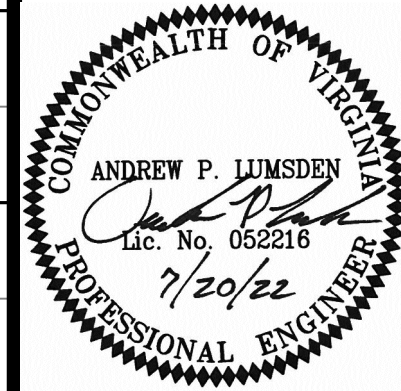

Lumsden Associates, P.C.
ENGINEERS | SURVEYORS | PLANNERS

4664 BRAMBLETON AVENUE
P.O. BOX 20669
ROANOKE, VIRGINIA 24018

REVISIONS		
NO.	DATE	DESCRIPTION
1		
2		
3		
4		
5		

DATE: July 20, 2022

SCALE:
1"=20'(H), 1"=10'(V)

20-339

SHEET 2 OF 2