




**BALZER
& ASSOCIATES**
PLANNERS / ARCHITECTS
ENGINEERS / SURVEYORS


Roanoke / Richmond
New River Valley / Staunton
Harrisonburg / Lynchburg
www.balzer.cc
1208 Corporate Circle
Roanoke, VA 24018
540.772.9680

PRELIMINARY


SANITARY SEWER E-L PROFILE

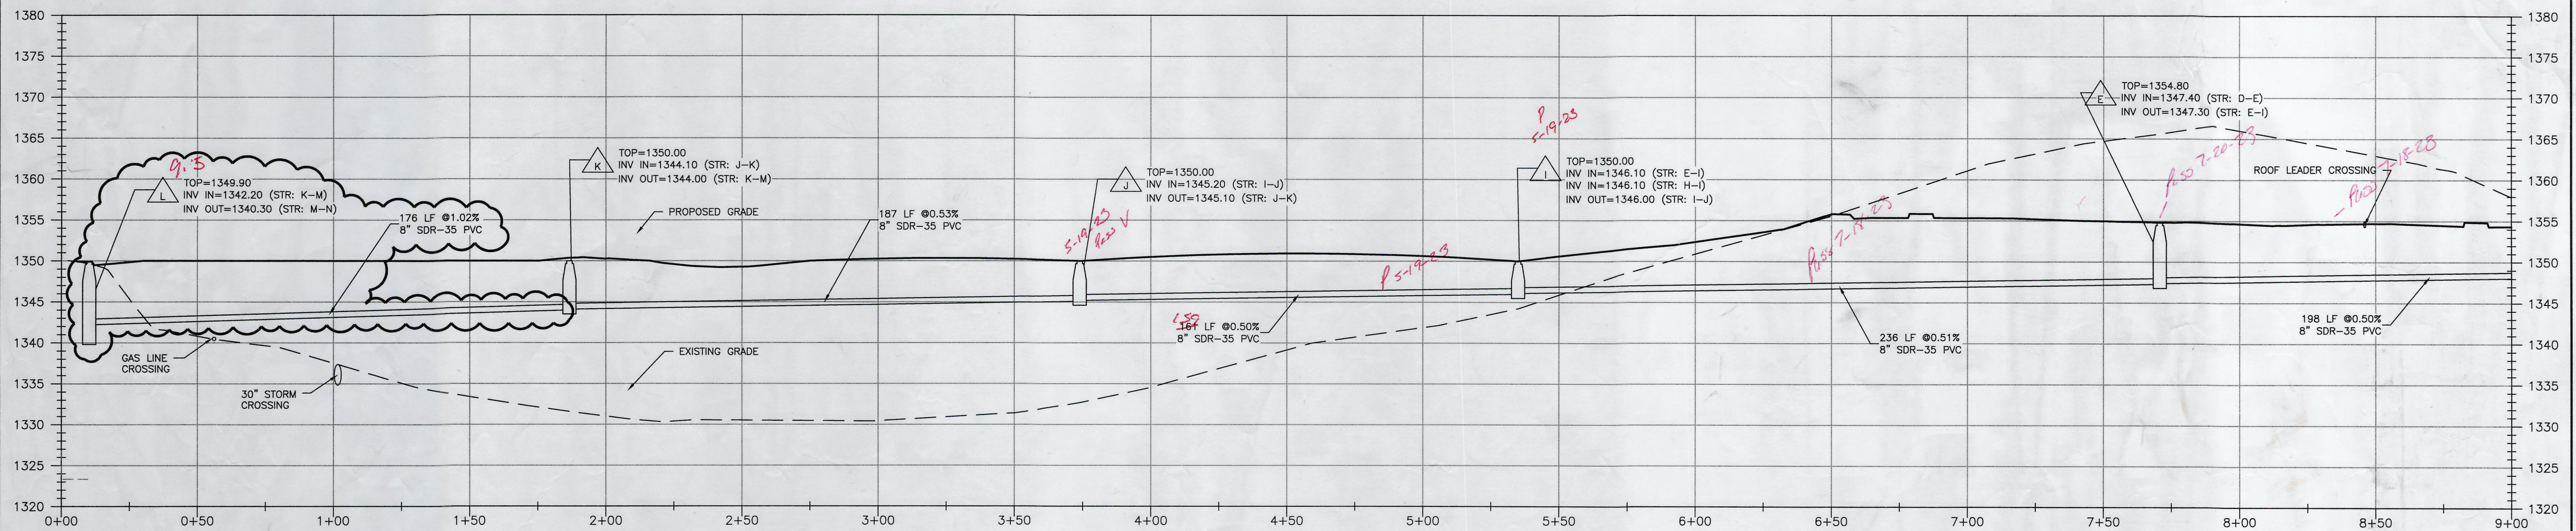


SANITARY SEWER U-E PROFILE

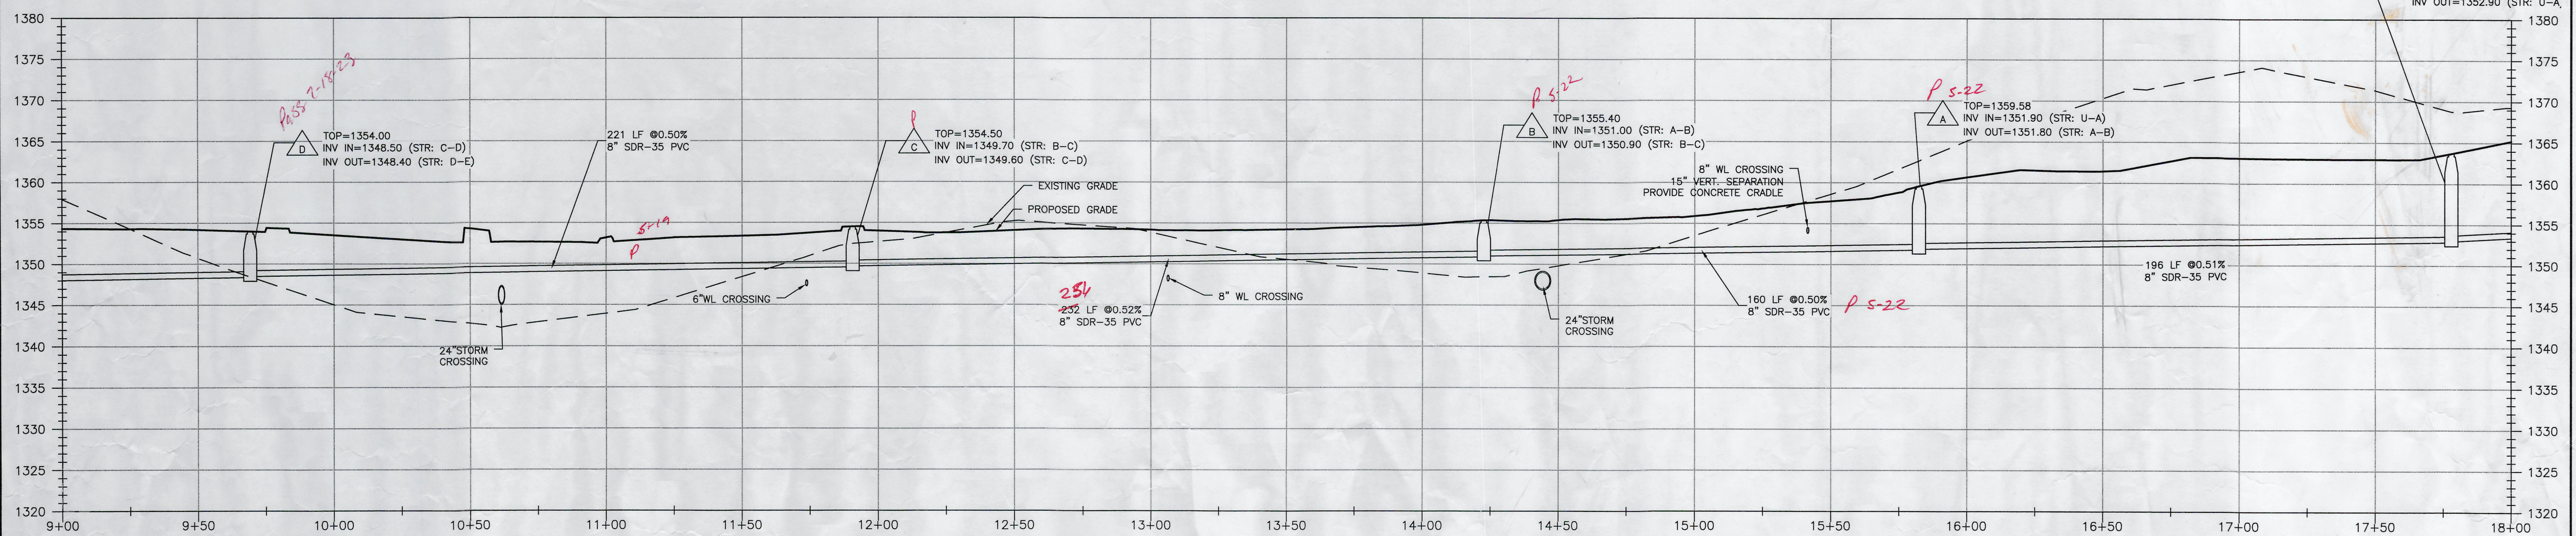

SANITARY SEWER R-U PROFILE

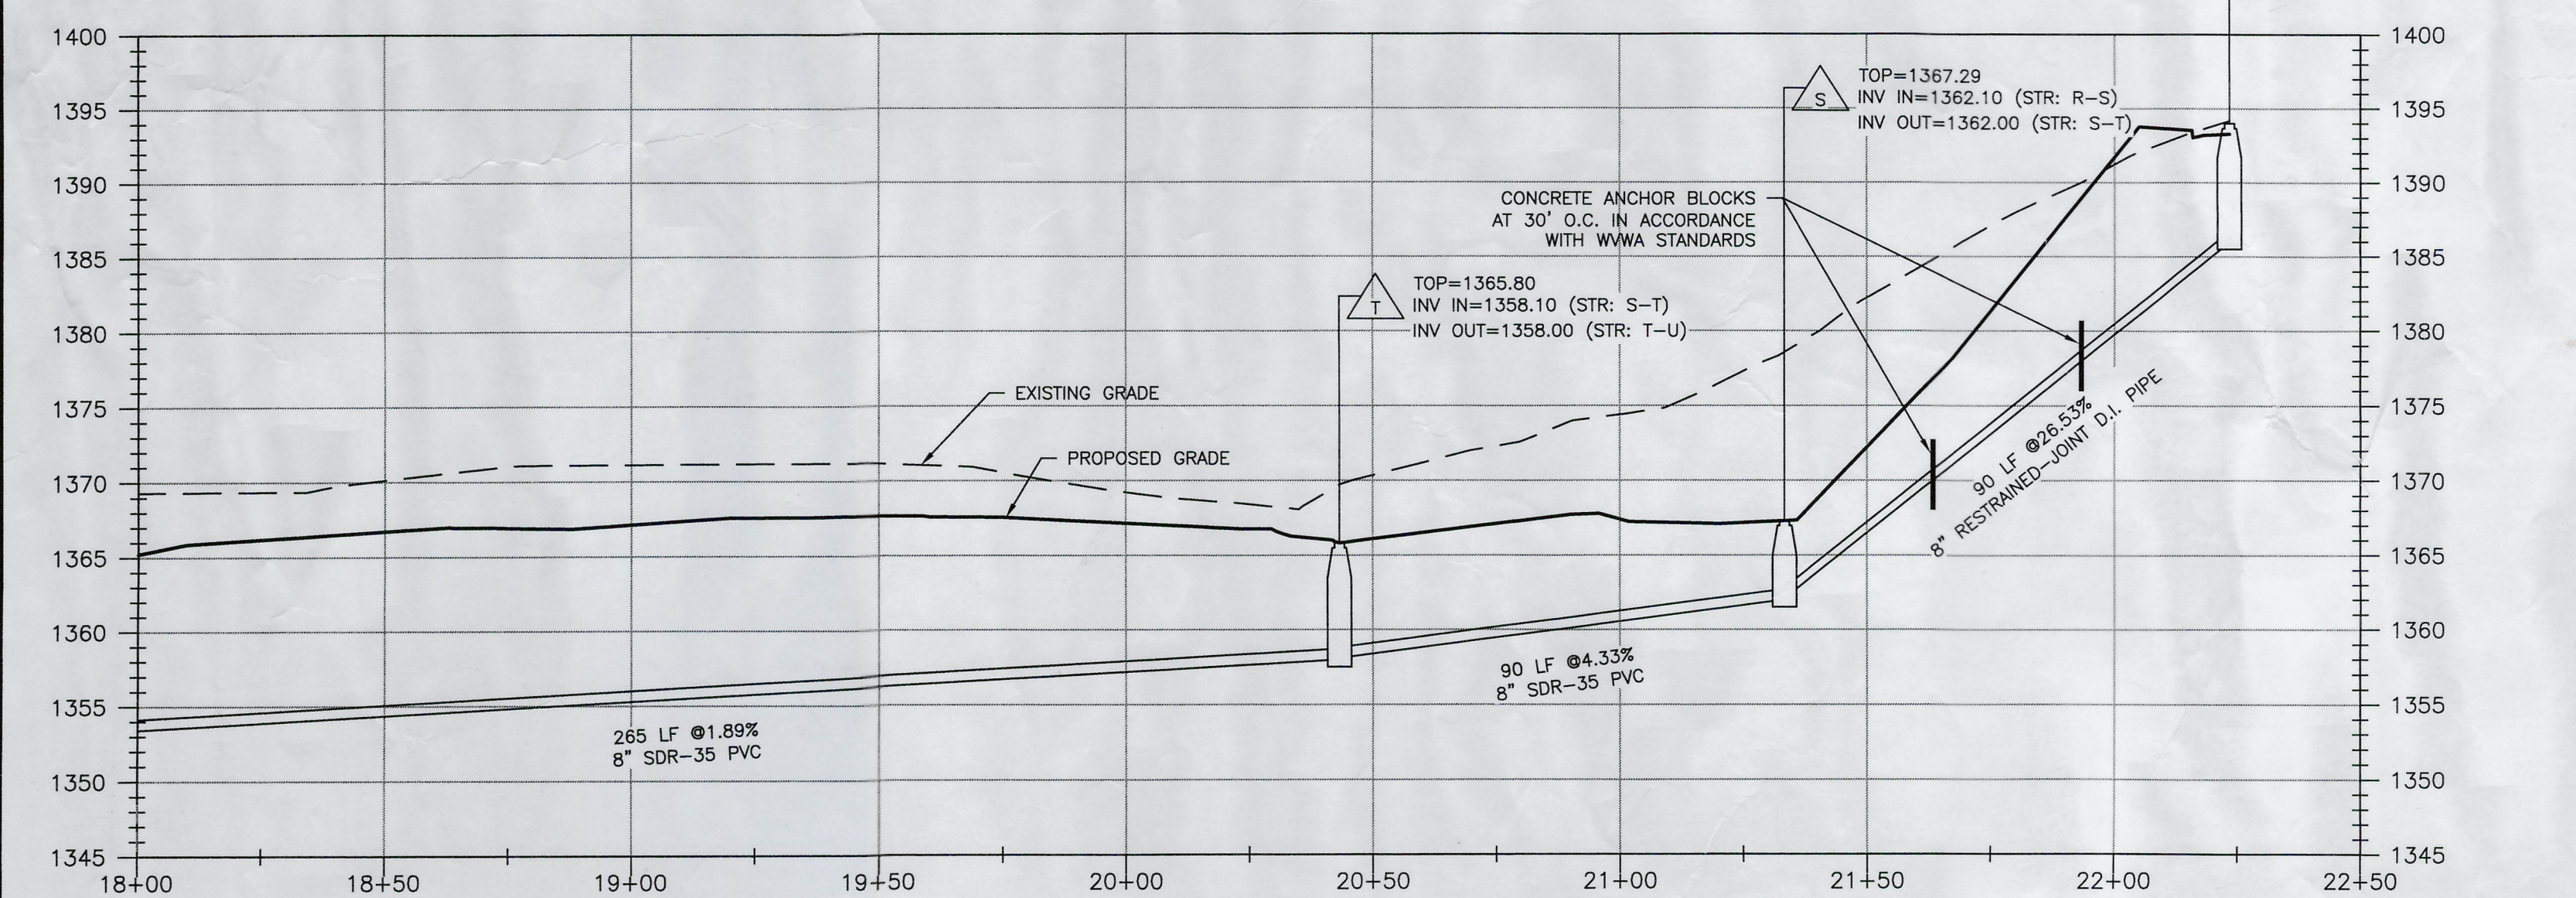

WATERLINE #2 PROFILE

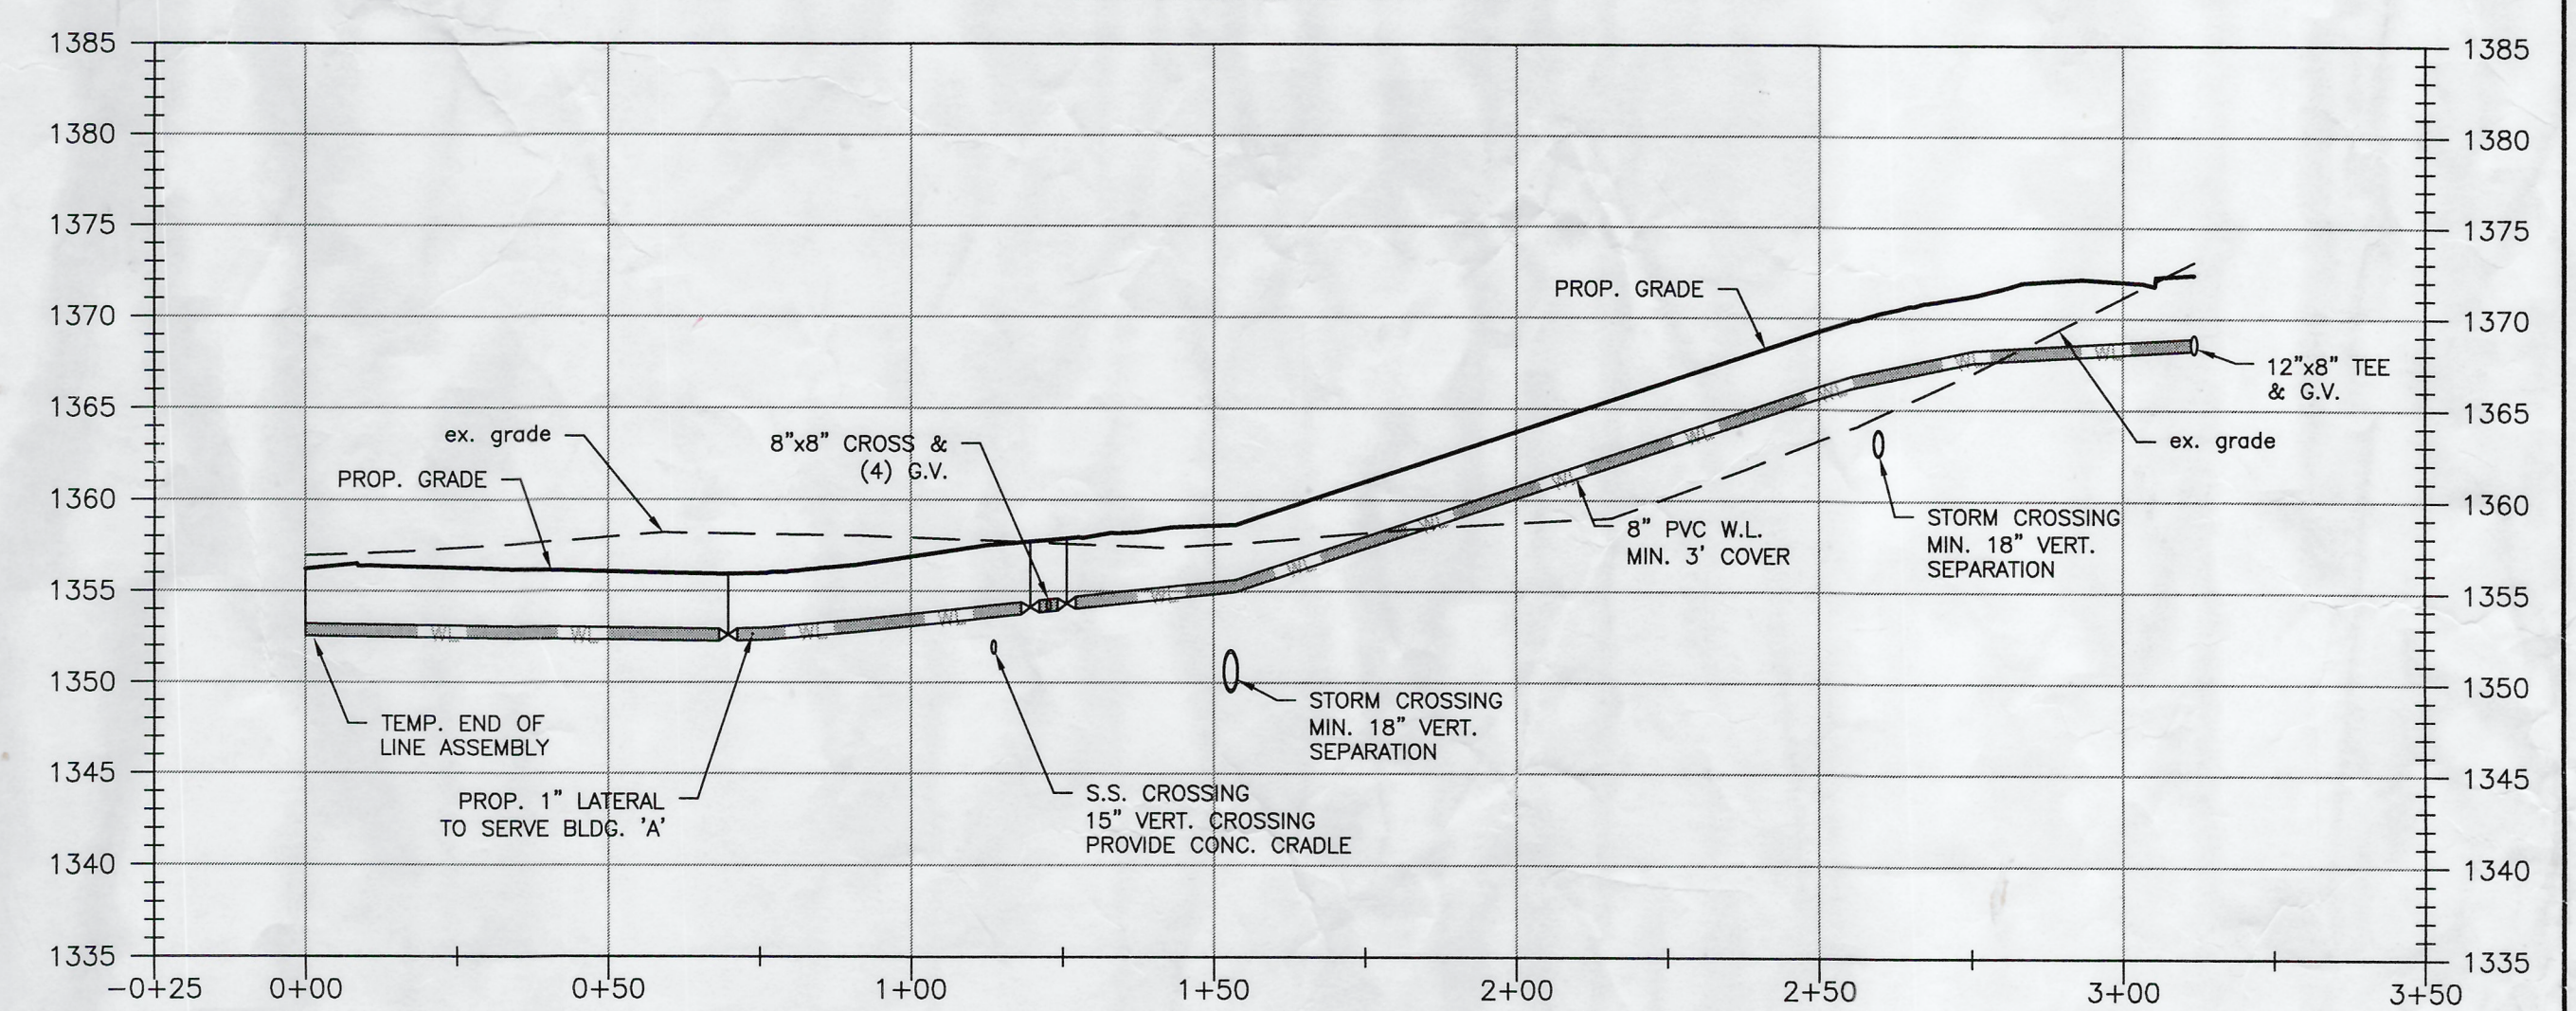

FIELDSTONE PHASE I

UTILITY PROFILES

AMSTERDAM DISTRICT
BOYD COUNTY, VIRGINIA

DRAWN BY: CLL
DESIGNED BY: CPB
CHECKED BY: CPB
DATE: 1/25/2019
SCALE: AS NOTED

REVISIONS
4/30/2019
10/8/2019
12/5/2019
10/14/2020
2/11/2021
3/28/2023

C17
PROJECT NO: 04170078.01