
DEVELOPMENT PLAN FOR

SITUATED IN CAVE SPRING MAGISTERIAL DISTRICT ROANOKE COUNTY, VIRGINIA

DATE: 12 SEPTEMBER 2003 7 JUNE 2004 (AS-BUILT) PREPARED FOR

FINK'S JEWELERS, INC.

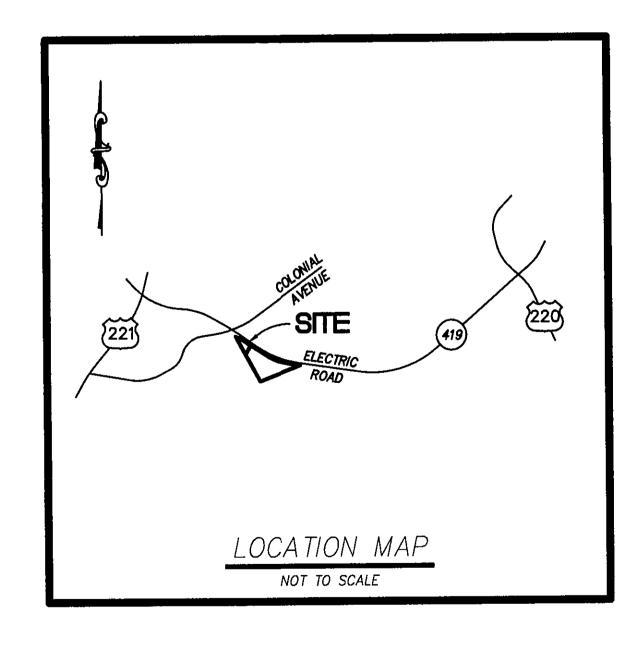

--INDEX OF DRAWINGS--

SHEET No.

DESCRIPTION

- 1. . . . LUMSDEN ASSOCIATES COVER SHEET 2.... ROANOKE COUNTY STANDARD COVER SHEET
- 3. NOTES AND DETAILS
- . . . DIMENSIONAL LAYOUT
- . . . GRADING PLAN PROFILES
- . . . LANDSCAPE PLAN
- EROSION AND SEDIMENT CONTROL PLAN 9. EROSION AND SEDIMENT CONTROL NOTES

AND DETAILS


I AM CERTIFIED BY THE STATE OF VIRGINIA AS A "RESPONSIBLE LAND DISTURBER". I SHALL BE RESPONSIBLE FOR THE IMPLEMENTATION OF THE EROSION AND SEDIMENT CONTROL PLAN AS SHOWN.

SIGNATURE:	
PRINTED NAME:	B. LEE HENDERSON, JF.
CERTIFICATE No.:	VA #17591
EXPIRATION DATE: .	7-30-04
TELEPHONE No.:	540 - 774-4411
ADDRESS:	4664 BRAMBLETON AVE.
ADDRESS	ROANOKE, VA ZHOIB



4664 BRAMBLETON AVENUE, SW P.O. BOX 20669 ROANOKE, VIRGINIA 24018

PHONE: (540) 774-4411 FAX: (540) 772-9445 E-MAIL: MAIL@LUMSDENPC.COM

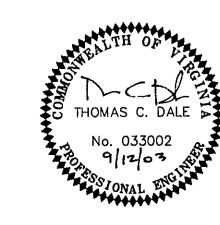

"AS-BUILT"

1. "AS BUILT" INFORMATION TAKEN FROM PLAN FURNISHED BY J. P. TURNER & BROTHERS, INC., GENERAL CONTRACTOR.

2. "AS-BUILT" DIMENSIONS SHOWN IN BRACKETS

				_
COMMISSIO	N N		003	_
SHEE	T	1	OF	-

DATE SHEETS 6/7'34 "AS-BUILT