
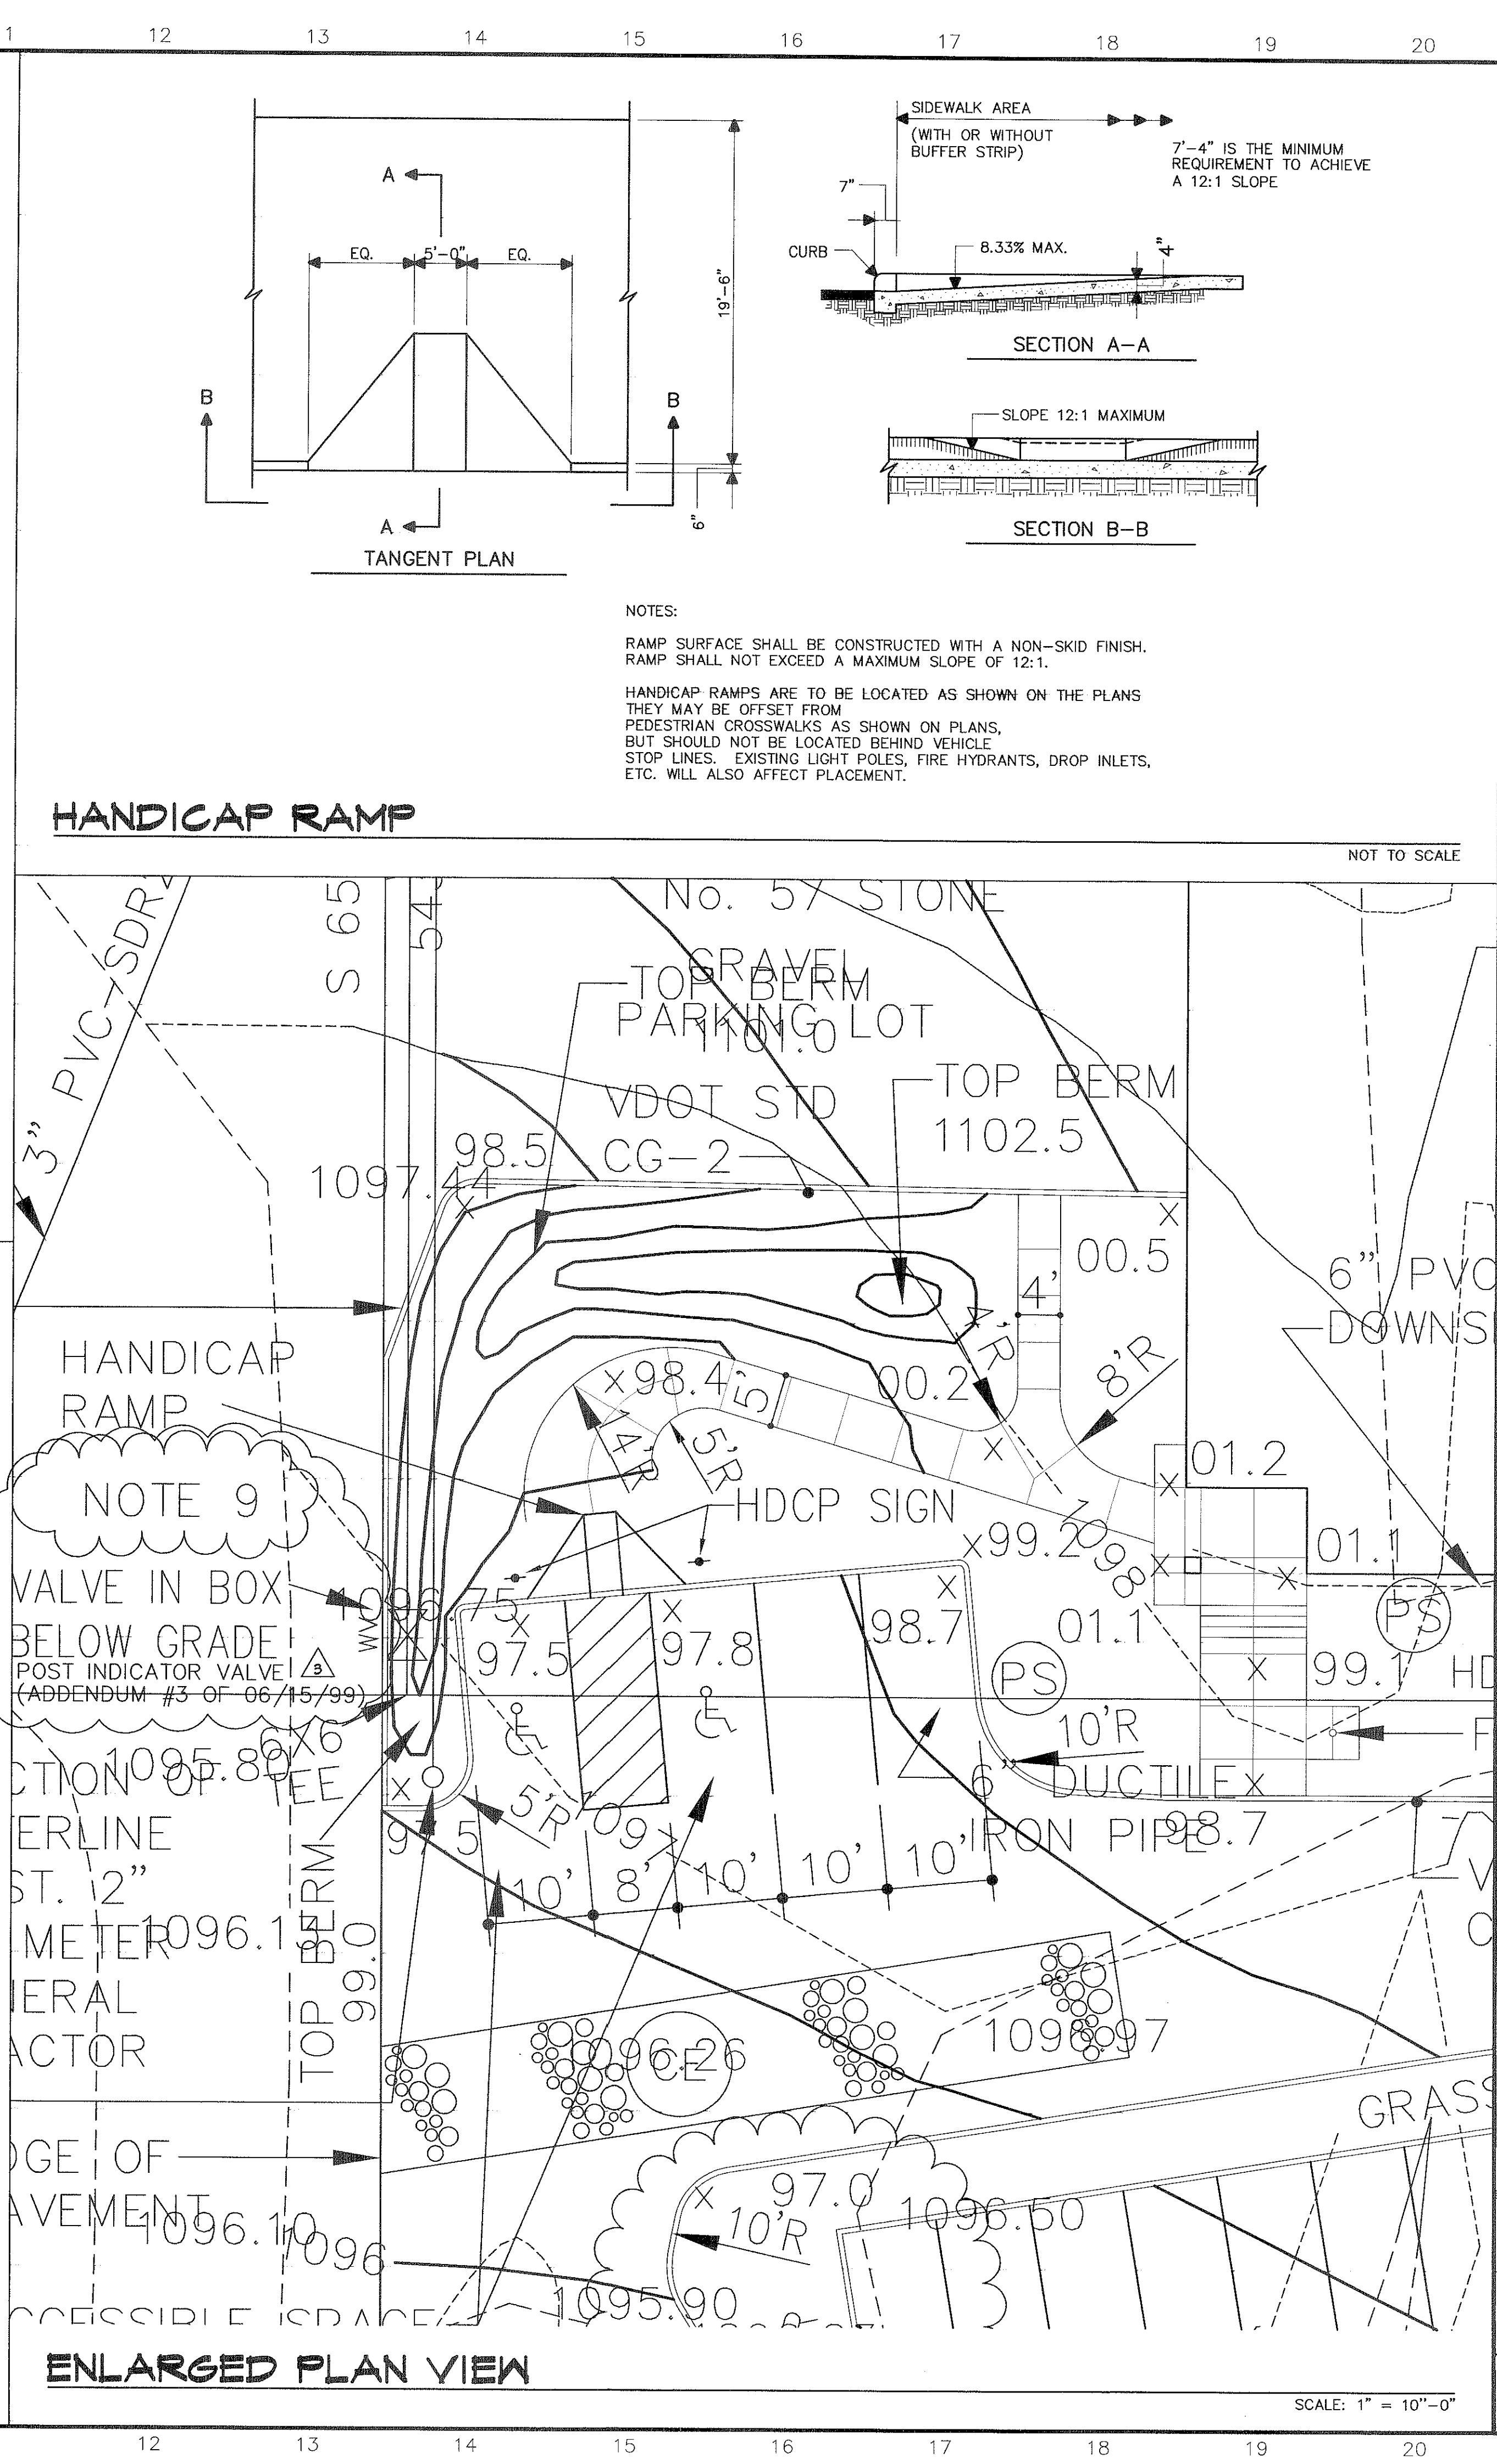
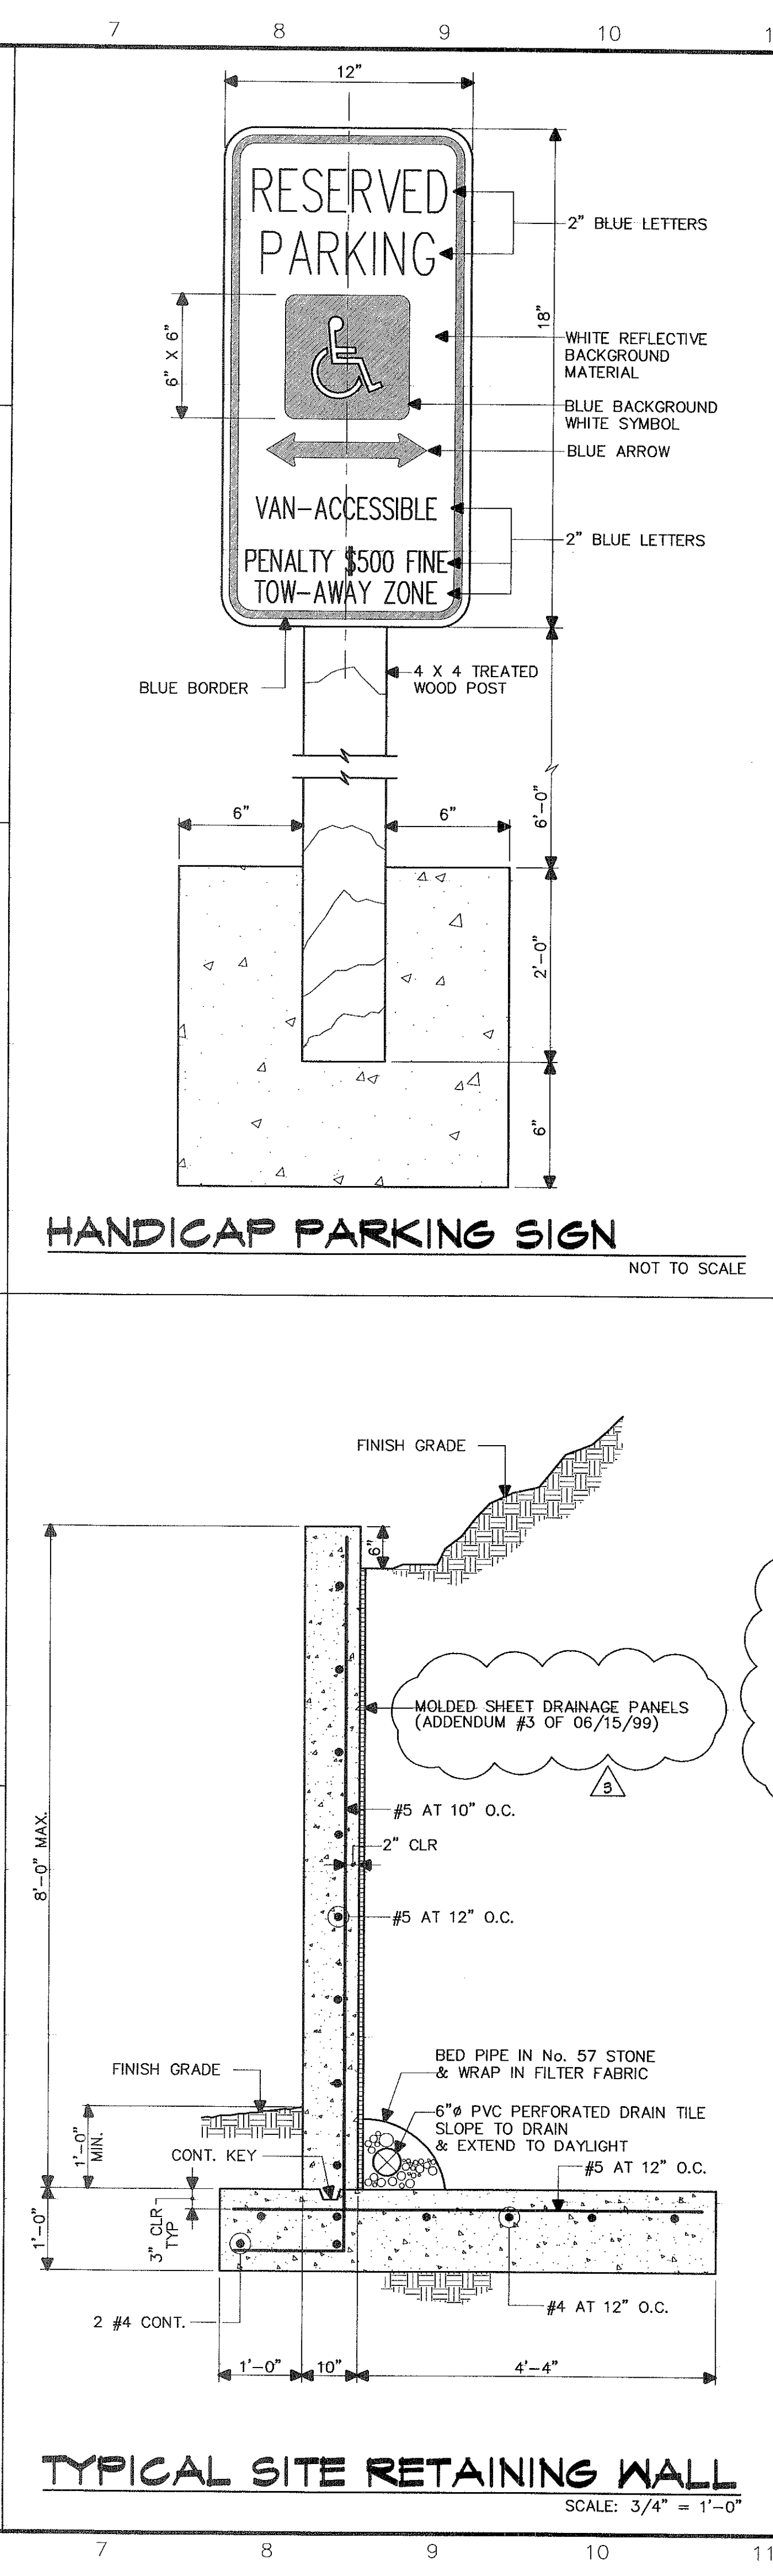


PLOT DATE: 05/19/99 PLOT TIME: 22:23

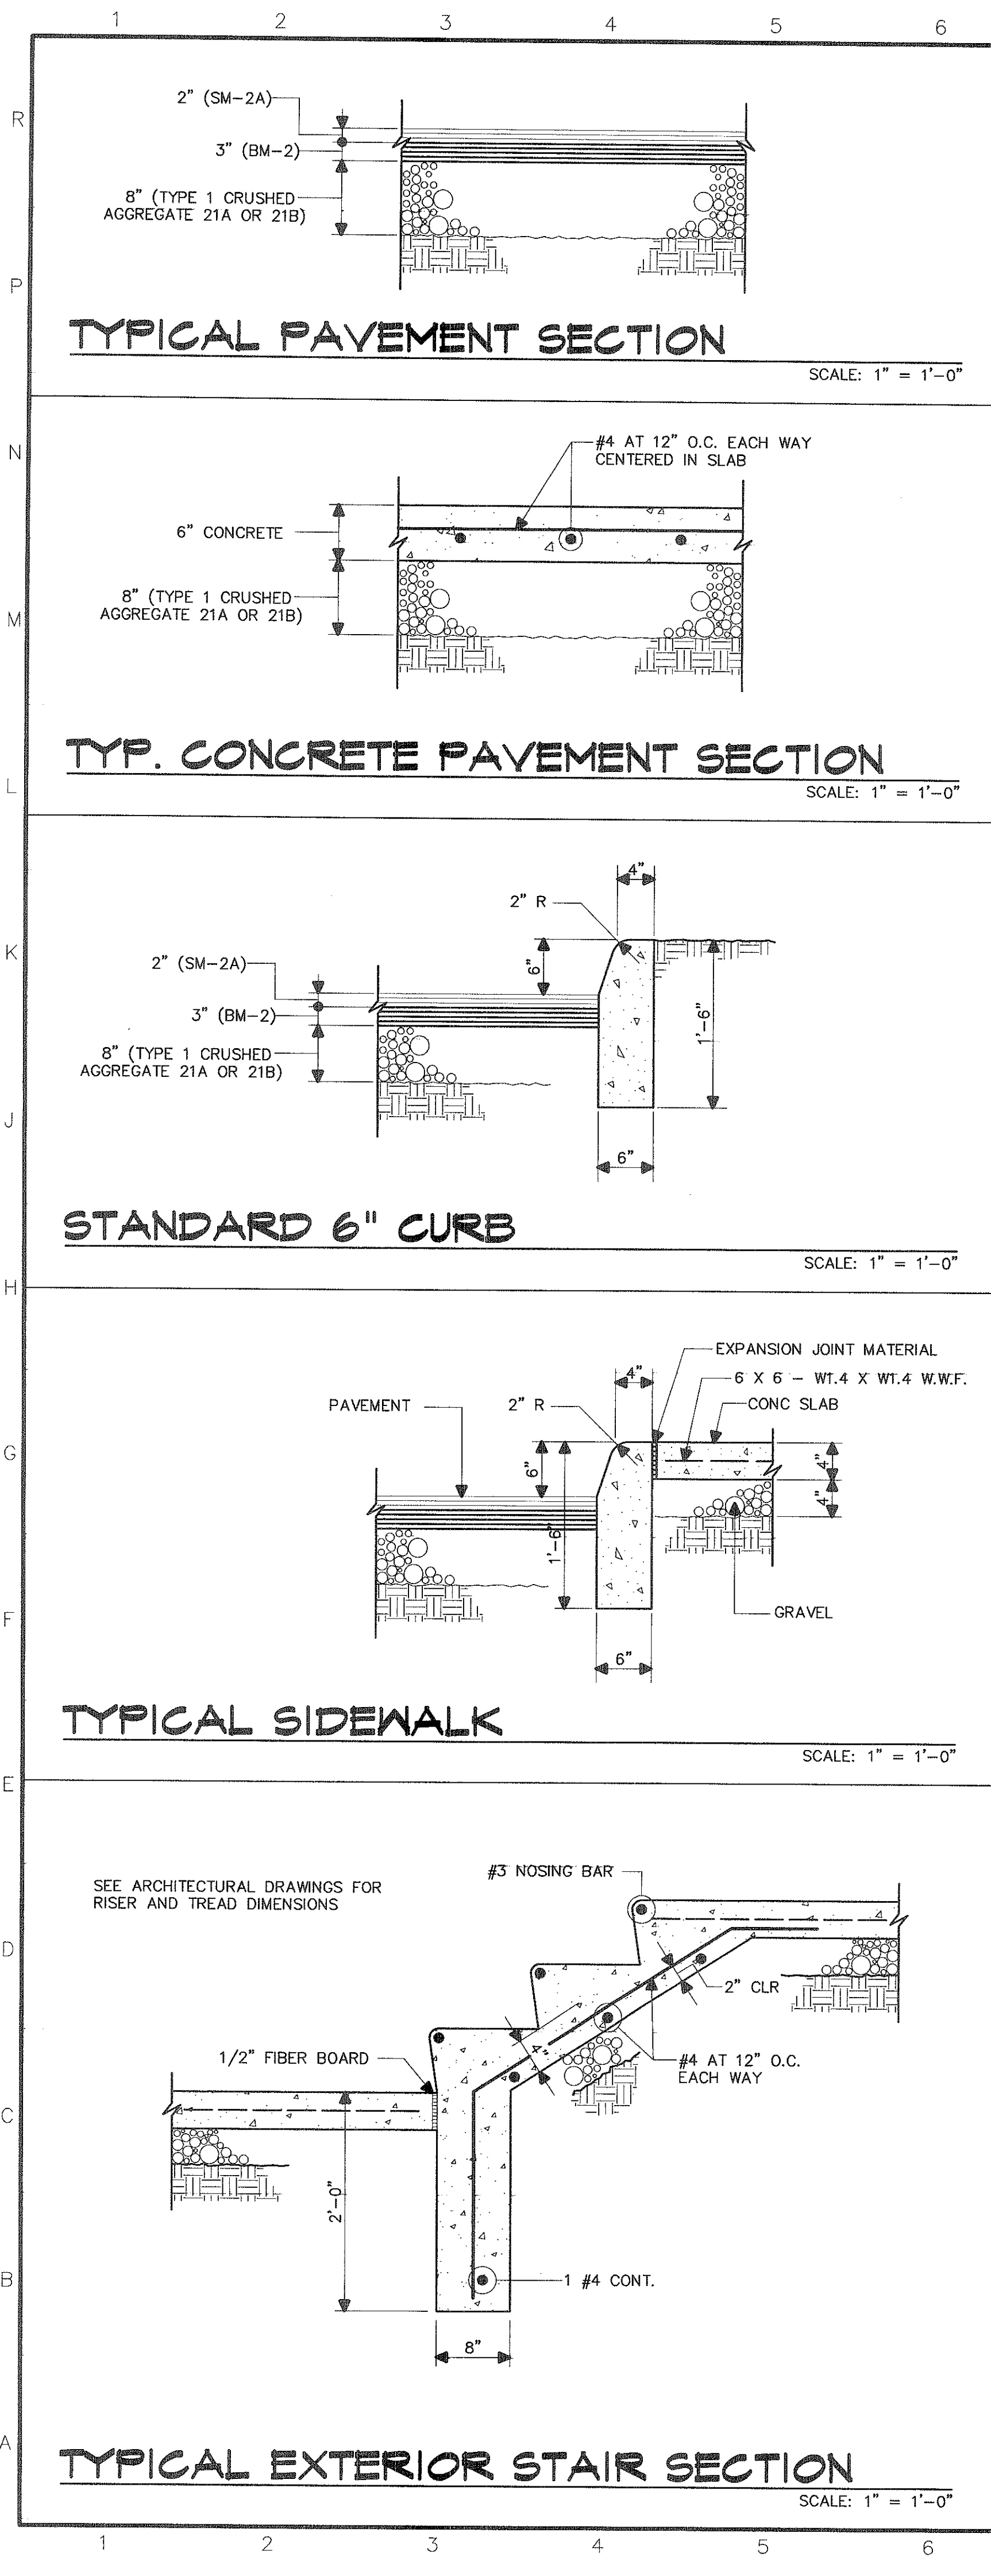

MarshWitt

MarshWitt Associates, P.C.
Architecture
Planning
Value Analysis

315 King George Ave. SW
Roanoke, VA 24016
Phone: 540 982 1444
Fax: 540 982 0300
email: marshwitt@ver.net

CONSULTANTS:
D W Day-Williams Consulting Engineers, P.L.L.C.
3239 Electric Road, Bldg. C
Roanoke, Virginia 24018
Phone (540)774-5706
Fax (540)772-3266
COMM. NO. 98-320

ROANOKE VALLEY
FIRE / EMS
REGIONAL
TRAINING
CENTER

ROANOKE COUNTY,
VIRGINIA
AS BUILTS

COMM. NO:	9826	
DESIGNED BY:	JFK	
DRAWN BY:	MLD	
CHECKED BY:	JFK	
PLOT SCALE:	1" = 1'	
COPYRIGHT MARSHWITT ASSOCIATES P.C. 1998		
3	06/15/99	PER ADDENDUM #3
	05/03/99	BID
CMK	DATE	DESCRIPTION

SHEET TITLE:
SITE DETAILS
AS BUILTS

C-601

SHEET 10 OF 55

0"1"2"