

MENU

CADD VERSION


PLOT SCALE


PLOT DATE 8/21/2018 4:28:55 PM

SAVE DATE

COMM NO.

DRAWING NO.

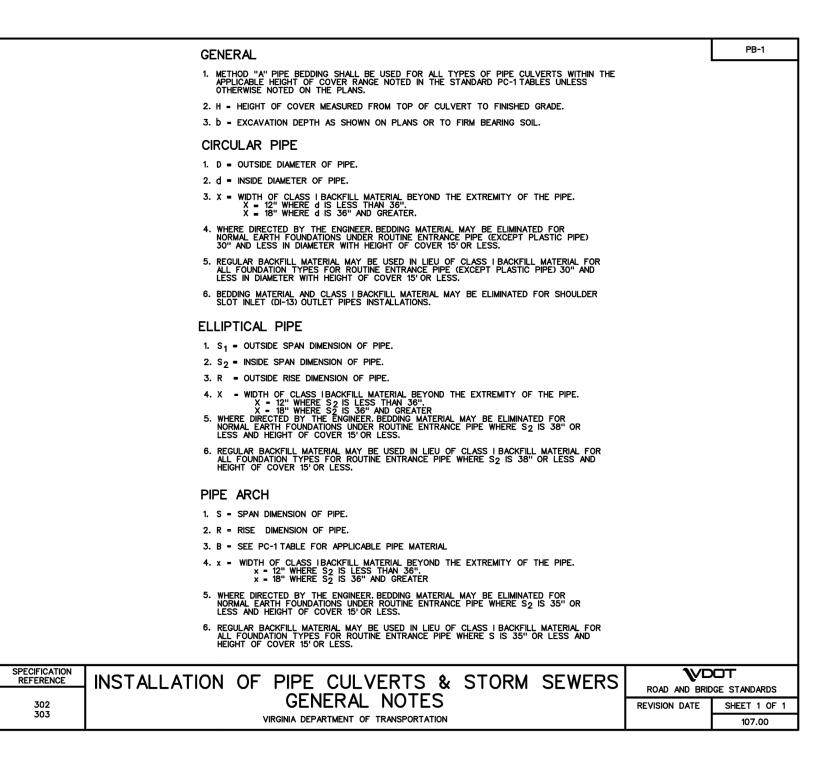


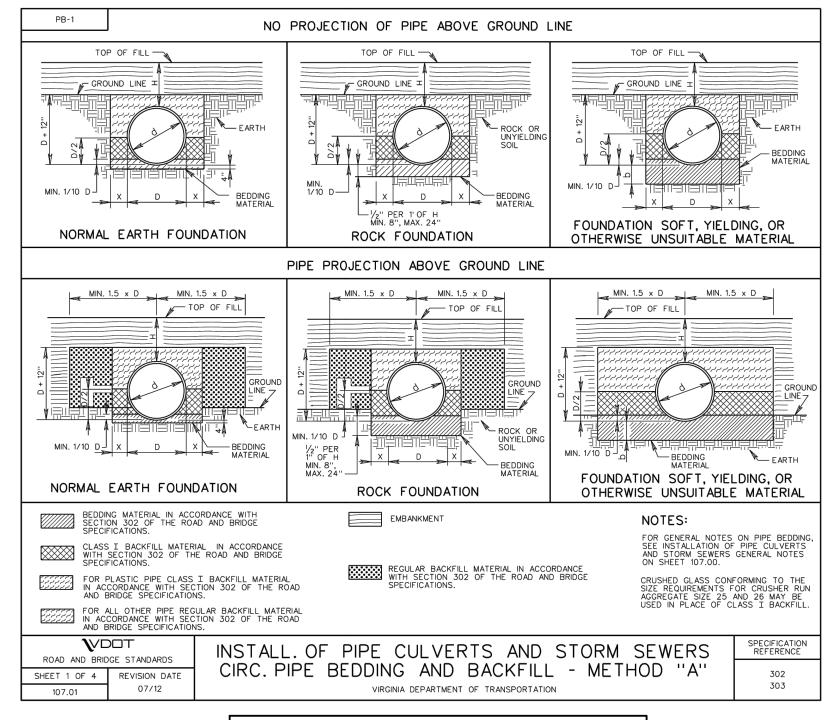

NOTE: CLASS I BACKFILL SHALL BE CRUSHER RUN AGGREGATE SIZE NO. 25 OR 26, AGGREGATE BASE MATERIAL SIZE 21A OR 21B, FLOWABLE FILL, OR CRUSHED GLASS CONFORMING TO THE SIZE REQUIRED FOR CRUSHER RUN AGGREGATE SIZE 25 AND 26.

STORM DRAINAGE GENERAL NOTES:

- 1. STORM DRAINAGE PIPE AND DRAINAGE STRUCTURES SHALL COMPLY WITH ALL APPLICABLE VDOT STANDARDS AND SPECIFICATIONS. REFER TO "INSTALLATION OF PIPE CULVERTS & STORM SEWER GENERAL NOTES" AND DETAILS SHOWN ON VDOT STD. PB-1 ON THIS SHEET FOR ADDITIONAL INFORMATION.
- 2. THE INVERT OF ALL NEW STORM DRAINAGE INLETS AND MANHOLES SHALL CONFORM TO VDOT STD. IS-1 "STANDARD METHOD OF SHAPING MANHOLE AND INLET INVERTS." REFER TO DETAIL ON THIS
- 3. STORM DRAIN PIPE LENGTHS SHOWN HEREON ARE APPROXIMATE HORIZONTAL DISTANCES FROM CENTER OF STRUCTURE TO CENTER OF STRUCTURE. PIPE SLOPES SHOWN ARE COMPUTED USING INVERT OUT AT UPSTREAM STRUCTURE, INVERT IN AT DOWNSTREAM STRUCTURE, AND HORIZONTAL PIPE LENGTH MEASURES FROM CENTER OF STRUCTURE TO CENTER OF STRUCTURE.
- 4. UPON COMPLETION OF THE STORM DRAINAGE SYSTEM, THE CONTRACTOR SHALL FURNISH TO THE OWNER A FIELD SURVEYED FINAL CORRECT SET OF AS-BUILT PLANS OF THE NEWLY CONSTRUCTED STORM DRAIN AND/OR STORMWATER MANAGEMENT FACILITIES. AS-BUILT PLANS SHALL BE PROVIDED IN THE STATE PLANE VIRGINIA SOUTH COORDINATE SYSTEM, NAD 1983, FIPS 4502 FEET, US SURVEY FEET, DATUM NA 83, IN THE FORM OF 1 PAPER COPY AND 1 DIGITAL AUTOCAD FILE.
- 5. CONTRACTOR SHALL SUBMIT STORM DRAINAGE STRUCTURE FABRICATION ORDER SHEETS TO ENGINEER FOR REVIEW AND APPROVAL PRIOR TO START OF FABRICATION.

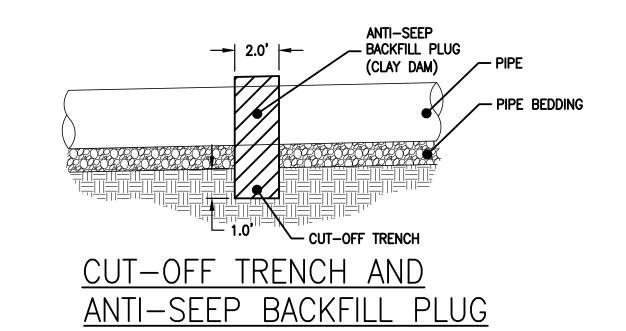

GENERAL NOTES

**ROANOKE FIRE-EMS STATION #7** BID SET


SFCS Inc. • 305 South Jefferson Street Roanoke, Virginia 24011.2003 540.344.6664 • Fax 540.343.6925 www.sfcs.com


PROJECT DESIGNER PROJECT ARCHITECT : WTA WTA REVISION DESCRIPTION Addendum No. 4

Addendum No. 5

STORM DRAIN PROFILES AND DETAILS

FEBRUARY 20, 2019

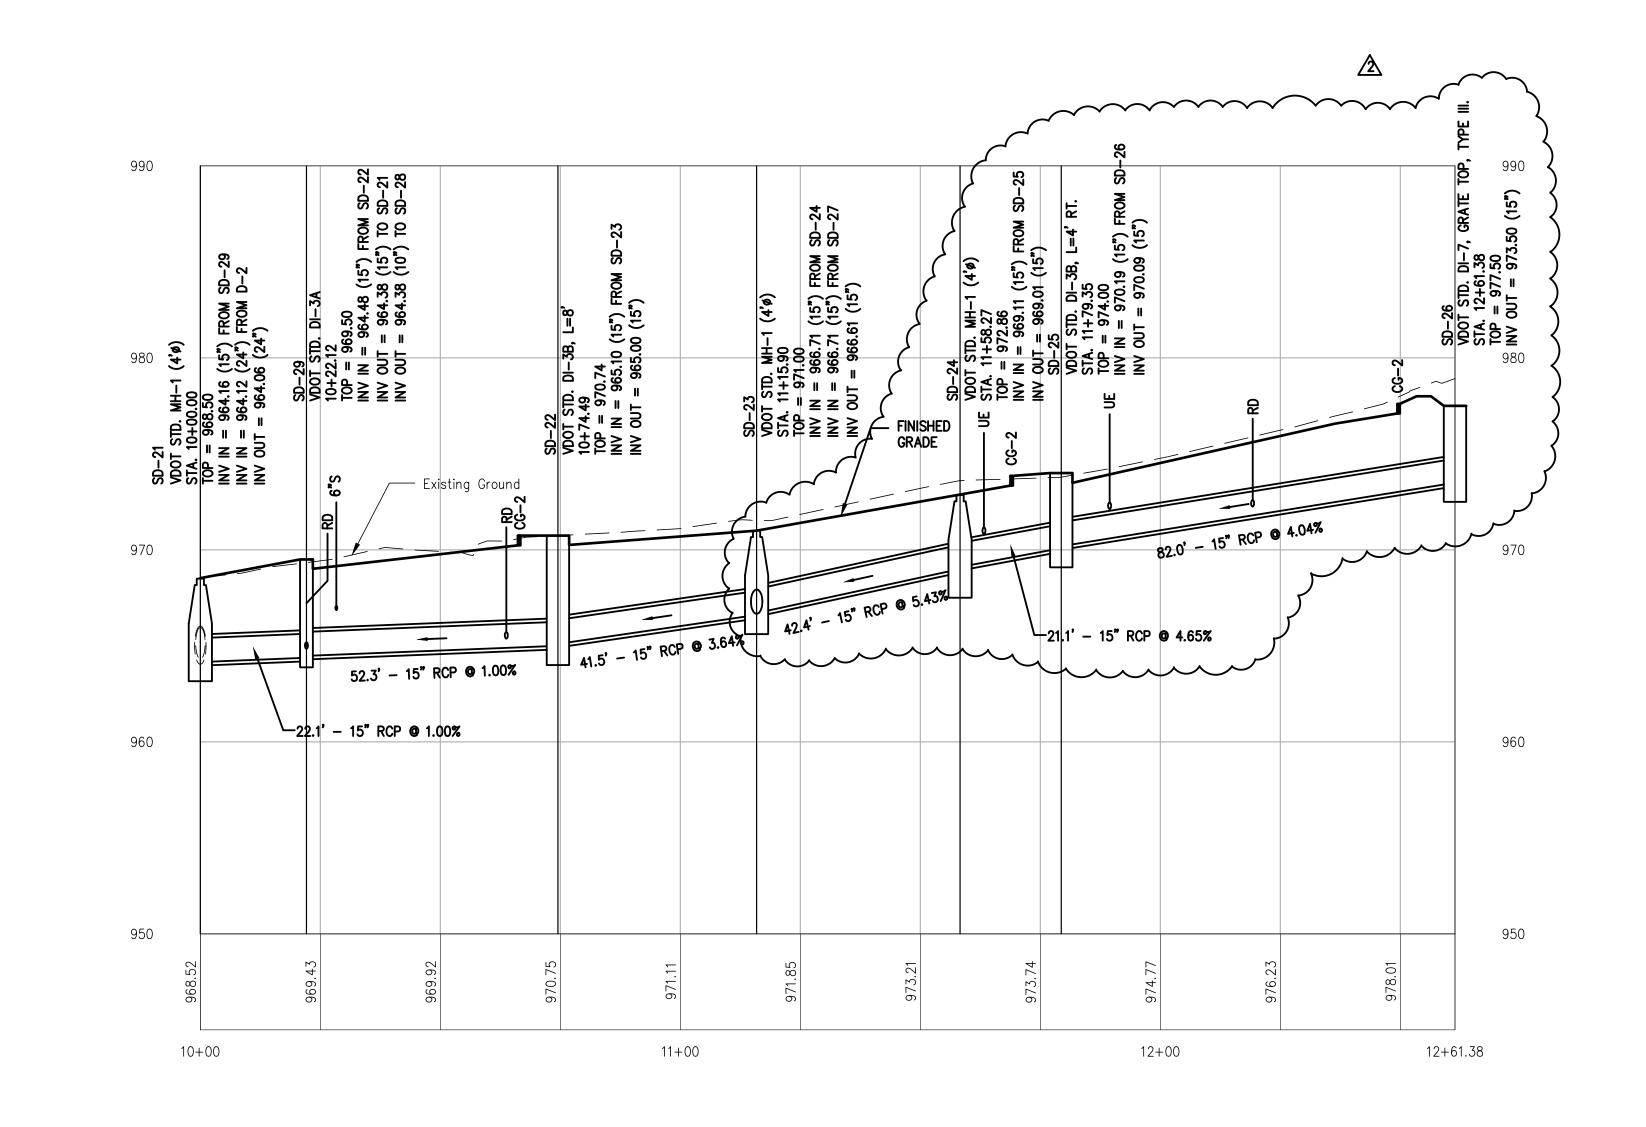

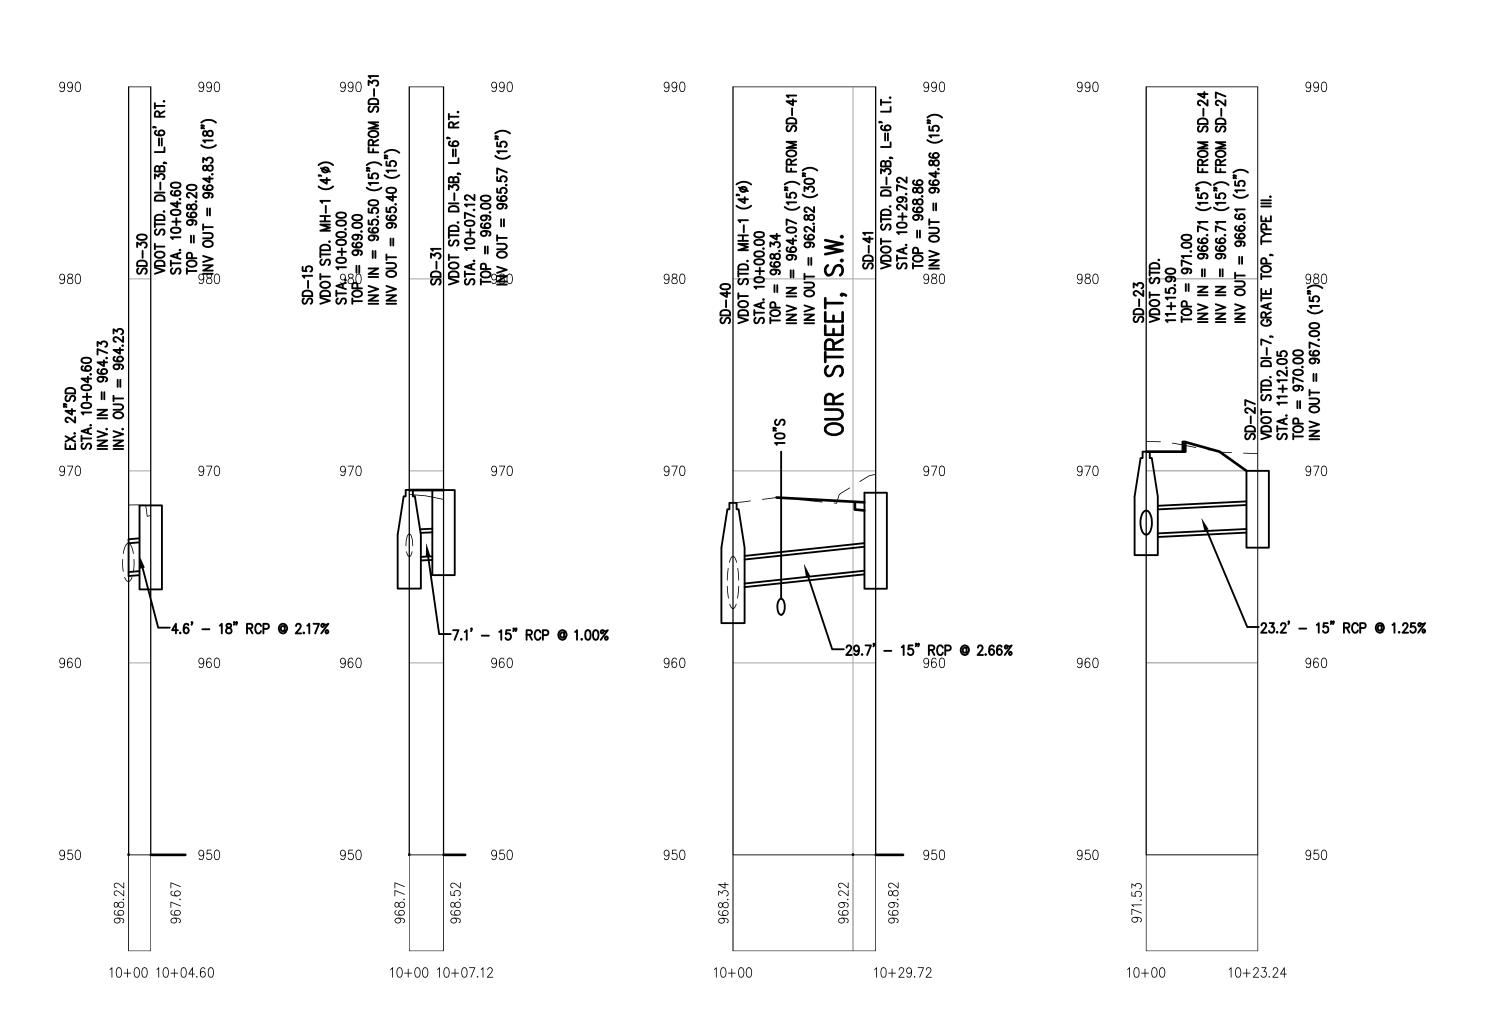

STORM DRAIN PROFILES SCALE: 1"= 20' HORIZ. 1"= 5' VERT.

