


First Team Hot Box
Auto 6520 Peters Creek Rd
Fire Box F.P.

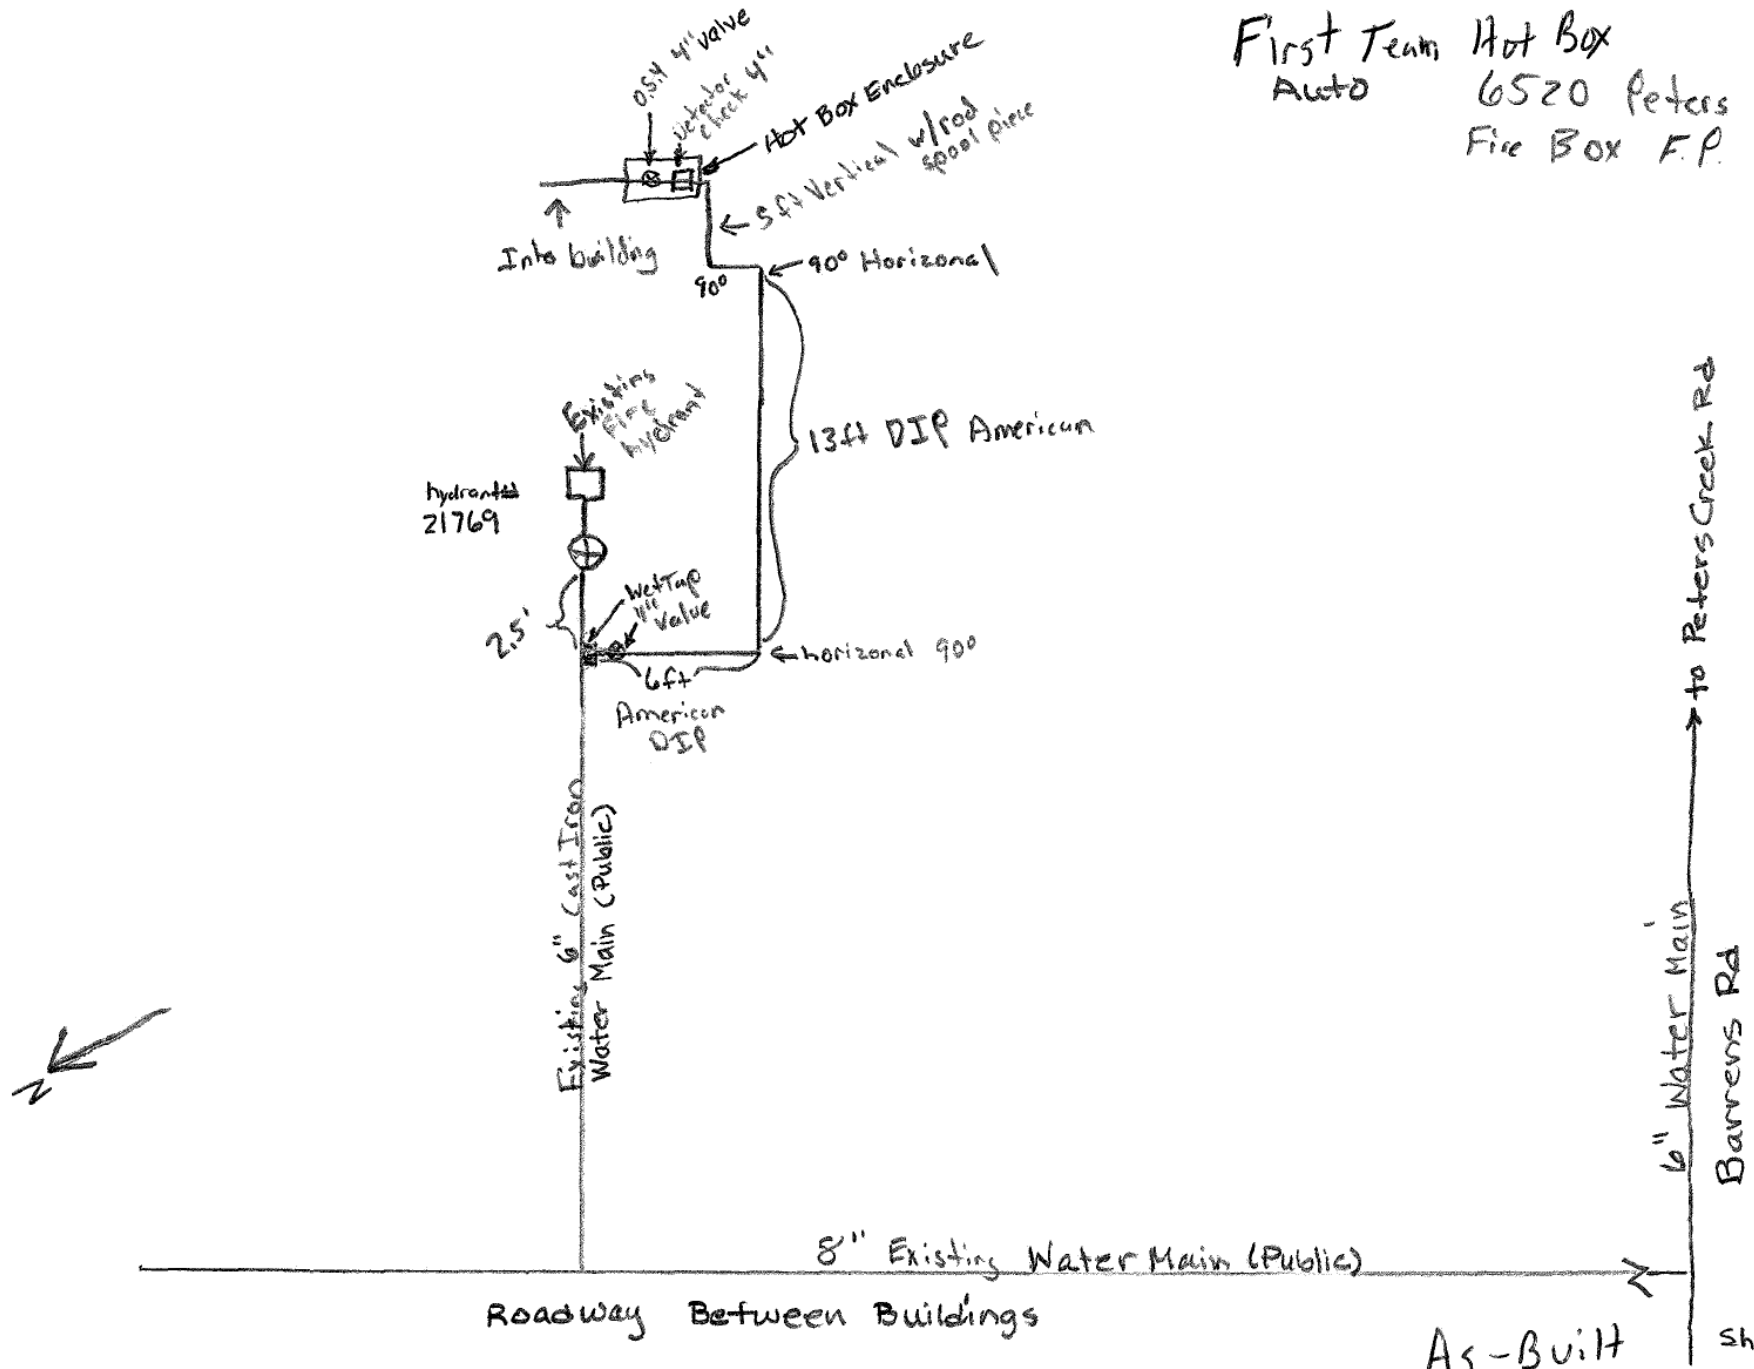

Not to Scale

Installed by Magic City Sprinkler

Substantial Completion 11/15/16

AS-BUILT

Sheet 1 of 2