


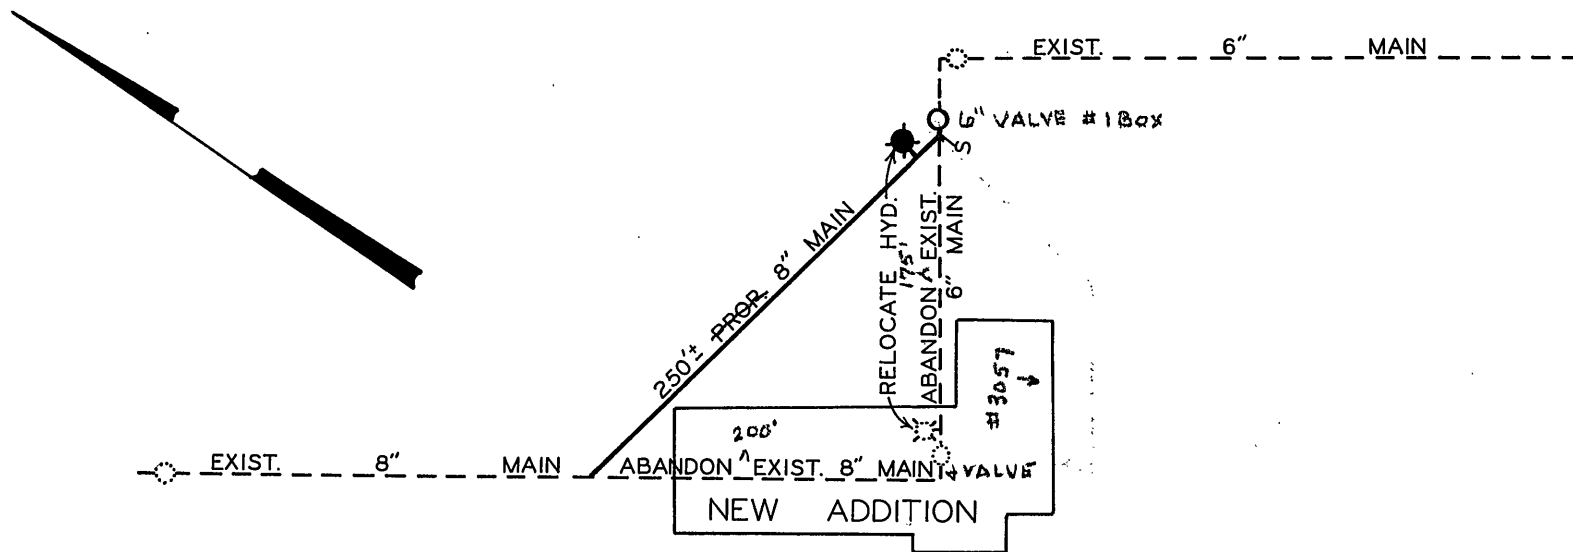

Colonial Avenue

AS-BUILT

DATE STARTED 1975				
DATE COMP. JULY 2 1975				
FEET MAIN	SIZE	VALVE	VAULT	BOX
250	8"			
	6"	1		1
F. H. COMP.				
F. H. STUB ONLY				
SERV. INS. BY: WEDDLE & WEDDLE				
MAIN INS. BY: "				
NO. 3/4" SERV. INS. 1-2"				
CITY OR CO. CITY				
DEPT. INSP. JAMES MOTLEY				

L. B. Lin
 DIRECTOR UTILITIES & OPERATIONS
Charles M. Smith
 CITY ENGINEER OF ROANOKE, VA.
Richard S. Surgen
 DIRECTOR OF PUBLIC WORKS
Lothar M. Mendenhall
 AGENT FOR ROANOKE PLANNING COMM.

1-10-75
 DATE
 1-10-75
 DATE
 1-13-75
 DATE
 1-13-75
 DATE

McNeil Drive

Virginia Western Community College

WATER DEPARTMENT
 CITY OF ROANOKE, VA.
 FISHBURN PARK SCHOOL
 SCALE - 1"=100'
 DRAWN BY C.A.H. JAN. 8, 1975