


MATCH LINE STA 8+00 B'A' SEE SHEET #5

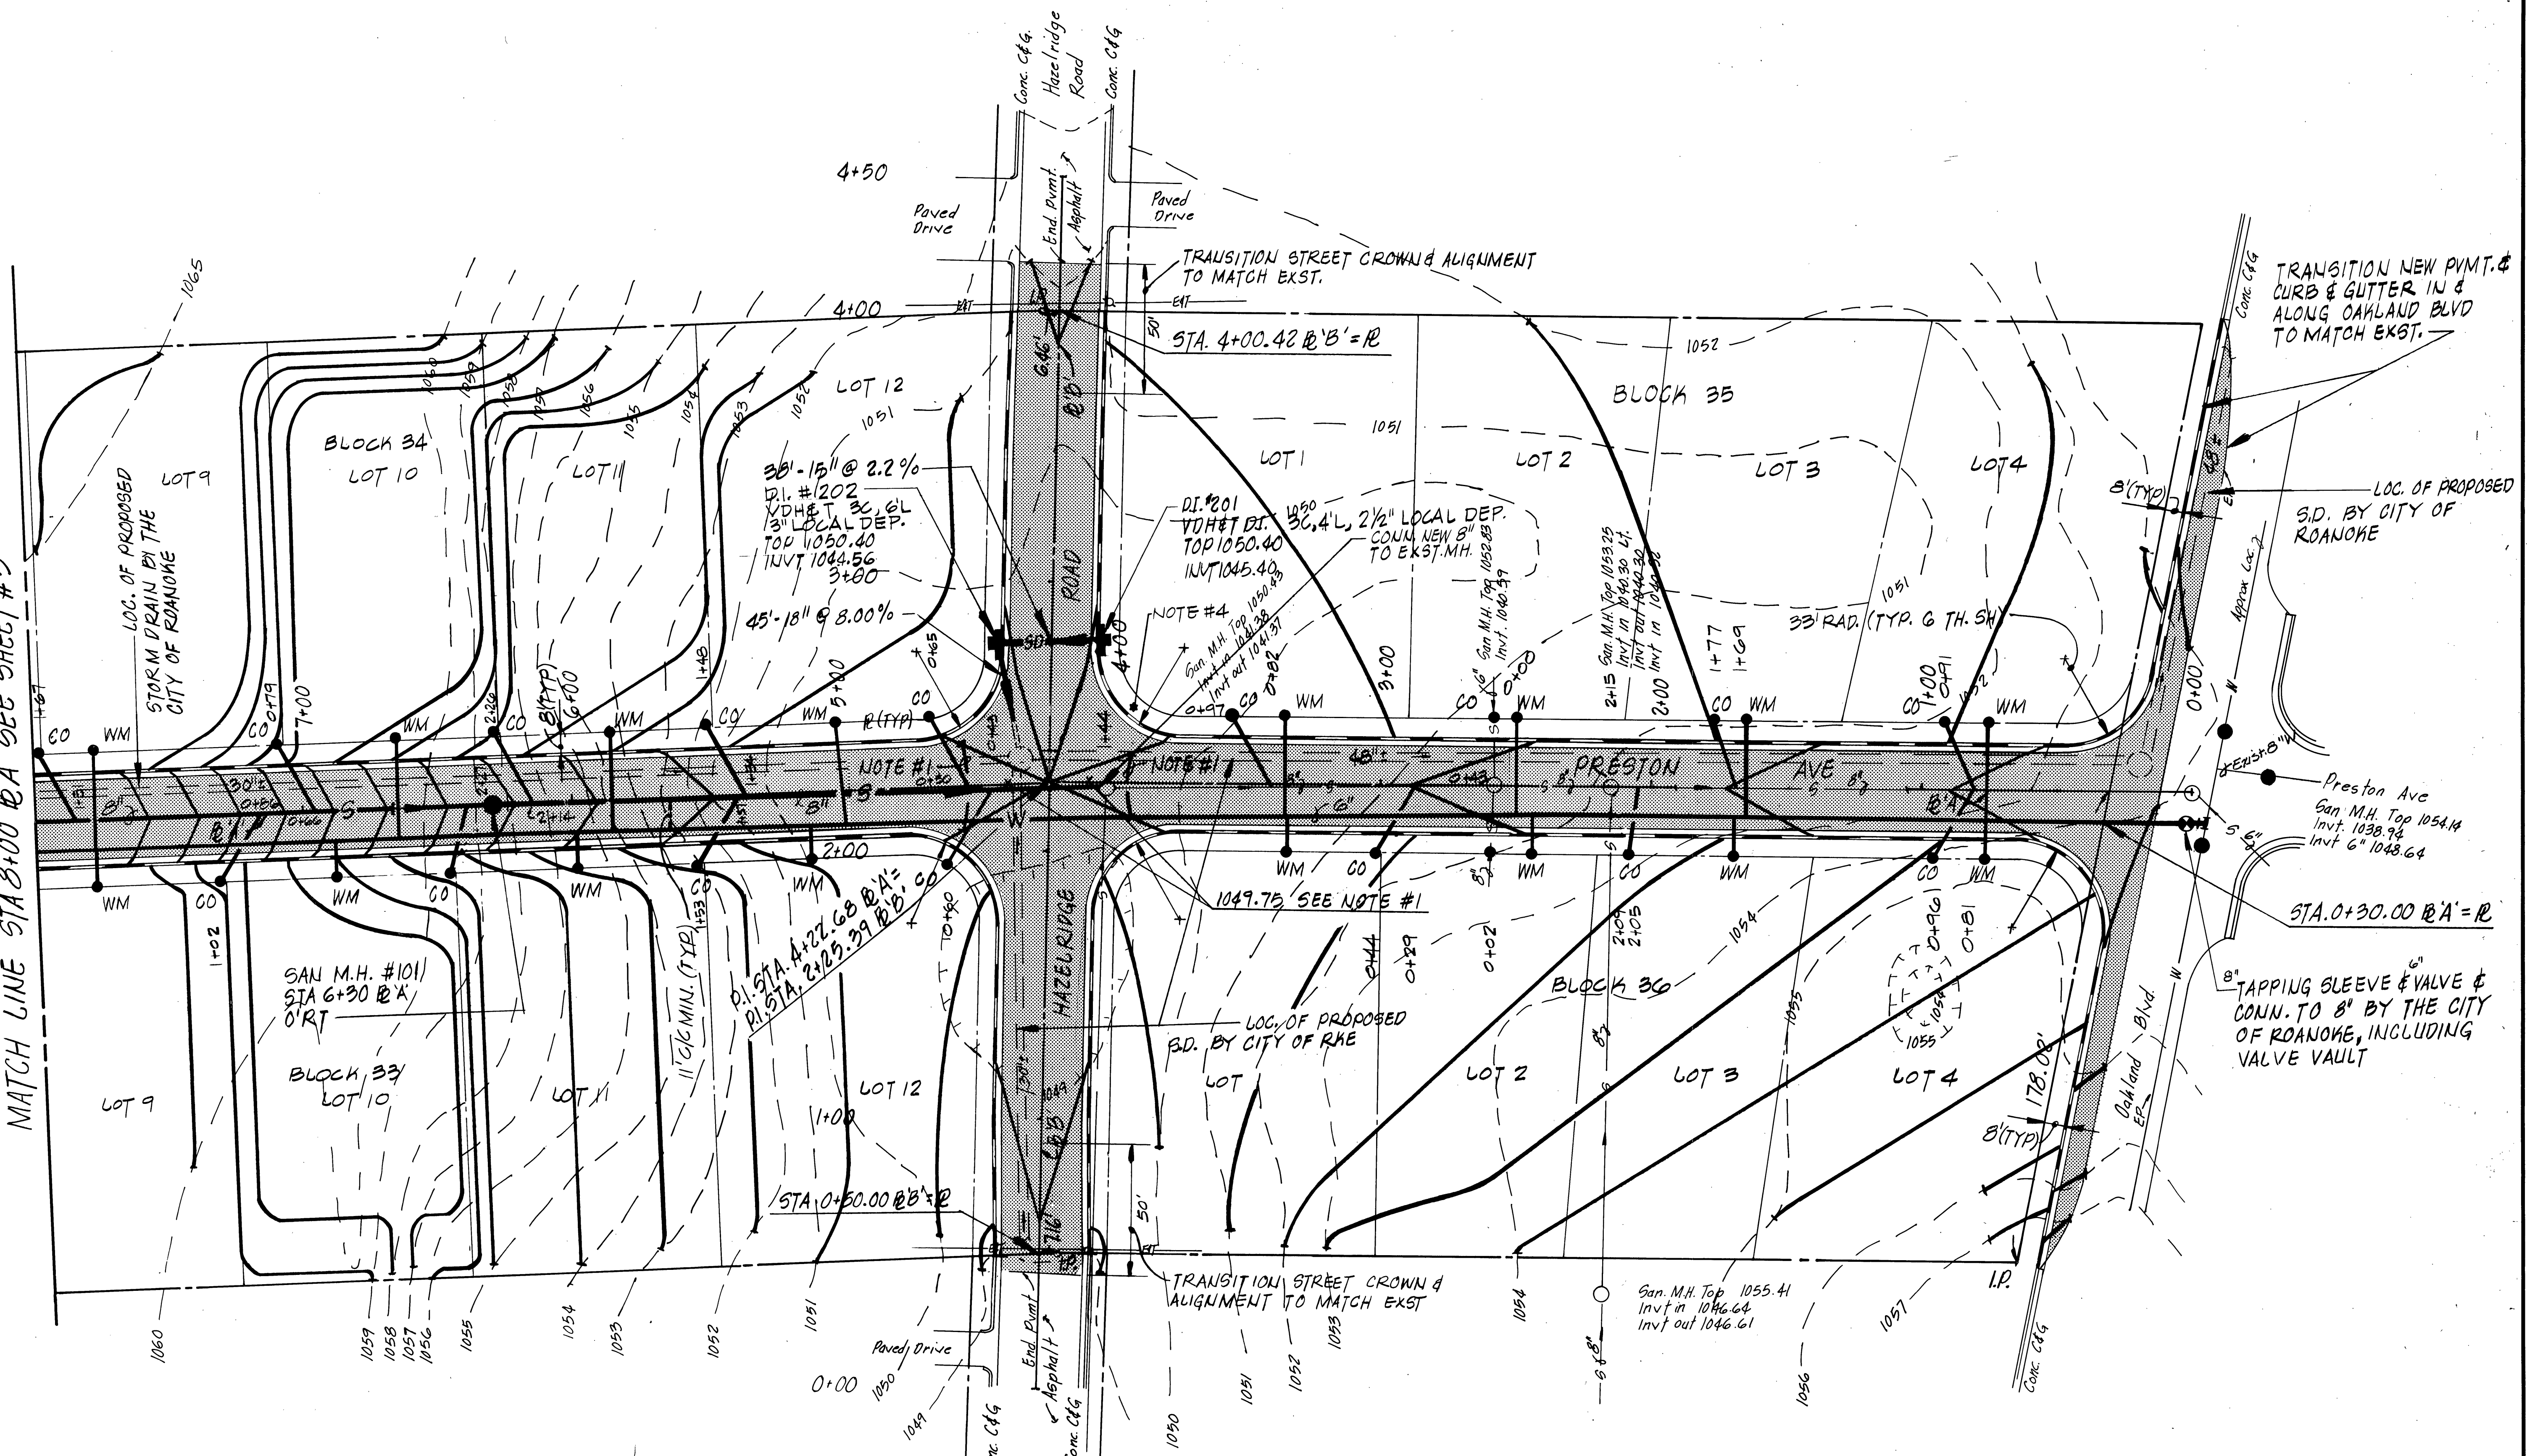

B.M. - ARROWHEAD ON TOP OF FHY
NEAR WINSLOE DR & FLEMING AVE;
EL. 1080.77

APPROVED: *Robert R. Tucker* 4/16/86
AGENT FOR ROANOKE CITY PLANNING COMMISSION DATE
Charles M. Hufner 6/12/86
CITY ENGINEER, CITY OF ROANOKE VIRGINIA DATE

- NOTES:
1. Contours and spot elevations noted are for temporary construction if street is built prior to main storm drain to be built by the City of Roanoke. If storm drain is in place street shall be built in accordance with new contours shown.
 2. Contours along Baseline 'A' Sta 0+00 to Sta 7+50 and along Baseline 'B' are taken from actual field survey, all other contours are taken from 1"=200' scale, 5' contour interval. Topographic maps prepared by American Air Surveys, Inc., Date 1961. Available from the Roanoke Valley Regional Planning and Economic Development Commission.
 3. DRIVEWAY CURB CUTS WILL BE LOCATED BY INDIVIDUAL PROPERTY OWNERS @ THE TIME OF CONSTRUCTION
 4. STREET SIGN PROVIDED BY THE CONTRACTOR
 5. ALL SAN. LATERALS SHALL BE 4"Ø

① SAN. SEWER PLUSES
LOT & BLOCK NUMBERS
WATER DEPT 86-19 AS-BUILT 2/15/86

DESIGNED	DRM	FLEMING OAKS	
DRAWN	DRM	SECTION 12A	
CHECKED		SITE PLAN	
APPROVED		GRADING, UTILITIES, AND STREET LAYOUT	
SUBMITTED			

REVISION	DATE	DESCRIPTION	BY	APP.
①	3-31-86	GENERAL BASED ON RKE CITY REVIEW	DRM	

SCALE: 1" = 30' COMM 521
DATE: MAR. 85 SHEET 4