
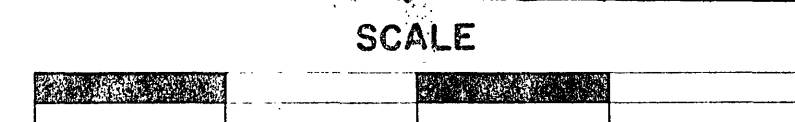


VICINITY MAP

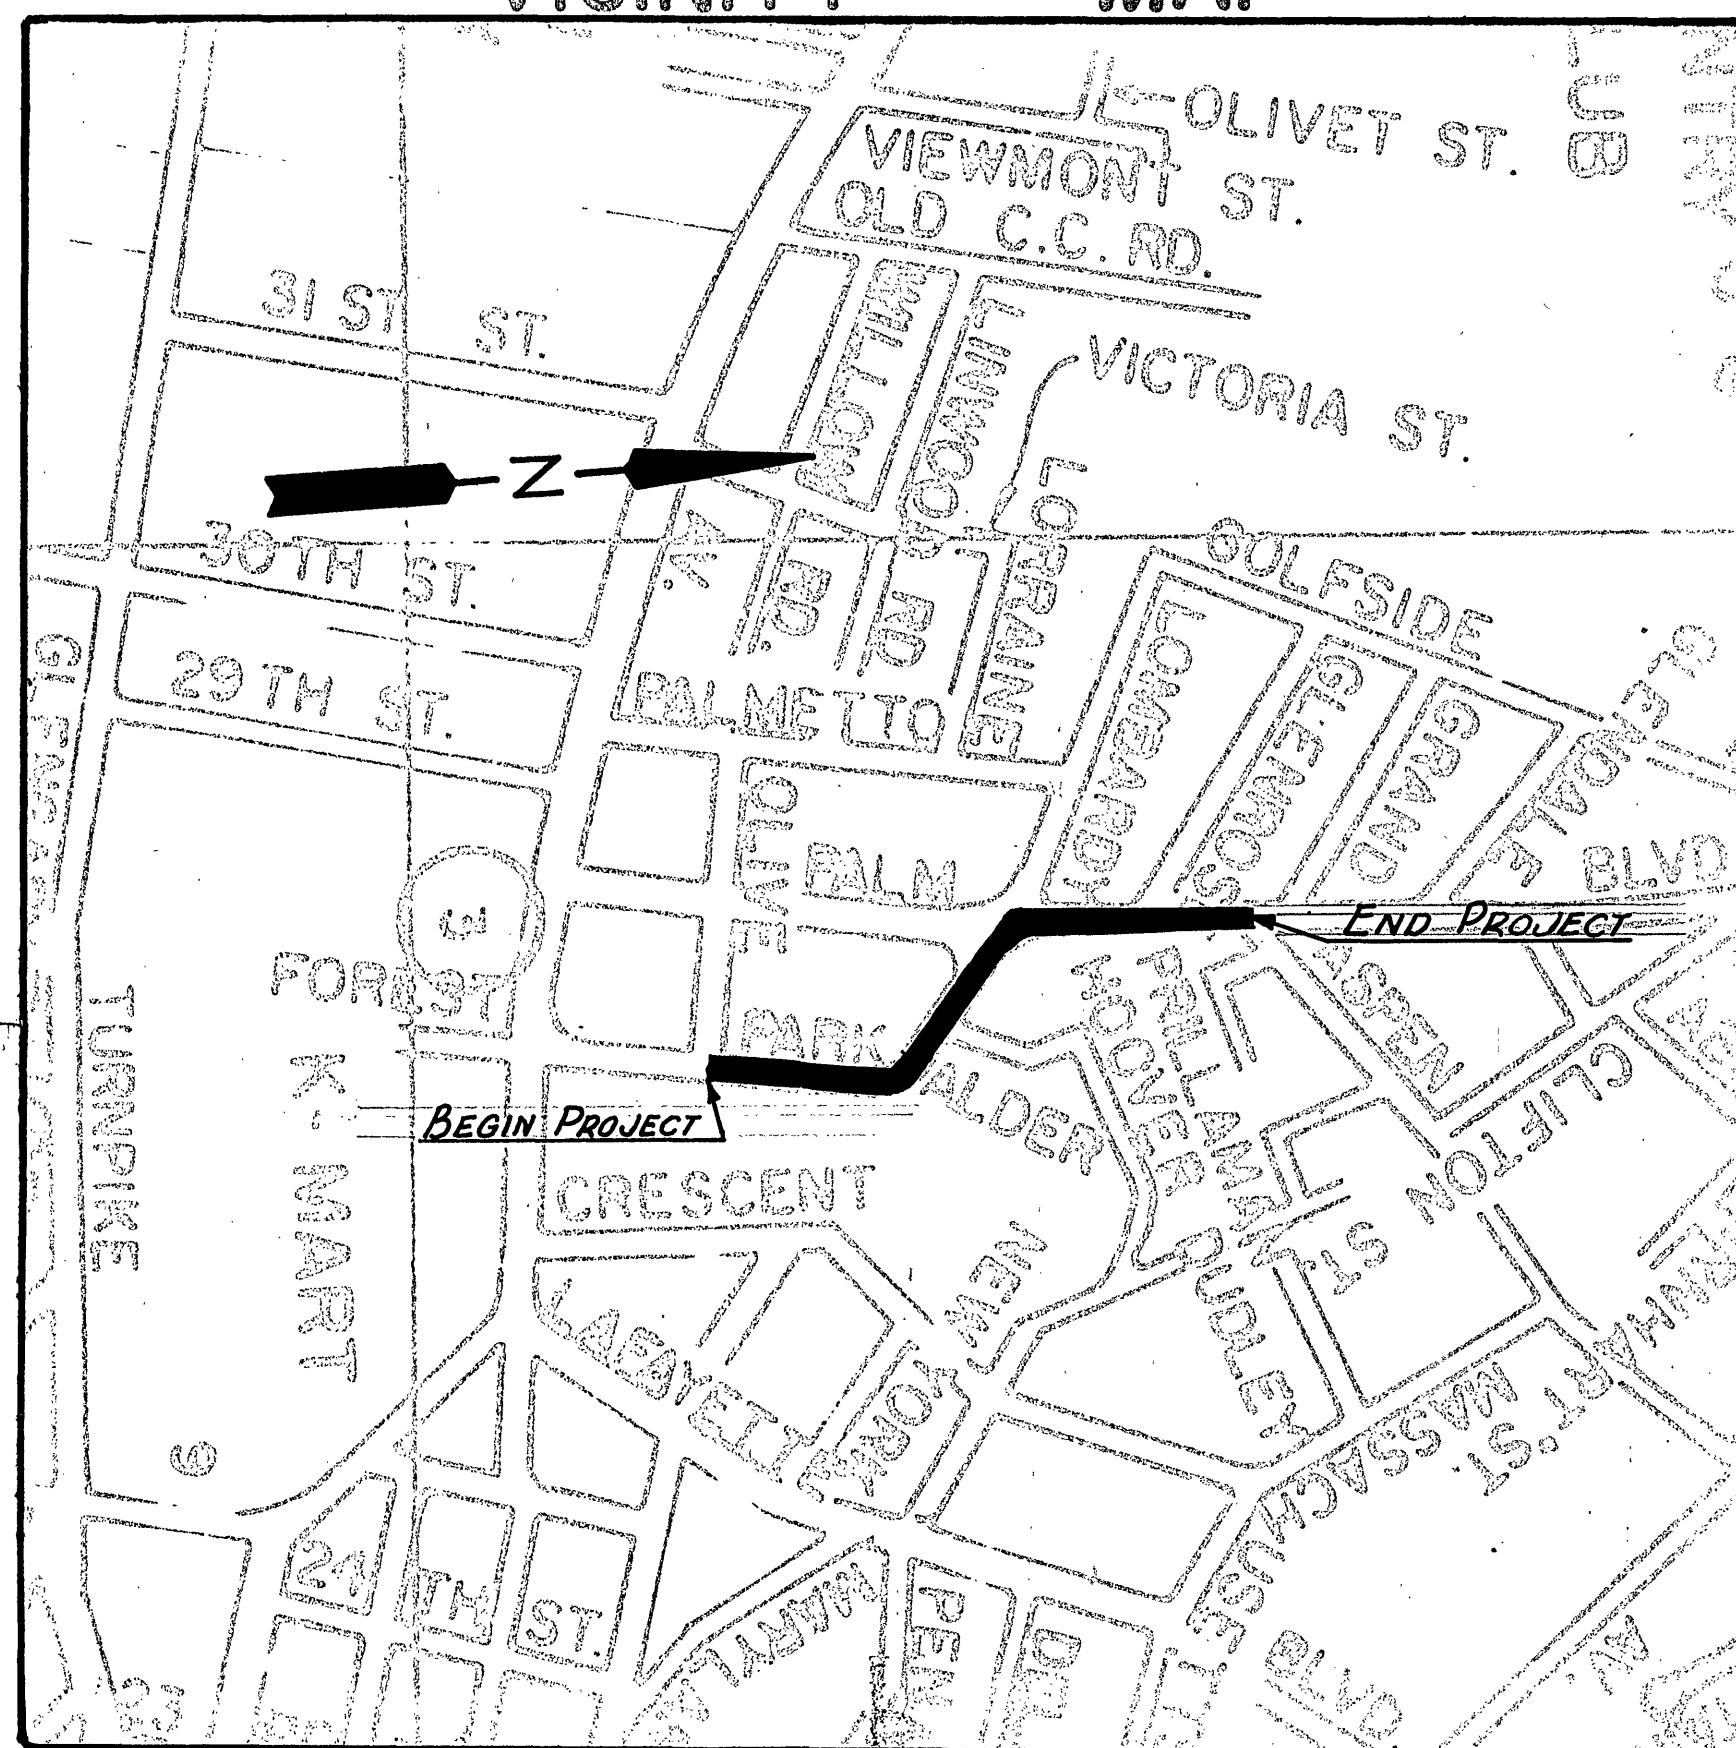

INDEX OF SHEETS

SHEET NO. -	DESCRIPTION
1	TITLE
2	QUANTITIES
3	PLAN & PROFILE
4	" "
5	" "

AS BUILT

FB. 581
PGS.



ROANOKE , VIRGINIA

OFFICE OF CITY ENGINEER

CONSTRUCTION PLAN

FOREST PARK BOULEVARD

REPLACEMENT SEWER

SHEET NO.	DATE	SHEET NO.	DATE
PLANS REVISED			

APPROVED FOR CONSTRUCTION	
04 25 1972 DATE	City Engineer CITY ENGINEER
DATE	
DATE	
APPROVED	
DATE	
APPROVED	
DATE	

SHEET 1 OF 5

PLAN NO. 5648