




IVY PARK DRIVE - ROAD PROFILE

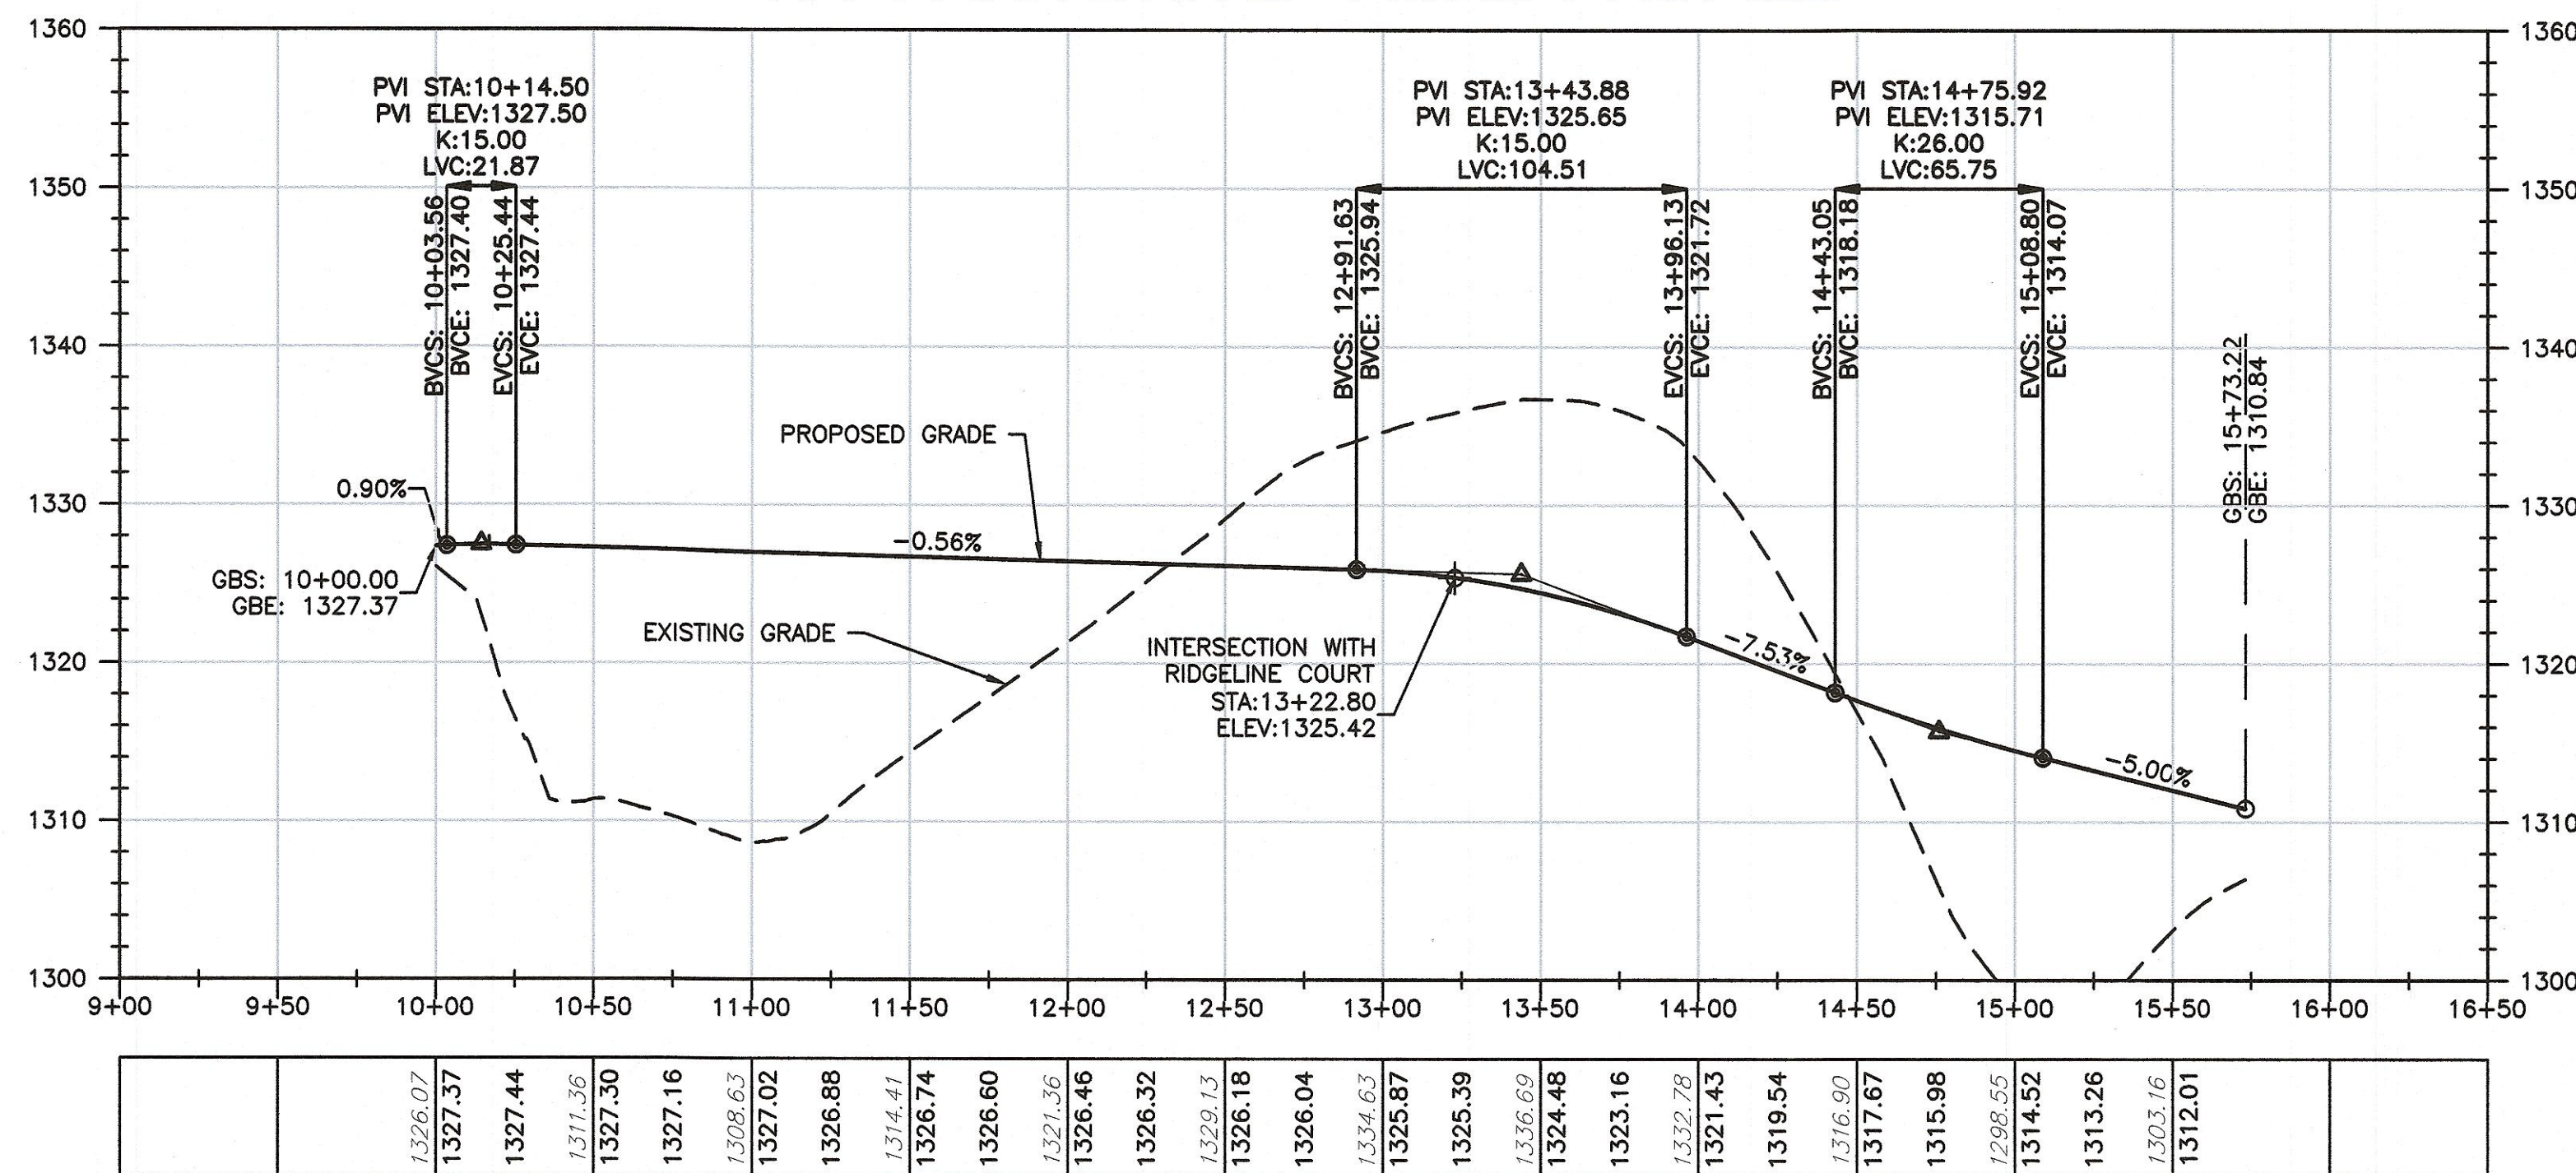


RIDGELINE COURT - ROAD PROFILE

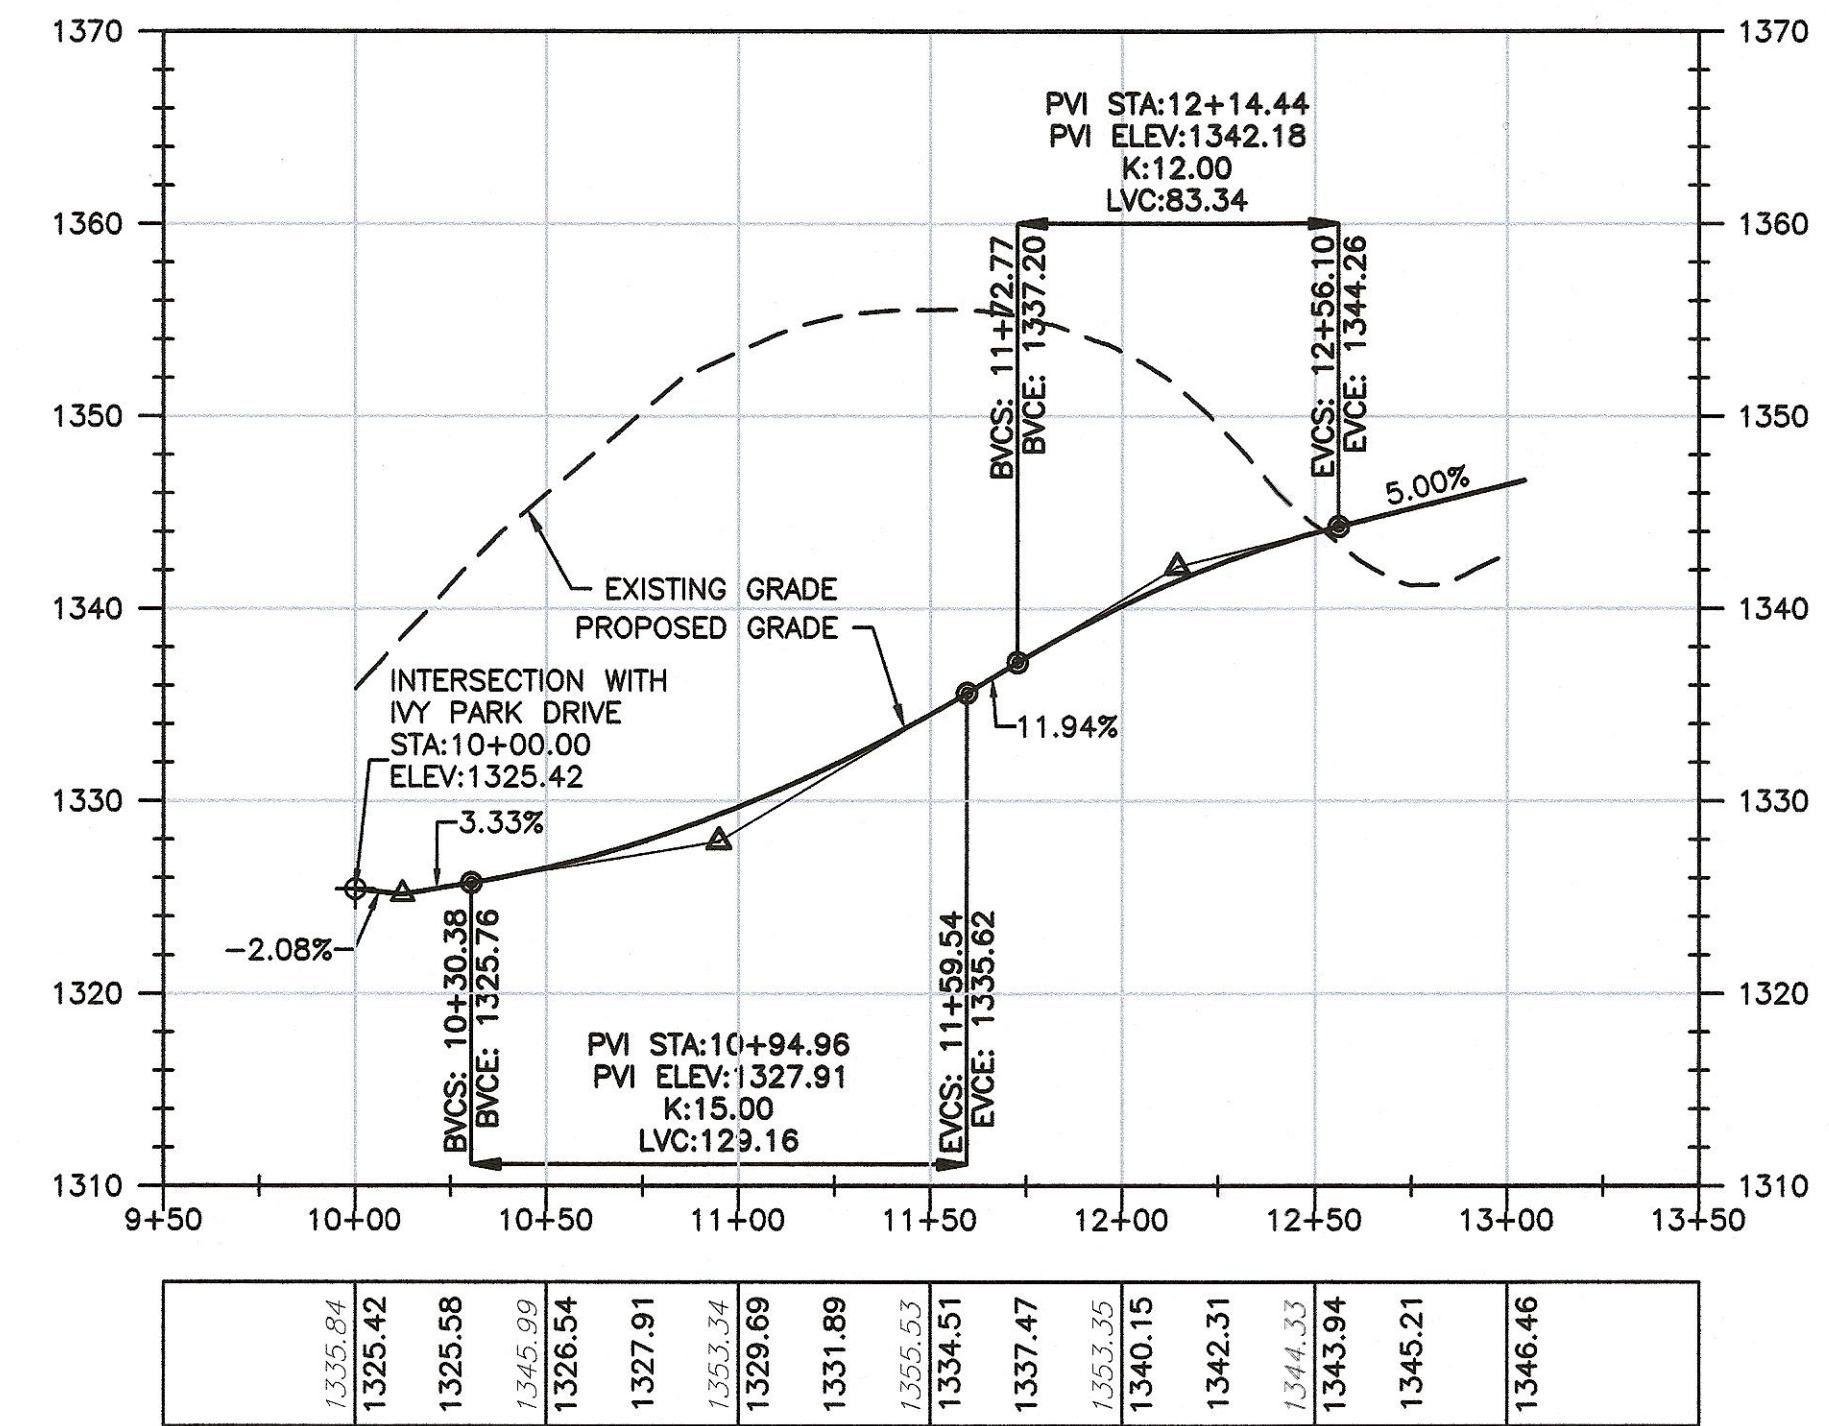


SANITARY SEWER A-F PROFILE

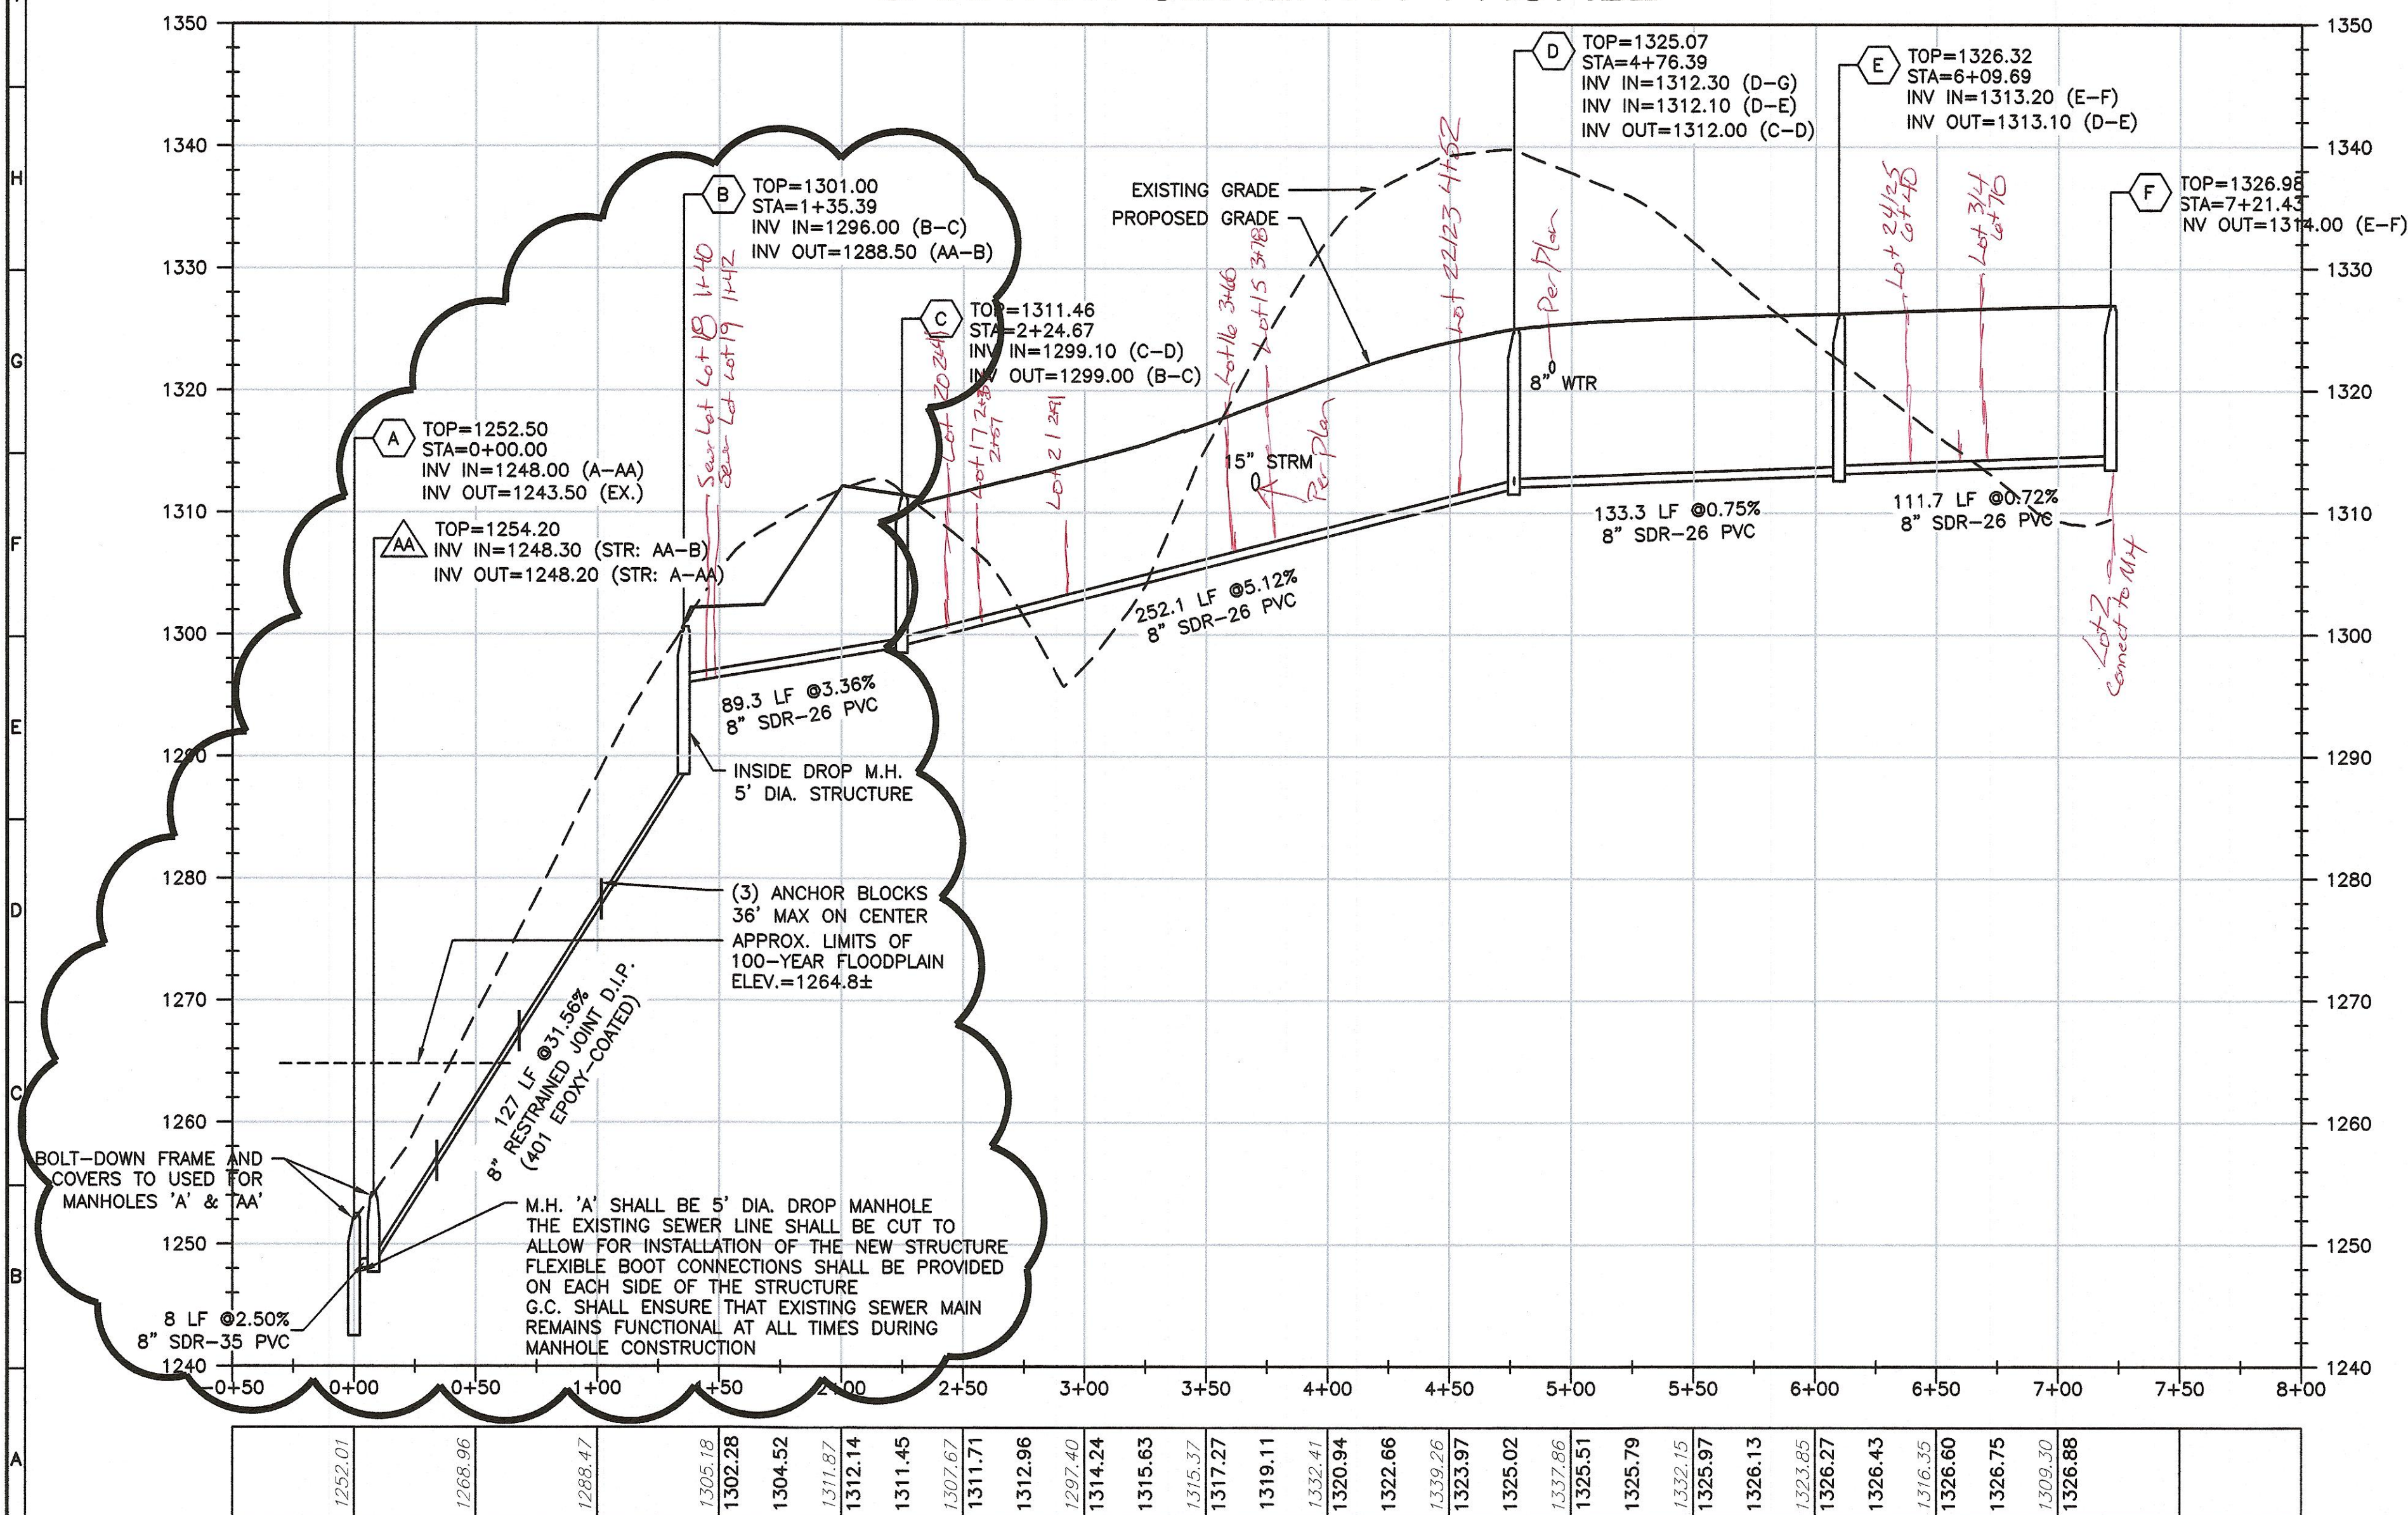

SANITARY SEWER D-G PROFILE

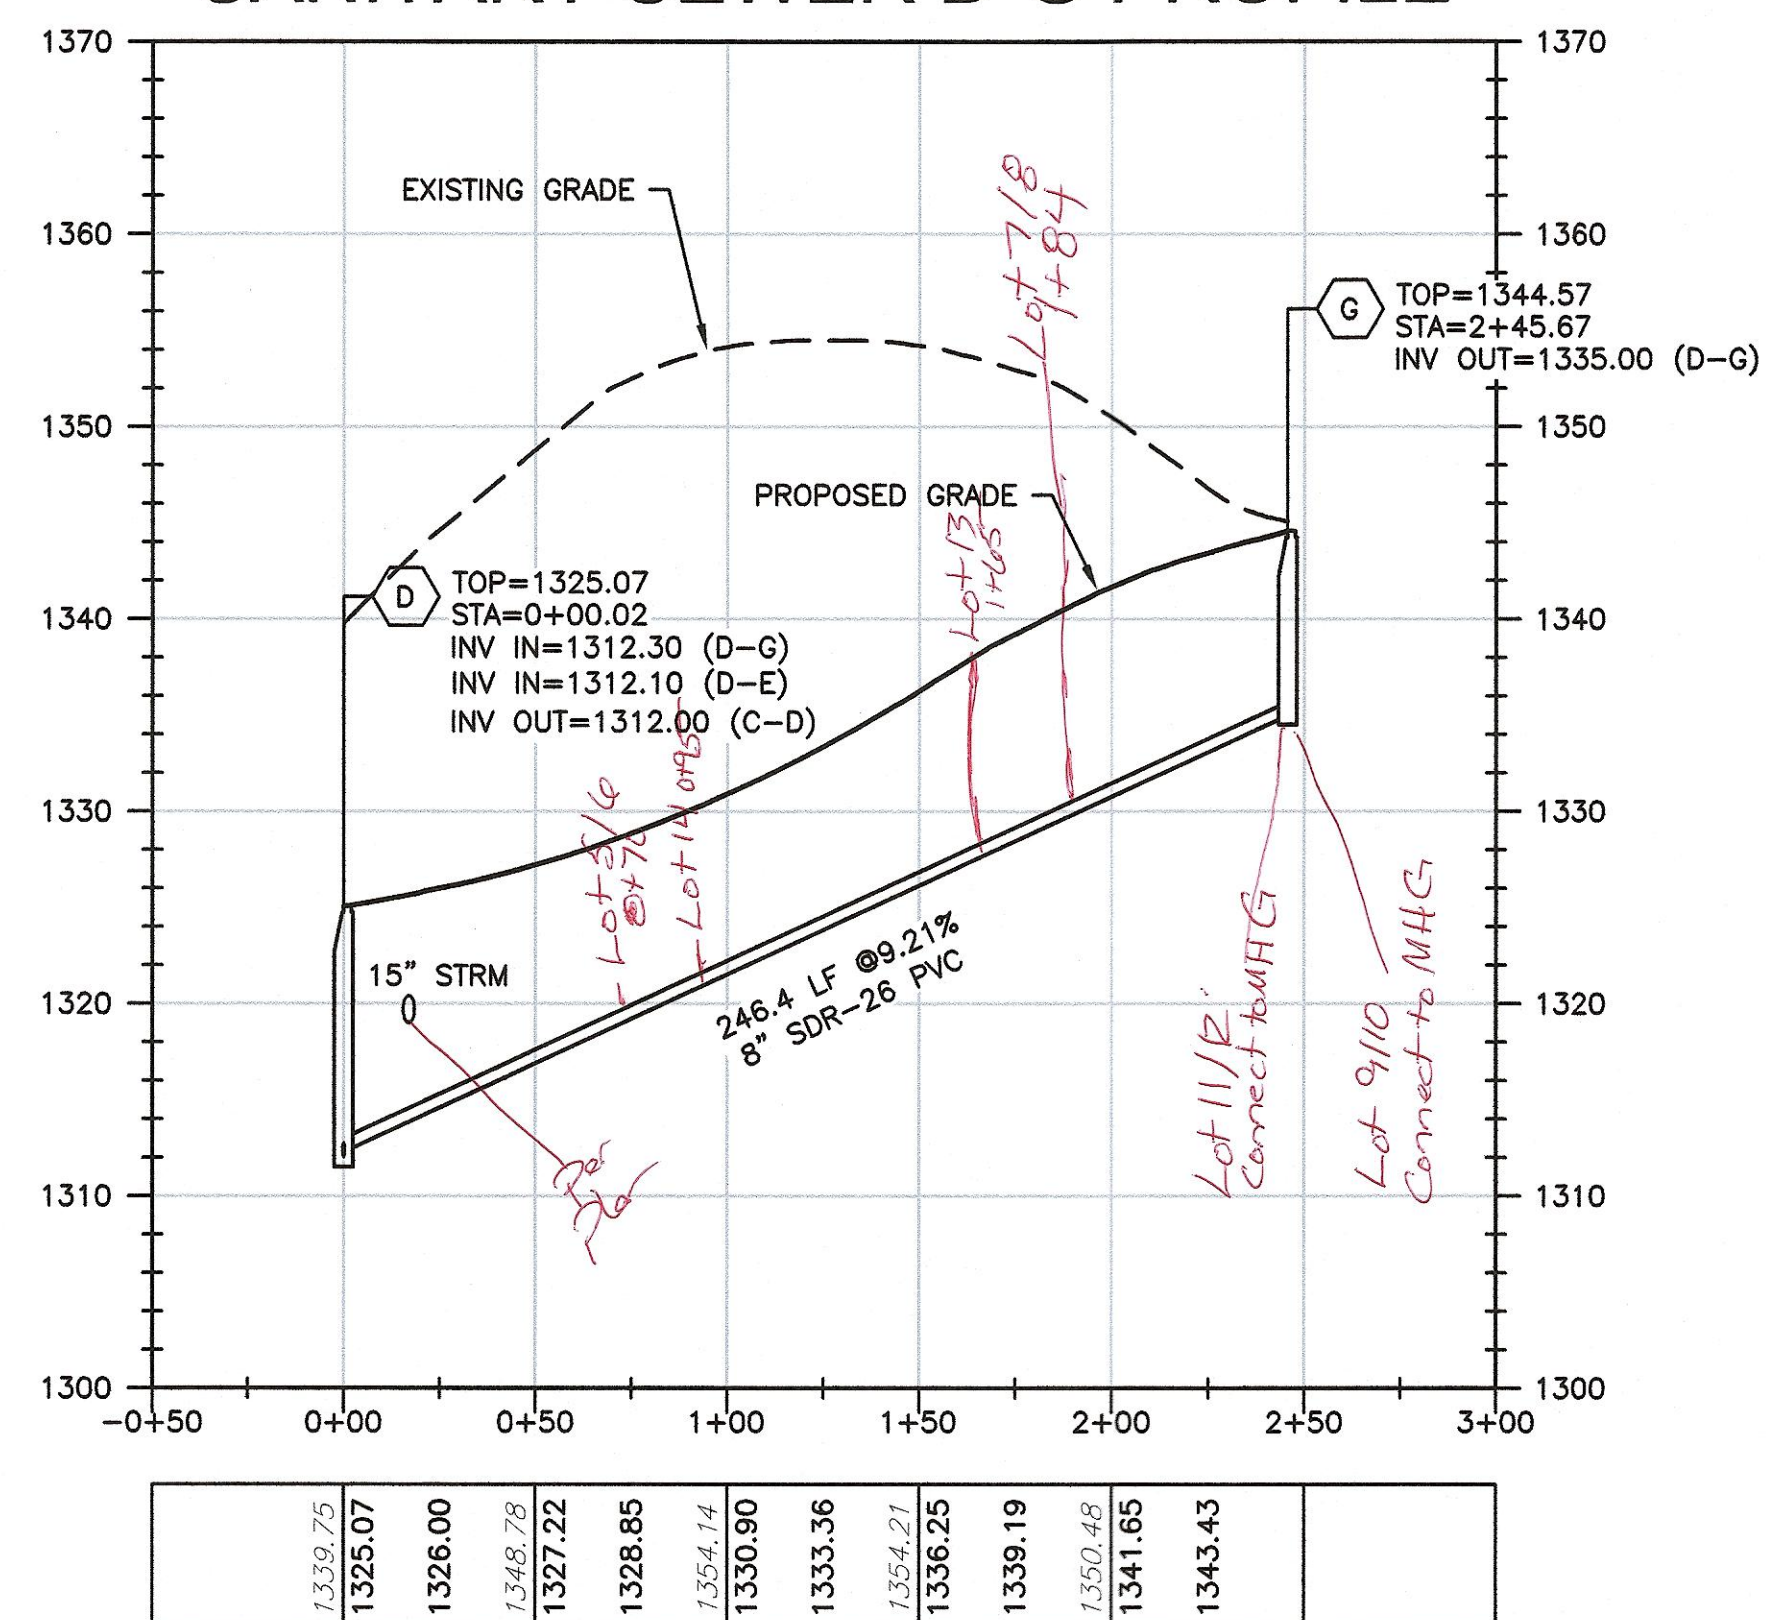


HORIZONTAL SCALE:

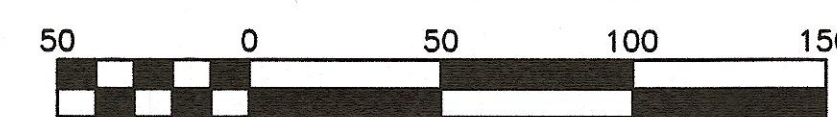

SCALE: 1" = 50'

VERTICAL SCALE:

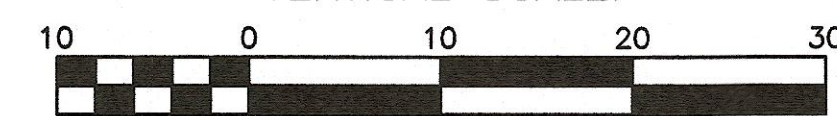

SCALE: 1" = 10'

BALZER
AND ASSOCIATES, INC.
BVNEC
REFLECTING TOMORROW

www.balzer.cc

Roanoke
New River Valley
Richmond
Staunton
Harrisonburg

RESIDENTIAL LAND DEVELOPMENT ENGINEERING
SITE DEVELOPMENT ENGINEERING
LAND USE PLANNING & ZONING
LANDSCAPE ARCHITECTURE
LAND SURVEYING
ARCHITECTURE
STRUCTURAL ENGINEERING
TRANSPORTATION ENGINEERING
ENVIRONMENTAL & SOIL SCIENCE
WETLAND DELINEATIONS & STREAM EVALUATIONS

Balzer and Associates, Inc.

1208 Corporate Circle
Roanoke, VA 24018
540-772-9580
FAX 540-772-8050



FOX HUNT SUBDIVISION
5661 ROSELAWN ROAD

ROAD AND S.S. PROFILES

WINDSOR HILLS DISTRICT
ROANOKE COUNTY, VIRGINIA

DRAWN BY CPB
DESIGNED BY CPB
CHECKED BY BTC
DATE 10/1/2015
SCALE AS NOTED

REVIEWS:
1/7/2016
3/7/2016
4/26/2016
5/17/2017
7/20/2017
8/7/2017
6/27/2018 P.R. #2
5/18/2019 P.R. #3

SHEET NO.

C6
JOB NO. 04150025.00

JOB NO. 04150025.00