





# IVY PARK DRIVE - WATERLINE PROFILE

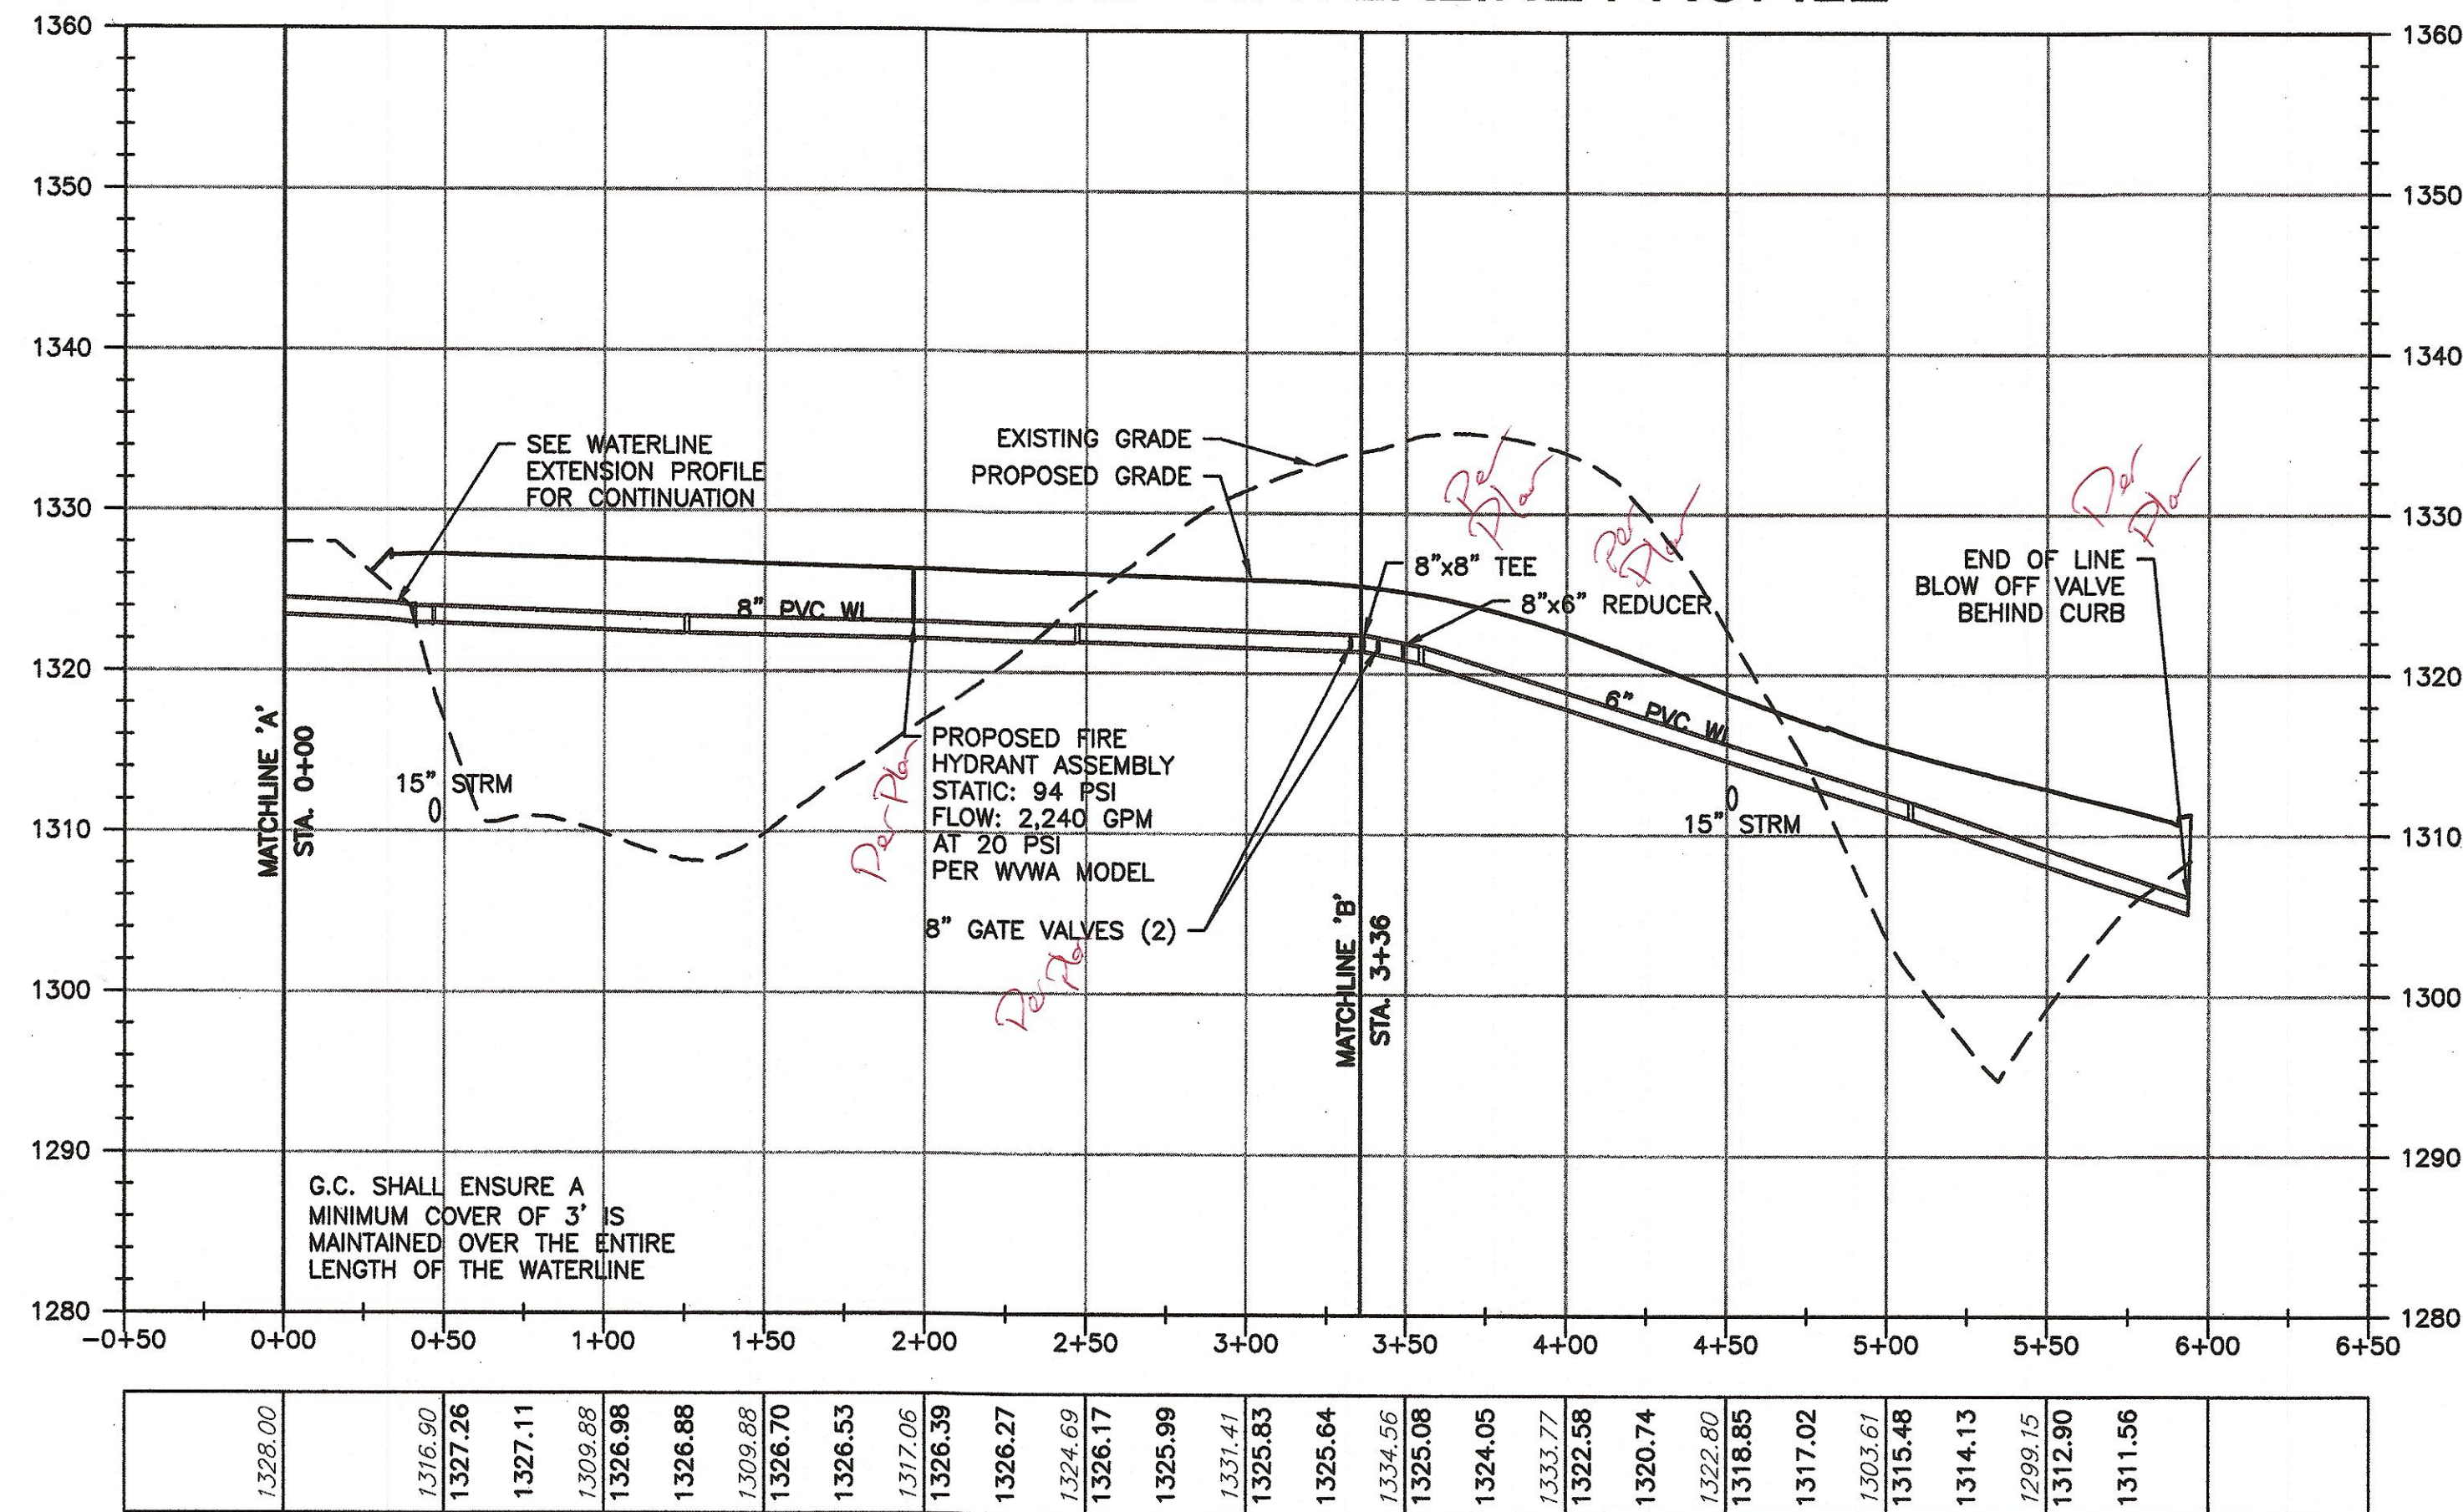

# RIDGELINE COURT WATERLINE PROFILE

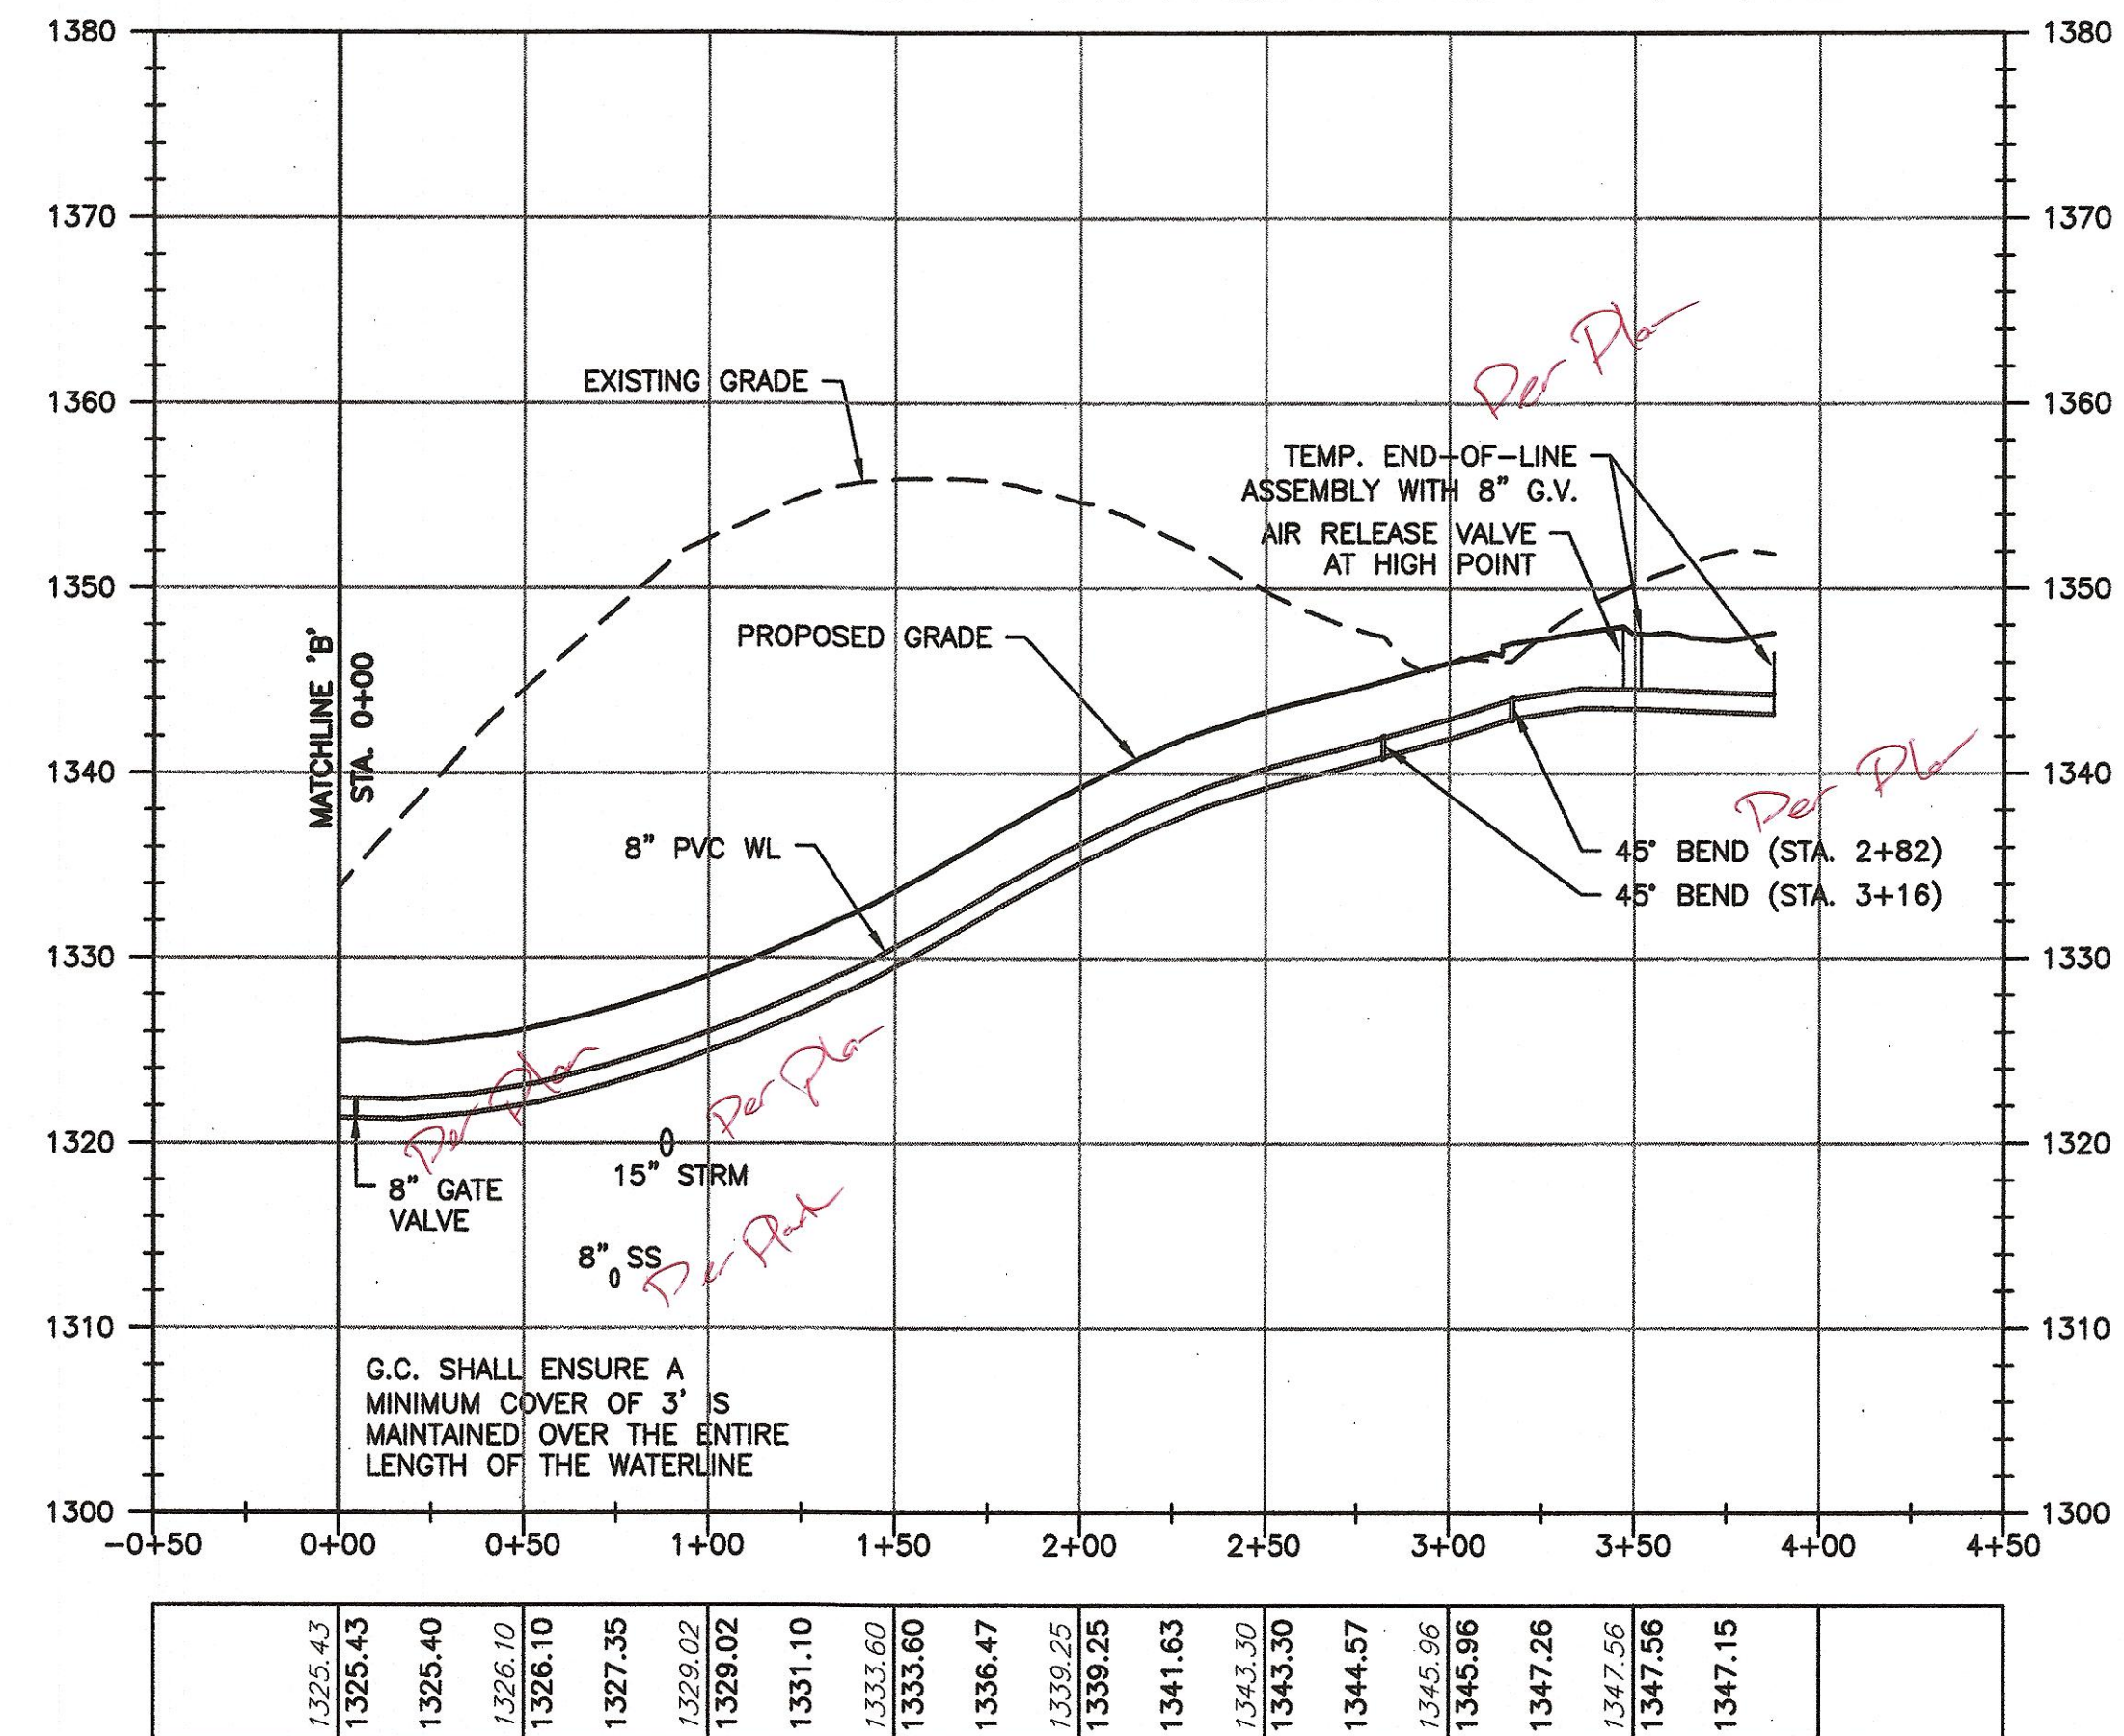

# WATERLINE EXTENSION PROFILE

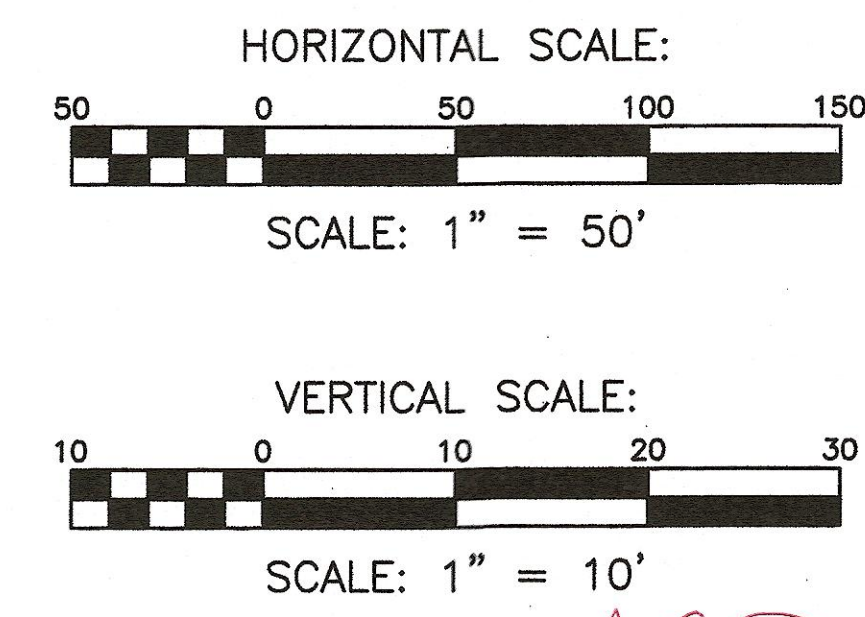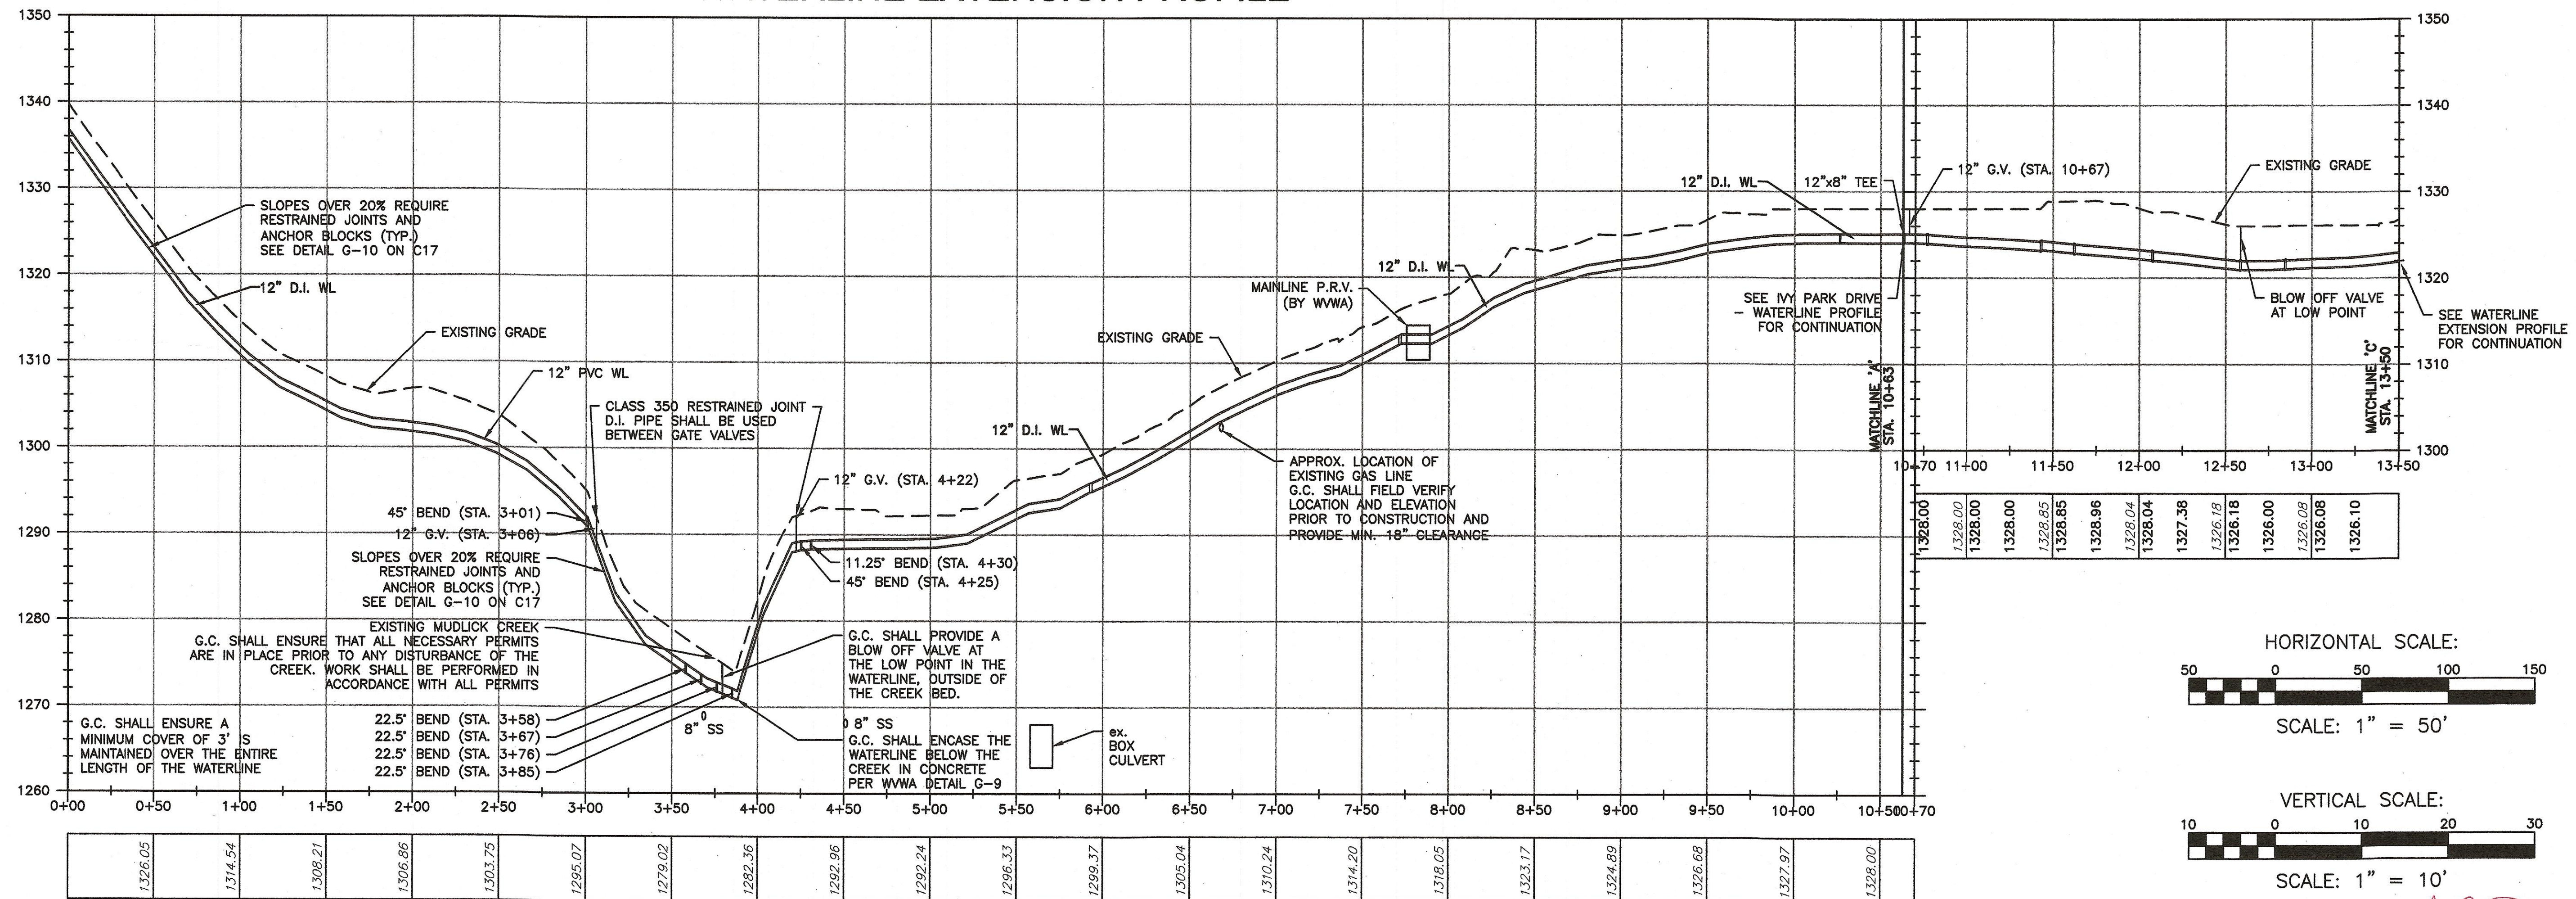

ASBUILT



www.balzer.cc

Roanoke  
New River Valley  
Richmond  
Staunton  
Harrisonburg

RESIDENTIAL LAND DEVELOPMENT ENGINEERING  
SITE DEVELOPMENT ENGINEERING  
LAND USE PLANNING & ZONING  
LANDSCAPE ARCHITECTURE  
LAND SURVEYING  
ARCHITECTURE  
STRUCTURAL ENGINEERING  
TRANSPORTATION ENGINEERING  
ENVIRONMENTAL & SOIL SCIENCE  
WETLAND DELINEATIONS & STREAM EVALUATIONS

Balzer and Associates, Inc.  
1208 Corporate Circle  
Roanoke, VA 24018  
540-772-9580  
FAX 540-772-8050



FOX HUNT SUBDIVISION  
5661 ROSELAWN ROAD  
WATERLINE PROFILES  
WINDSOR HILLS DISTRICT  
ROANOKE COUNTY, VIRGINIA

DRAWN BY CPB  
DESIGNED BY CPB  
CHECKED BY BTC  
DATE 10/1/2015  
SCALE AS NOTED

REVISIONS:  
1/7/2016  
3/7/2016  
4/26/2016  
5/17/2017  
7/20/2017  
8/7/2017

APPROVED

SHEET NO.

C8

JOB NO. 04150025.00