



AS Built
03/04/2020

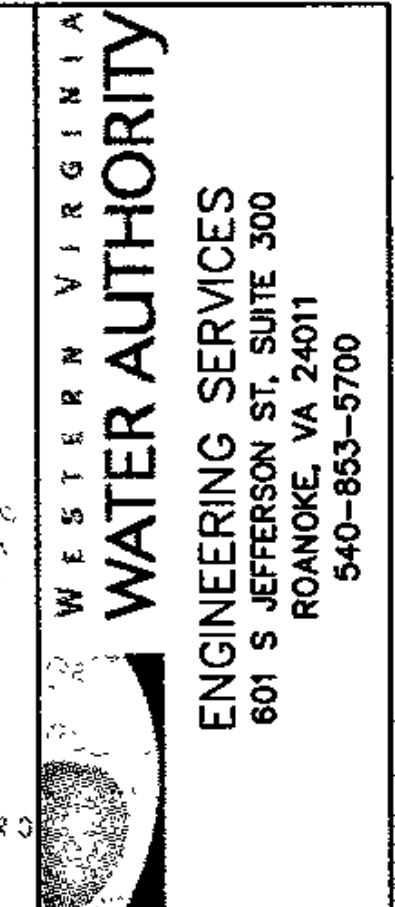

PRELIMINARY
(NOT FOR CONSTRUCTION)

BOONES MILL SEWER
REALIGNMENT

PLAN & PROFILE

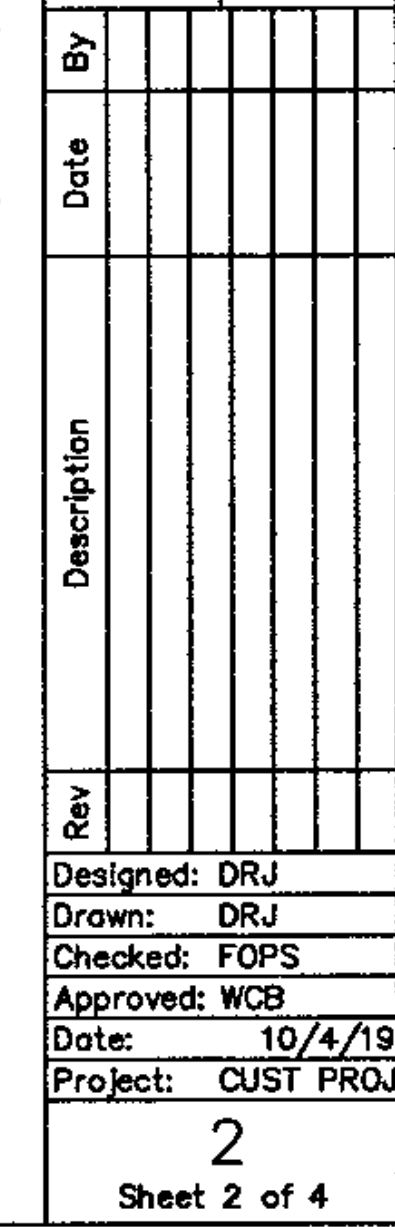

CORE DRILL M/H
8" BOOT

✓
CORE DRILL M/H
8" BOOT