


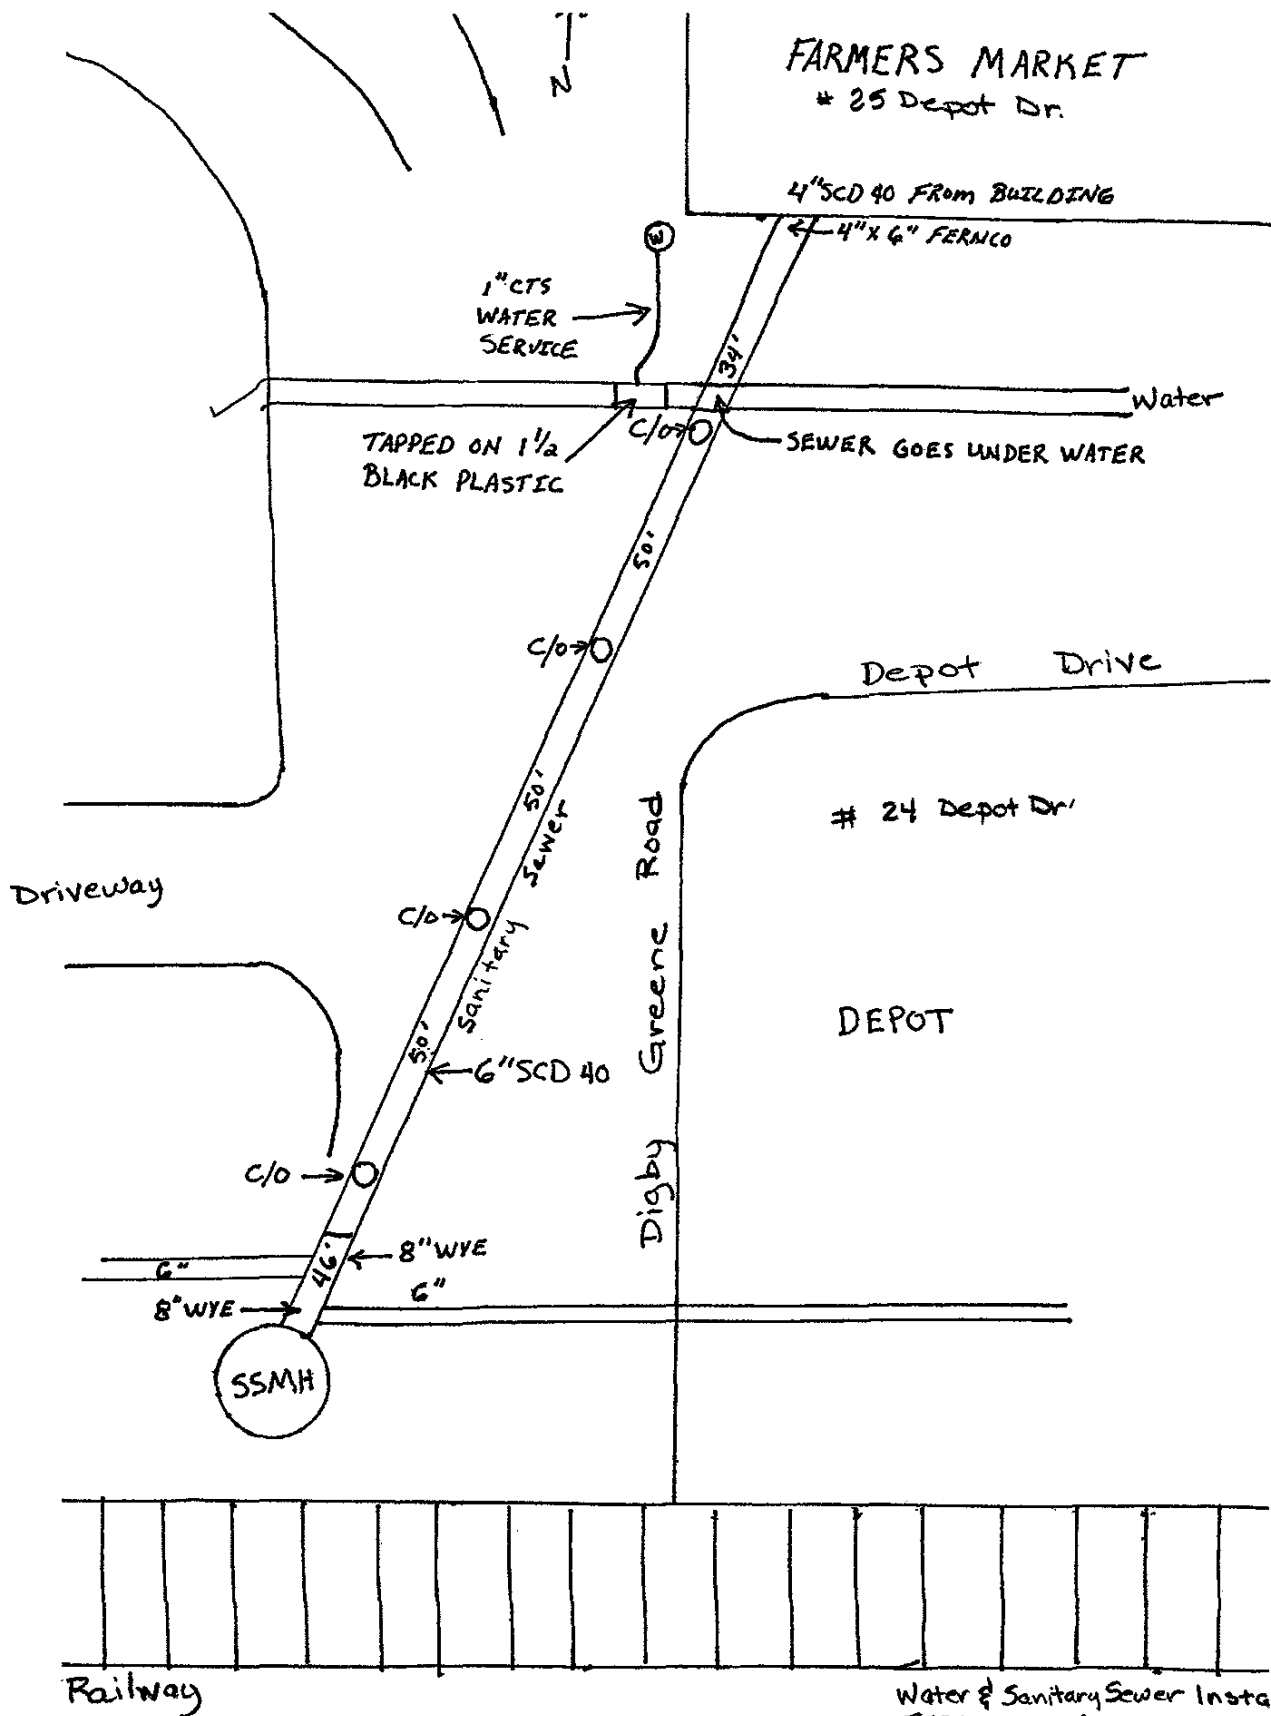

Water & Sanitary Sewer Installed
 INSTALLED 6-21-2018
 by
 WYWA CIP-1
 (Western Virginia Water Authority)
 BILLY THOMAS
 103 Digby Greene Rd
 for Town of Boones Mill
 T# 3010008001
 Franklin County