


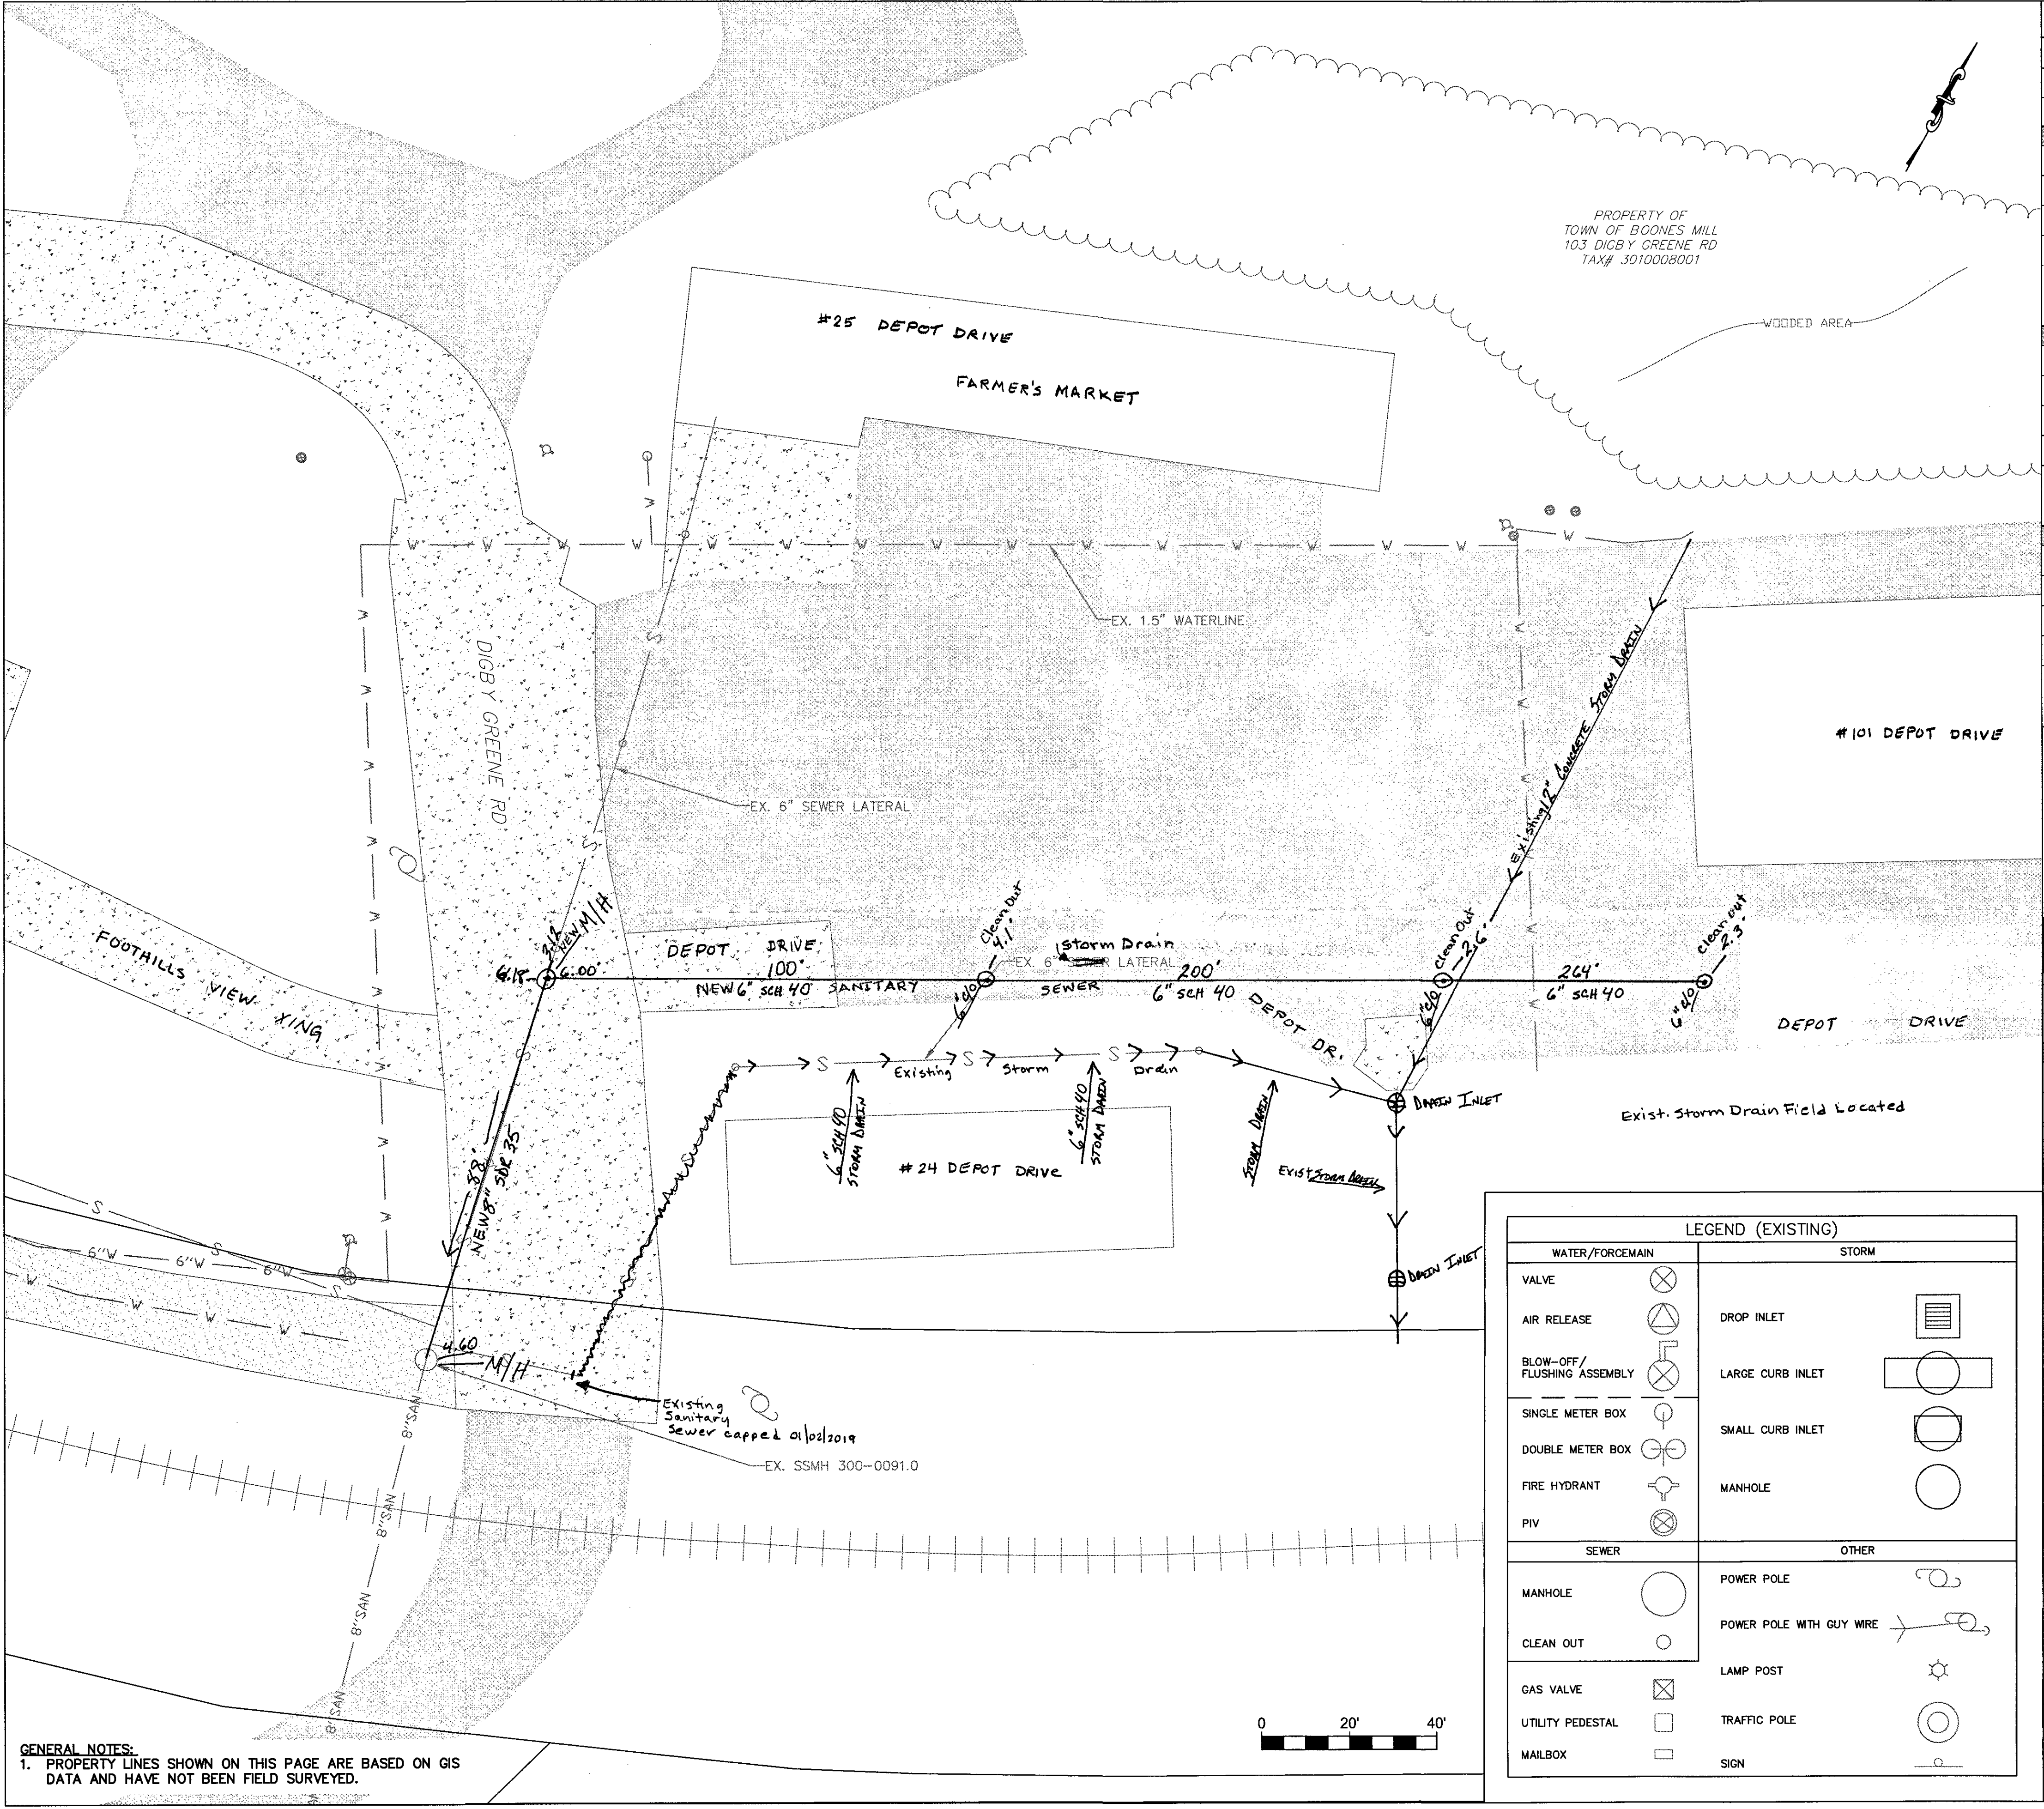

GENERAL NOTES:
1. PROPERTY LINES SHOWN ON THIS PAGE ARE BASED ON GIS DATA AND HAVE NOT BEEN FIELD SURVEYED.



LEGEND (EXISTING)			
WATER/FORCEMAIN		STORM	
VALVE		DROP INLET	
AIR RELEASE		LARGE CURB INLET	
BLOW-OFF/FLUSHING ASSEMBLY		SMALL CURB INLET	
SINGLE METER BOX		MANHOLE	
DOUBLE METER BOX			
FIRE HYDRANT			
PIV			
SEWER		OTHER	
MANHOLE		POWER POLE	
CLEAN OUT		POWER POLE WITH GUY WIRE	
GAS VALVE		LAMP POST	
UTILITY PEDESTAL		TRAFFIC POLE	
MAILBOX		SIGN	

Project Name		Project Name	
Contractor		WVWA CIP2 - TAFT BEASLEY	
Construction Start Date		12-11-2018	
Completion Date		1-2-2019	
Sewer Gravity Main(s)			
Manufacturer		US PIPE	
Diameter		8"	
Pipe Class		SDR 35	
Material		PASTEC	
Comments			
Sewer Gravity Lateral(s)			
Manufacturer		US PIPE	
Diameter		6"	
Pipe Class		SCH 40	
Material		PASTEC	
Comments			
Sewer Manhole(s)			
Manufacturer		CSI ROANOKE VA	
Material		CONCRETE	
Ring & Cover Manuf.		EAST JORDAN	
Cover Type		STANDARD	
Comments			
Water Main(s)			
Manufacturer			
Diameter			
Pipe Class			
Material			
Comments			
Water Service(s)			
Manufacturer			
Diameter			
Pipe Class			
Material			
Comments			
Water Valve(s) 1			
Manufacturer			
Valve Type			
Diameter			
Direction to Open / Turns to Close			
Comments			
Hydrant(s)			
Authority ID #			
Manufacturer			
Model			
Cast Date			
Static Pressure			
Comments			
By		Date	
BOONSMILL SEWER PROJECT		1-3-2019 TB	
Description		As-built	
Rev			
Designed:		AJC	
Drawn:		DRJ	
Checked:		DRJ	
Approved:			
Date:		DEC 2018	
Project:		PVT. MNT.	
1		Sheet 1 of 21	

WESTERN VIRGINIA

WATER AUTHORITY

ENGINEERING SERVICES

601 S JEFFERSON ST. SUITE 300

ROANOKE, VA 24011

540-853-5700

TOWN OF BOONES MILL
~~WATER~~ SEWER EXTENSION
FIELD LOCATED EXISTING STORM DRAIN
BASEMAP