


NOTES:


1. EXISTING TREATMENT BUILDING AND RESERVOIR MUST REMAIN IN SERVICE DURING CONSTRUCTION. SYSTEM OUTAGES WILL NOT BE ALLOWED WITHOUT PRIOR AUTHORIZATION FROM OWNER.

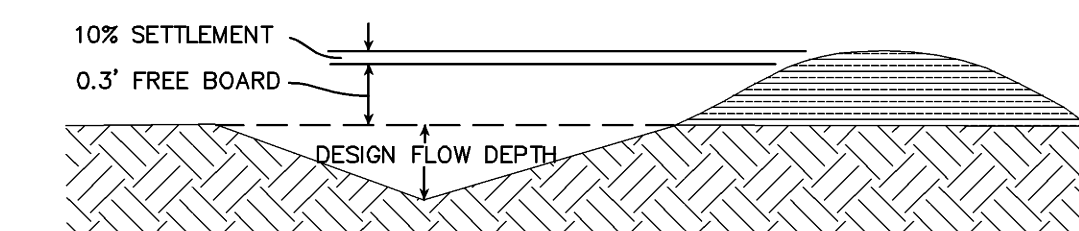

(DV) TYPICAL VEE-SHAPED DIVERSION
N.T.S.

THE ENGINEER AND/OR SURVEYOR TAKES NO RESPONSIBILITY FOR THE LOCATION OR ACCURACY OF THE UTILITIES AS SHOWN HEREON OR ANY UTILITY WITHIN THE PROJECT THAT MAY NOT BE SHOWN HEREON. THE CONTRACTOR SHALL BE RESPONSIBLE FOR CONTACTING THE UTILITY COMPANIES TO SEE IF ANY UTILITIES EXIST WITHIN THE AREA OF THE PROJECT BEFORE ANY CONSTRUCTION BEGINS. ANY COST INCURRED BY DAMAGING ANY UTILITY WITHIN THE PROJECT SHALL BE AT THE EXPENSE OF THE CONTRACTOR.

48 WORKING HOURS PRIOR TO STARTING THE WORK, THE CONTRACTOR SHALL CALL MISS UTILITY AT PHONE NUMBER 811 AND ADVISE THE NATURE AND LOCATION OF THE WORK.

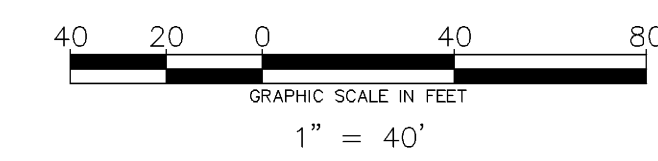

1	8/28/09	VDH/OWNER COMMENTS
2	9/3/09	VDH/OWNER COMMENTS
3	10/7/09	ADDENDUM #2
4	11/17/09	FRANKLIN COUNTY COMMENTS
5	3/14/12	ASBUILTS

TANK SITE AND GRADING PLAN-ASBUILT
FOR
TOWN OF BOONES MILL WATER SYSTEM REPLACEMENT, VOLUME 2
TOWN OF BOONES MILL, BOONE DISTRICT, FRANKLIN COUNTY, VA

PROJECT NO.	20080815
G.L. NO.	297-03-A3.9
FILE NO.	G-12675
DATE:	7/31/09
DRAWN BY:	ASK
CHECKED BY:	BLC