

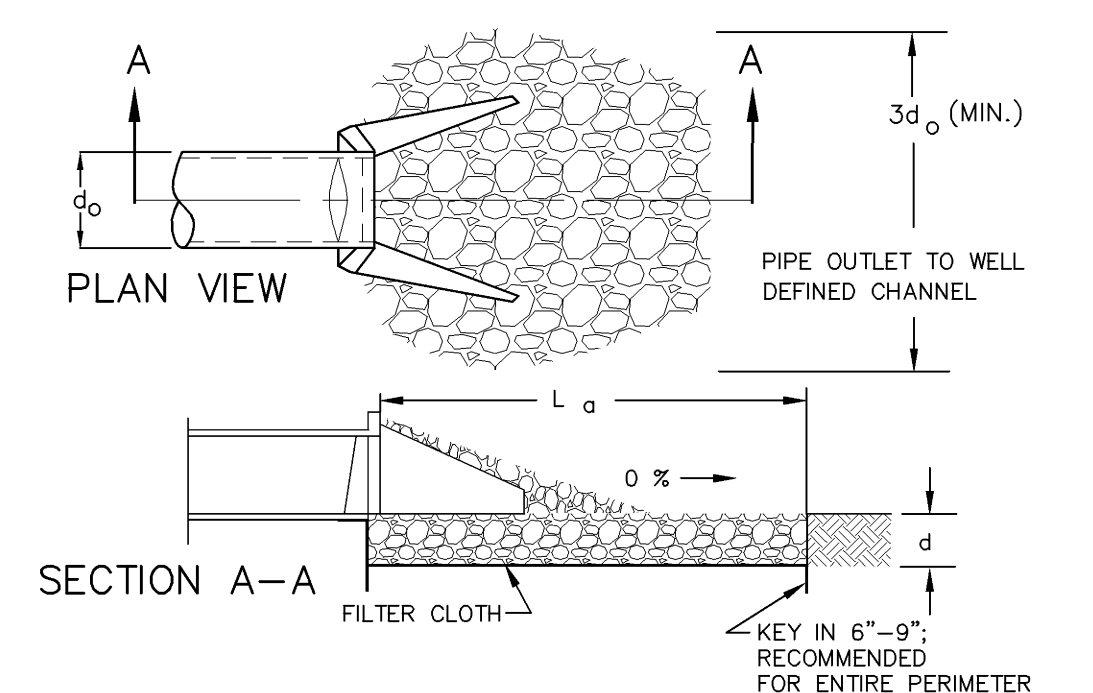
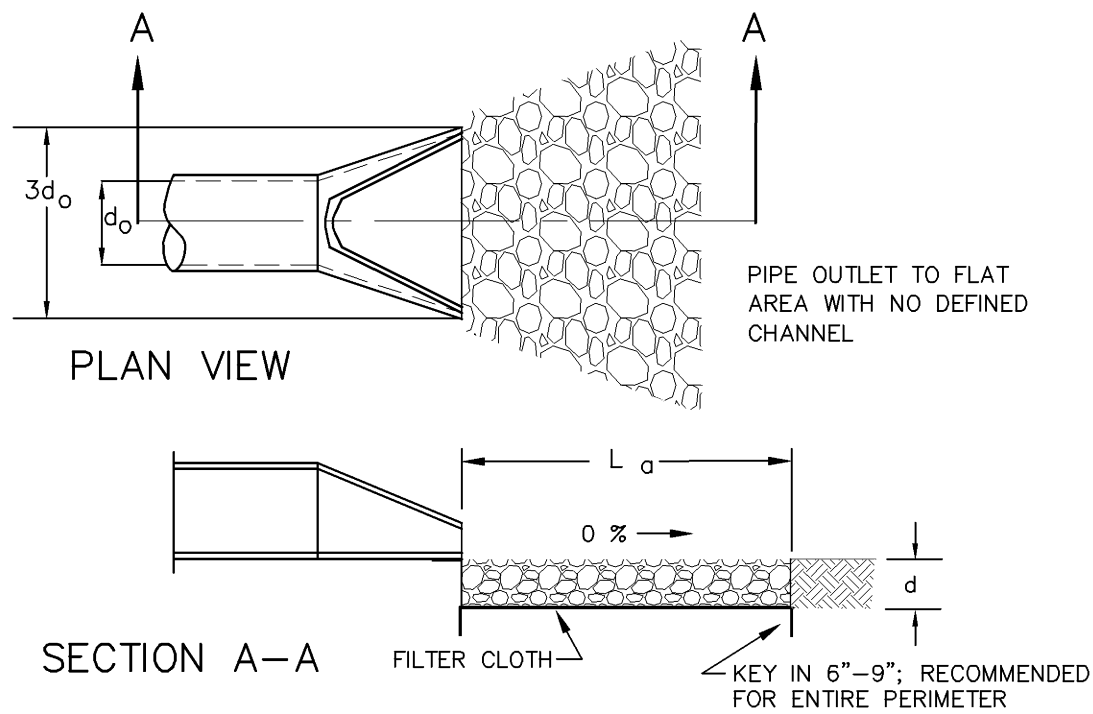
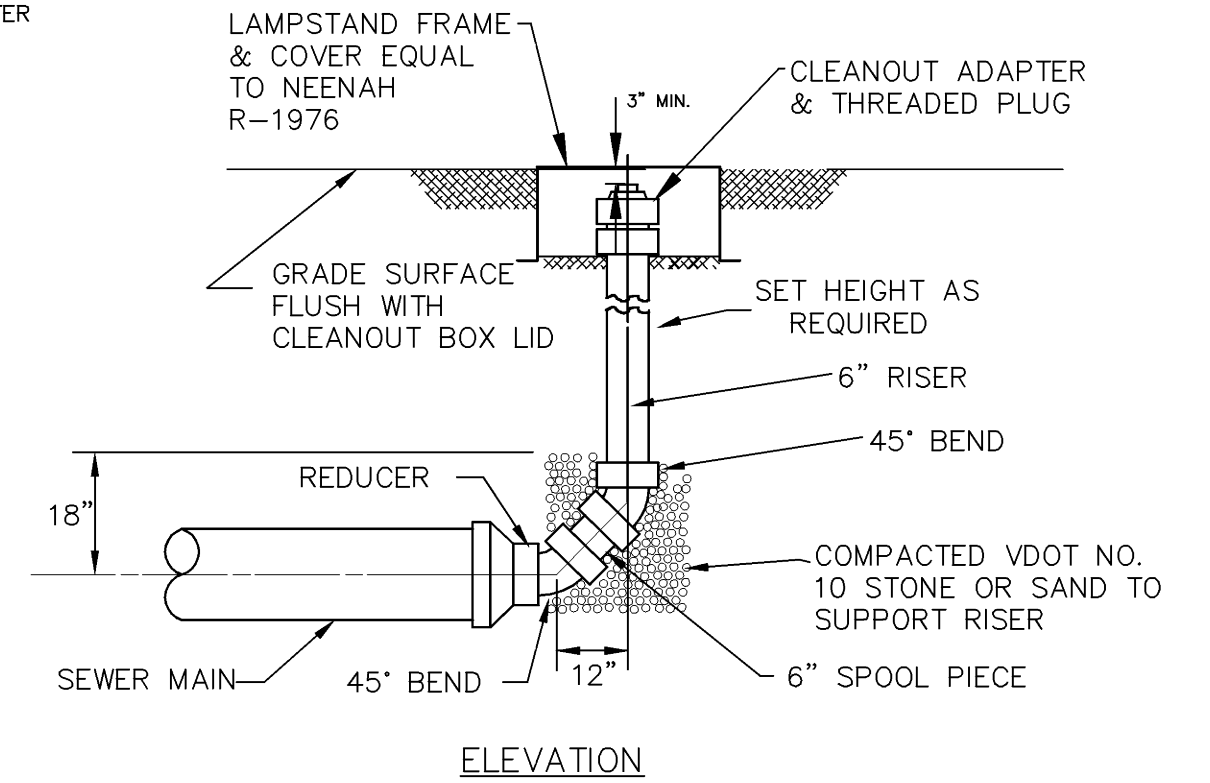


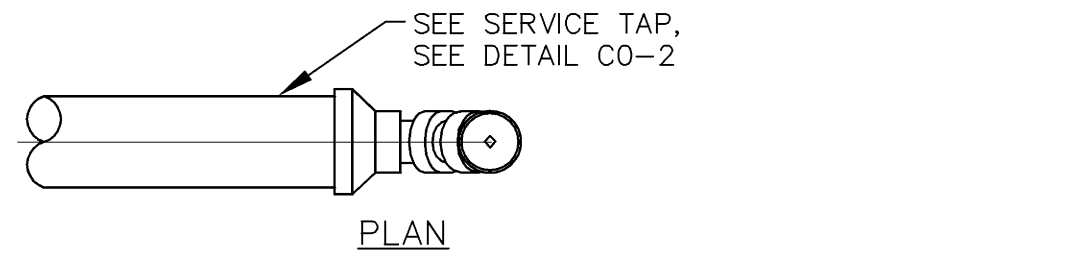



PIPE OUTLET PROTECTION
N.T.S.

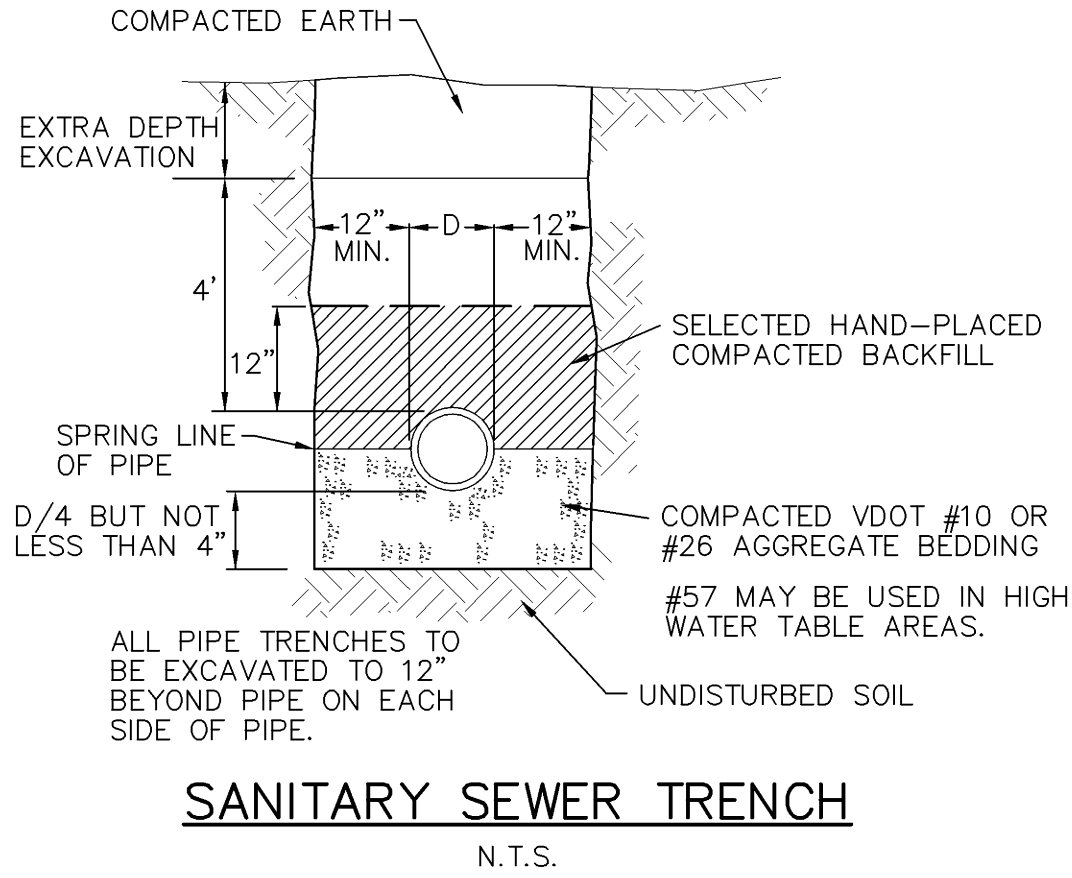

FITTINGS REQUIRED FOR EACH CLEANOUT


	Ø	WYE	45° BEND	22 1/2° BEND	11 1/4° BEND	CLEANOUT ADAPT.
STRAIGHT THRU	0	0	2	0	0	1

**LAMPSTAND
SANITARY CLEANOUT TYPE I
TERMINAL LINE CLEANOUT**
N.T.S.

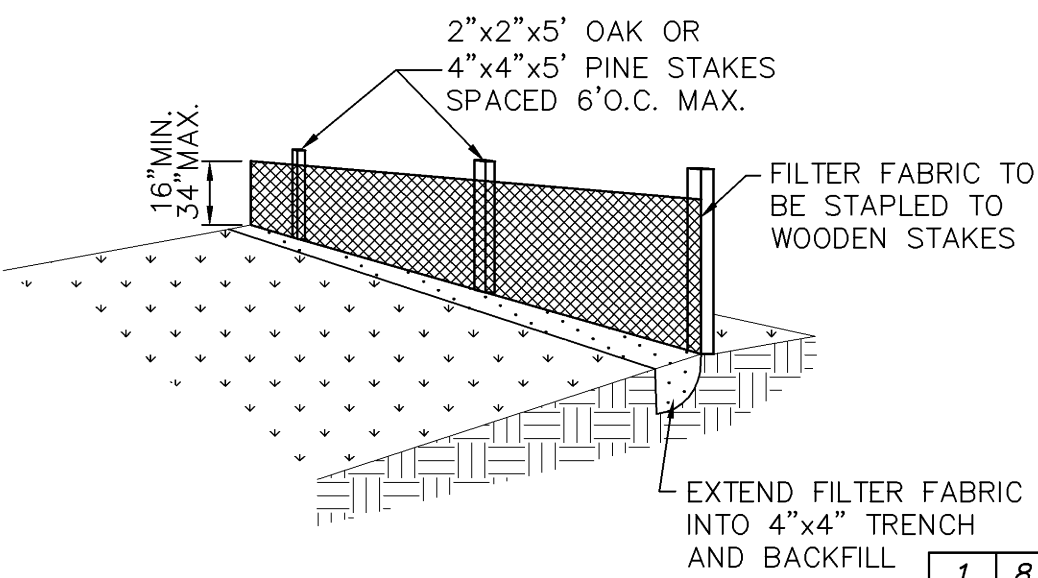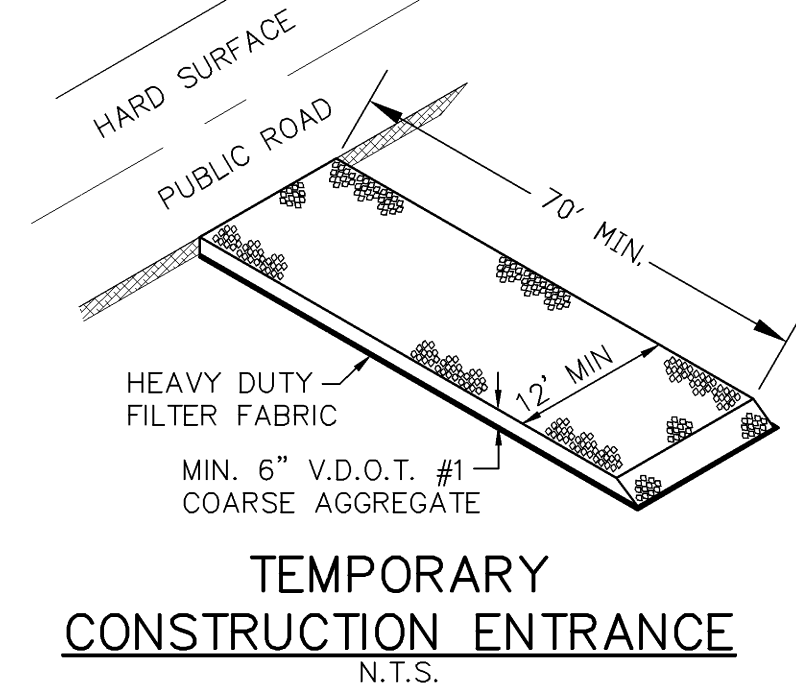


SILT FENCE
(WITHOUT WIRE SUPPORT)
N.T.S.


1	8/28/09	VDH/OWNER COMMENTS
2	9/3/09	VDH/OWNER COMMENTS
3	10/7/09	ADDENDUM #2
4	11/17/09	FRANKLIN COUNTY COMMENTS
5	3/14/12	ASBUILTS

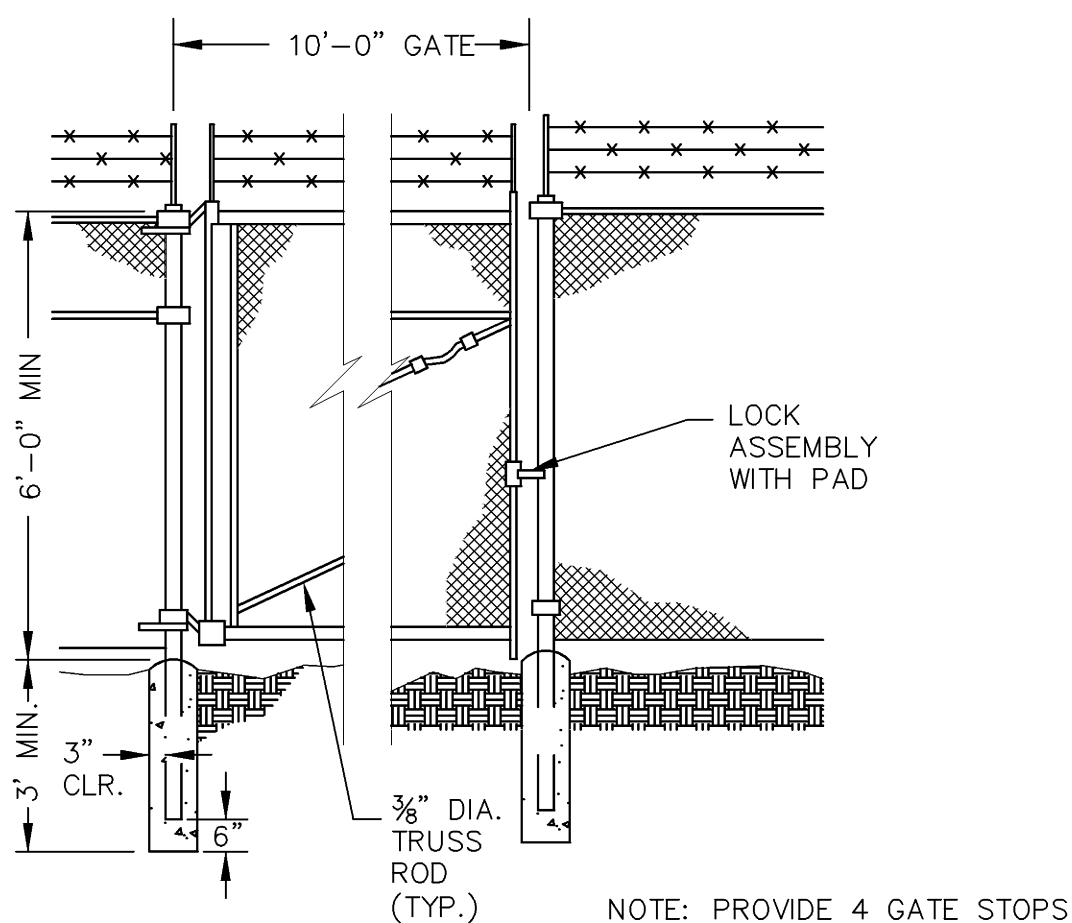

SINGLE GATE
NOT TO SCALE
N.T.S.

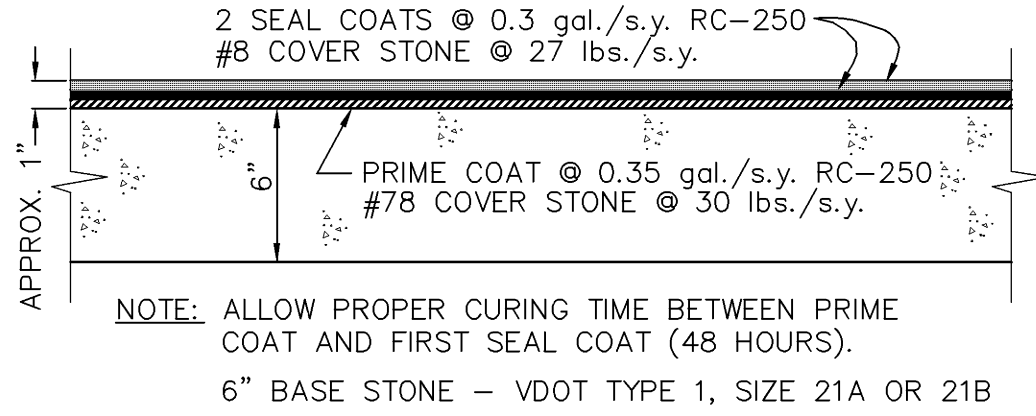

**PRIME AND DOUBLE SEAL
SURFACE TREATMENT**
N.T.S.

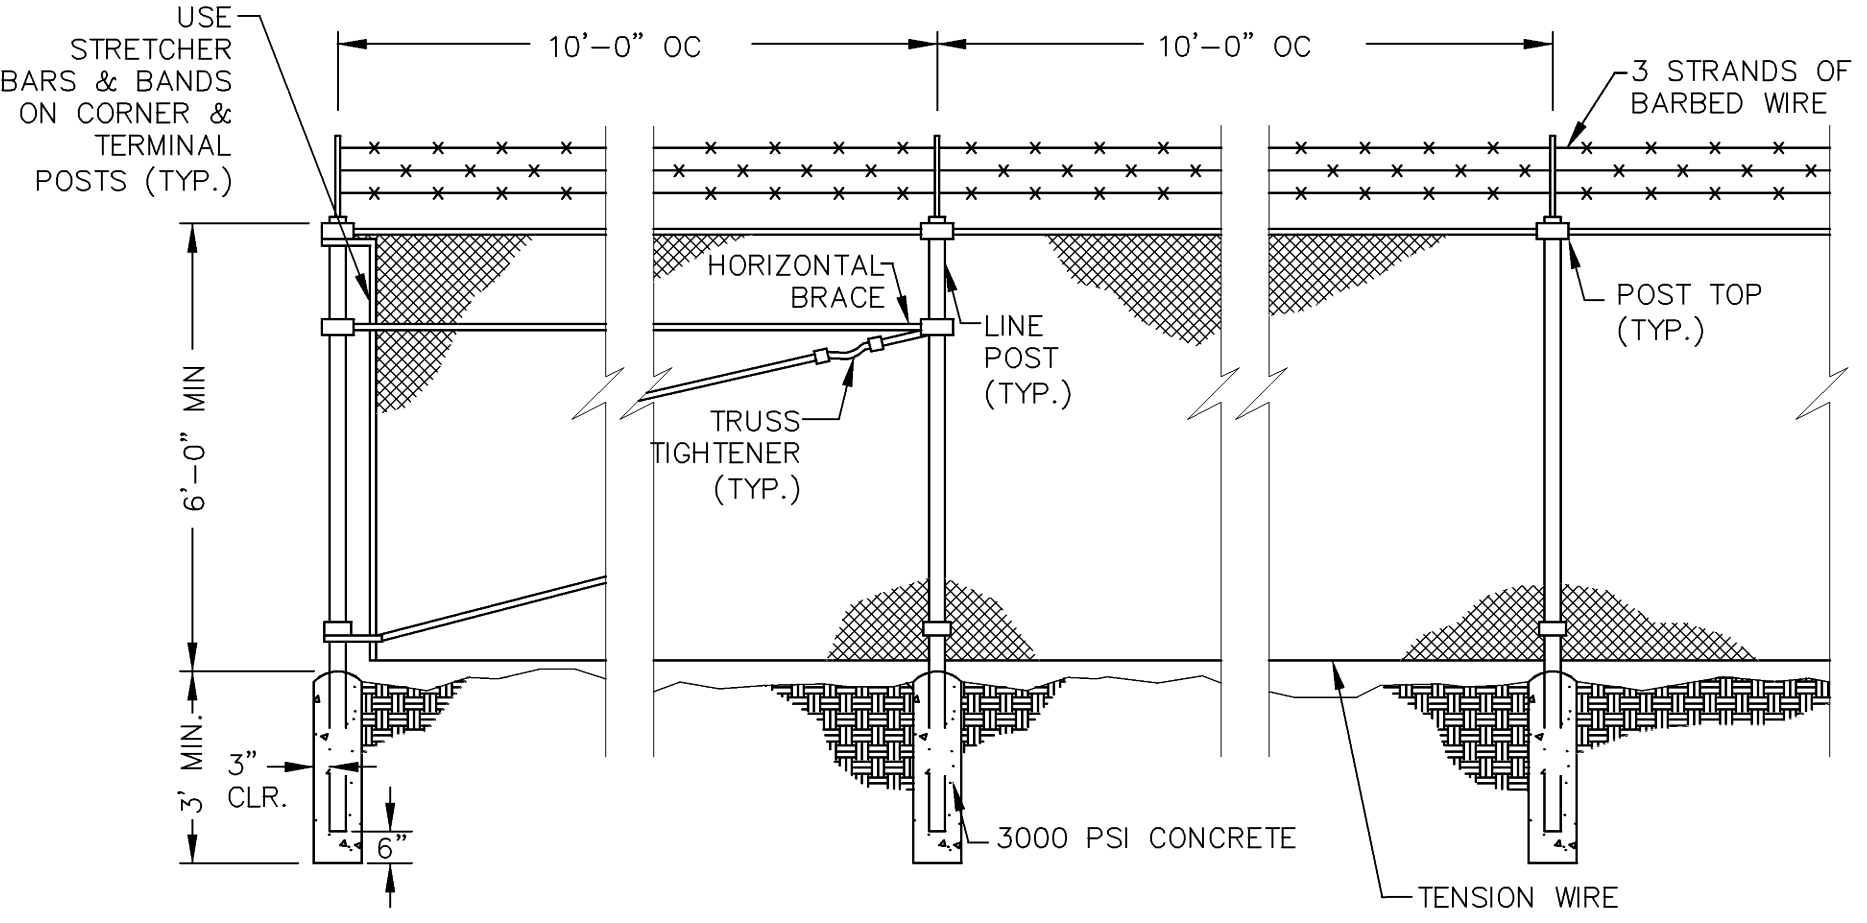

FENCE DETAIL
NOT TO SCALE
N.T.S.

TANK SITE DETAILS-ASBUILT
FOR
TOWN OF BOONES MILL WATER SYSTEM REPLACEMENT, VOLUME 2
TOWN OF BOONES MILL, BOONE DISTRICT, FRANKLIN COUNTY, VA

PROJECT NO.	20080815
G.L. NO.	297-03-A3.9
FILE NO.	G-12675
DATE:	7/31/09
DRAWN BY:	ASK
CHECKED BY:	BLC