


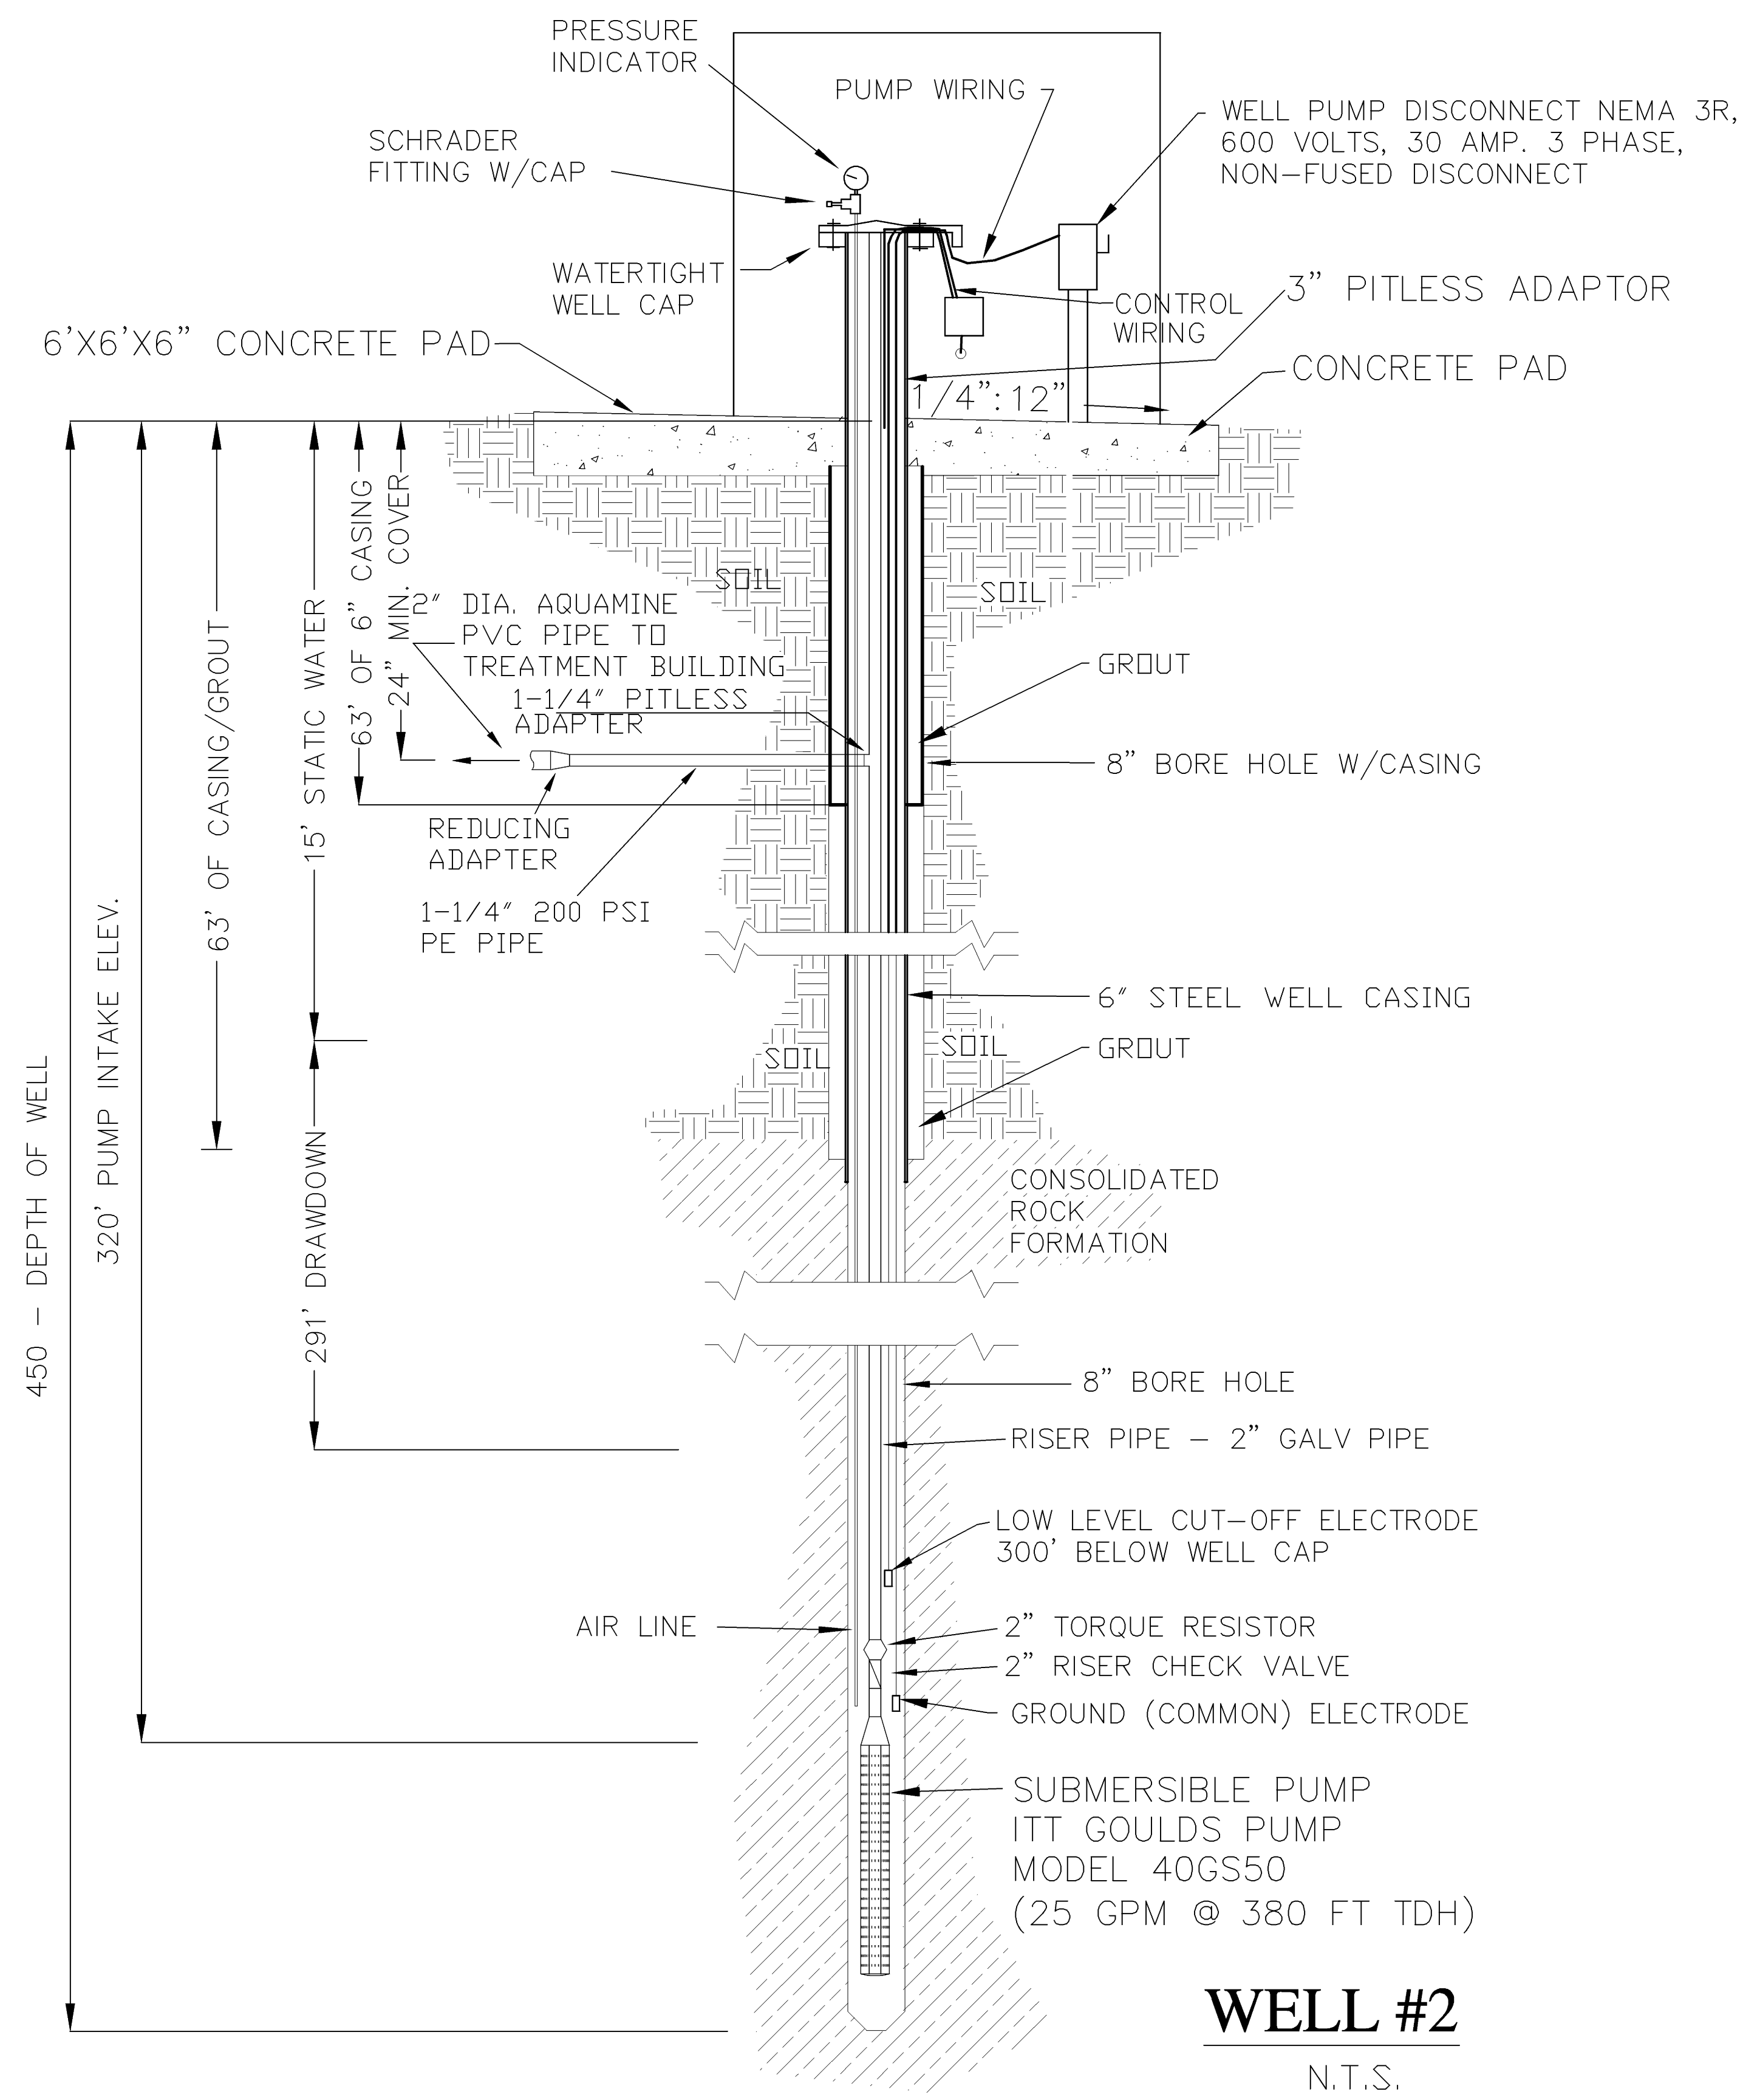

WELL DEVELOPMENT DETAILS-ASBUILT
FOR
TOWN OF BOONES MILL WATER SYSTEM REPLACEMENT, VOLUME 2
TOWN OF BOONES MILL, BOONE DISTRICT, FRANKLIN COUNTY, VA

PROJECT NO.	20080815
G.L. NO.	297-03-A3.9
FILE NO.	G-12675
DATE:	7/31/09
DRAWN BY:	ASK
CHECKED BY:	BLC

1	8/28/09	VDH/OWNER COMMENTS
2	9/3/09	VDH/OWNER COMMENTS
4	11/17/09	FRANKLIN COUNTY COMMENTS
5	3/14/12	ASBUILTS