

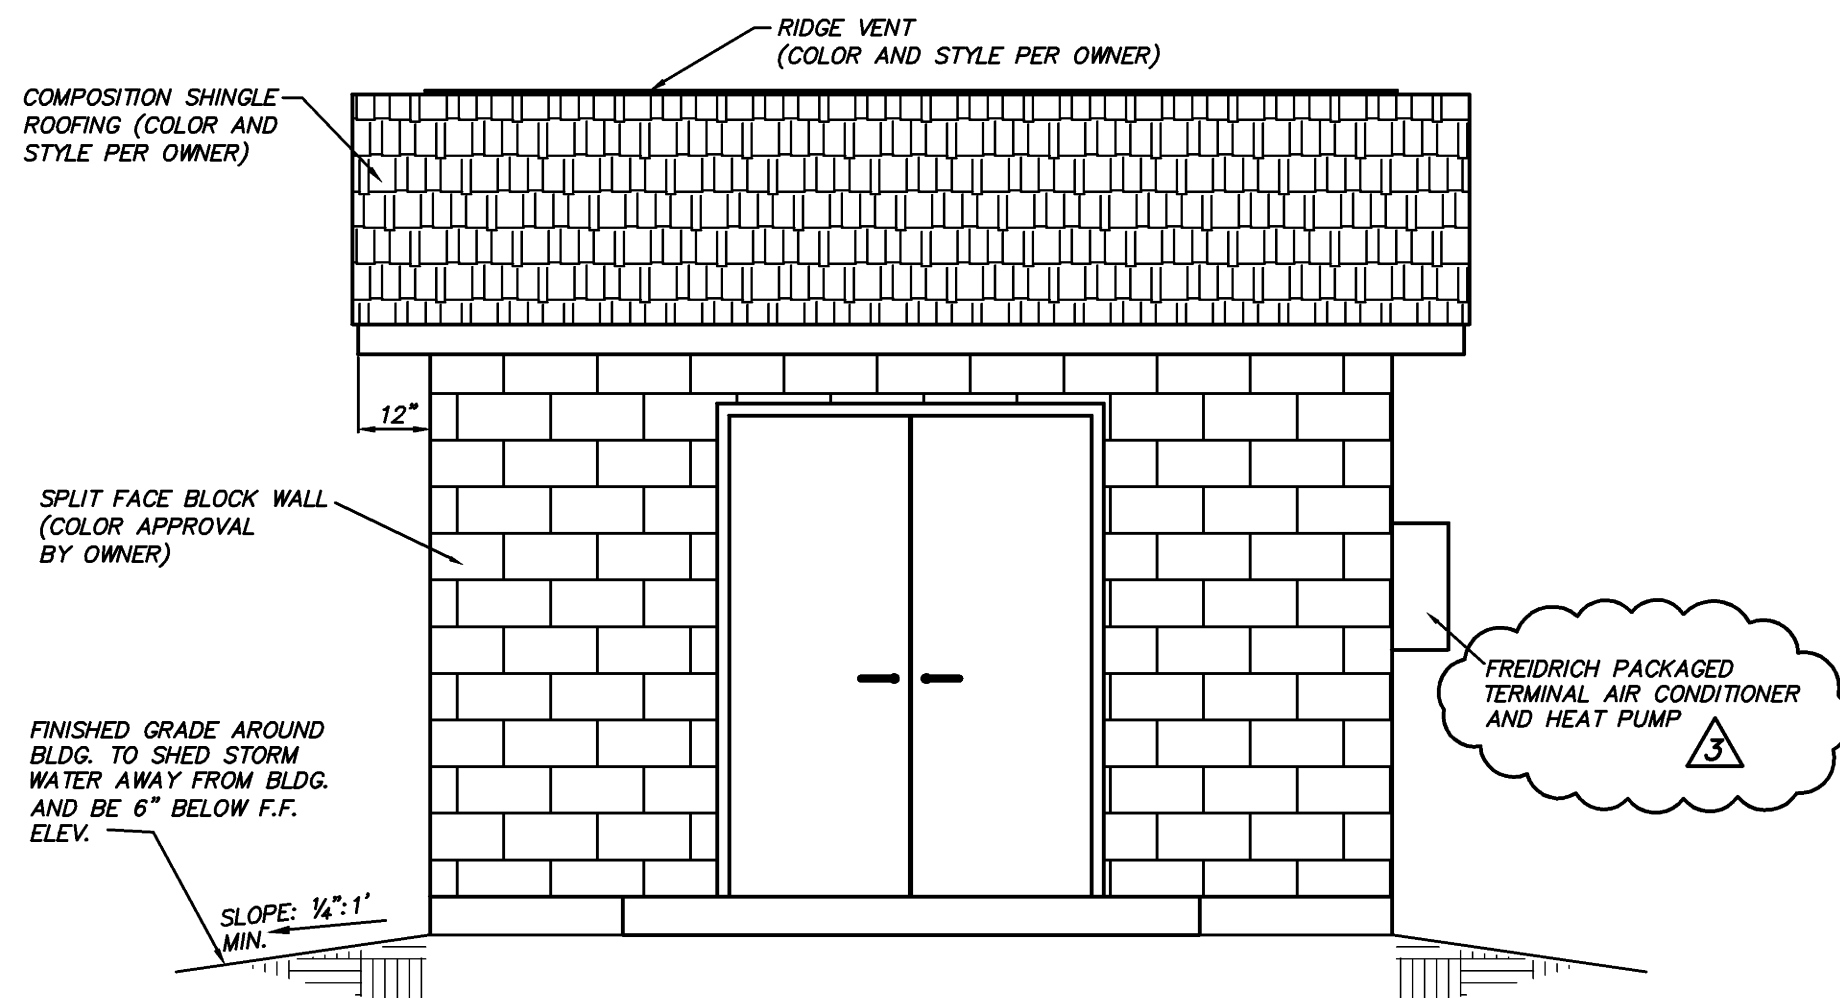



WELL 1 SITE PLAN

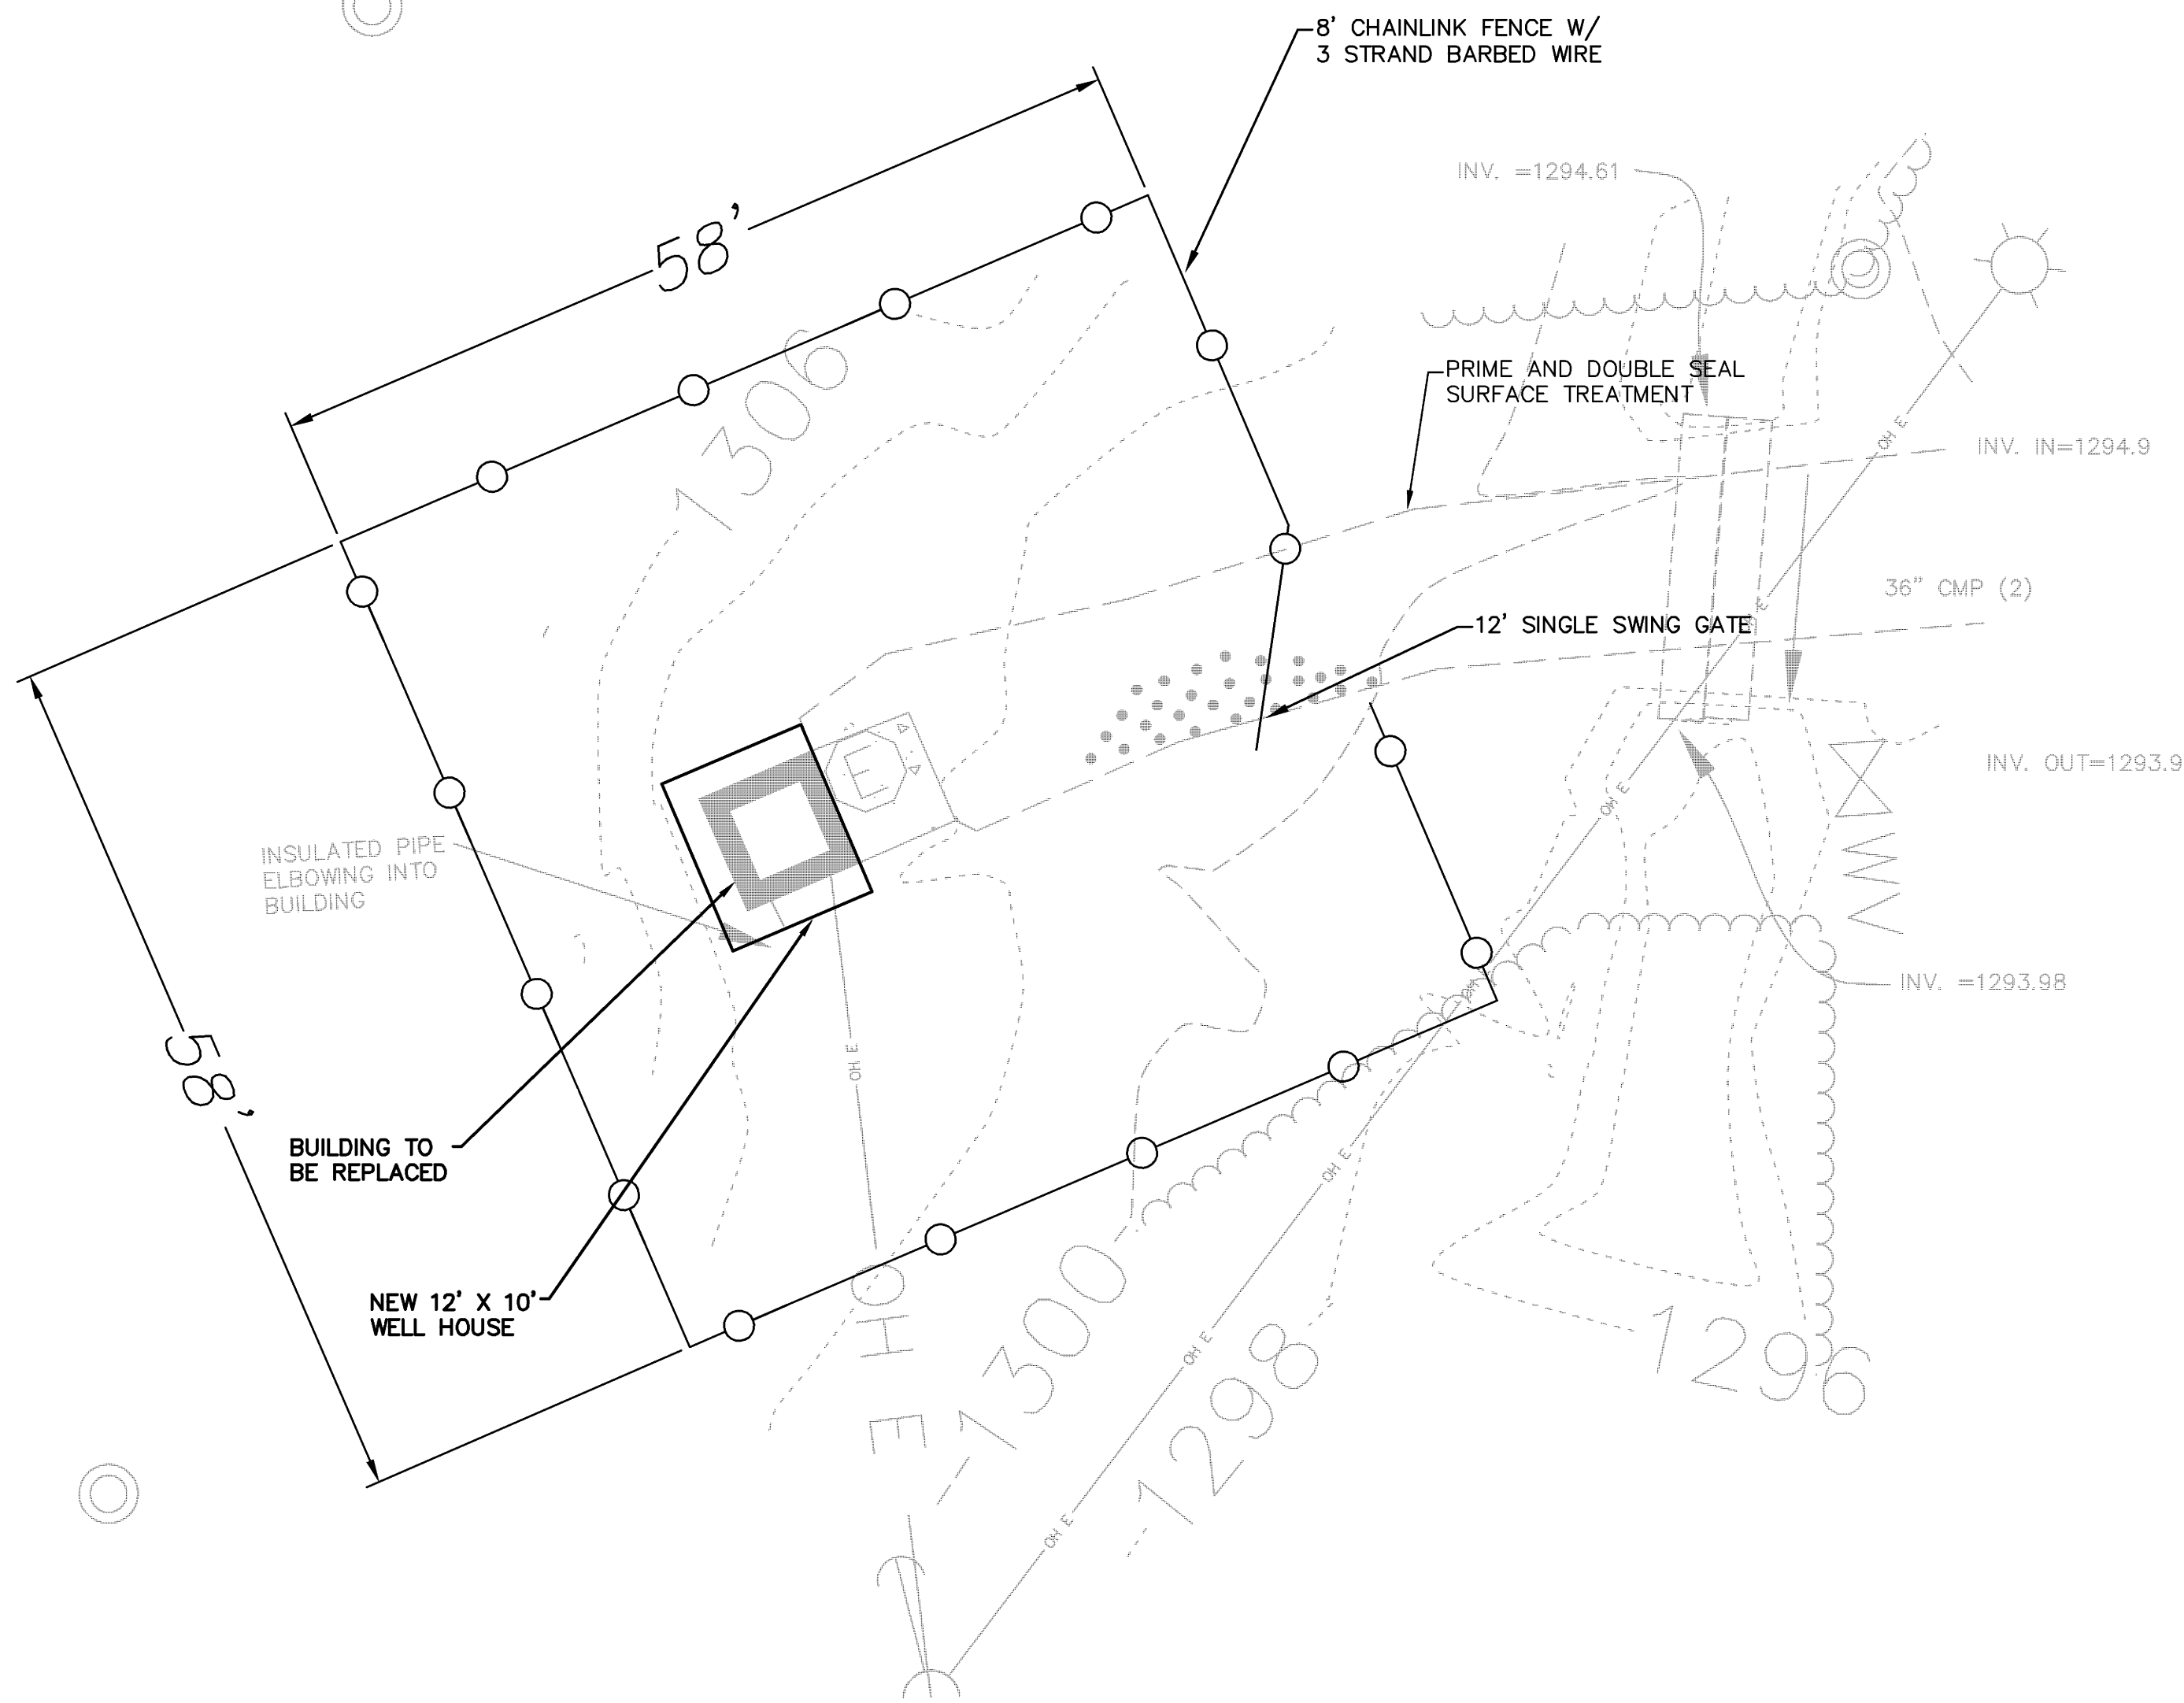


ELEVATION - FRONT VIEW
N.T.S.

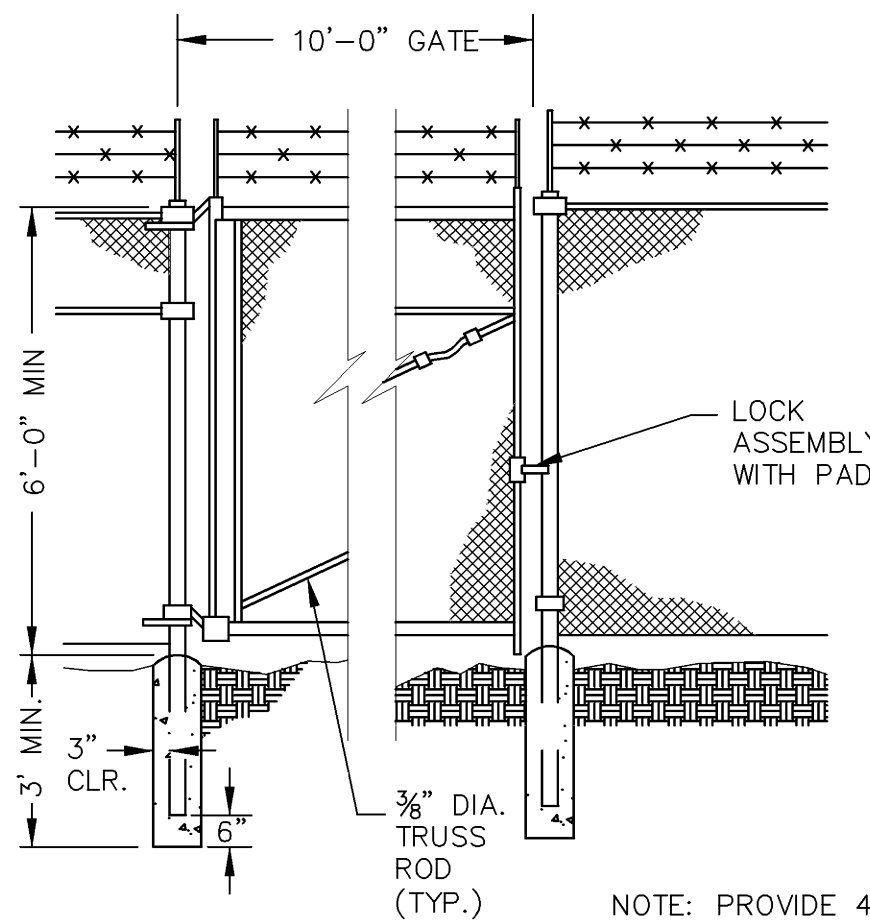


SINGLE GATE
NOT TO SCALE
N.T.S.

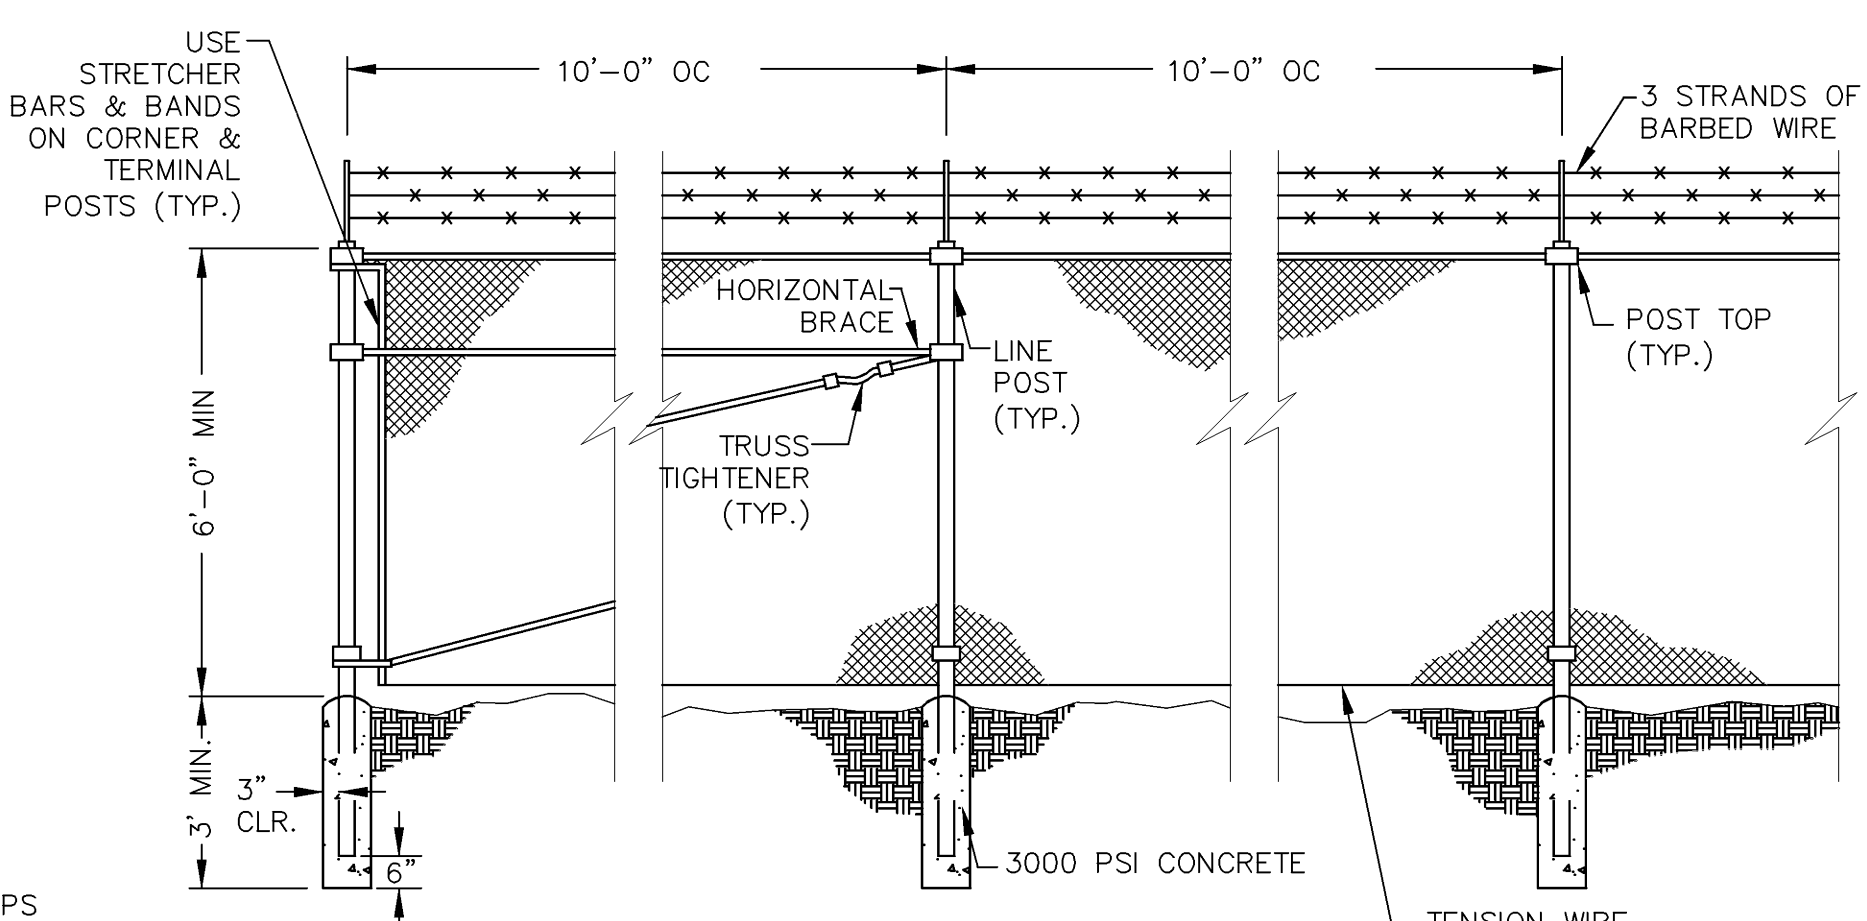


FENCE DETAIL
NOT TO SCALE
N.T.S.

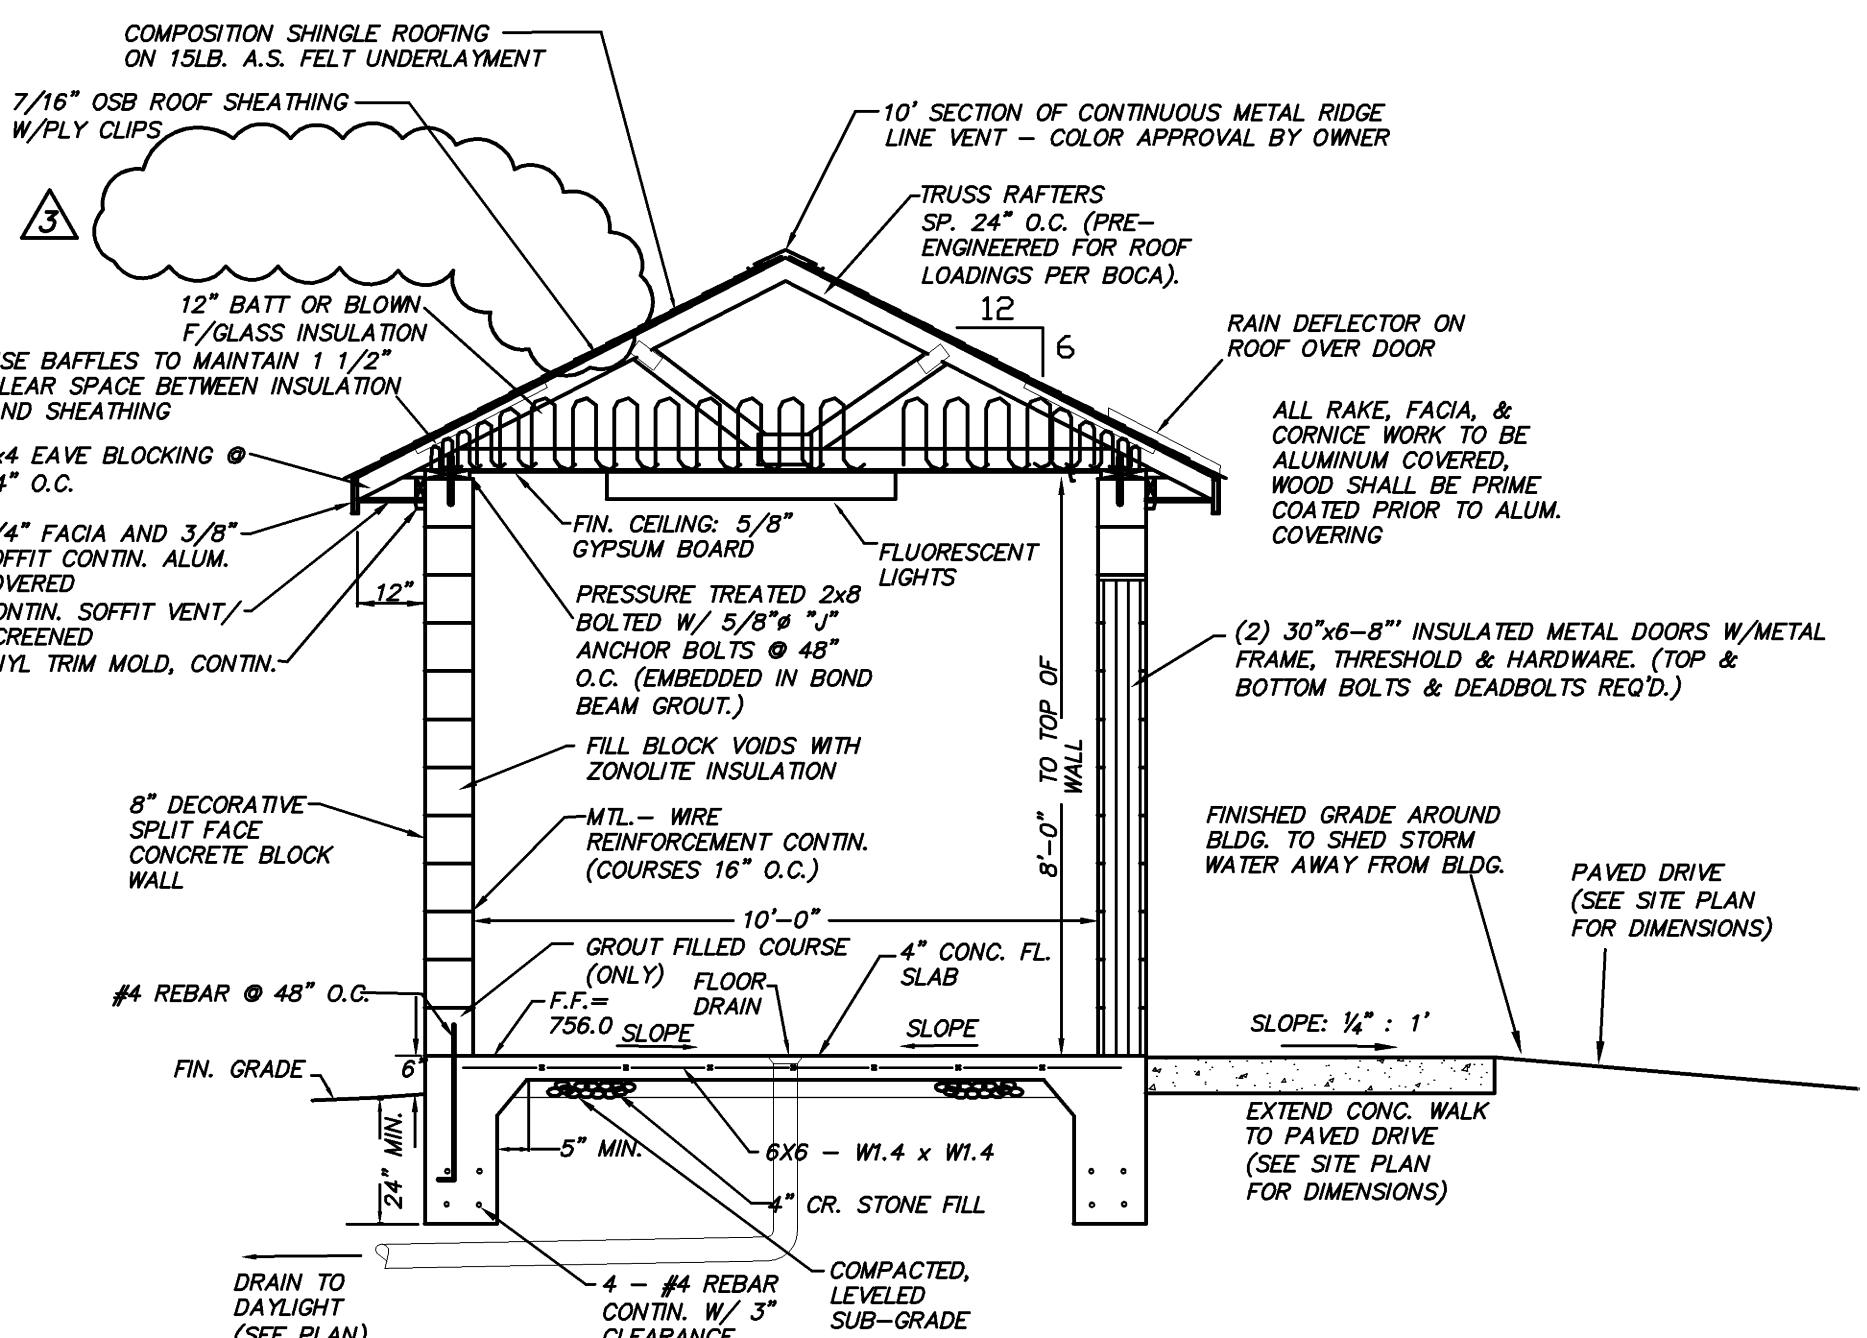

SECTION - MAIN WALL & ROOF
N.T.S.
WELL 1 BUILDING

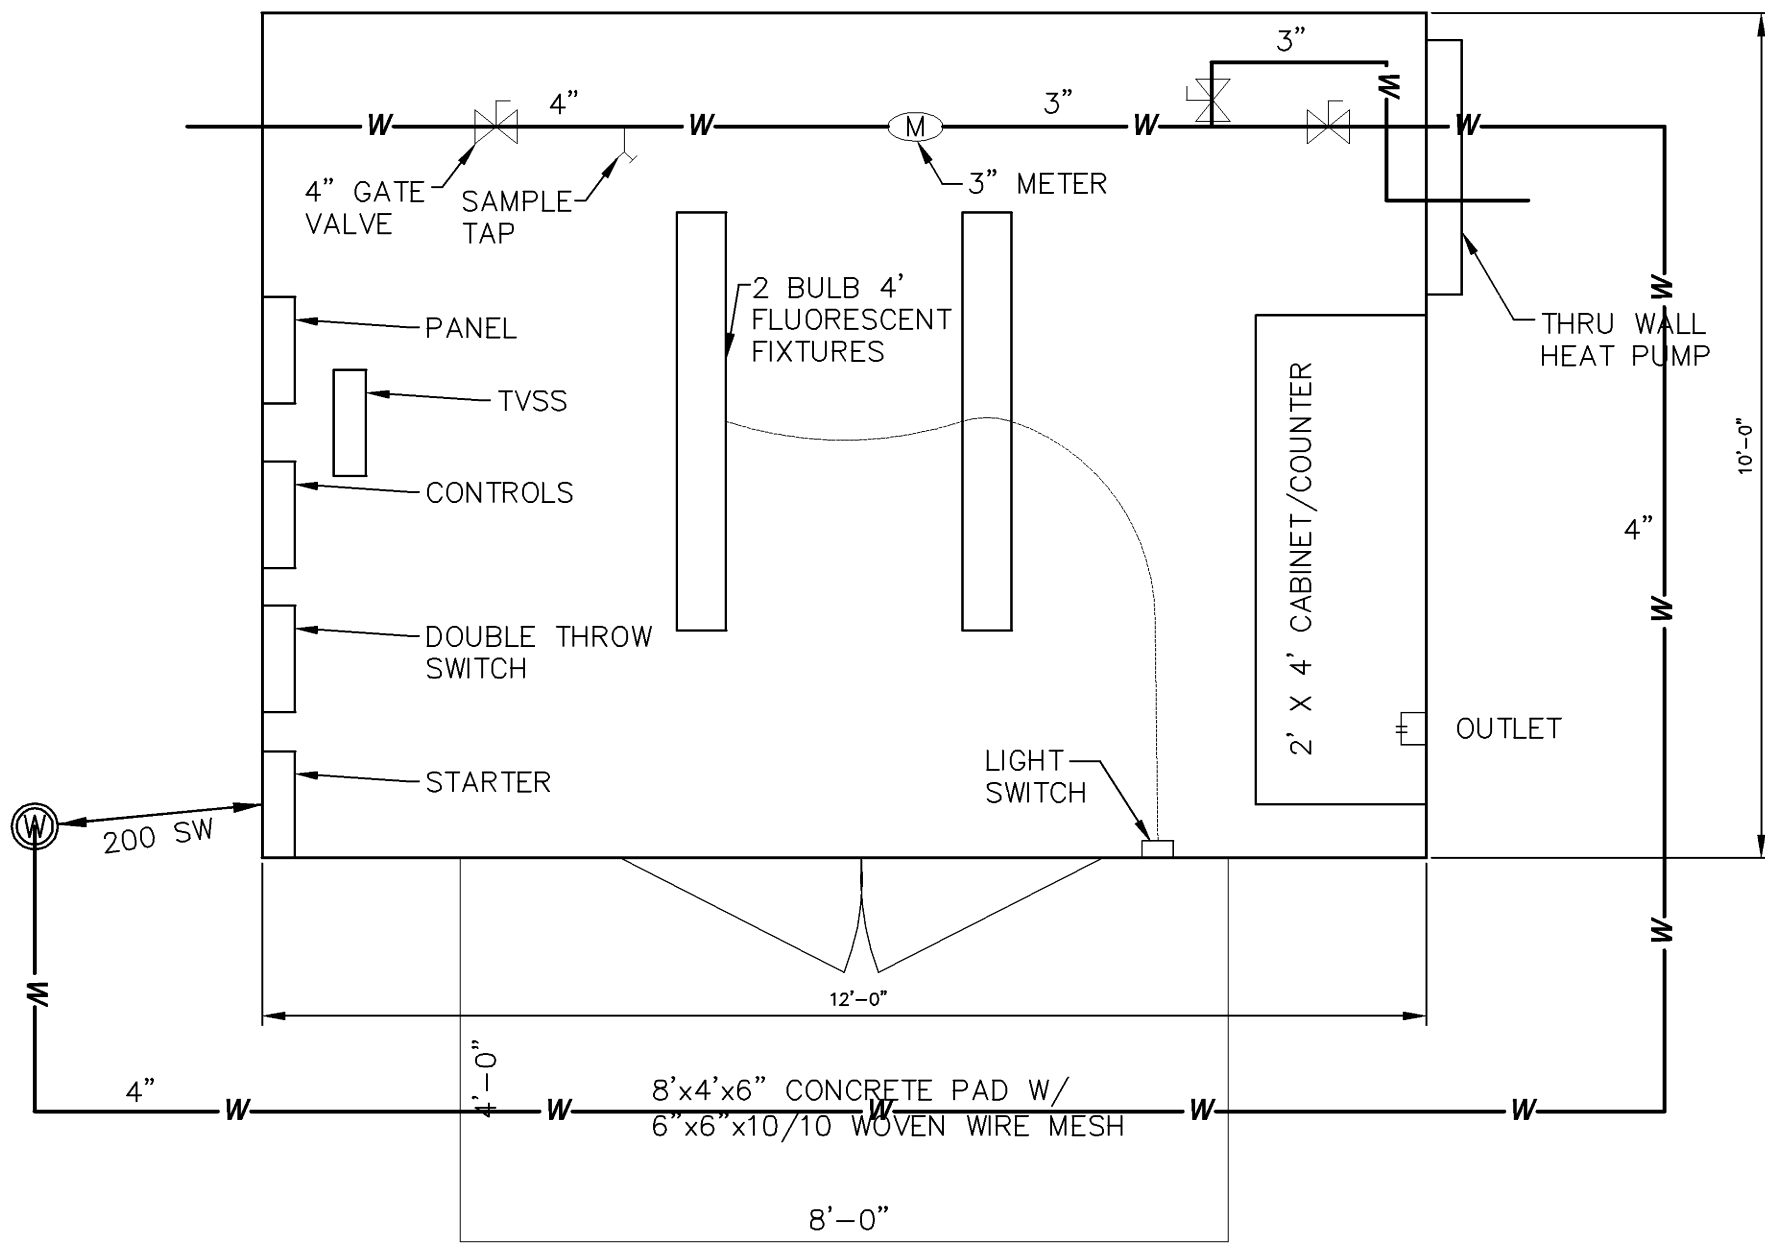

WELL 1 LAYOUT
N.T.S.

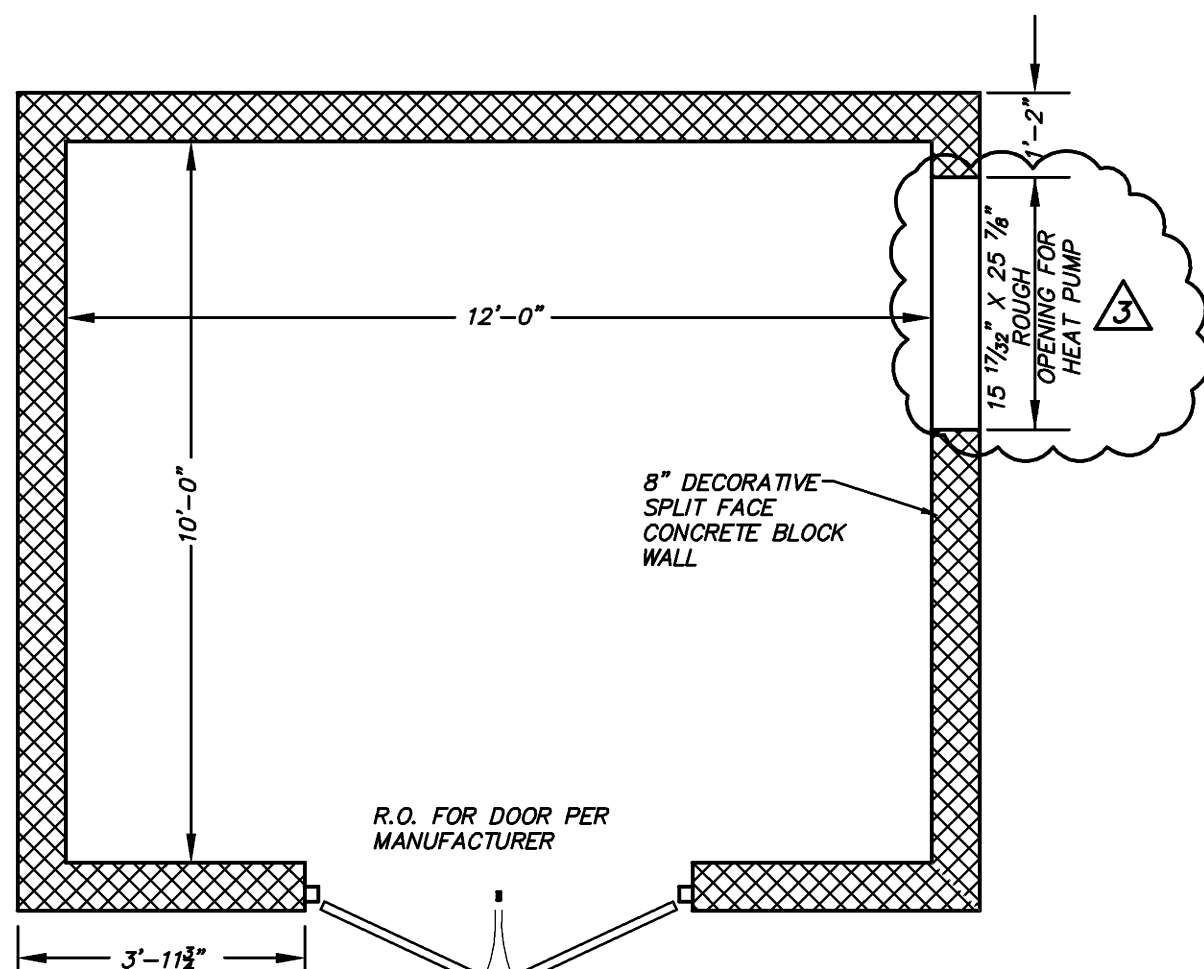

WALL PLAN VIEW
N.T.S.

1	8/28/09	VDH/OWNER COMMENTS
2	9/3/09	VDH/OWNER COMMENTS
3	10/7/09	ADDENDUM #2
4	11/17/09	FRANKLIN COUNTY COMMENTS
5	3/14/12	ASBUILTS

*ENGINEERING >> SURVEYING >> PLANNING

HURT & PROFFITT
INCORPORATED
2524 LANGHORNE ROAD
LYNCHBURG VA 24501
800.242.4906 TOLL FREE
434.847.7796 MAIN
434.847.0047 FAX

WELL #1 SITE PLAN AND DETAILS-ASBUILT
FOR
TOWN OF BOONES MILL WATER SYSTEM REPLACEMENT, VOLUME 2
TOWN OF BOONES MILL, BOONE DISTRICT, FRANKLIN COUNTY, VA

PROJECT NO. 20080815
G.L. NO. 297-03-A3.9
FILE NO. G-12675
DATE: 7/31/09
DRAWN BY: WCH
CHECKED BY: BLC

HURT & PROFFITT

SHEET NO.
C1.11