




Mar 14, 2012 4:11pm V:\unproffitt\projects\20080815.dwg\asbuilts-WTP\ASBUILT-SITE-TANK-DETAILS.dwg

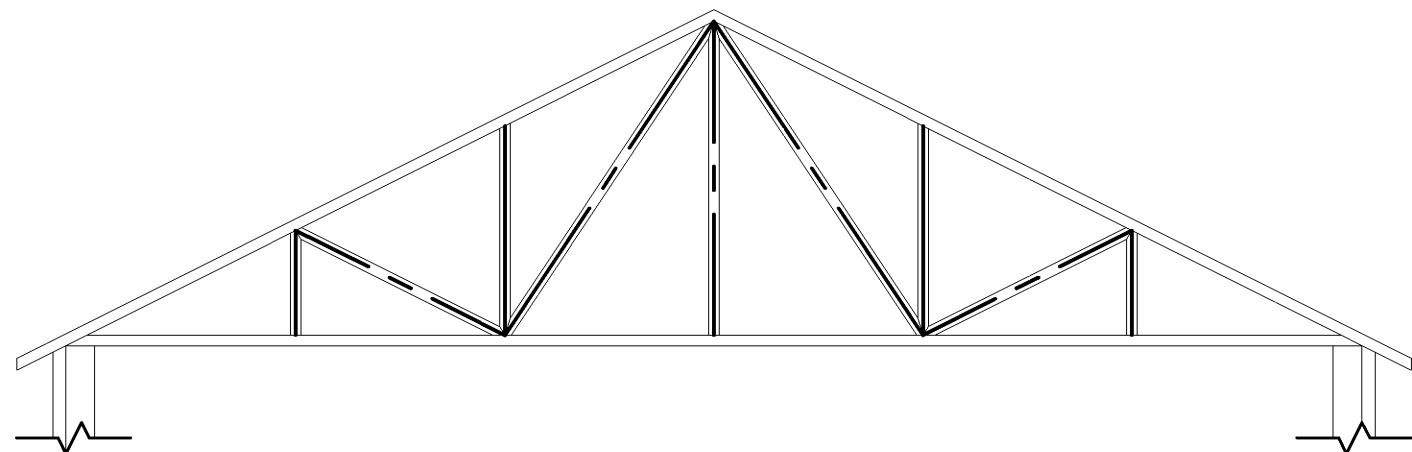


TRUSS ROFILE
SCALE: 3/16"=1'-0"

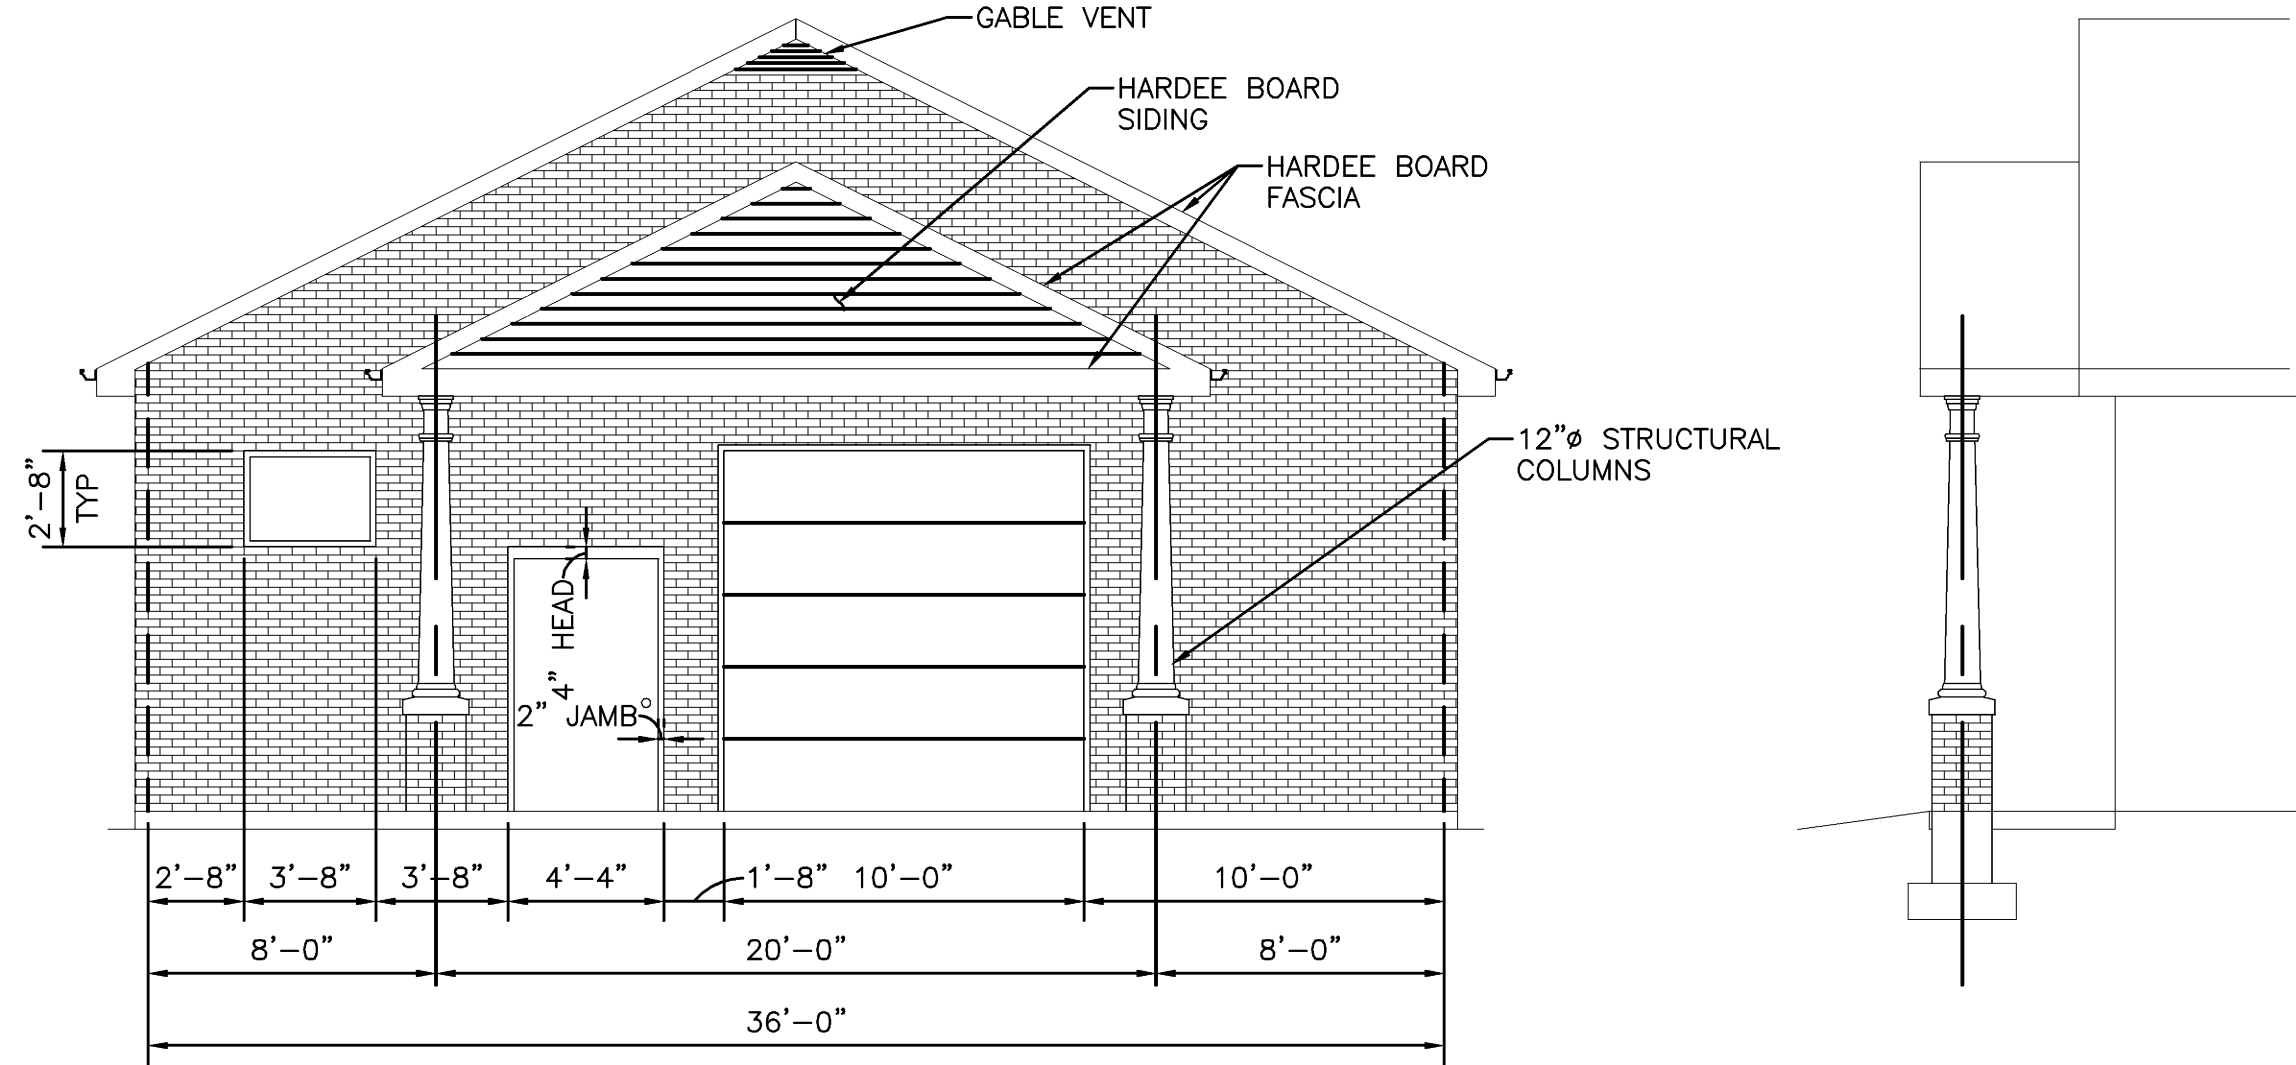


ELEVATION - FRONT VIEW
SCALE: 3/16"=1'-0"

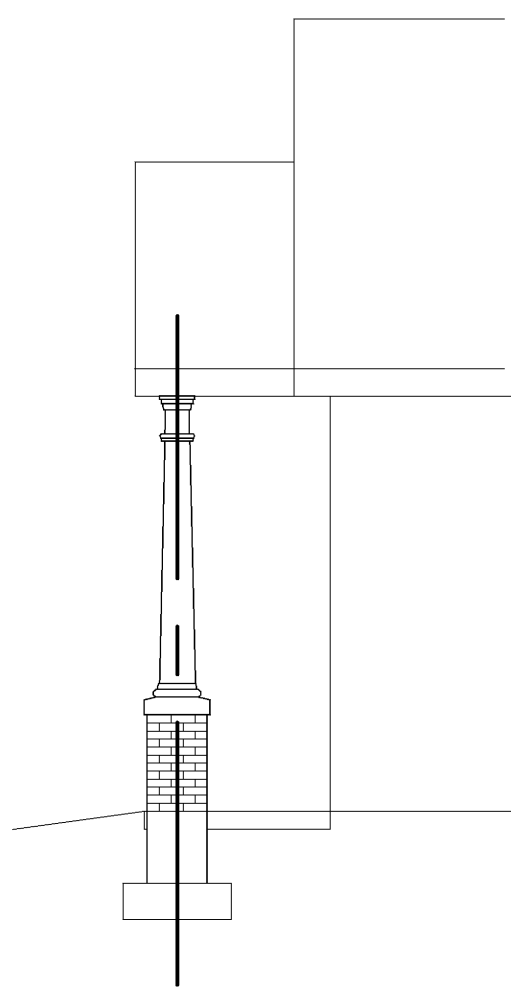


PARTIAL SIDE ELEVATION
SCALE: 3/16"=1'-0"

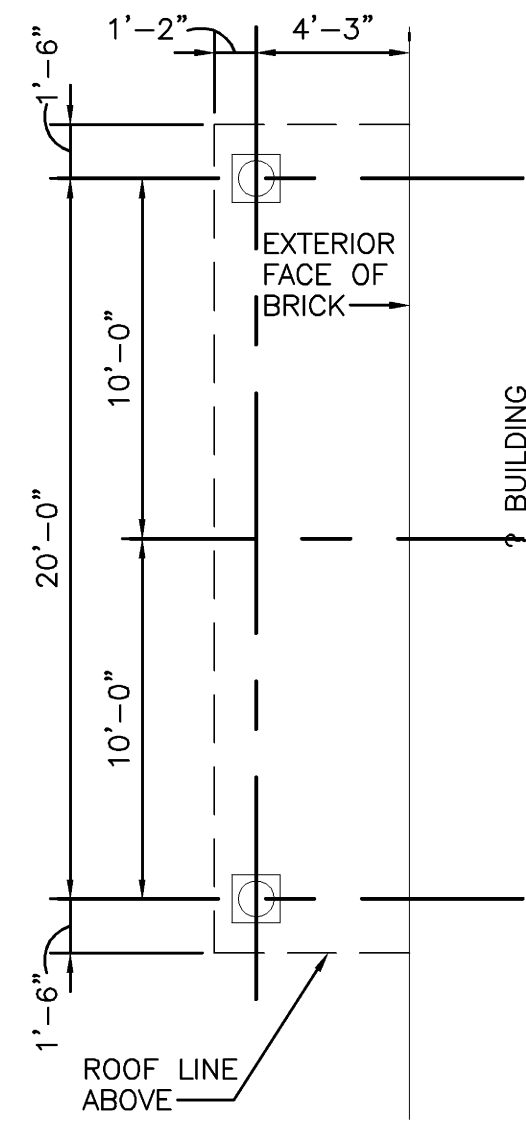


PORCH PLAN VIEW
SCALE: 3/16"=1'-0"

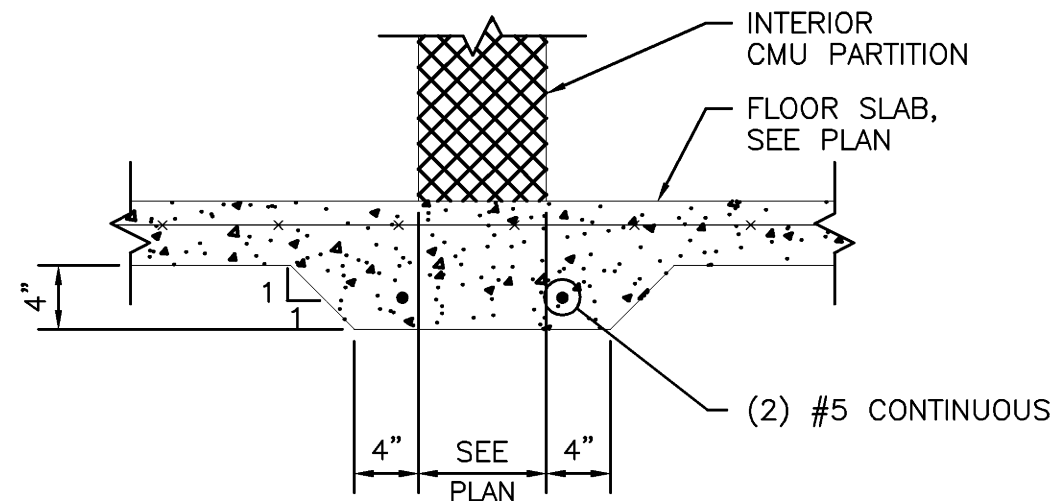


THICKENED SLAB DETAIL
SCALE: 1"=1'-0"

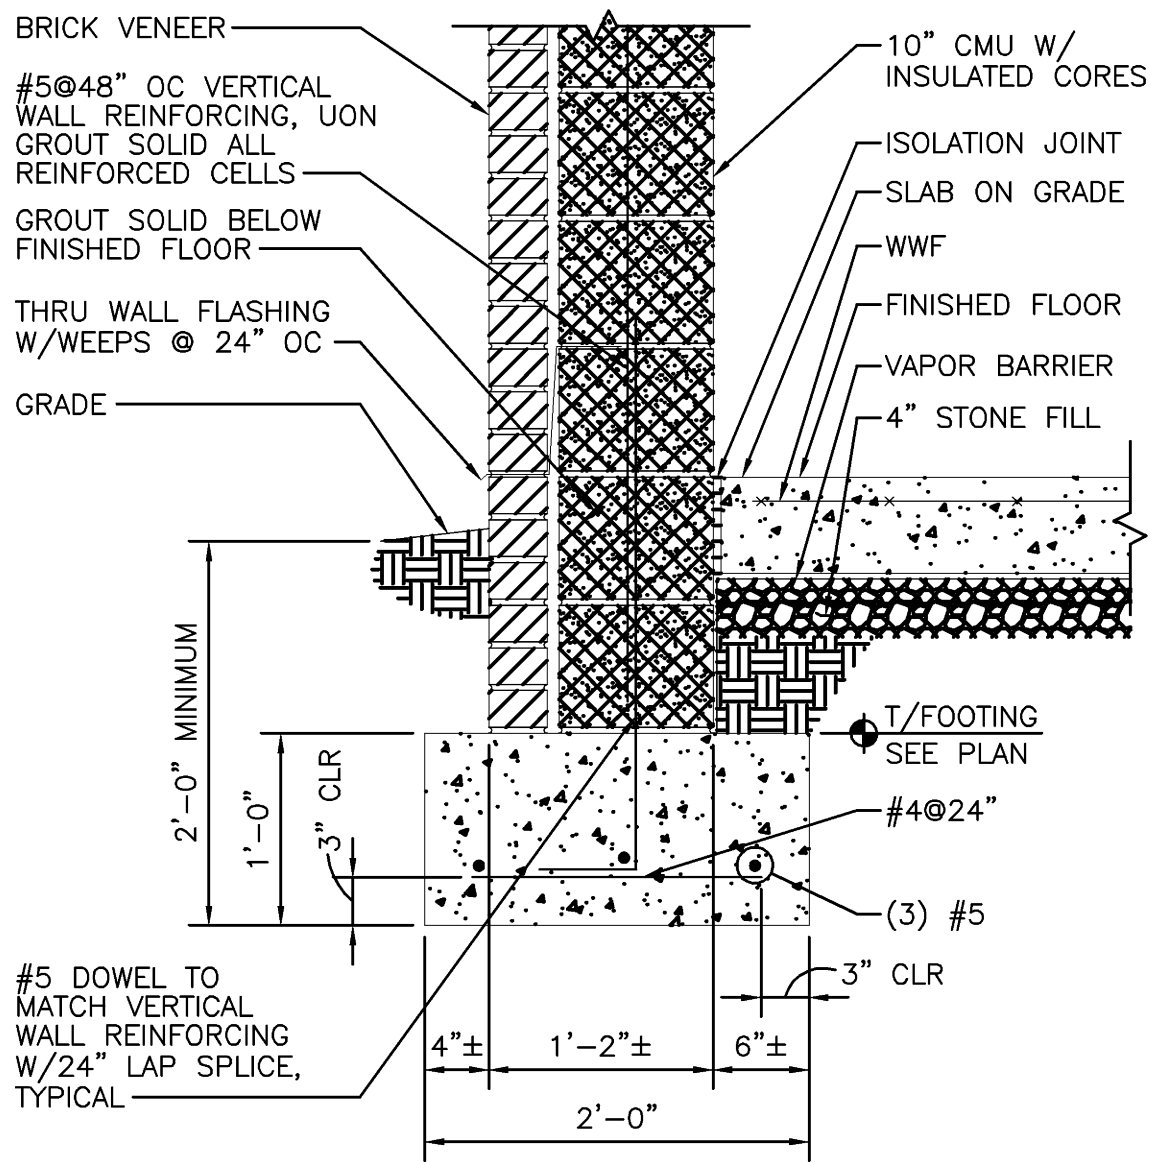


WALL AND FOOTING SECTION
SCALE: 1"=1'-0"

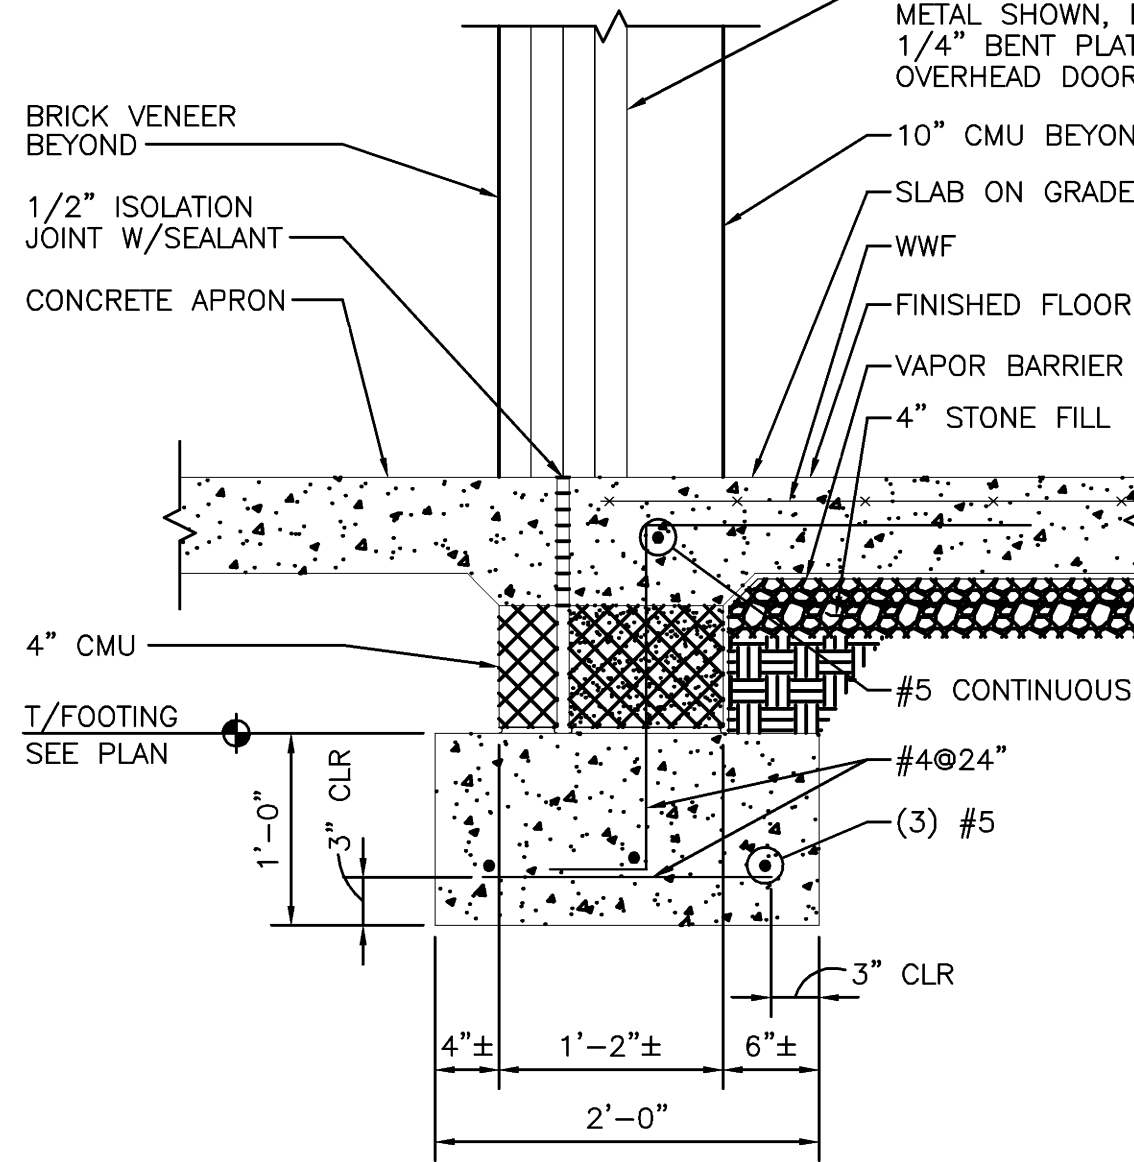


WALL AND FOOTING SECTION AT DOOR
SCALE: 1"=1'-0"

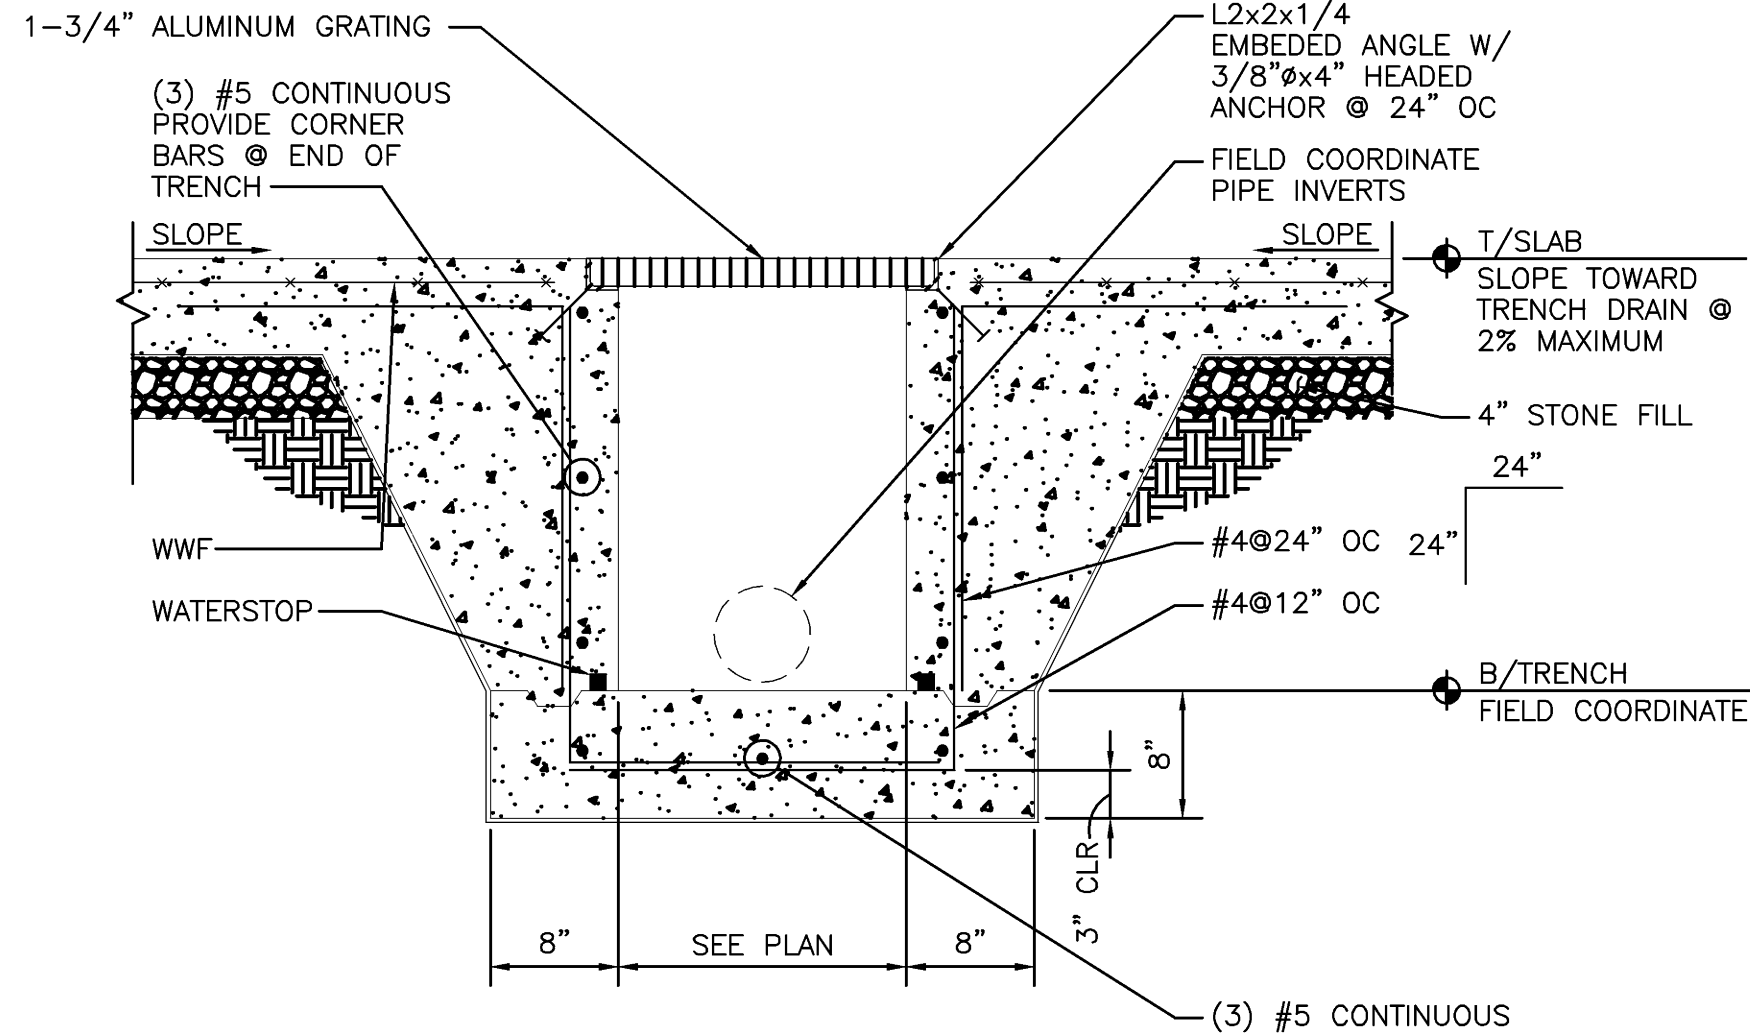

CAST-IN-PLACE TRENCH DETAIL
SCALE: 1"=1'-0"

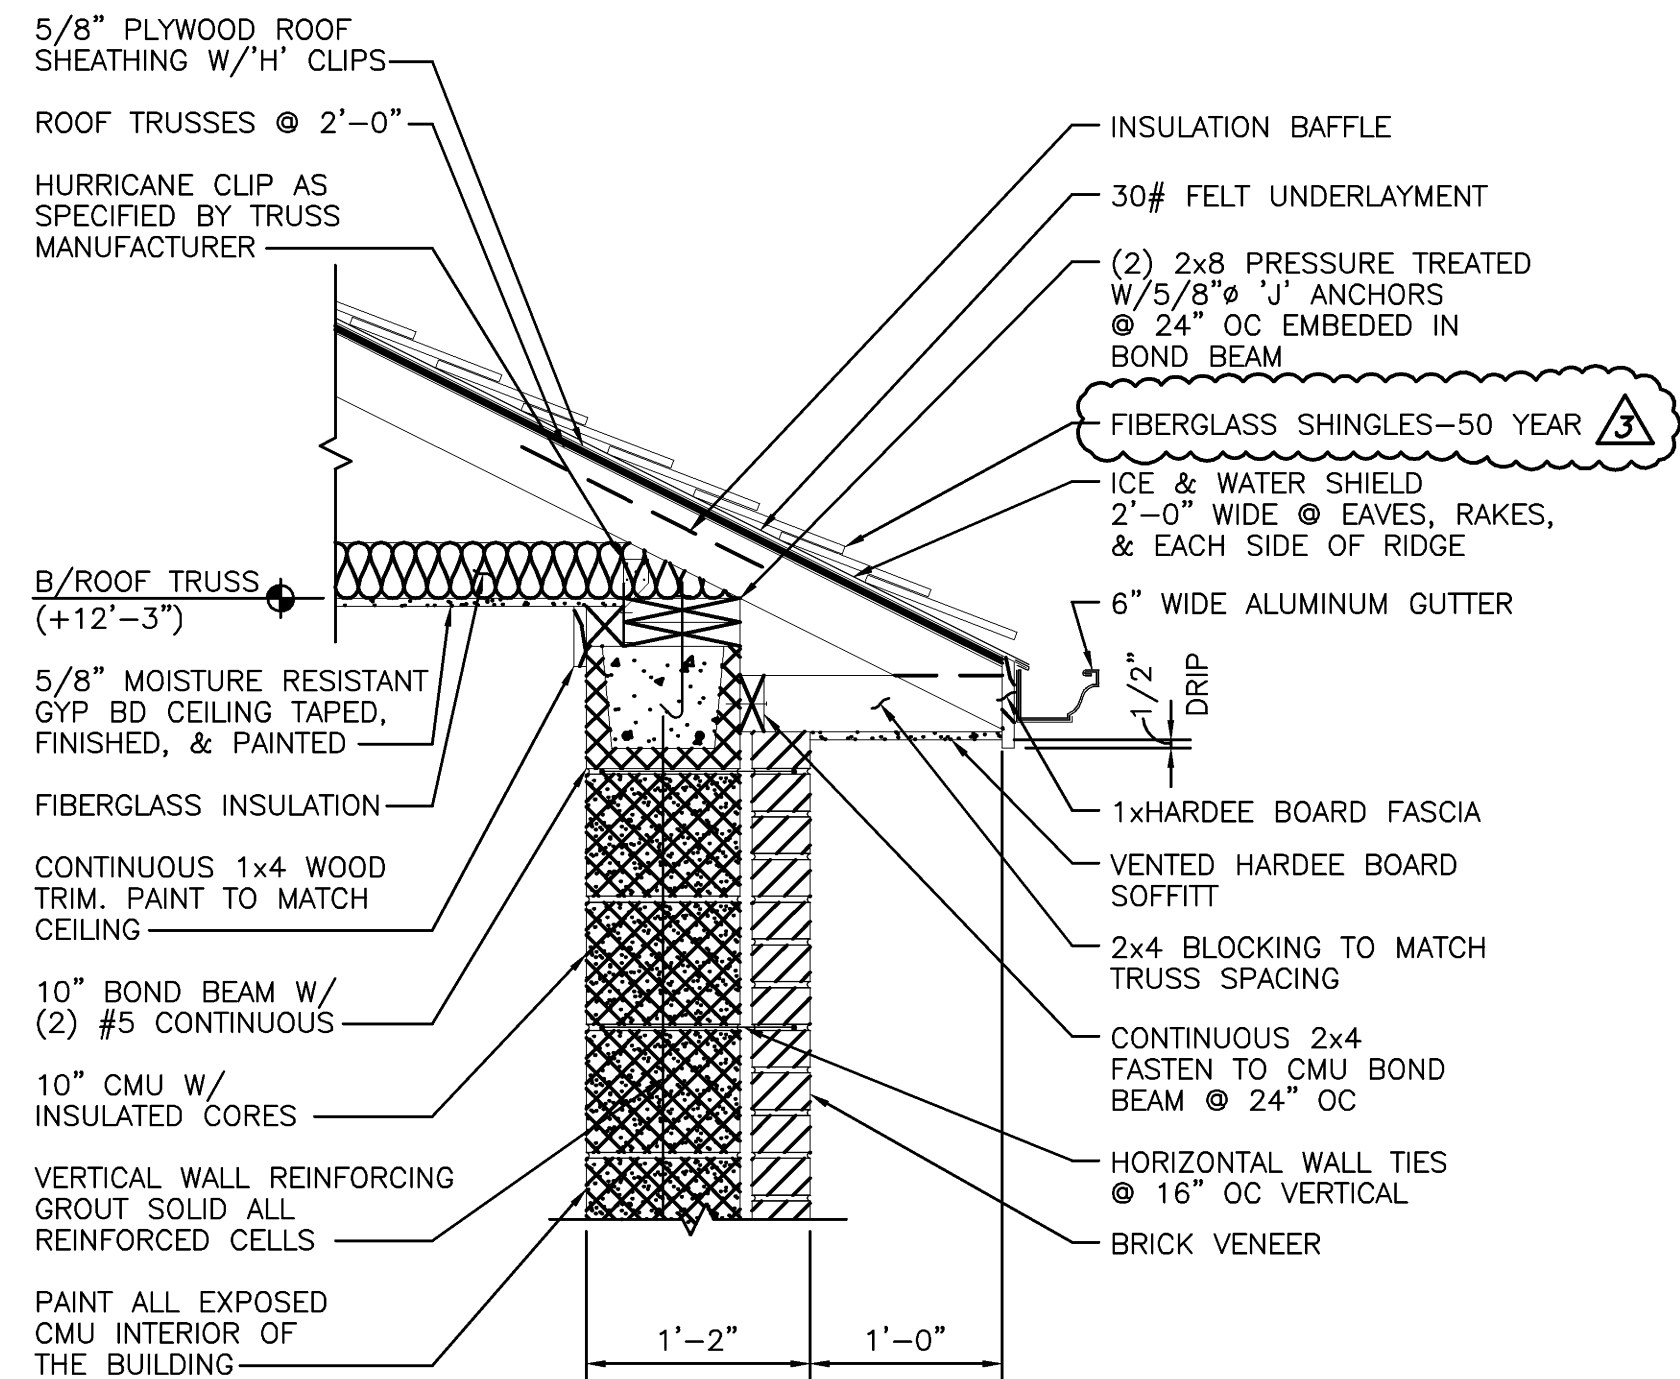

EAVE WALL SECTION
SCALE: 1"=1'-0"

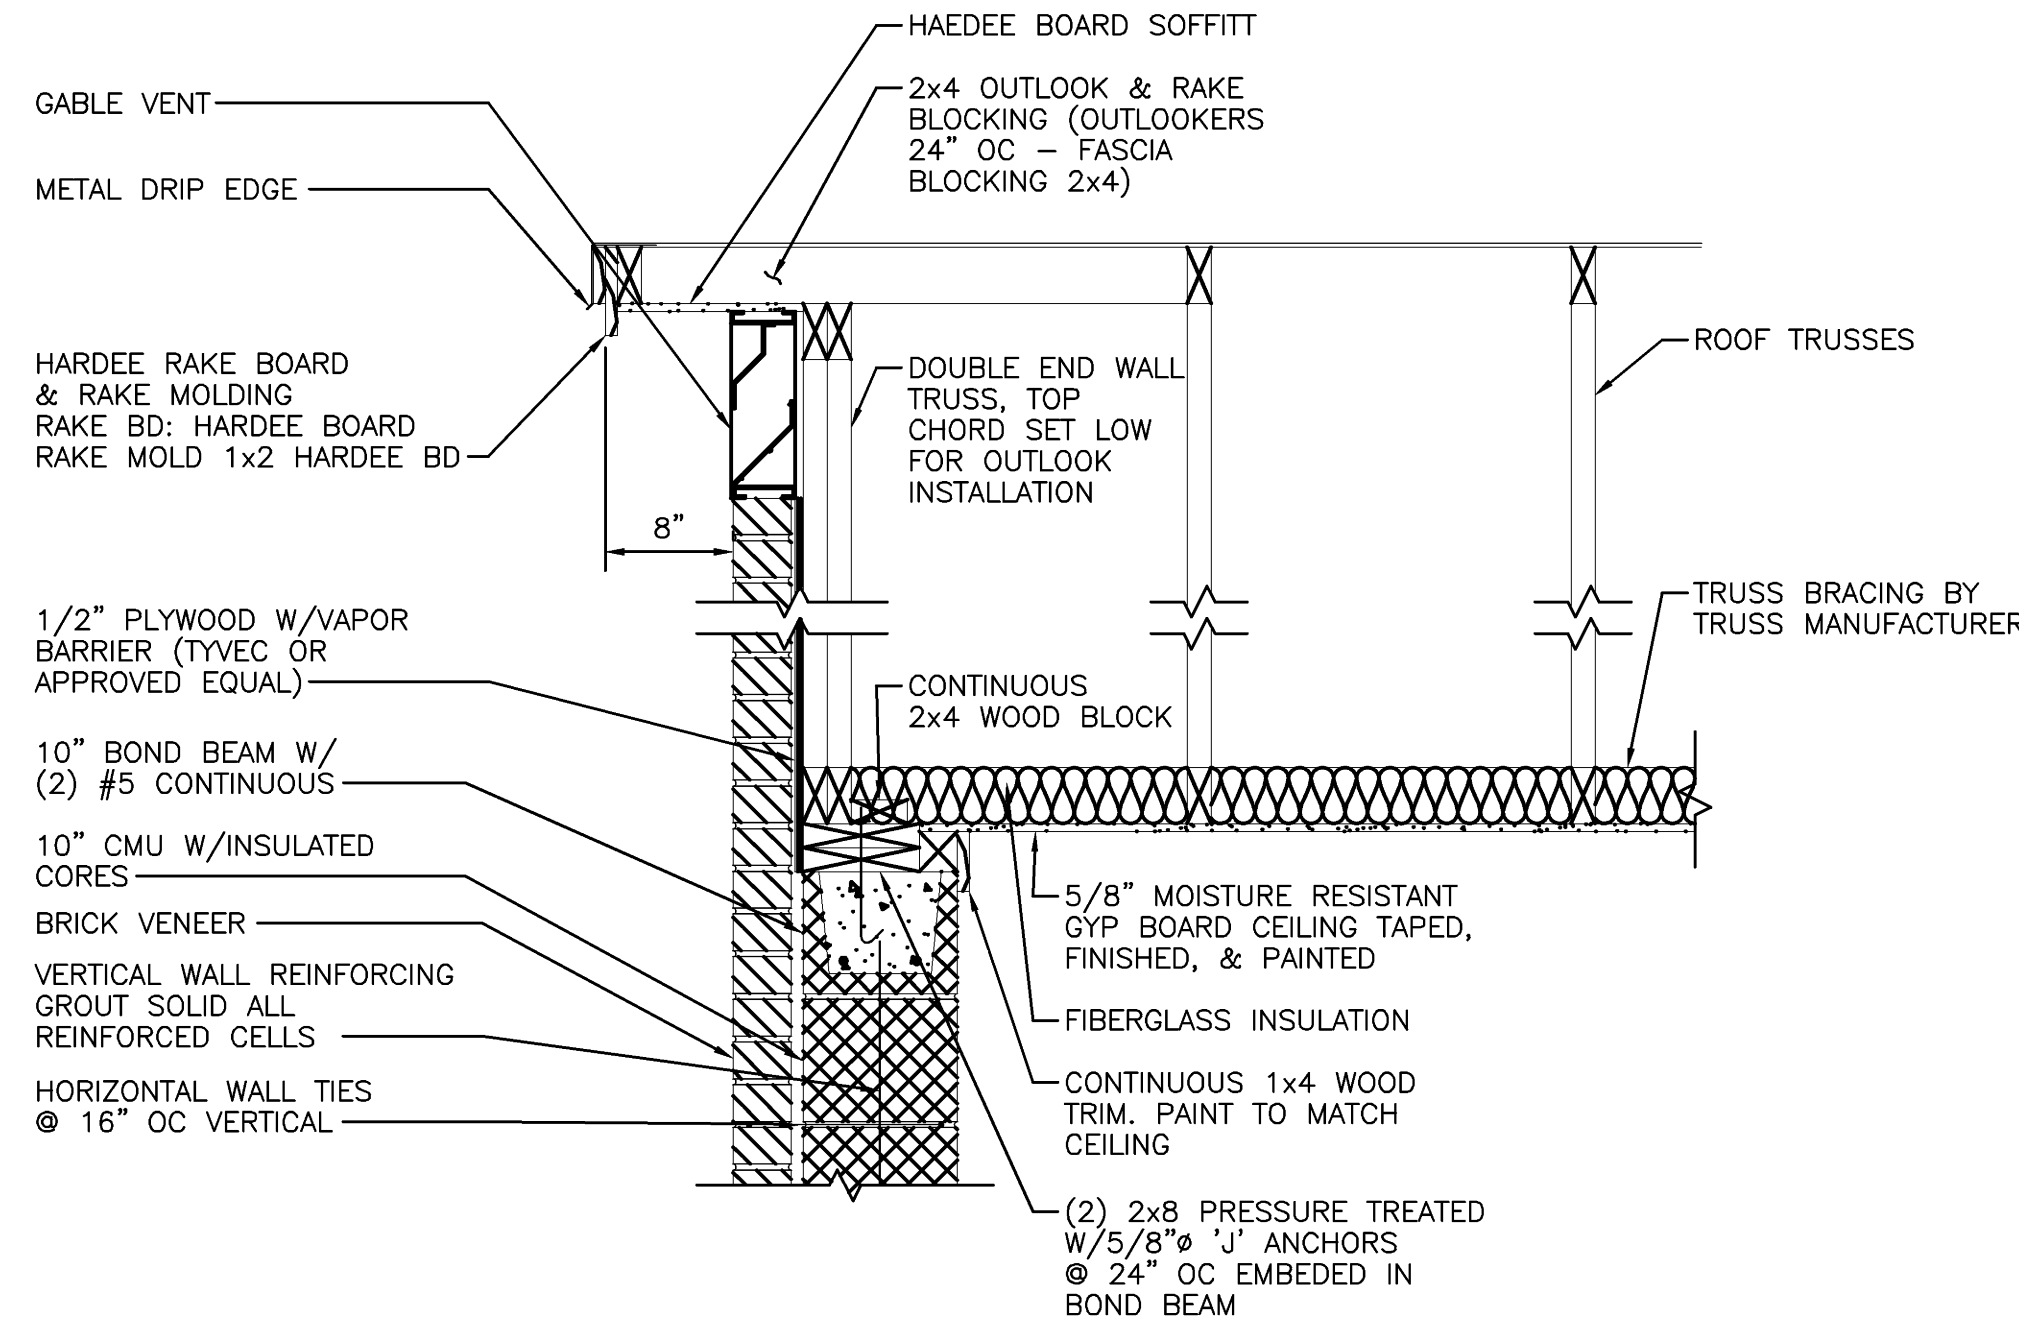

GABLE WALL SECTION
SCALE: 1"=1'-0"

LINTEL SCHEDULE				
MARK	TYPE	DESCRIPTION	BOTTOM OF LINTEL	MASONRY OPENING
L-1		10" BOND BEAM W/(2) #5 CONTINUOUS W/L4x3 1/2x1/4 LLV. 8" BEARING @ EACH END.	7'-4" @ DOORS 10'-0" @ WINDOWS	4'-4"Wx7'-4"T @ DOORS 3'-8"Wx2'-8"T @ WINDOWS
L-2		(2) 10" BOND BEAM W/(4) #5 CONTINUOUS W/L6x4x3/8 LLV & 5/8" HILTI @ 24" OC. 8" BEARING @ EACH END.	10'-0"	10'-0"x10'-0"
L-3		(2) 10" BOND BEAM W/(4) #5 CONTINUOUS W/L6x4x3/8 LLV & 5/8" HILTI @ 24" OC. 8" BRG @ EACH END & @ MIDDLE.	9'-4"± FIELD VERIFY W/FUTURE TANKS	FUTURE OPENINGS IN MASONRY WALL FOR FUTURE CONTACT TANKS

NOTE: PROVIDE THRU WALL FLASHING WITH WEEPS @ 24" OC ABOVE ALL DOOR AND WINDOW OPENINGS.

2	9/3/09	OWNER COMMENTS
3	10/7/09	ADDENDUM #2
4	11/17/09	FRANKLIN COUNTY COMMENTS
5	3/14/12	ASBUILTS

*ENGINEERING >> SURVEYING >> PLANNING

HURT & PROFFITT
INCORPORATED



2524 LANGHORNE ROAD
LYNCHBURG VA 24501
800.242.4906 TOLL FREE
434.847.7796 MAIN
434.847.0047 FAX

WATER TREATMENT BUILDING DETAILS-ASBUILT
FOR
TOWN OF BOONES MILL WATER SYSTEM REPLACEMENT, VOLUME 2
TOWN OF BOONES MILL, BOONE DISTRICT, FRANKLIN COUNTY, VA

PROJECT NO. 20080815
G.L. NO. 297-03-AS.9
FILE NO. G-12675
DATE: 7/31/09
DRAWN BY: ASK
CHECKED BY: BLC

HURT & PROFFITT

SHEET NO.
S1.2