


Mar 14, 2012 - 4:11pm V:\unaprojects\20080815.dwg\asbuils-WTP\ASBUIL-DETAILS.dwg

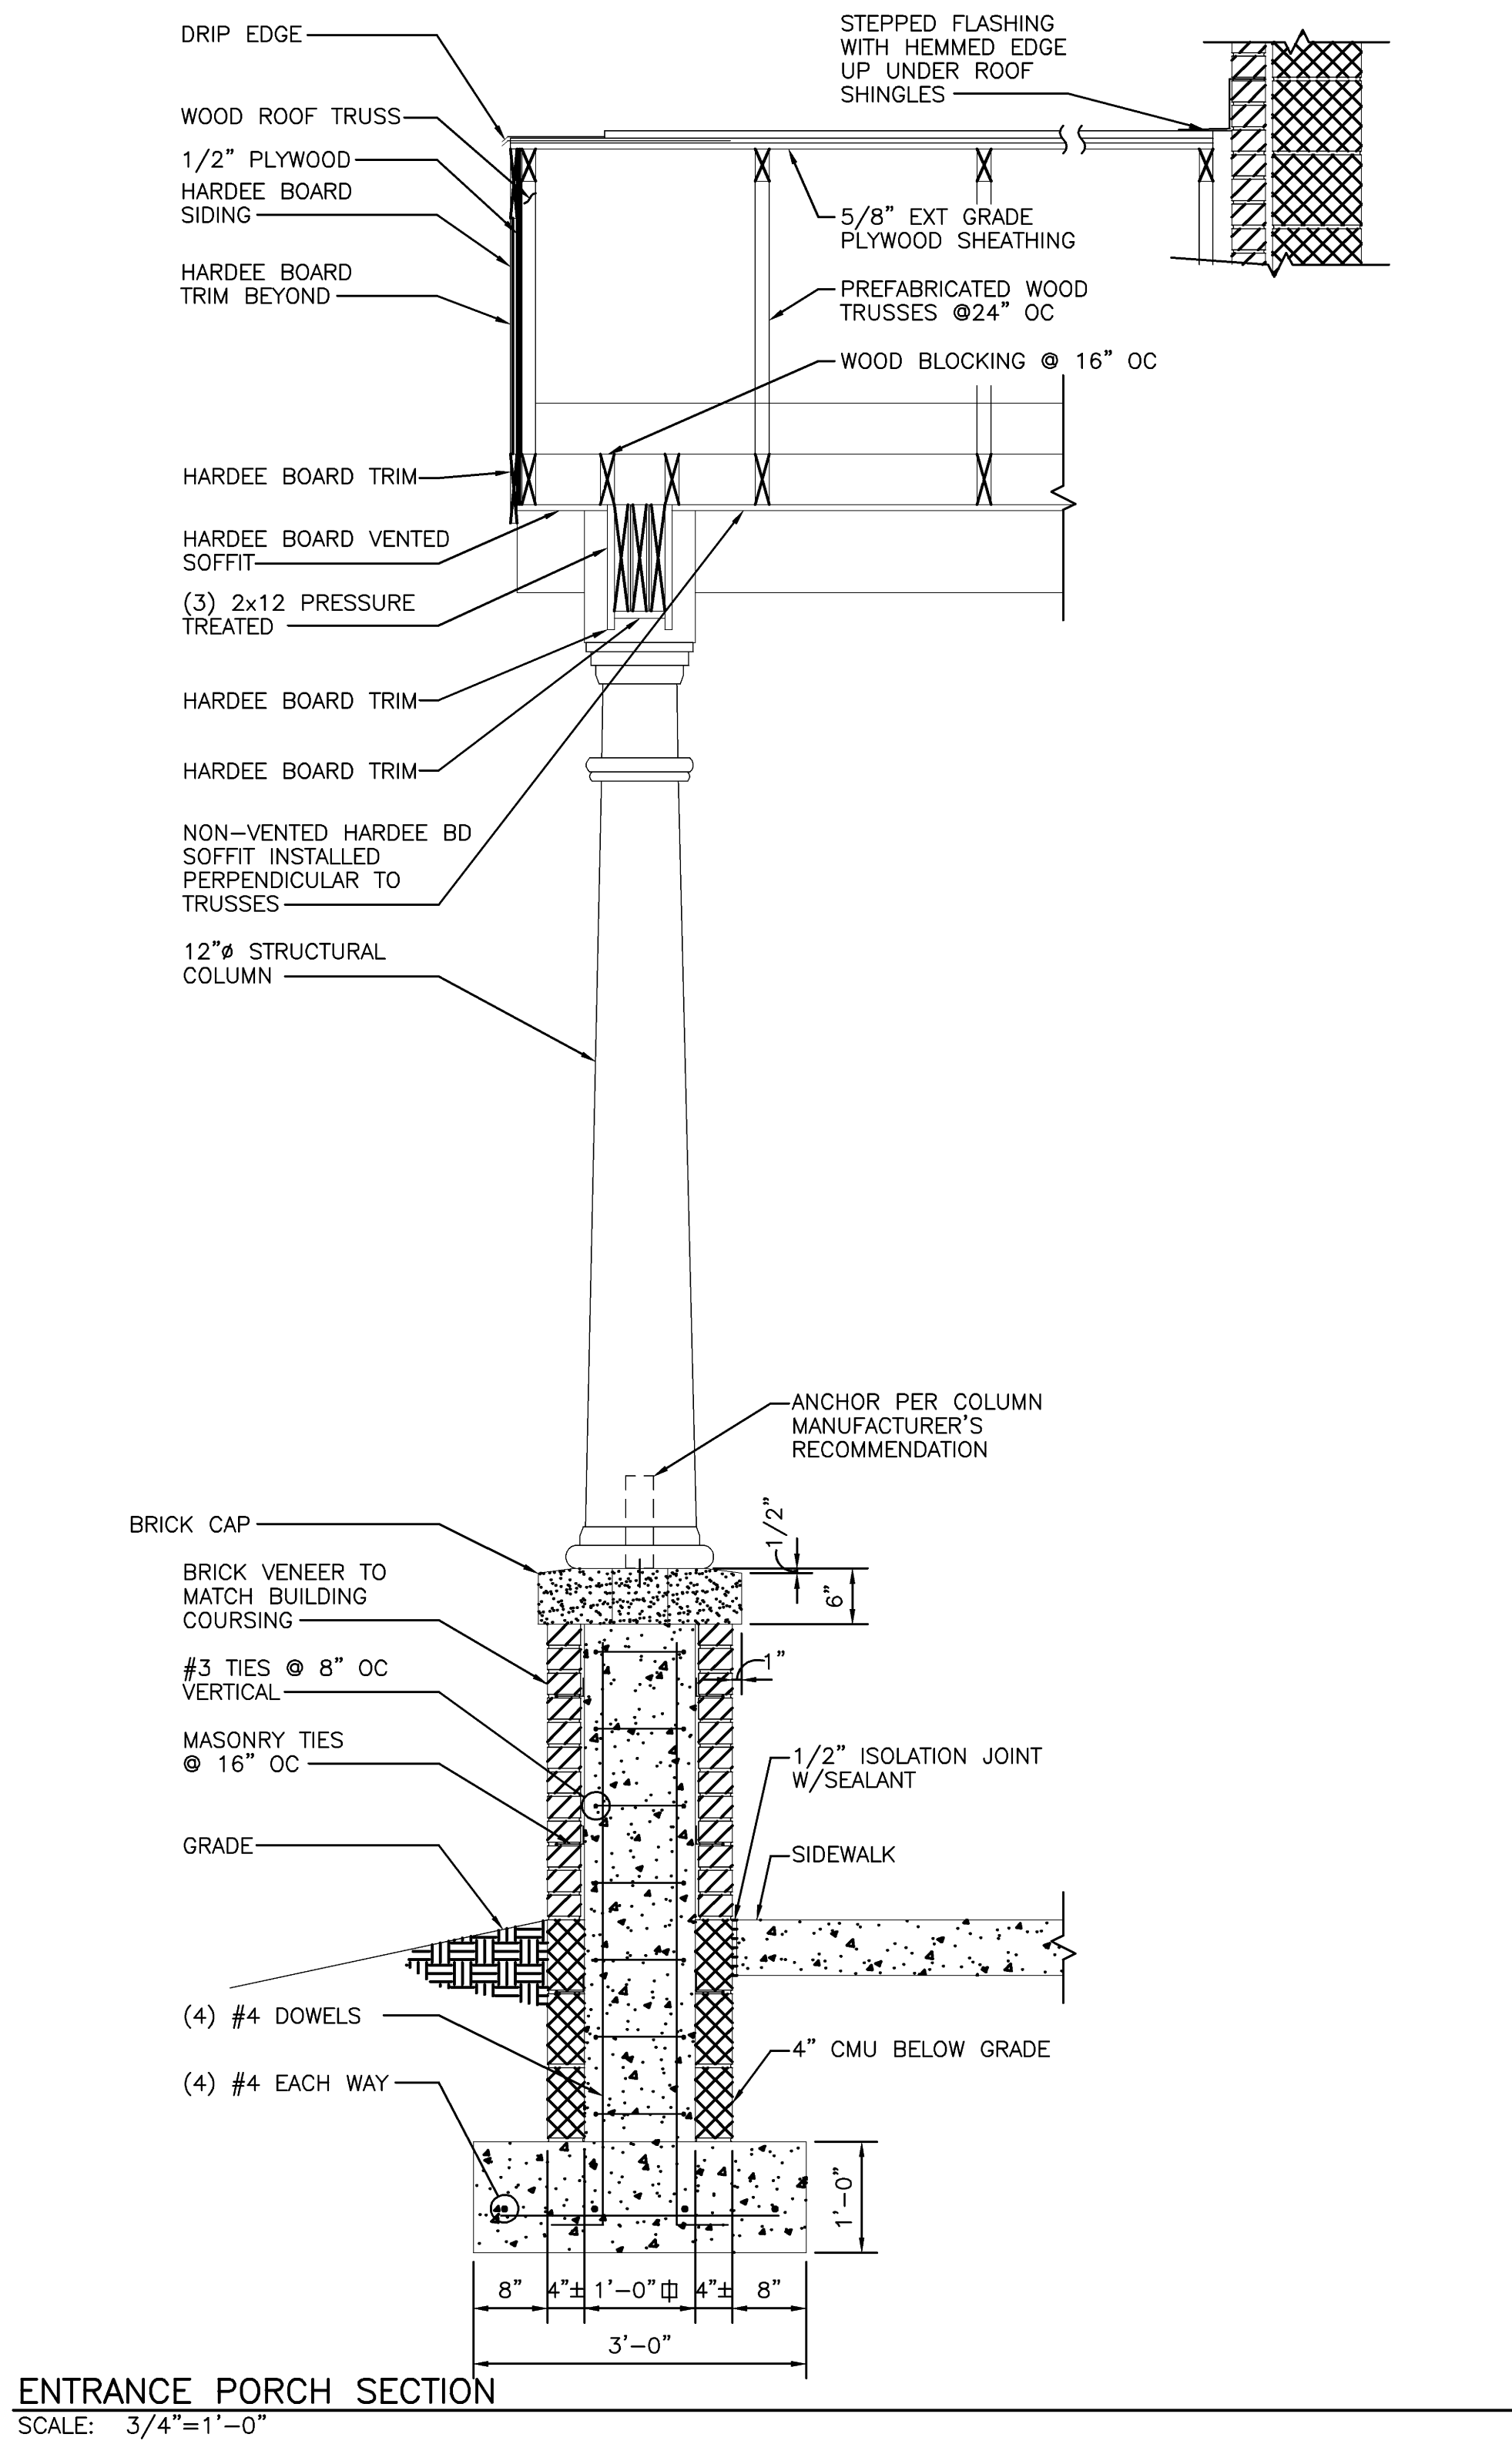

*ENGINEERING >> SURVEYING >> PLANNING

HURT & PROFFITT
INCORPORATED
2524 LANGHORNE ROAD
LYNCHBURG VA 24501
800.242.4906 TOLL FREE
434.847.7796 MAIN
434.847.0047 FAX

WATER TREATMENT BUILDING DETAILS-ASBUILT
FOR
TOWN OF BOONES MILL WATER SYSTEM REPLACEMENT, VOLUME 2
TOWN OF BOONES MILL, BOONE DISTRICT, FRANKLIN COUNTY, VA

PROJECT NO. 20080815
G.L. NO. 297-03-A3.9
FILE NO. G-12675
DATE: 7/31/09
DRAWN BY: ASK
CHECKED BY: BLC

HURT & PROFFITT

SHEET NO.
S1.3

2	9/3/09	OWNER COMMENTS
4	11/17/09	FRANKLIN COUNTY COMMENTS
5	3/14/12	ASBUILTS