
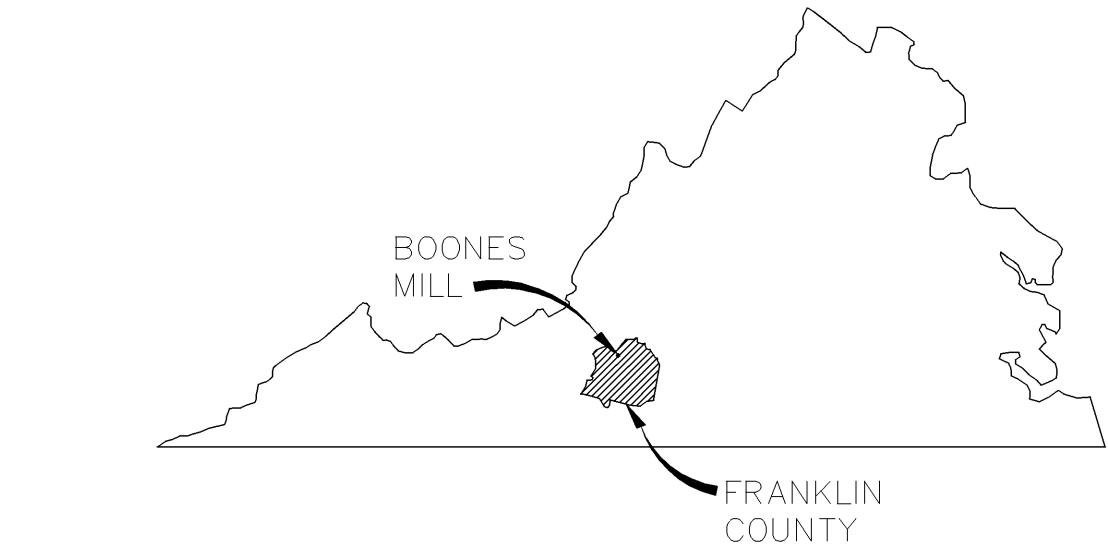


TOWN OF BOONES MILL  
WATER SYSTEM REPLACEMENT, VOLUME 2-ASBUILT  
TOWN OF BOONES MILL, BOONE DISTRICT, FRANKLIN COUNTY, VIRGINIA

- PROPOSED LEGEND**
- WATER METER
  - WATER LINE
  - BLOW OFF ASSEMBLY
  - AIR RELEASE
  - FIRE HYDRANT
  - CONCRETE ANCHOR
  - GATE VALVE
  - STEEL CASING
- EXISTING LEGEND**
- ELECTRIC POLE
  - GUY WIRE
  - UTILITY PEDESTAL
  - LIGHT POLE
  - EDGE OF PAVEMENT
  - EDGE OF GRAVEL
  - BENCHMARK
  - SIGN
  - CONCRETE PAD
  - EDGE OF WOODS
  - EXISTING FENCE LINE
  - OVERHEAD ELECTRIC
  - UG ELECTRIC LINE
  - UG GAS LINE
  - UG TELEPHONE LINE
  - UG FIBER OPTIC LINE
  - UG WATER LINE
  - DITCH LINE
  - E.O.L. END OF LINE

VIRGINIA UNIFORM CODING SYSTEM FOR EROSION  
AND SEDIMENT CONTROL PRACTICES  
\* CHART TAKEN FROM THE VIRGINIA EROSION AND  
SEDIMENT CONTROL HANDBOOK (JULY 1992)

- SILT FENCE
- TEMPORARY SEEDING
- PERMANENT SEEDING
- MULCHING
- TEMPORARY CONSTRUCTION  
ENTRANCE
- CULVERT INLET PROTECTION
- INLET PROTECTION
- BLANKET MATTING
- SURFACE ROUGHING
- OUTLET PROTECTION

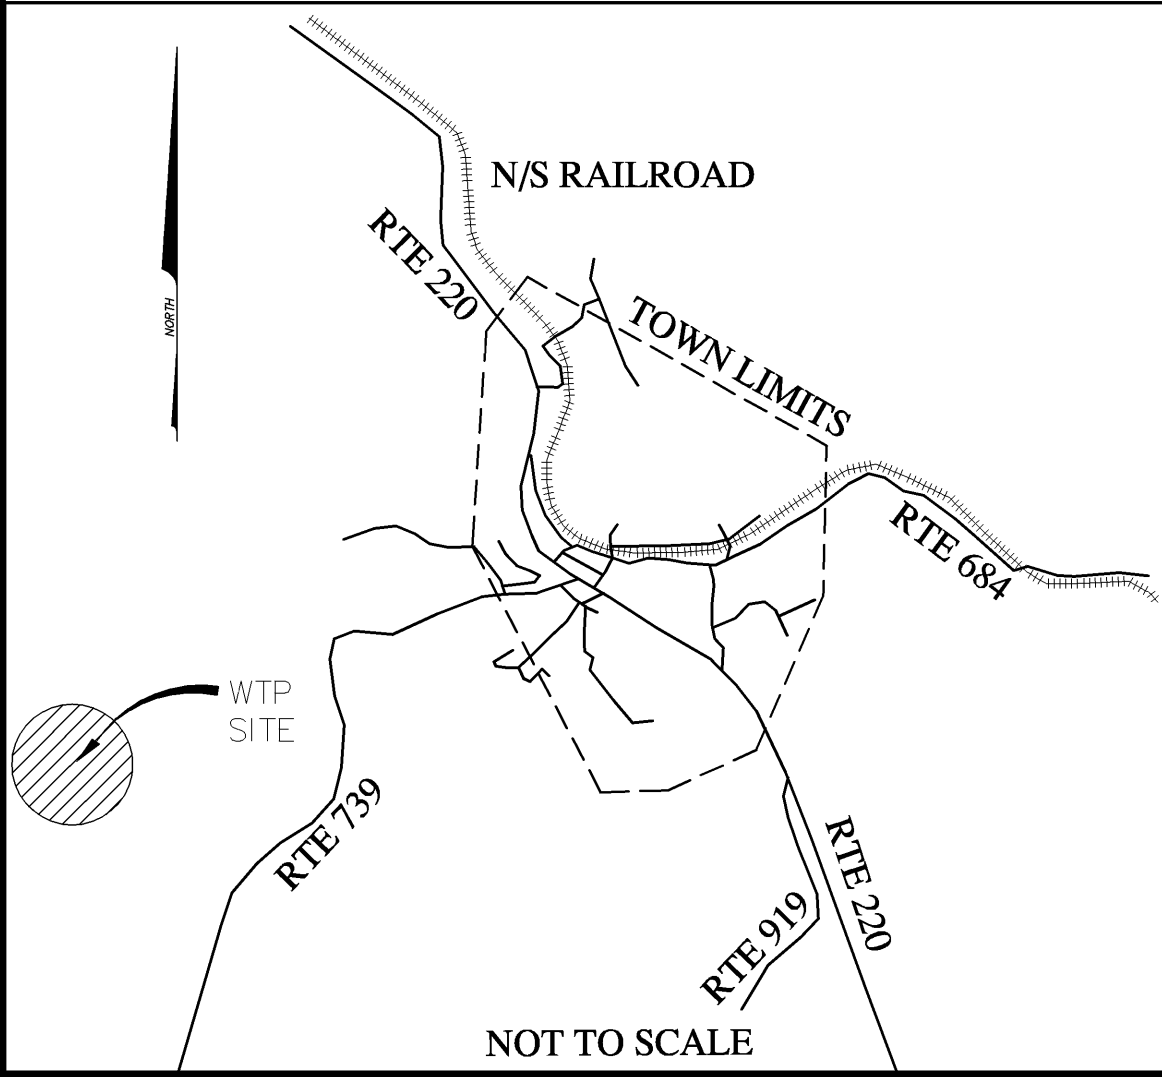

**SHEET INDEX**

- C0.0 COVER SHEET  
C0.1 NOTES  
C0.2 E&S NARRATIVE AND DETAILS
- C1.0 TANK SITE EXISTING CONDITIONS  
C1.1 TANK SITE AND GRADING PLAN  
C1.2 TANK SITE UTILITY PLAN  
C1.3 WATER TREATMENT DETAILS—PHASE 1  
C1.4 WATER TREATMENT DETAILS—PHASE 2 (FUTURE)  
C1.5 WATER TREATMENT DETAILS  
C1.6 WATER TREATMENT DETAILS  
C1.7 EFFLUENT PUMP PLAN DETAILS  
C1.8 TANK SITE DETAILS  
C1.9 WELL DEVELOPMENT DETAILS  
C1.10 SPRING DISTRIBUTION BOX DETAILS  
C1.11 WELL #1 SITE PLAN AND DETAILS  
C2.0 WATER LINE DETAILS
- S1.0 GENERAL STRUCTURAL NOTES  
S1.1 GENERAL STRUCTURAL NOTES  
S1.2 WATER TREATMENT BUILDING DETAILS  
S1.3 WATER TREATMENT BUILDING DETAILS
- E1 SITE PLAN AND SERVICE RISER DIAGRAM  
E2 WATER TREATMENT BUILDING ELECTRICAL PLAN  
E3 WATER TREATMENT BUILDING MECHANICAL PLAN  
E4 WELL HOUSE PLAN AND DETAILS

PLAN REVISIONS			
#	DATE	DESCRIPTION OF REVISION	SHEETS
1	8/28/09	VDH/OWNER COMMENTS	ALL
2	9/3/09	VDH/OWNER COMMENTS	ALL
3	10/7/09	ADDENDUM #2	C0.0, 1.0, 1.1, 1.2, 1.3, 1.6, 1.7, 1.8, 1.11, 2.0, S1.2, E1, E2, E3, E4
4	11/17/09	FRANKLIN COUNTY COMMENTS	ALL
5	3/14/12	ASBUILTS	ALL

**HURT & PROFFITT**  
INCORPORATED  
2524 LANGHORNE ROAD  
LYNCHBURG VA 24501  
800.242.4906 TOLL FREE  
434.847.7796 MAIN  
434.847.0047 FAX

**COVER SHEET-ASBUILT**  
FOR  
**TOWN OF BOONES MILL WATER SYSTEM REPLACEMENT, VOLUME 2**  
**TOWN OF BOONES MILL, BOONE DISTRICT, FRANKLIN COUNTY, VA**

PROJECT NO. 20080815  
G.L. NO. 297-03-A3.9  
FILE NO. G-12675  
DATE: 7/31/09  
DRAWN BY: WCH  
CHECKED BY: BLC

**HURT & PROFFITT**  
SHEET NO.  
**C0.0**

Mar 14, 2012 4:07pm V:\proj\projects\20080815\dwg\asbults-WTP\ASBUILT-Cover-WTP.dwg

THE ENGINEER AND/OR SURVEYOR TAKES NO RESPONSIBILITY FOR THE  
LOCATION OR ACCURACY OF THE UTILITIES AS SHOWN HEREON OR ANY  
UTILITIES WITHIN THE PROJECT THAT MAY NOT BE SHOWN HEREON. THE  
CONTRACTOR SHALL BE RESPONSIBLE FOR CONTACTING THE UTILITY  
COMPANIES TO SEE IF ANY UTILITIES EXIST WITHIN THE AREA OF THE  
PROJECT BEFORE ANY CONSTRUCTION BEGINS. ANY COST INCURRED BY  
DAMAGING ANY UTILITY WITHIN THE PROJECT SHALL BE AT THE EXPENSE  
OF THE CONTRACTOR.

48 WORKING HOURS PRIOR TO STARTING THE WORK, THE CONTRACTOR  
SHALL CALL MISS UTILITY AT PHONE NUMBER 811 AND ADVISE THE  
NATURE AND LOCATION OF THE WORK.







Mar 14, 2012 -- 4:07pm W:\LandProjects\20080815\Wq\Asbuilts-WTP\ASBuilts-WTP-Cover-WTP.dwg

EROSION AND SEDIMENT CONTROL NARRATIVE

**PROJECT DESCRIPTION:**  
THIS PROJECT CONSISTS OF CONSTRUCTION OF WATER LINE, WATER TREATMENT PLANT, WELL DEVELOPMENT AND TWO TANKS LOCATED IN THE TOWN OF BOONES MILL. THE PROJECT INCLUDES GRADING AND ASSOCIATED EROSION AND SEDIMENT CONTROL MEASURES NECESSARY TO CONSTRUCT WATERLINE, WATER TREATMENT PLANT, WELL DEVELOPMENT AND THE TWO OTHER TANKS. APPROXIMATELY 4.88 ACRES WILL BE DISTURBED AS PART OF THE CONSTRUCTION. A VSPM PERMIT WILL BE REQUIRED FOR THIS PORTION OF THE PROJECT.

**EXISTING SITE CONDITIONS:**  
CURRENTLY THE SPRING SITE HAS A TREATMENT BUILDING, A SMALL CONCRETE TANK AND A 250,000 GALLON WATER TANK ON IT. THE SPRING SITE HAS BEEN CLEARED OF ALL TREES. THE LOCATION OF THE FUTURE WATER TREATMENT BUILDING IS LOCATED JUST BELOW THE SPRING SITE AND IS CURRENTLY AN APPLE ORCHARD.

**ADJACENT PROPERTIES:**  
THE SURROUND PROPERTY IS ZONED AGRICULTURAL. ALL MEASURES SHALL BE TAKEN TO ENSURE THAT THE SITE IS STABILIZED AND NO ADDITIONAL SEDIMENT IS DEPOSITED INTO THE DRAINAGE CHANNEL.

**OFFSITE AREAS:**  
ALL GRADING SHALL OCCUR ON-SITE. ANY ADDITIONAL DIRT BORROWED OR WASTED FROM THE SITE WILL BE EITHER STOCKPILED OR REMOVED FROM A LOCATION CHOSEN BY THE CONTRACTOR AT A LATER DATE.

**CRITICAL AREAS:**  
THE CRITICAL AREAS FOR THIS PROJECT WILL BE THE AREA AROUND THE SPRING AND THE PLACE WHERE THE WATERLINE CROSSES ANY STREAMS OR CREEKS. THE CONTRACTOR SHALL ENSURE THAT SILT FENCE IS INSTALLED AT ANY AREA NEAR THE SPRING AND CREEK.

**SOILS:**  
ALL SOILS AROUND THE SPRING AND WATER TREATMENT PLANT SITE ARE CLASSIFIED AS WINTERGREEN LOAM, 8-15% SLOPES. SOILS IN THE REMAINDER OF THE PROJECT AREA VARY BETWEEN CLIFFORD-HICKORY KNOB COMPLEX AND HAYESVILLE LOAM.

**EROSION AND SEDIMENT CONTROL MEASURES:**  
UNLESS OTHERWISE INDICATED, ALL VEGETATIVE AND STRUCTURAL EROSION AND SEDIMENT CONTROL PRACTICES SHALL BE CONSTRUCTED AND MAINTAINED ACCORDING TO MINIMUM STANDARDS AND SPECIFICATION OF THE LATEST EDITION OF THE VIRGINIA EROSION AND SEDIMENT CONTROL HANDBOOK. THE MINIMUM STANDARDS OF THE HANDBOOK SHALL BE ADHERED TO UNLESS OTHERWISE WAIVED OR APPROVED BY VARIANCE.

SECTION 3.02-- TEMPORARY STONE CONSTRUCTION ENTRANCE

**MAINTENANCE**  
1. THE ENTRANCE SHALL BE MAINTAINED IN A CONDITION WHICH WILL PREVENT TRACKING OR FLOW OF MUD ONTO PUBLIC RIGHTS-OF-WAY. THIS MAY REQUIRE PERIODIC TOP DRESSING WITH ADDITIONAL STONE OR THE WASHING AND REWORKING OF EXISTING STONE AS CONDITIONS DEMAND AND REPAIR AND/OR CLEANOUT OF ANY STRUCTURES USED TO TRAP SEDIMENT. ALL MATERIALS SPILLED, DROPPED, WASHED, OR TRACKED FROM VEHICLES ONTO ROADWAYS OR INTO STORM DRAINS MUST BE REMOVED IMMEDIATELY. THE USE OF WATER TRUCKS TO REMOVE MATERIALS DROPPED, WASHED, OR TRACKED ONTO ROADWAYS WILL NOT BE PERMITTED UNDER ANY CIRCUMSTANCES.

SECTION 3.05-- SILT FENCE

**MAINTENANCE**  
1. SILT FENCES SHALL BE INSPECTED IMMEDIATELY AFTER EACH RAINFALL AND AT LEAST DAILY DURING PROLONGED RAINFALL. ANY REQUIRED REPAIRS SHALL BE MADE IMMEDIATELY.  
2. CLOSE ATTENTION SHALL BE PAID TO THE REPAIR OF DAMAGED SILT FENCE RESULTING FROM END RUNS AND UNDERCUTTING.  
3. SHOULD THE FABRIC ON A SILT FENCE DECOMPOSE OR BECOME INEFFECTIVE PRIOR TO THE END OF THE EXPECTED USEFUL LIFE AND THE BARRIER STILL BE NECESSARY, THE FABRIC SHALL BE REPLACED PROMPTLY.  
4. SEDIMENT DEPOSITS SHOULD BE REMOVED AFTER EACH STORM EVENT. THEY MUST BE REMOVED WHEN DEPOSITS REACH APPROXIMATELY ONE-HALF THE HEIGHT OF THE BARRIER.  
5. ANY SEDIMENT DEPOSITS REMAINING IN PLACE AFTER THE SILT FENCE IS NO LONGER REQUIRED SHALL BE DRESSED TO CONFORM WITH THE EXISTING GRADE, PREPARED AND SEEDED.

SECTION 3.08-- CULVERT INLET PROTECTION

**MAINTENANCE**  
1. THE STRUCTURE SHALL BE INSPECTED AFTER EACH RAIN AND REPAIRS MADE AS NEEDED.  
2. AGGREGATE SHALL BE REPLACED OR CLEANED WHEN INSPECTION REVEALS THAT CLOGGED VOIDS ARE CAUSING PONDING PROBLEMS WHICH INTERFERE WITH ON-SITE CONSTRUCTION.  
3. SEDIMENT SHALL BE REMOVED AND THE IMPOUNDMENT RESTORED TO ITS ORIGINAL DIMENSIONS WHEN SEDIMENT HAS ACCUMULATED TO ONE-HALF THE DESIGN DEPTH. REMOVED SEDIMENT SHALL BE DEPOSITED IN A SUITABLE AREA IN SUCH A MANNER THAT IT WILL NOT ERODE AND CAUSE SEDIMENTATION PROBLEMS.  
4. TEMPORARY STRUCTURES SHALL BE REMOVED WHEN THEY HAVE SERVED THEIR USEFUL PURPOSE, BUT NOT BEFORE THE UPSLOPE AREA HAS BEEN PERMANENTLY STABILIZED.

SECTION 3.12-- DIVERSION

**MAINTENANCE**  
1. BEFORE FINAL STABILIZATION, THE DIVERSION SHOULD BE INSPECTED AFTER EVERY RAINFALL AND AT LEAST ONCE EVERY TWO WEEKS. SEDIMENT SHALL BE REMOVED FROM THE CHANNEL AND REPAIRS MADE AS NECESSARY. SEEDED AREAS WHICH FAIL TO ESTABLISH A VEGETATIVE COVER SHALL BE RESEDED AS NECESSARY.

SECTION 3.18-- OUTLET PROTECTION

**MAINTENANCE**  
1. OUTLET PROTECTION SHOULD BE CHECKED FOR SEDIMENT ACCUMULATION AFTER EACH RUNOFF-PRODUCING STORM EVENT. IT SHOULD BE INSPECTED PERIODICALLY TO DETERMINE IF HIGH FLOWS HAVE CAUSED SCOUR BENEATH THE RIPRAP OR FILTER FABRIC OR IF CLOGGED ANY OF THE STONE. CARE MUST BE TAKEN TO PROPERLY CONTROL SEDIMENT-LADEN CONSTRUCTION RUNOFF WHICH MAY DRAIN TO THE POINT OF THE NEW INSTALLATION. IF REPAIRS ARE NEEDED, THEY SHOULD BE ACCOMPLISHED IMMEDIATELY.

**SECTION 3.31-- TEMPORARY SEEDING**  
ESTABLISHMENT OF TEMPORARY VEGETATIVE COVER BY PLANTING SEED ON ROUGH-GRADED AREAS THAT WILL BE BROUGHT TO FINAL GRADE BETWEEN 6 MONTHS AND A YEAR.

SECTION 3.32-- PERMANENT SEEDING

**MAINTENANCE**  
1. EVEN WITH CAREFUL, WELL-PLANNED SEEDING OPERATIONS, FAILURES CAN OCCUR. WHEN IT IS CLEAR THAT PLANTS HAVE NOT GERMINATED ON AN AREA OR HAVE DIED THESE AREAS MUST BE RESEDED IMMEDIATELY TO PREVENT EROSION DAMAGE. HOWEVER, IT IS EXTREMELY IMPORTANT TO DETERMINE FOR WHAT REASON GERMINATION DID NOT TAKE PLACE AND MAKE ANY CORRECTIVE ACTION NECESSARY PRIOR TO RESEEDING THE AREA. HEALTHY VEGETATION IS THE MOST EFFECTIVE EROSION CONTROL AVAILABLE.

SECTION 3.35-- MULCHING

**MAINTENANCE**  
1. ALL MULCHES AND SOIL COVERINGS SHOULD BE INSPECTED PERIODICALLY (PARTICULARLY AFTER RAINSTORMS) TO CHECK FOR EROSION. WHERE EROSION IS OBSERVED IN MULCHED AREAS, ADDITIONAL MULCH SHOULD BE APPLIED. NETS AND MATS SHOULD BE INSPECTED AFTER RAINSTORMS FOR DISLOCATION OR FAILURE. IF WASHOUTS OR BREAKAGE OCCUR, RE-INSTALL NETTING OR MATTING AS NECESSARY AFTER REPAIRING DAMAGE TO THE SLOPE OR DITCH. INSPECTIONS SHOULD TAKE PLACE UP UNTIL GRASSES ARE FIRMLY ESTABLISHED. WHERE MULCH IS USED IN CONJUNCTION WITH ORNAMENTAL PLANTINGS, INSPECT PERIODICALLY THROUGHOUT THE YEAR TO DETERMINE IF MULCH IS MAINTAINING COVERAGE OF THE SOIL SURFACE; REPAIR AS NEEDED.

VEGETATIVE PRACTICES:

**TEMPORARY SEEDING / PERMANENT STABILIZATION:**  
SEEDING MEASURES SHALL BE TAKEN ON DISTURBED SOIL AT CUT / FILL SLOPES, DITCH LINES, OR AREAS OUTSIDE OF ON-GOING CONSTRUCTION PRACTICES WITHIN SEVEN (7) DAYS OF COMPLETED GRADING. ALL AREAS DISTURBED BY CONSTRUCTION WILL BE STABILIZED WITH PERMANENT SEEDING IMMEDIATELY FOLLOWING FINAL GRADING.

SITE MAINTENANCE:

- SILT FENCE BARRIERS SHALL BE CHECKED WEEKLY AND ESPECIALLY AFTER EACH RAINFALL EVENT, TO INSURE THAT THEY ARE FUNCTIONING PROPERLY. IF ANY BARRIER IS DAMAGED DUE TO CONSTRUCTION ACTIVITIES, NATURAL CAUSES, OR ANY OTHER REASON, THE BARRIER SHALL BE REPAIRED OR REPLACED IMMEDIATELY. IF TRASH OR SEDIMENTATION REACHES ONE-HALF THE HEIGHT OF THE BARRIER, THE BARRIER SHALL BE CLEANED, AND RESTORED TO PROPER FUNCTIONING CONDITION.
- ALL OTHER STRUCTURAL MEASURES ARE TO BE CHECKED WEEKLY AND ESPECIALLY AFTER EACH RAINFALL EVENT TO INSURE THAT THEY ARE FUNCTIONING PROPERLY. ANY DAMAGED OR CLOGGED MEASURE SHALL BE CLEANED OUT OR REPAIRED IMMEDIATELY.
- ALL SEDIMENT REMOVED FROM THE CONTROL DEVICES SHALL BE RE-SPREAD ON THE SITE ABOVE THE CONTROL DEVICES.
- VEGETATION SHALL BE CHECKED WEEKLY TO INSURE PROPER AND ADEQUATE COVERAGE. BARE OR WASHED AREAS SHALL BE SCARIFIED AND RESEDED UNTIL PERMANENT STABILIZATION HAS BEEN ACHIEVED.
- ONCE SITE HAS ESTABLISHED AND SEDIMENT HAS CEASED TO BE CONVEYED ON THE SITE, ALL SILT FENCE BARRIERS AND INLET PROTECTION SHALL BE REMOVED FROM THE SITE.
- OTHER CONTROLS.
  - NO SOLID MATERIALS, INCLUDING BUILDING MATERIALS, GARBAGE AND DEBRIS SHALL BE DISCHARGED TO SURFACE WATERS OF THE STATE, EXCEPT AS AUTHORIZED BY A CWA SECTION 404 PERMIT.
  - WHERE CONSTRUCTION VEHICLE ACCESS ROUTES INTERSECT PAVED PUBLIC ROADS, MINIMIZATION OF TRANSPORT OF SEDIMENT BY VEHICULAR TRACKING ON THE PAVEMENT WILL BE PREVENTED BY PROPER USE AND MAINTENANCE OF THE CONSTRUCTION ENTRANCES AND CLEANING THE ROAD AT THE END OF EACH DAY.
  - STORAGE OF ONSITE MATERIALS WILL BE DONE TO MINIMIZE EXPOSURE OF THE MATERIALS TO STORMWATER AND SPILL PREVENTION AND RESPONSE.
  - DISTURBED AREAS AND AREAS USED FOR STORAGE OF MATERIALS THAT ARE EXPOSED TO PRECIPITATION SHALL BE INSPECTED FOR EVIDENCE OF, OR THE POTENTIAL FOR, POLLUTANTS ENTERING THE DRAINAGE SYSTEM.

INSPECTIONS AND REPORTING:

FACILITY PERSONNEL WHO ARE FAMILIAR WITH THE CONSTRUCTION ACTIVITY, THE BMPS AND THE STORMWATER POLLUTION PREVENTION PLAN WILL INSPECT DISTURBED AREAS OF THE CONSTRUCTION SITE THAT HAVE NOT BEEN FINALLY STABILIZED, AND AREAS USED FOR STORAGE MATERIALS THAT ARE EXPOSED TO PRECIPITATION. STRUCTURAL CONTROLS AND LOCATIONS WHERE VEHICLES ENTER OR EXIT THE SITE. THESE INSPECTIONS SHALL BE CONDUCTED EVERY 14 DAYS OR WITHIN 48 HOURS OF THE END OF A STORM EVENT THAT IS 0.5 INCHES OR GREATER.

SEEDING SPECIFICATIONS:

TEMPORARY SEEDING--

WINTER -- 40 LBS. ANNUAL RYE/40 LBS. CEREALE RYE (PER ACRE)  
SUMMER -- 40 LBS. ANNUAL RYE/40 LBS. FOXTAIL MILLET (PER ACRE)

FERTILIZER -- 1500 LBS. 10-18-10/ACRE  
LIME -- 2 TONS/ACRE

PERMANENT SEEDING--

SEASONAL SPECIFICATION -- PER ACRE

2/1 TO 5/15 100 LBS. TALL FESCUE  
15 LBS. ANNUAL RYE  
2 LBS. RED CLOVER

5/16 TO 7/31 120 LBS. TALL FESCUE  
10 LBS. FOXTAIL MILLET  
2 LBS. RED CLOVER

8/1 TO 9/15 100 LBS. TALL FESCUE  
15 LBS. ANNUAL RYE  
2 LBS. RED CLOVER

9/16 TO 1/31 120 LBS. TALL FESCUE  
10 LBS. CEREALE RYE  
2 LBS. RED CLOVER

SOD--

REFER TO THE LANDSCAPE SPECIFICATION SECTIONS FOR AN APPROVED SOD MATERIAL.

FERTILIZER -- ALL SEASONS -- 1500 LBS. 10-18-10/ACRE  
LIME -- ALL SEASONS -- 2 TONS/ACRE

\* A MULCH COVER IS REQUIRED ON TEMPORARY AND FINAL SEEDING

\* STRAW AT 80 BALES PER ACRE OR AN APPROVED MANUFACTURED MULCH/STABILIZATION MATTING MATERIAL.

VIRGINIA EROSION AND SEDIMENT CONTROL REGULATIONS MINIMUM STANDARD #1

PERMANENT OR TEMPORARY SOIL STABILIZATION SHALL BE APPLIED TO DENUDED AREAS WITHIN 7 DAYS AFTER FINAL GRADE IS REACHED ON ANY PORTION OF THE SITE. TEMPORARY SOIL STABILIZATION SHALL BE APPLIED WITHIN SEVEN DAYS TO DENUDED AREAS THAT MAY NOT BE AT FINAL GRADE BUT WILL REMAIN DORMANT (UNDISTURBED) FOR LONGER THAN 30 DAYS. PERMANENT STABILIZATION SHALL BE APPLIED TO AREAS THAT ARE TO BE LEFT DORMANT FOR MORE THAN ONE YEAR.

GENERAL EROSION AND SEDIMENT CONTROL NOTES  
TABLE 6-1

ES-1: UNLESS OTHERWISE INDICATED, ALL VEGETATIVE AND STRUCTURAL EROSION AND SEDIMENT CONTROL PRACTICES WILL BE CONSTRUCTED AND MAINTAINED ACCORDING TO MINIMUM STANDARDS AND SPECIFICATIONS OF THE VIRGINIA EROSION AND SEDIMENT CONTROL HANDBOOK AND VIRGINIA REGULATIONS VR 625-02-00 EROSION AND SEDIMENT CONTROL REGULATIONS.

ES-2: THE PLAN APPROVING AUTHORITY MUST BE NOTIFIED ONE WEEK PRIOR TO THE PRE-CONSTRUCTION CONFERENCE, ONE WEEK PRIOR TO THE COMMENCEMENT OF LAND DISTURBING ACTIVITY, AND ONE WEEK PRIOR TO THE FINAL INSPECTION.

ES-3: ALL EROSION AND SEDIMENT CONTROL MEASURES ARE TO BE PLACED PRIOR TO OR AS THE FIRST STEP IN CLEARING.

ES-4: A COPY OF THE APPROVED EROSION AND SEDIMENT CONTROL PLAN SHALL BE MAINTAINED ON THE SITE AT ALL TIMES.

ES-5: PRIOR TO COMMENCING LAND DISTURBING ACTIVITIES IN AREAS OTHER THAN INDICATED ON THESE PLANS (INCLUDING, BUT NOT LIMITED TO, OFF SITE BORROW OR WASTE AREAS), THE CONTRACTOR SHALL SUBMIT A SUPPLEMENTARY EROSION CONTROL PLAN TO THE OWNER FOR REVIEW AND APPROVAL BY THE PLAN APPROVING AUTHORITY.

ES-6: THE CONTRACTOR IS RESPONSIBLE FOR INSTALLATION OF ANY ADDITIONAL EROSION CONTROL MEASURES NECESSARY TO PREVENT EROSION AND SEDIMENTATION AS DETERMINED BY THE PLAN APPROVING AUTHORITY.

ES-7: ALL DISTURBED AREAS ARE TO DRAIN TO APPROVED SEDIMENT CONTROL MEASURES AT ALL TIMES DURING LAND DISTURBING ACTIVITIES AND DURING SITE DEVELOPMENT UNTIL FINAL STABILIZATION IS ACHIEVED.

ES-8: DURING DEWATERING OPERATIONS, WATER WILL BE PUMPED INTO AN APPROVED FILTERING DEVICE.


ES-9: THE CONTRACTOR SHALL INSPECT ALL EROSION CONTROL MEASURES PERIODICALLY AND AFTER EACH RUNOFF PRODUCING RAINFALL EVENT. ANY NECESSARY REPAIRS OR CLEANUP TO MAINTAIN THE EFFECTIVENESS OF THE EROSION CONTROL DEVICES SHALL BE MADE IMMEDIATELY.

EROSION AND SEDIMENT CONTROL DEVICES:

PERIMETER EROSION AND SEDIMENT CONTROL DEVICES SHALL BE INSTALLED PRIOR TO ANY LAND DISTURBING ACTIVITY. AS CONSTRUCTION PROCEEDS, ALL ADDITIONAL EROSION AND SEDIMENT CONTROL DEVICES SHALL BE INSTALLED AS SOON AS POSSIBLE. EROSION AND SEDIMENT CONTROL DEVICES AS SHOWN ON THE PLAN ARE A MINIMUM AND THE PROJECT CONDITION MAY DICTATE ADDITIONAL CONTROL. ALL EROSION AND SEDIMENT CONTROL DEVICES SHALL BE PER THE LATEST EDITION OF THE VIRGINIA EROSION AND SEDIMENT CONTROL HANDBOOK.


EROSION AND SEDIMENT CONTROL MAINTENANCE:

THE CONTRACTOR IS RESPONSIBLE FOR MAINTAINING ALL EROSION CONTROL DEVICES FOR THE DURATION OF THE PROJECT. ALL EROSION AND SEDIMENT CONTROL DEVICES SHALL BE CHECKED WEEKLY AND AFTER EACH SIGNIFICANT RAINFALL TO INSURE THAT ALL DEVICES ARE IN PLACE AND FUNCTIONING AS REQUIRED. ALL EROSION AND SEDIMENT CONTROL DEVICES SHALL BE MAINTAINED PER THE LATEST EDITION OF THE VIRGINIA EROSION AND SEDIMENT CONTROL HANDBOOK. IN GENERAL, IF THE SILT BUILT UP BEHIND A BARRIER BECOMES AS DEEP AS 9 INCHES, THE SILT IS TO BE REMOVED AND THE BARRIER REPAIRED OR REPLACED. AFTER COMPLETION OF THE PROJECT, AND PERMANENT SEEDING HAS BEEN ESTABLISHED, EROSION CONTROL DEVICES AND ANY SILT BUILT UP SHALL BE REMOVED. DISTURBED AREAS DUE TO THIS CLEANUP OPERATION SHALL BE REPAIRED, RESEDED AND REMULCHED.

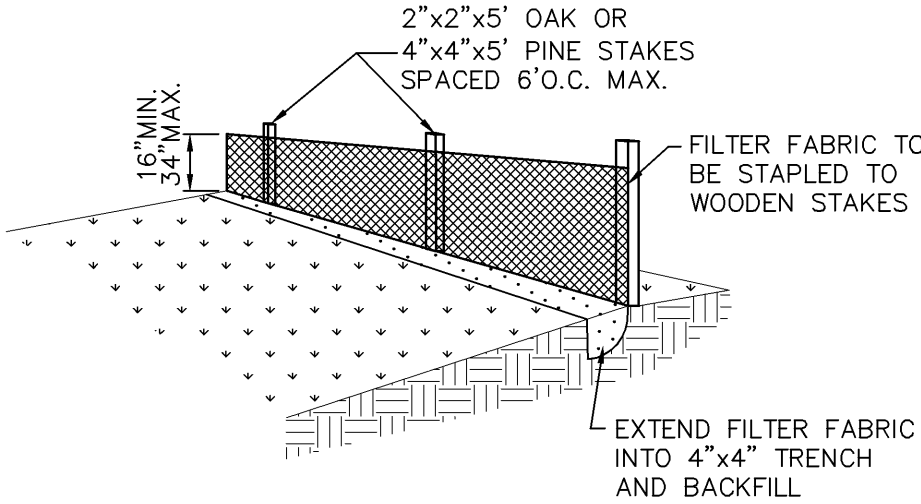


(SF) SILT FENCE  
(WITHOUT WIRE SUPPORT)  
N.T.S.

(CIP) SILT FENCE CULVERT INLET PROTECTION

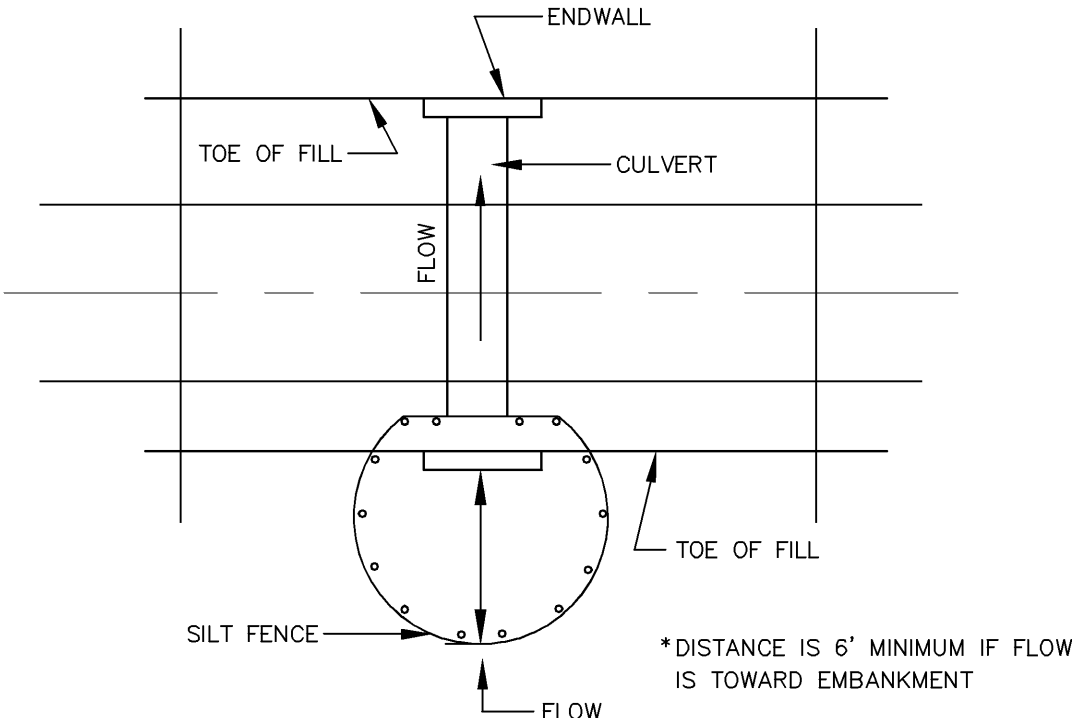



\* OPTIONAL STONE COMBINATION

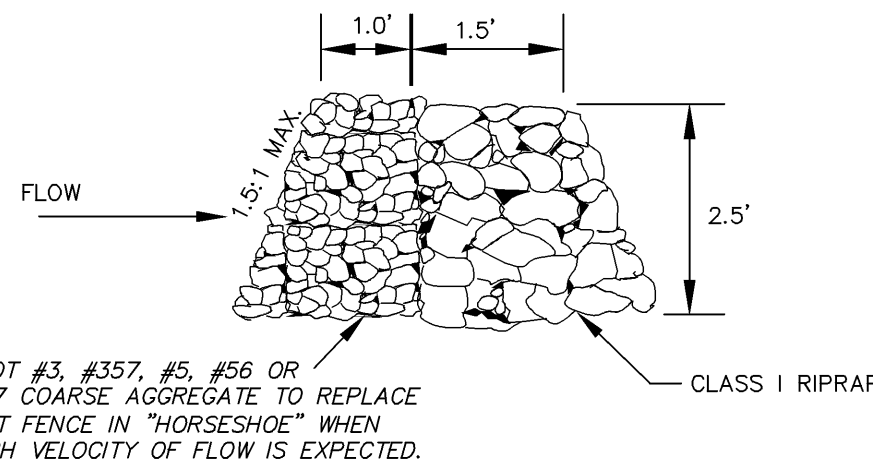

\* VDOT #3, #357, #5, #56 OR #57 COARSE AGGREGATE TO REPLACE SILT FENCE IN "HORSESHOE" WHEN HIGH VELOCITY OF FLOW IS EXPECTED.


SOURCE: ADAPTED FROM VDOT Standard Sheets and Va. DSWC

PLATE. 3.08-1

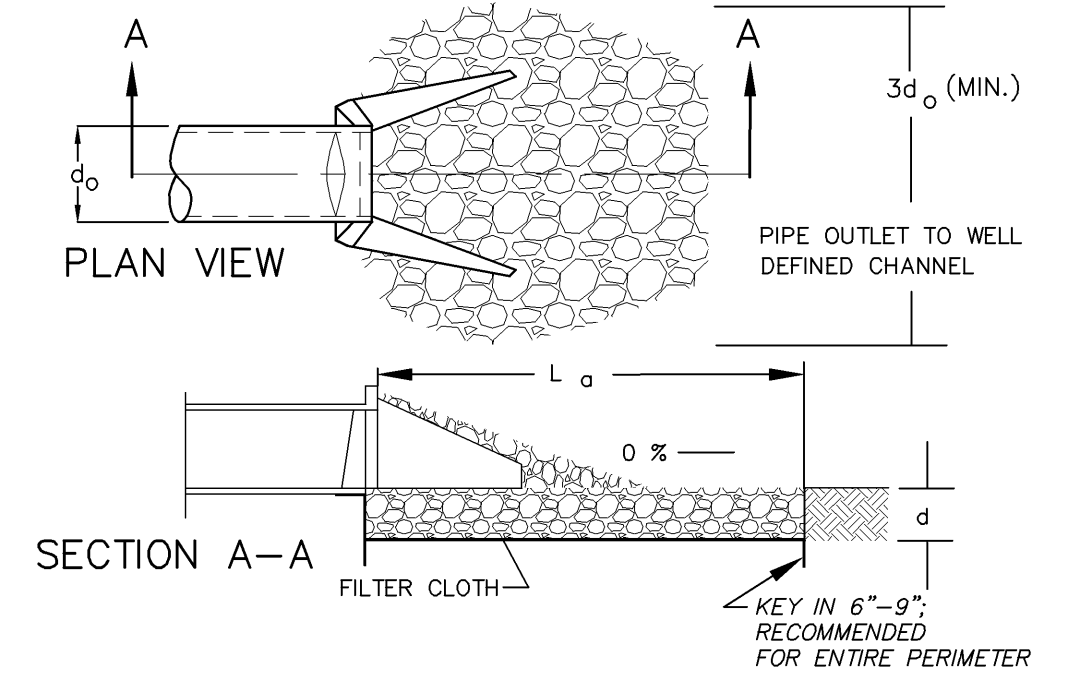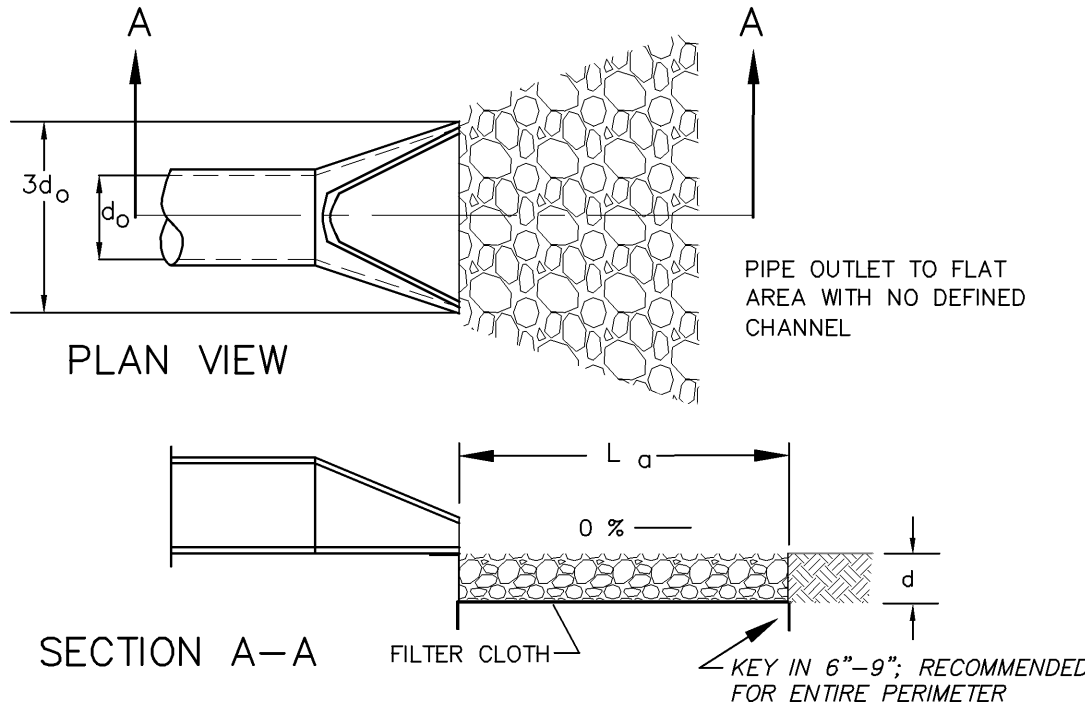

NOTES:  
1. APRON LINING MAY BE RIPRAP, GROUTED RIPRAP, GABION BASKET, OR CONCRETE.  
2. L<sub>o</sub> IS THE LENGTH OF THE RIPRAP APRON AS CALCULATED USING PLATES 3.18-3 AND 3.18-4.  
3. d = 1.5 TIMES THE MAXIMUM STONE DIAMETER, BUT NOT LESS THAN 6 INCHES.

(OP) PIPE OUTLET PROTECTION  
N.T.S.

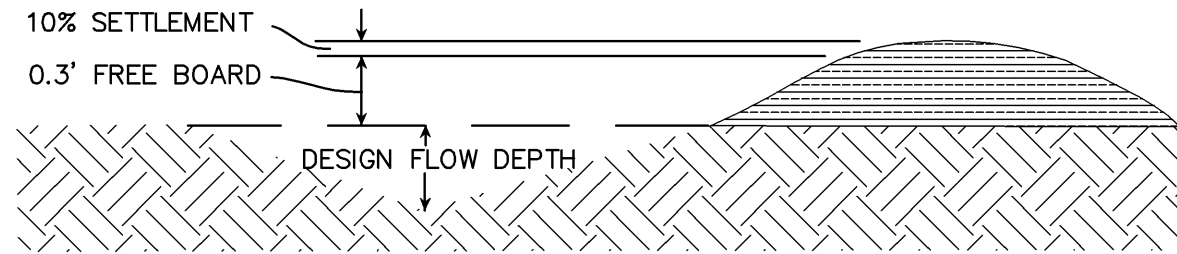

(DV) TYPICAL VEE-SHAPED DIVERSION  
N.T.S.

(CE) TEMPORARY CONSTRUCTION ENTRANCE  
N.T.S.

1	8/28/09	VDH/OWNER COMMENTS
2	9/3/09	VDH/OWNER COMMENTS
4	11/17/09	FRANKLIN COUNTY COMMENTS
5	3/14/12	ASBUILTS

\* ENGINEERING >>> SURVEYING >> PLANNING

HURT & PROFFITT  
INCORPORATED



2524 LANGHORNE ROAD  
LYNCHBURG VA 24501  
800.242.4906 TOLL FREE  
434.847.7796 MAIN  
434.847.0047 FAX

E&S NARRATIVE AND DETAILS-ASBUILT  
FOR  
TOWN OF BOONES MILL WATER SYSTEM REPLACEMENT, VOLUME 2  
TOWN OF BOONES MILL, BOONE DISTRICT, FRANKLIN COUNTY, VA


PROJECT NO.	20080815
G.L. NO.	297-03-A3.9
FILE NO.	G-12675
DATE:	7/31/09
DRAWN BY:	WCH
CHECKED BY:	BLC

HURT & PROFFITT


SHEET NO.  
C0.2









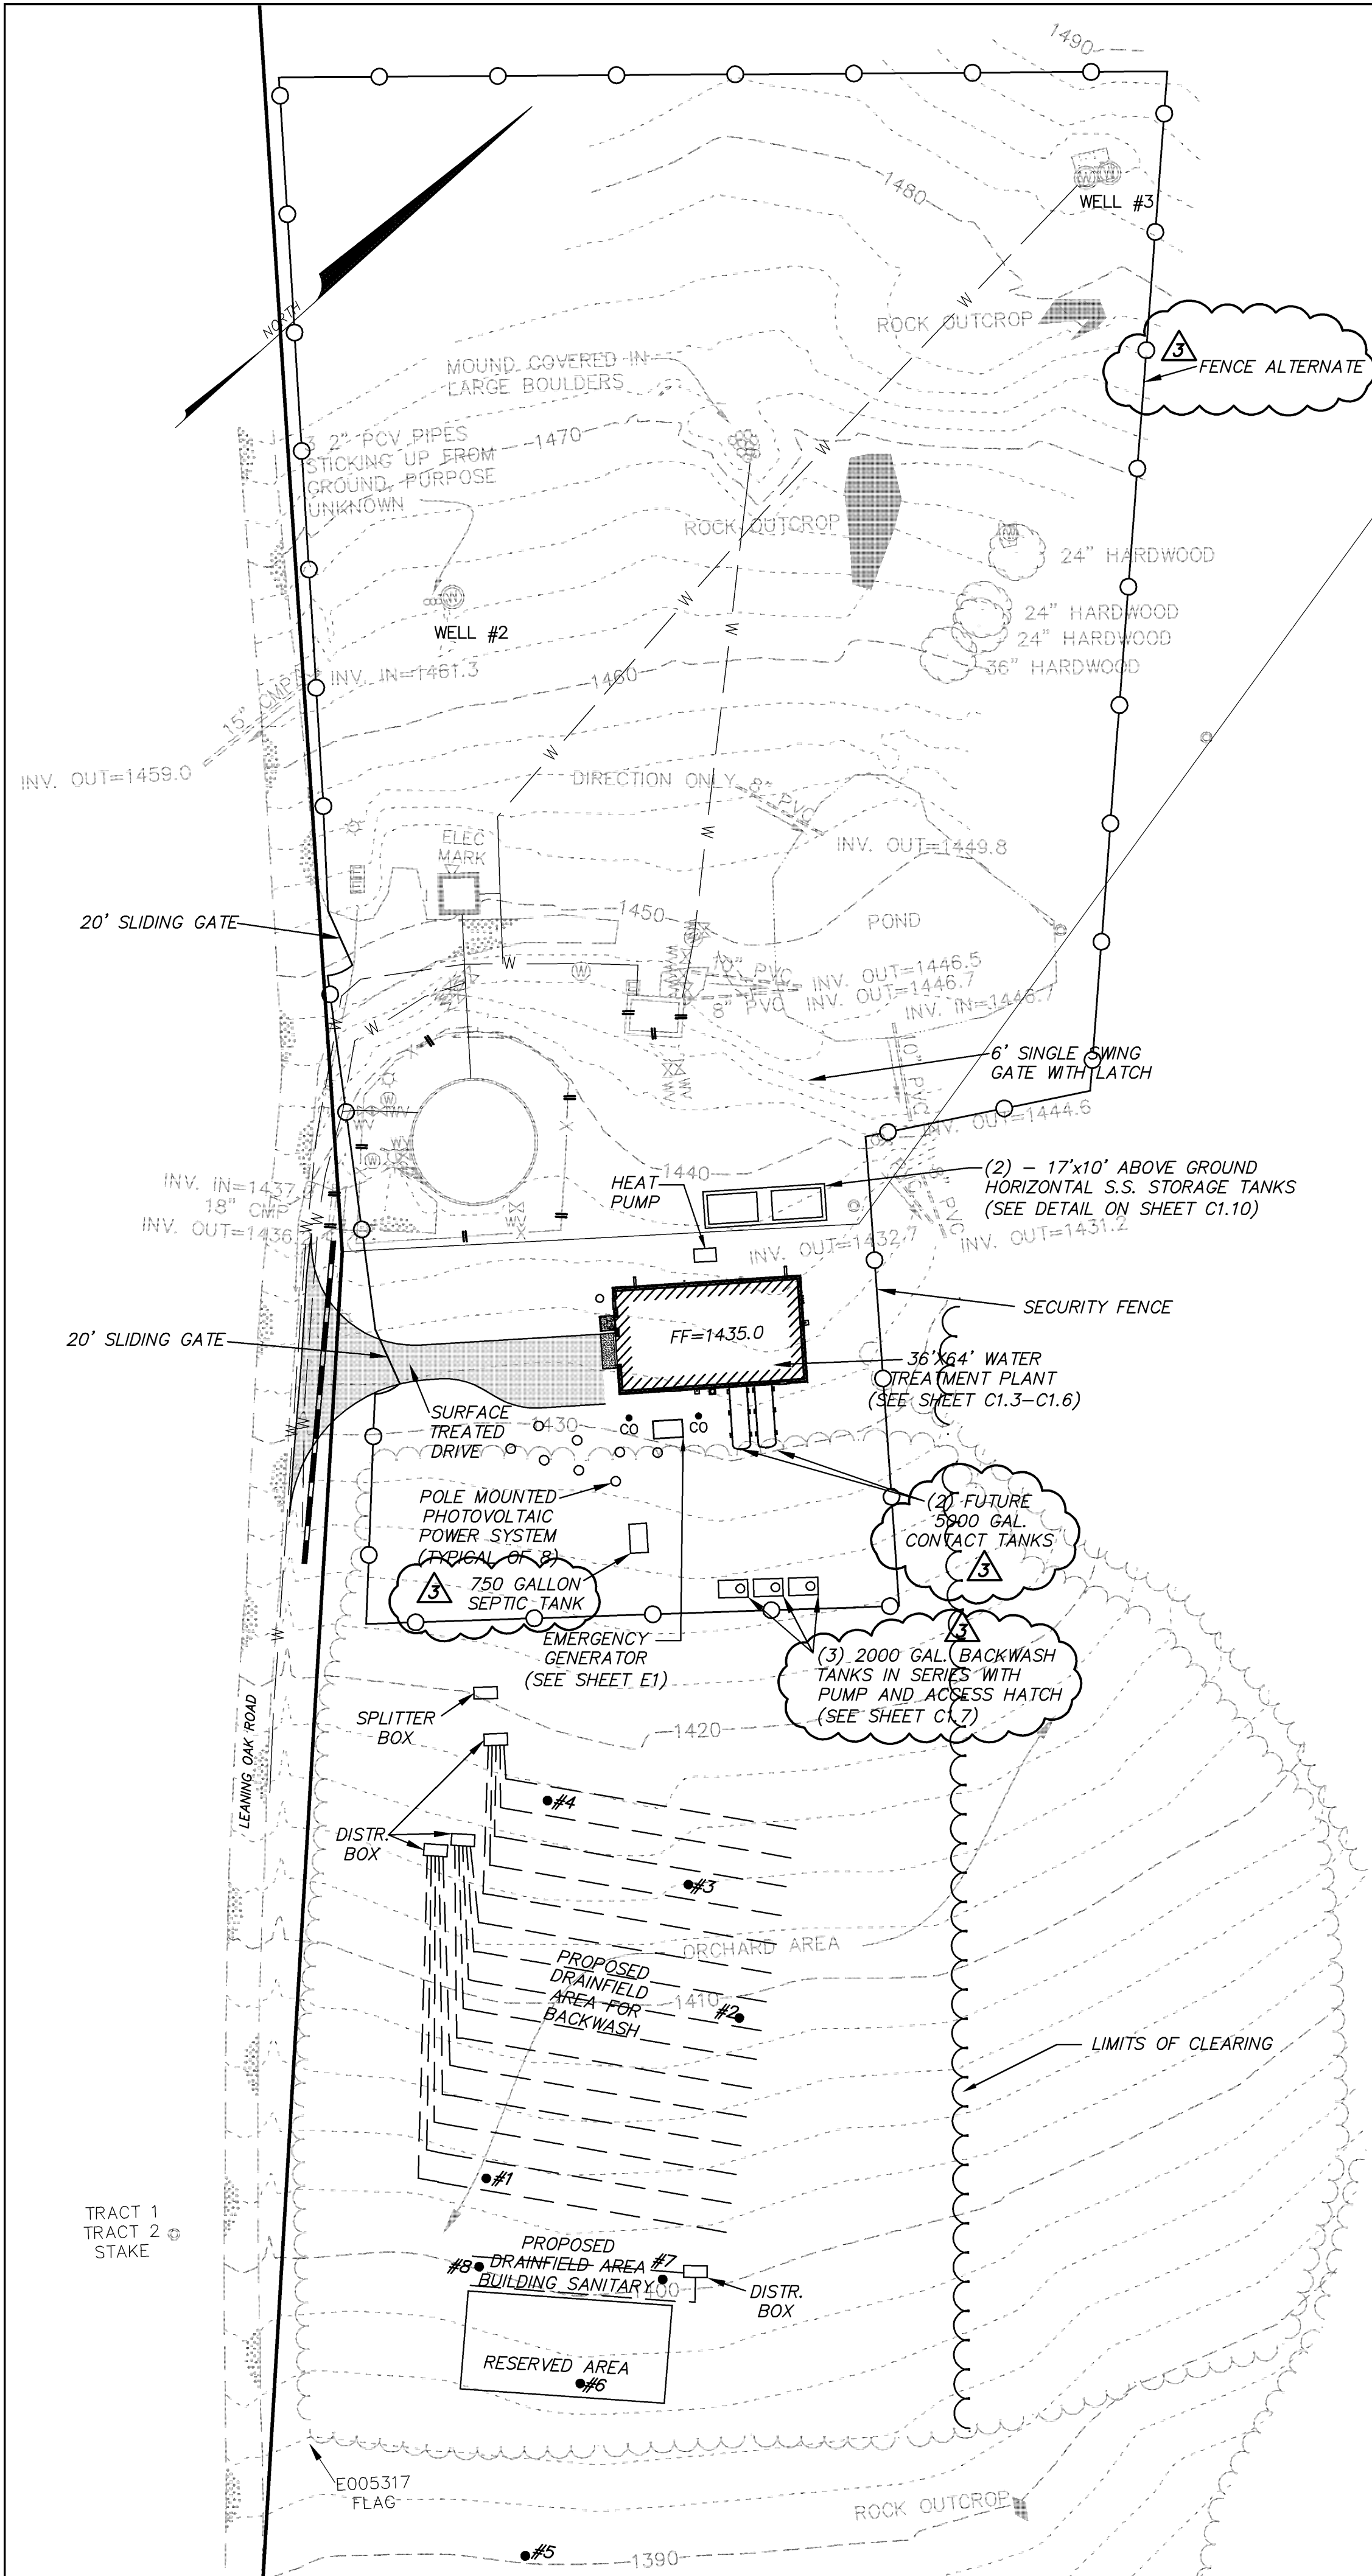

SITE PLAN

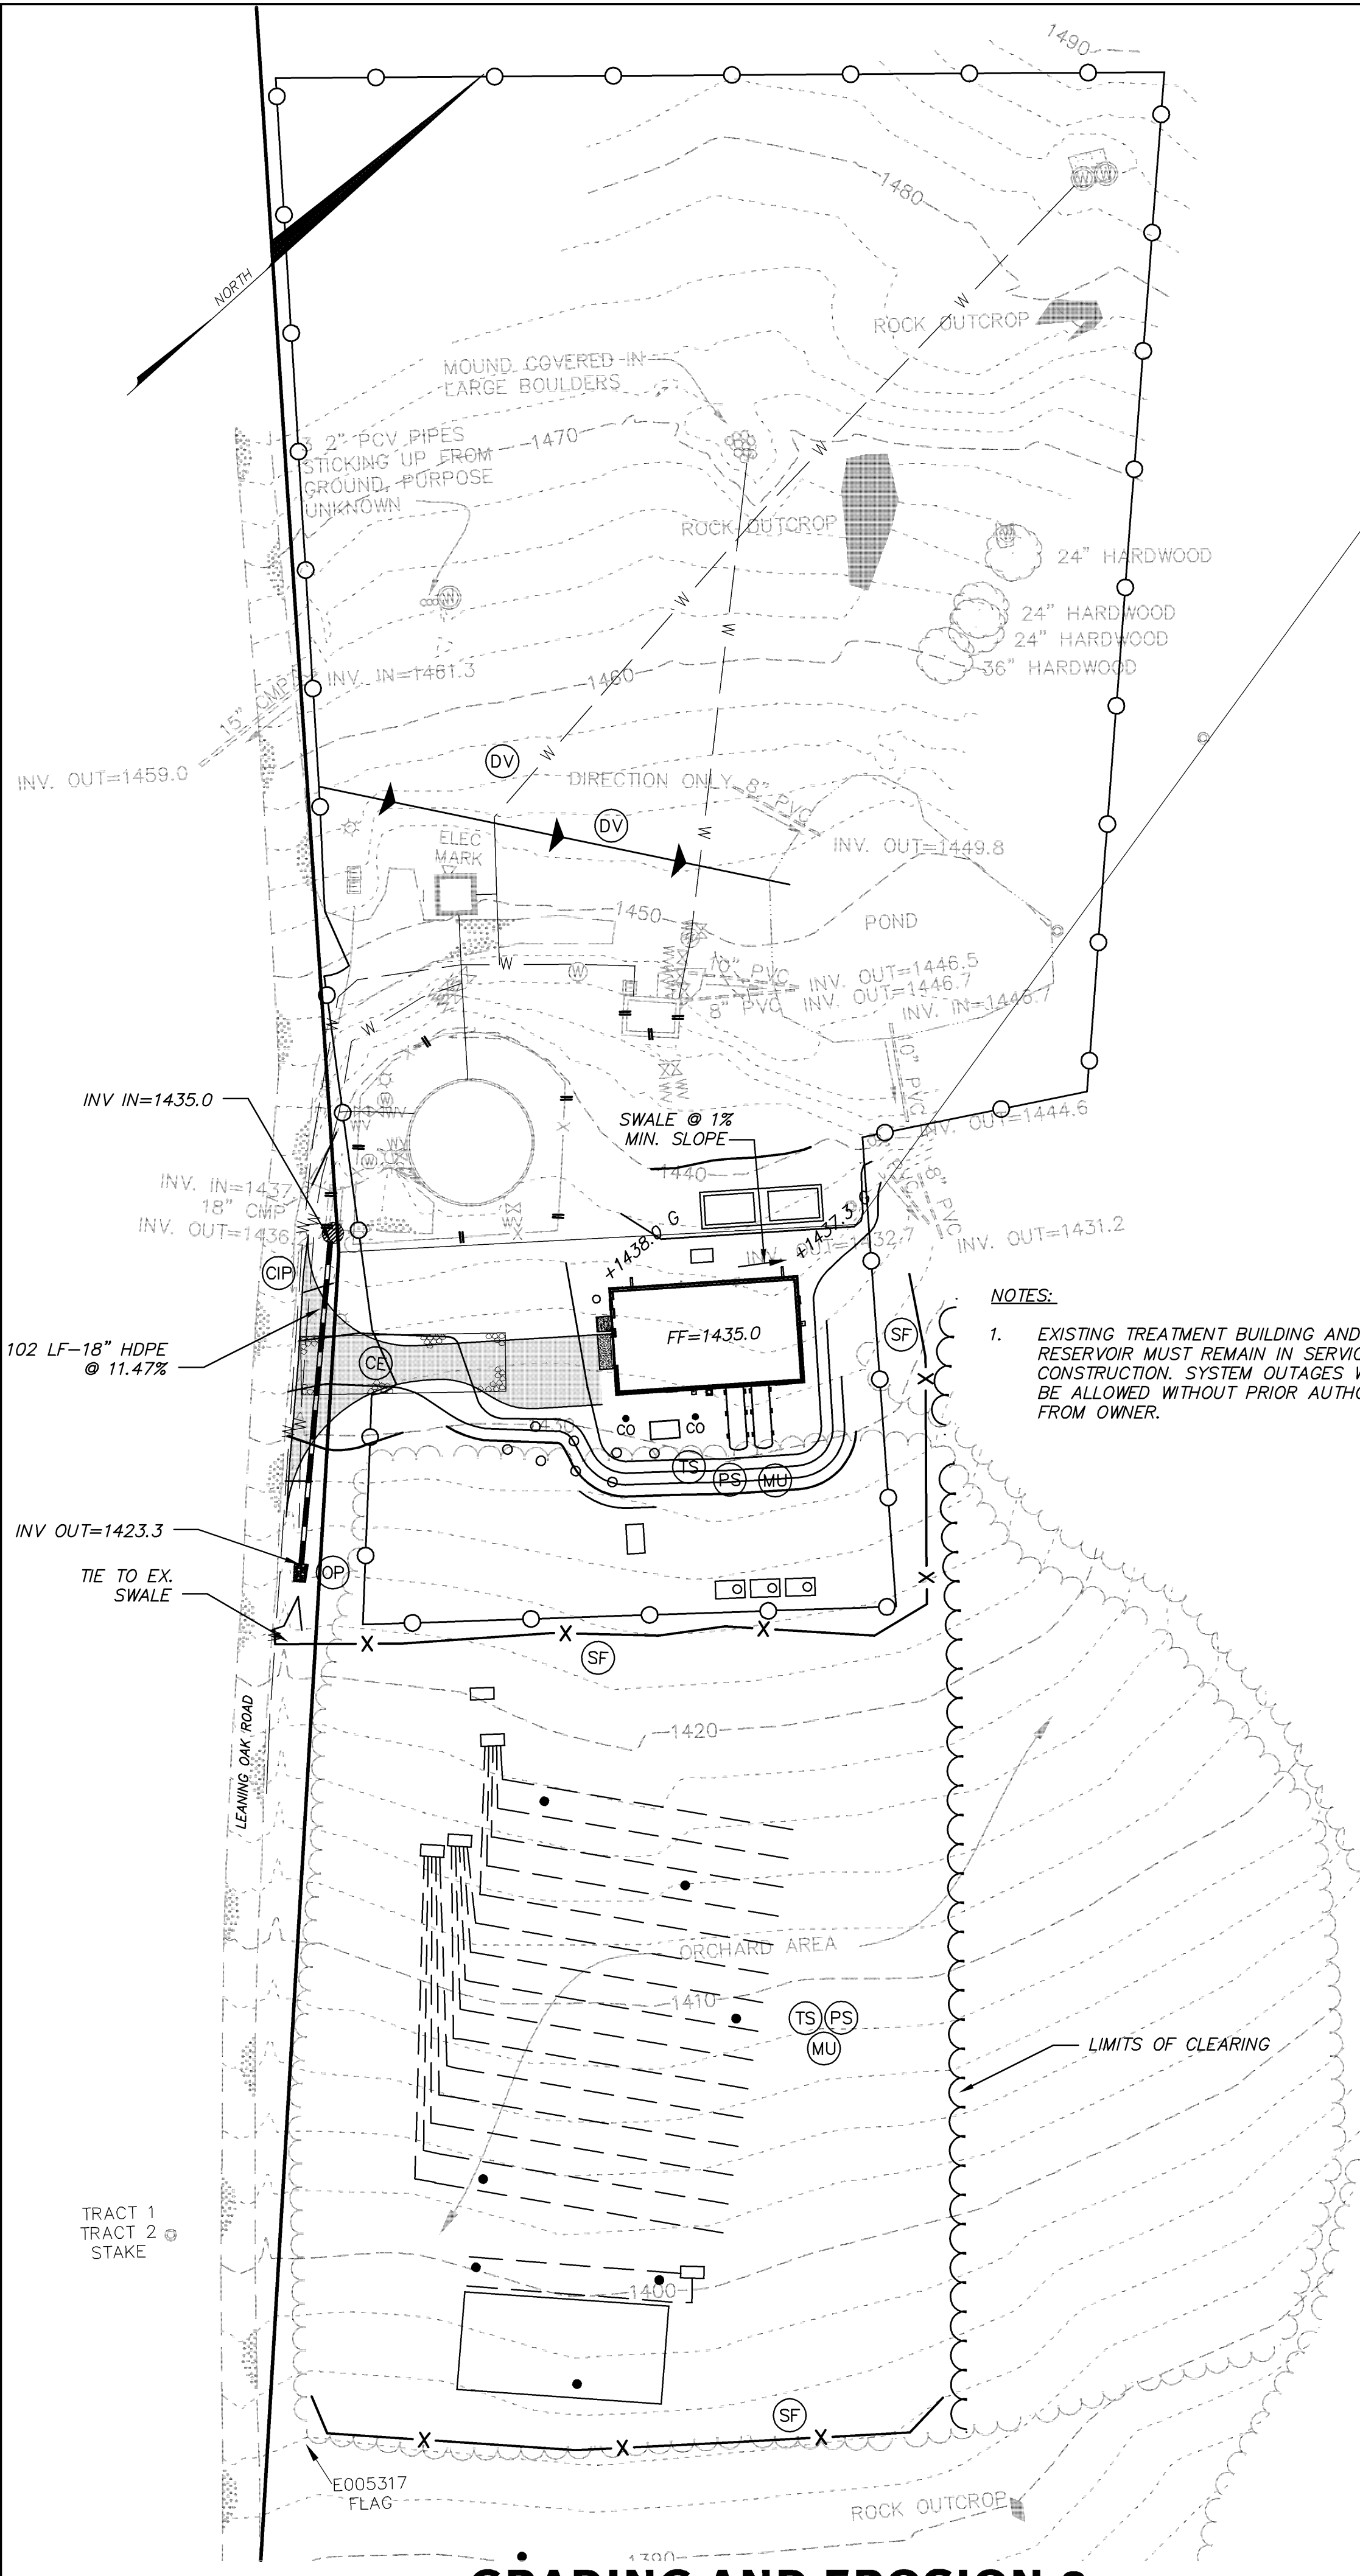


GRADING AND EROSION & SEDIMENT CONTROL PLAN

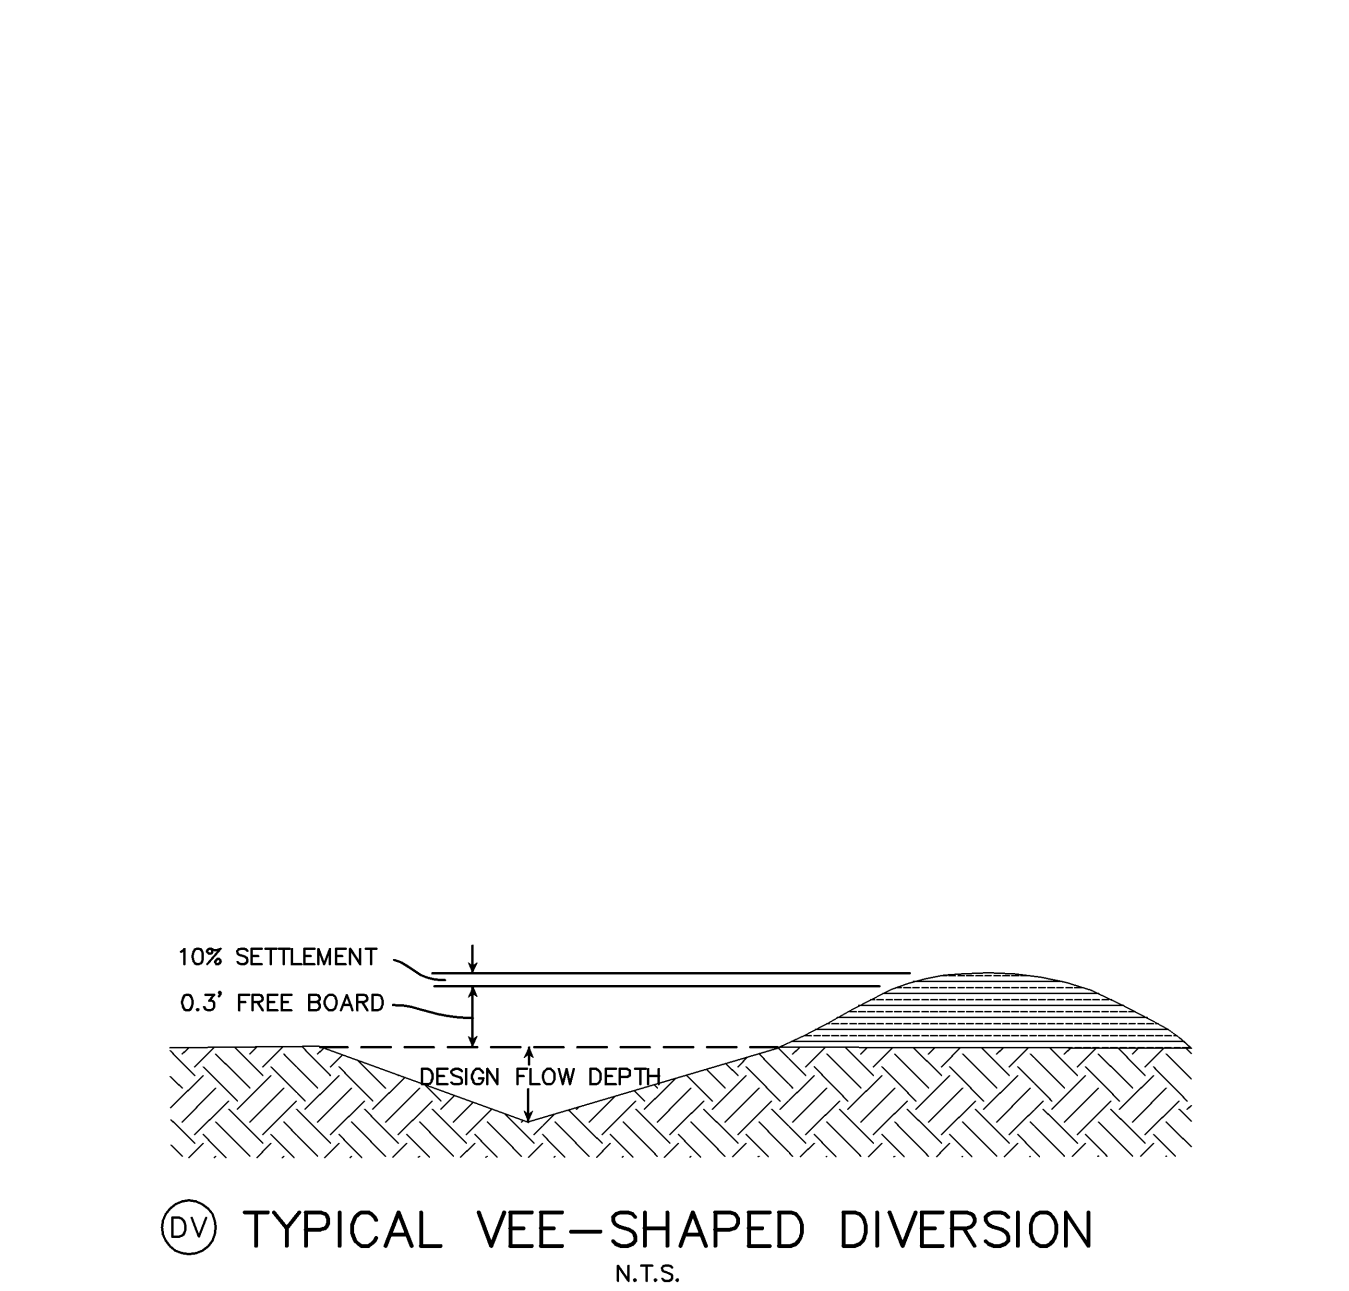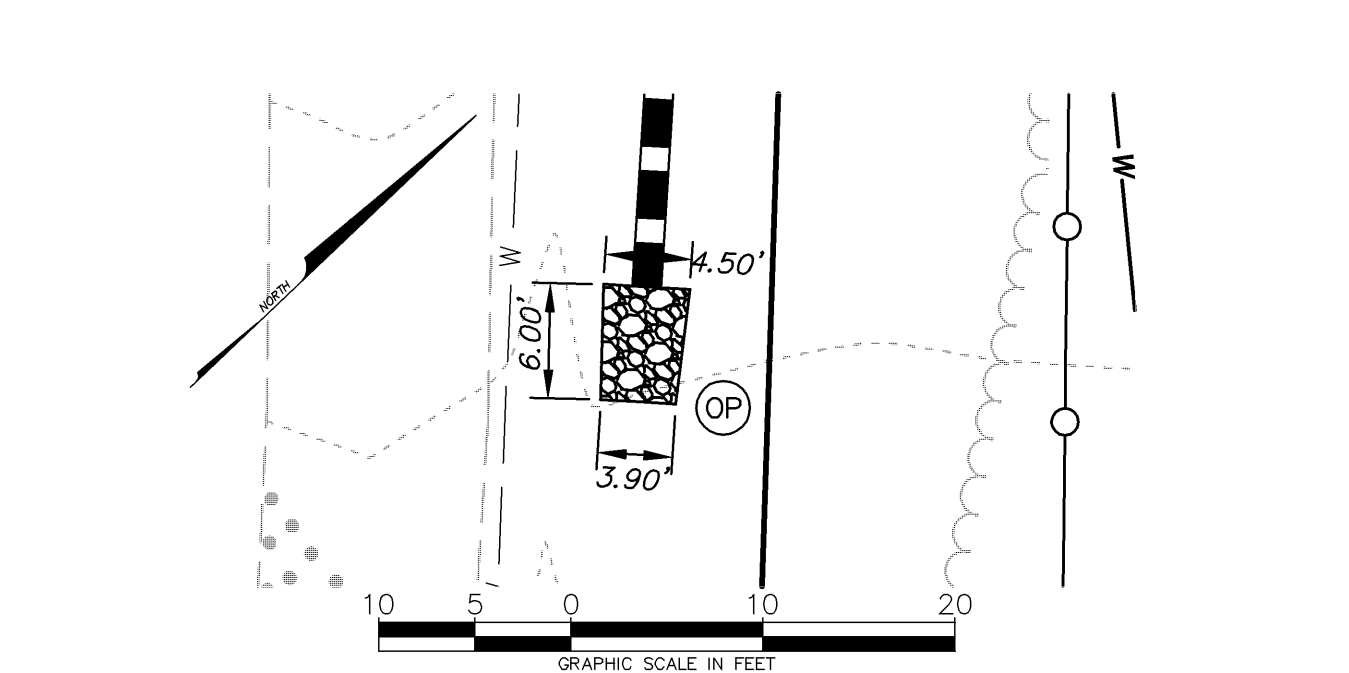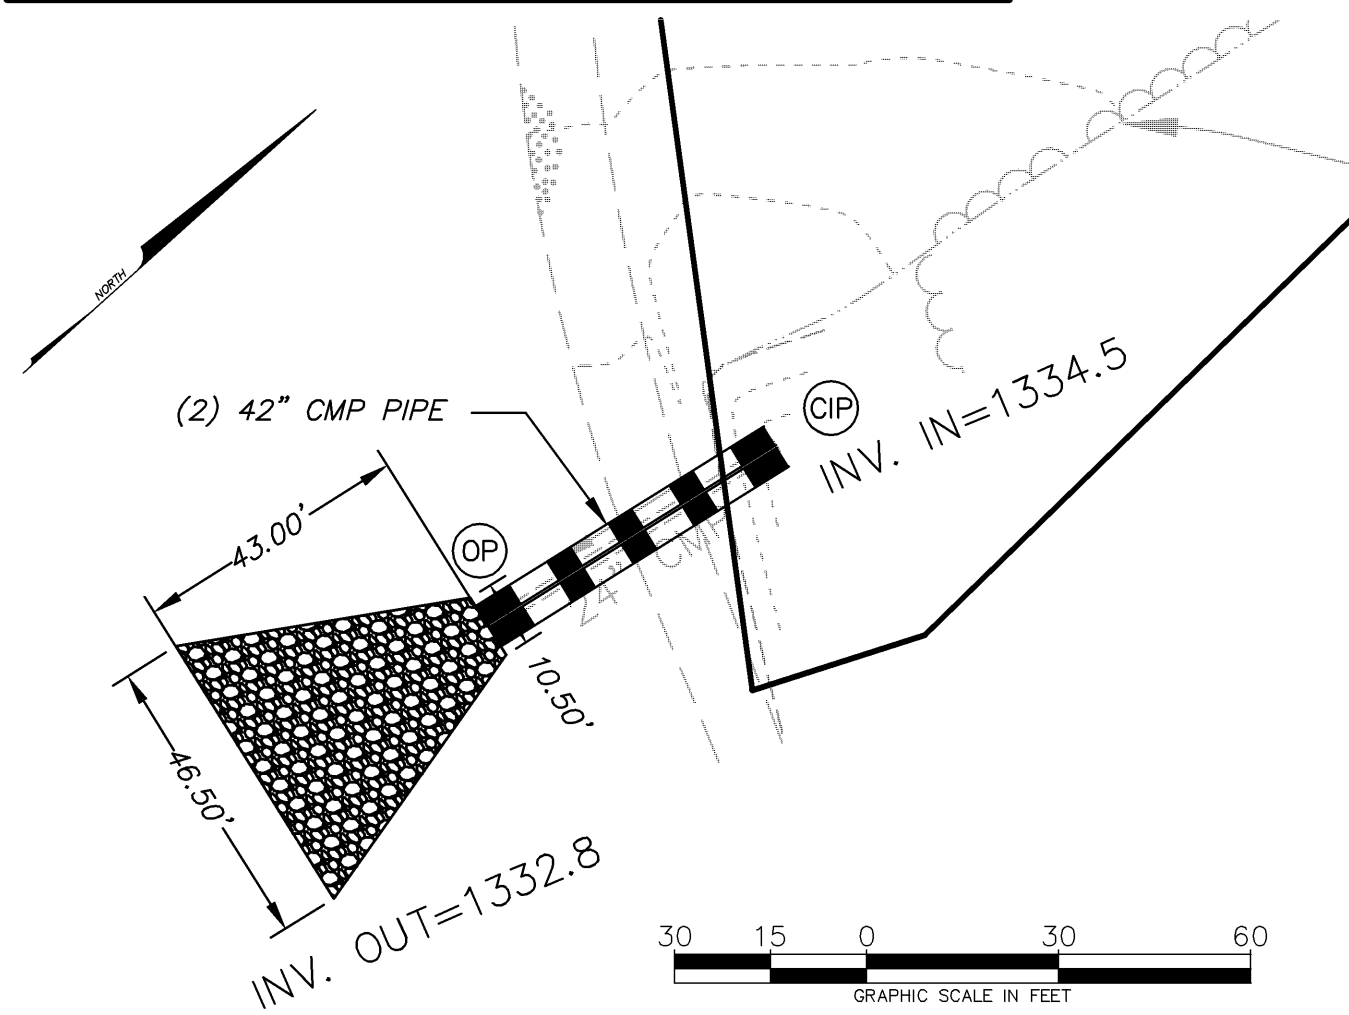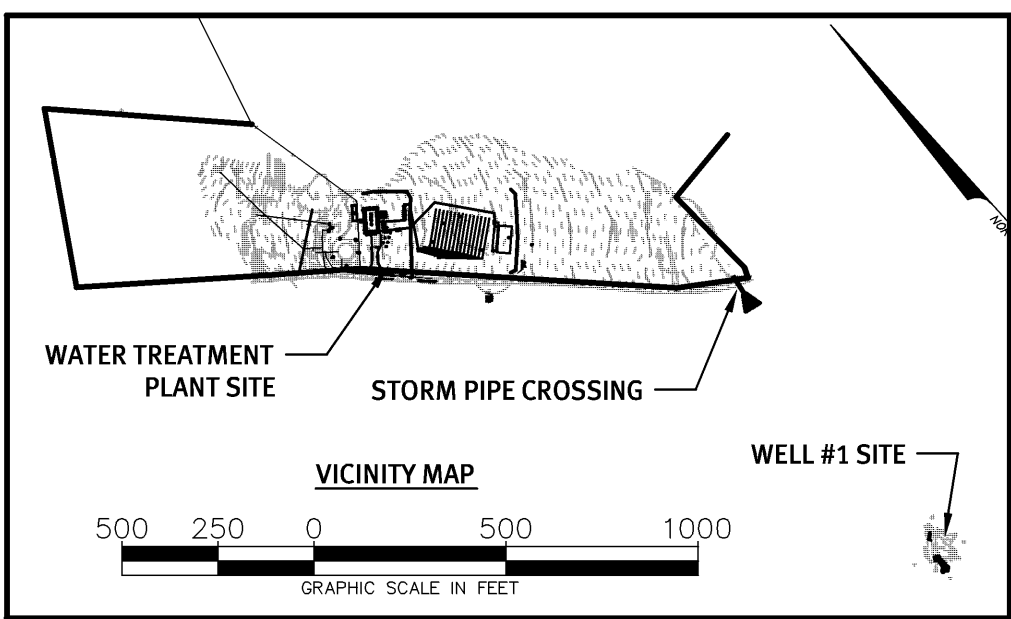

THE ENGINEER AND/OR SURVEYOR TAKES NO RESPONSIBILITY FOR THE LOCATION OR ACCURACY OF THE UTILITIES AS SHOWN HEREON OR ANY UTILITIES WITHIN THE PROJECT THAT MAY NOT BE SHOWN HEREON. THE CONTRACTOR SHALL BE RESPONSIBLE FOR CONTACTING THE UTILITY COMPANIES TO SEE IF ANY UTILITIES EXIST WITHIN THE AREA OF THE PROJECT BEFORE ANY CONSTRUCTION BEGINS. ANY COST INCURRED BY DAMAGING ANY UTILITY WITHIN THE PROJECT SHALL BE AT THE EXPENSE OF THE CONTRACTOR.

48 WORKING HOURS PRIOR TO STARTING THE WORK, THE CONTRACTOR SHALL CALL MISS UTILITY AT PHONE NUMBER 811 AND ADVISE THE NATURE AND LOCATION OF THE WORK.

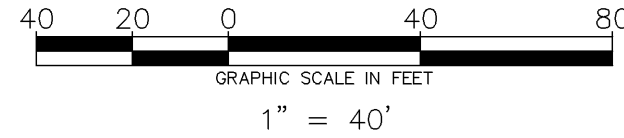

1	8/28/09	VDH/OWNER COMMENTS
2	9/3/09	VDH/OWNER COMMENTS
3	10/7/09	ADDENDUM #2
4	11/17/09	FRANKLIN COUNTY COMMENTS
5	3/14/12	ASBUILTS


**HURT & PROFFITT**  
INCORPORATED  
2524 LANGHORNE ROAD  
LYNCHBURG VA 24501  
800.242.4906 TOLL FREE  
434.847.0047 FAX

**TANK SITE AND GRADING PLAN-ASBUILT**  
FOR  
**TOWN OF BOONES MILL WATER SYSTEM REPLACEMENT, VOLUME 2**  
**TOWN OF BOONES MILL, BOONE DISTRICT, FRANKLIN COUNTY, VA**

PROJECT NO. 20080815  
G.L. NO. 297-03-A3.9  
FILE NO. G-12675  
DATE: 7/31/09  
DRAWN BY: ASK  
CHECKED BY: BLC


**HURT & PROFFITT**

SHEET NO.  
**C1.1**

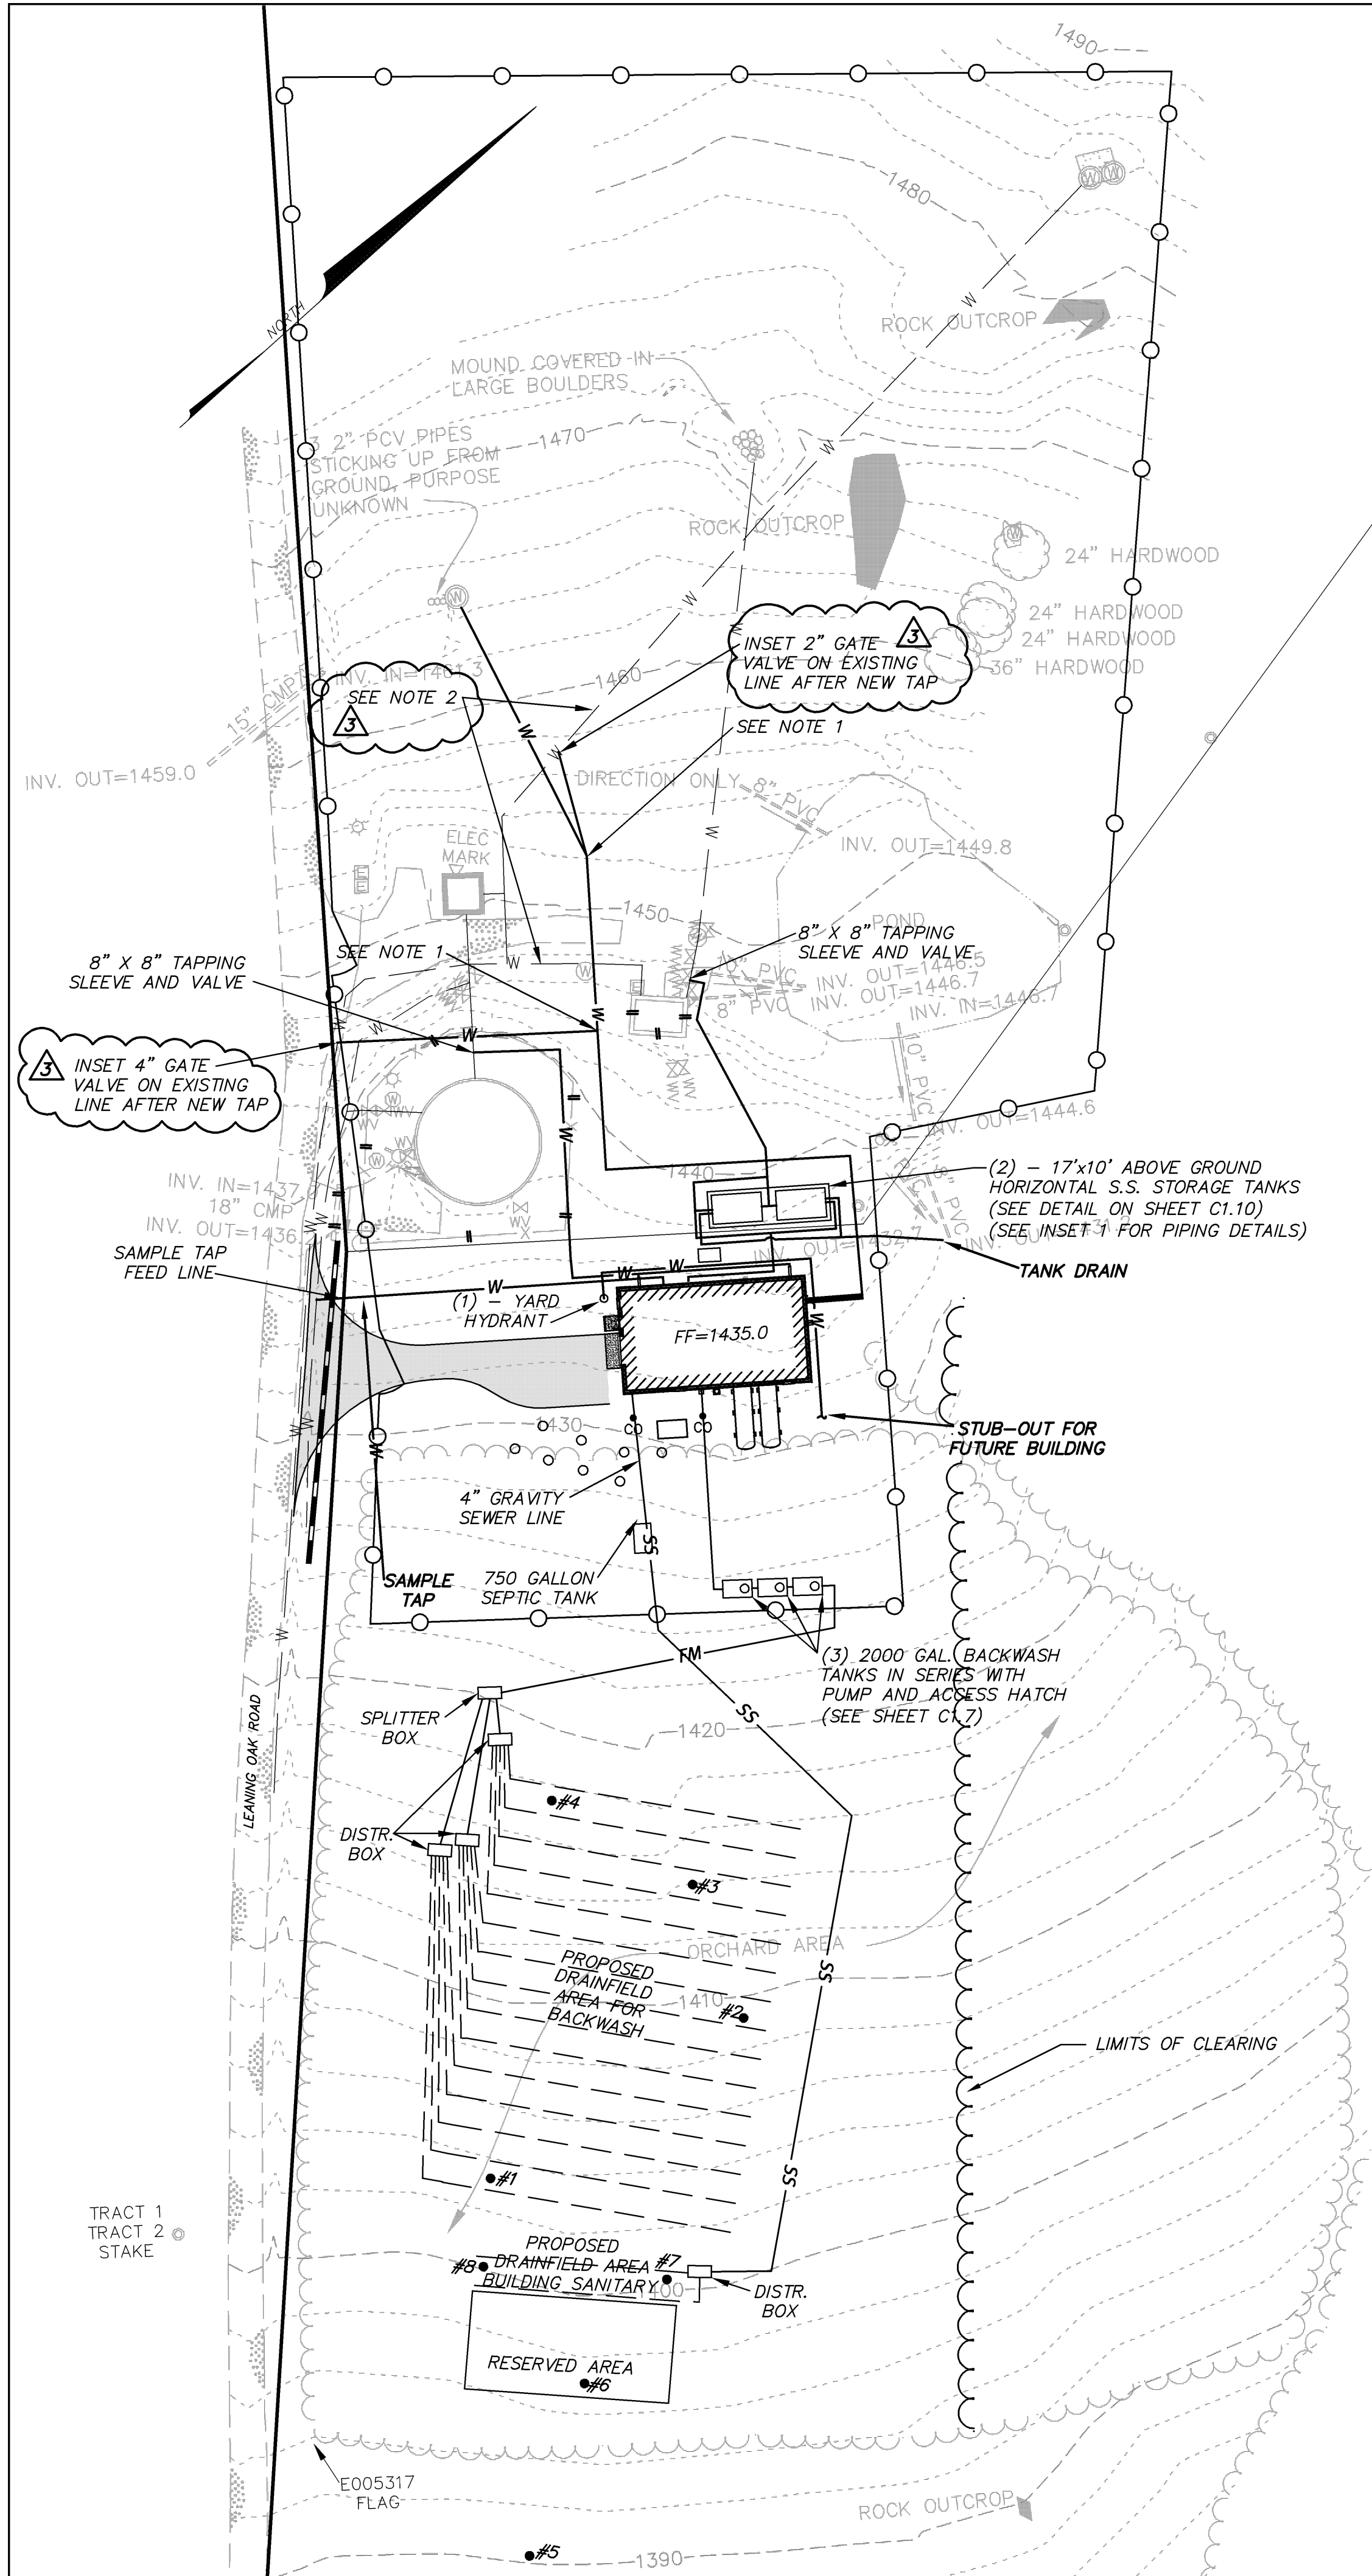



UTILITY PLAN

NOTES:  
1. RAW WELL LINES TO BE RUN IN COMMON TRENCH.  
2. RAW WATER LINE TO BE ABANDONED IN PLACE UPON COMPLETION OF PROJECT.

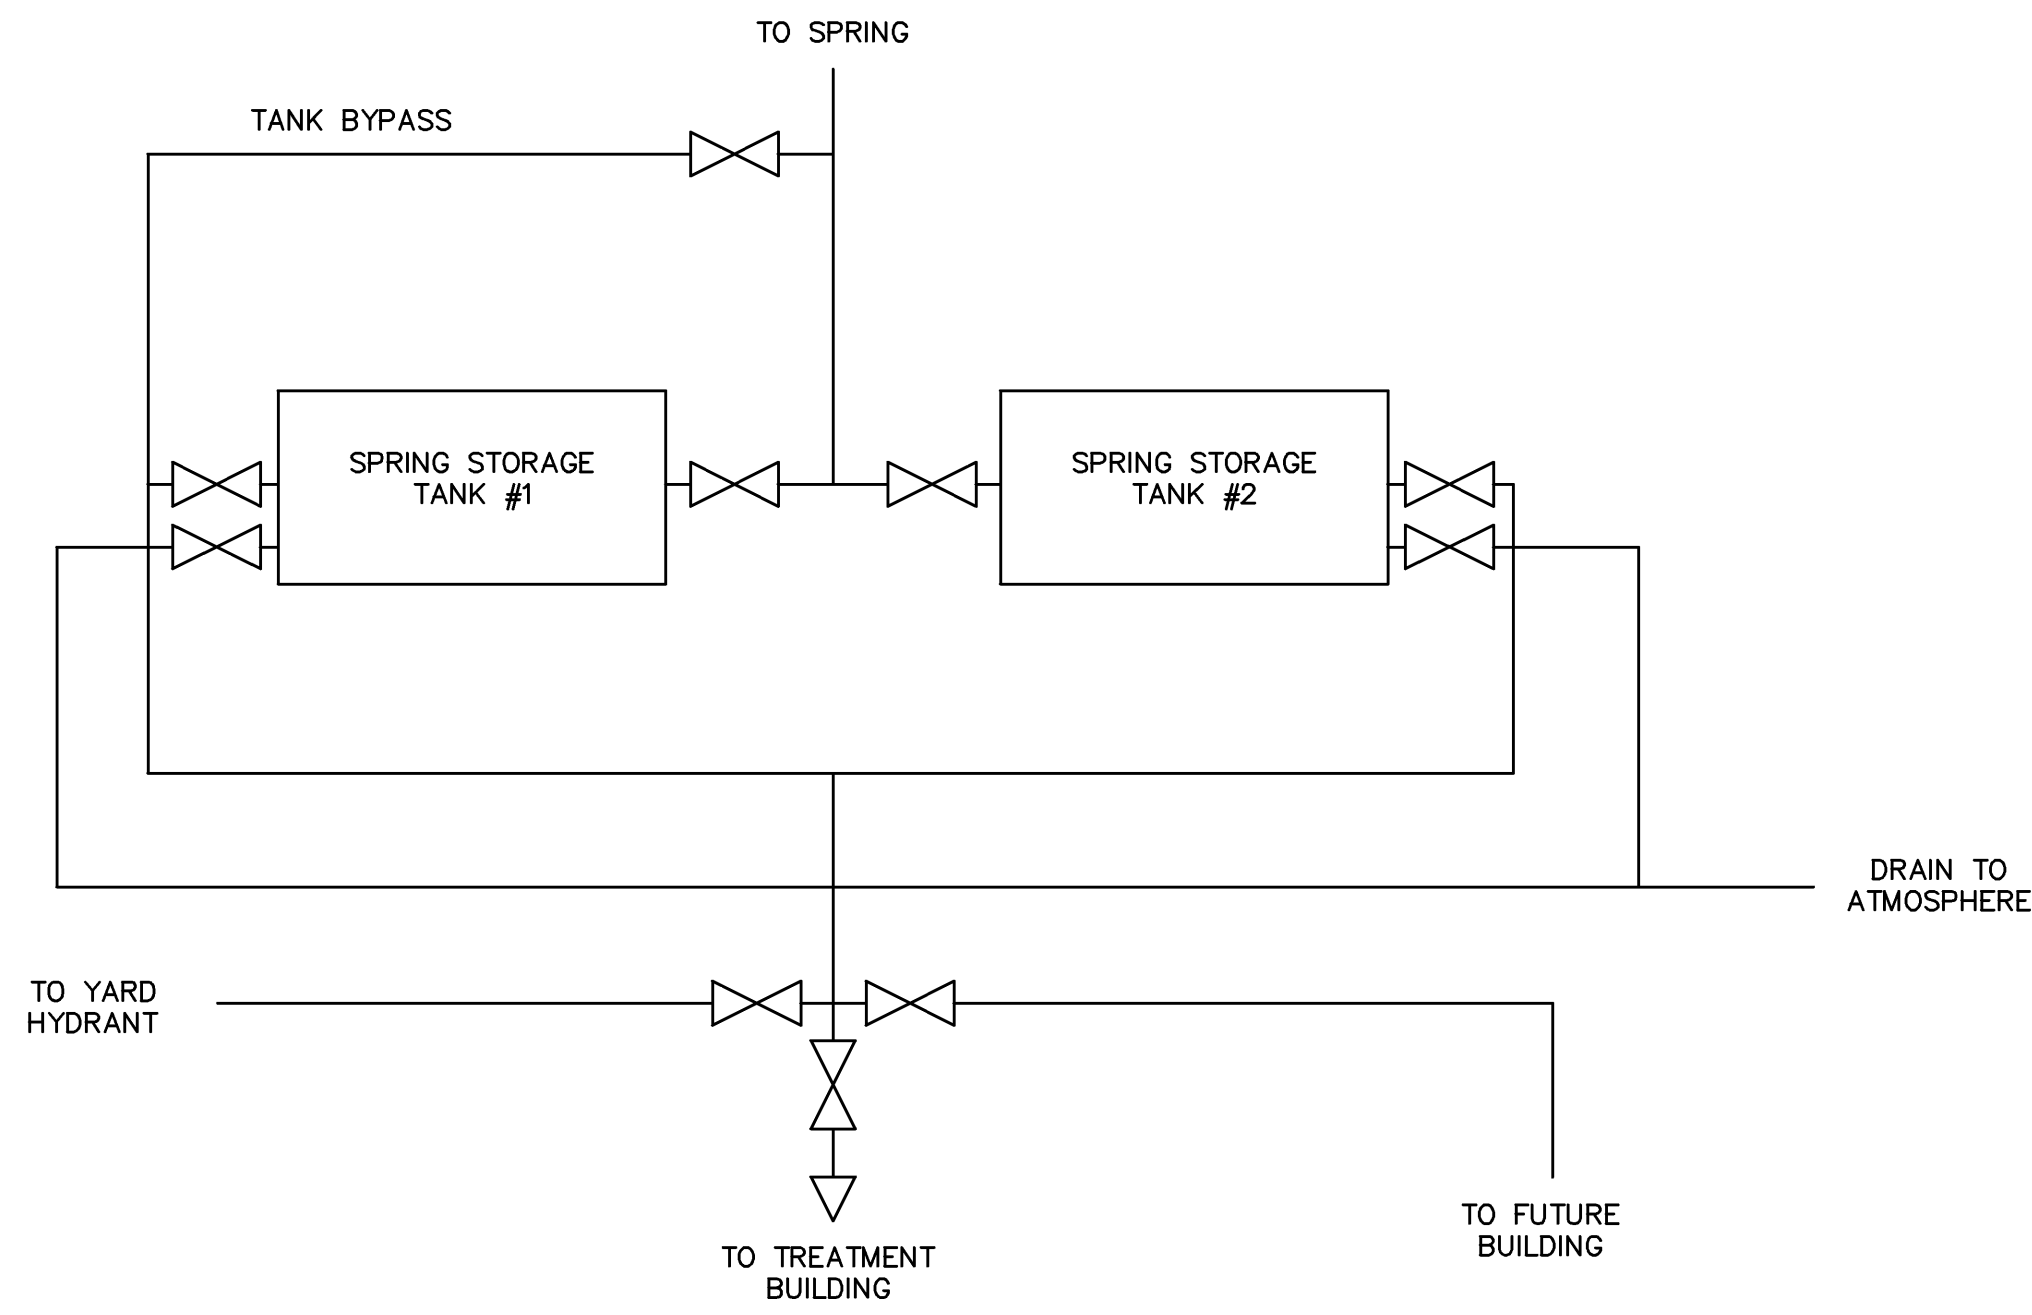

- NOTES: 1. ALL PIPING AND VALVES SHOWN ARE TO BE 8".  
2. ALL PIPING IS TO BE INSTALLED AT MINIMUM OF 1% SLOPE TO ALLOW GRAVITY FLOW.  
3. 8" X 4" REDUCER TO BE INSTALLED ON LINE TO TREATMENT BUILDING.  
4. 2" TAPPED PLUG INSTALLED ON LINE TO YARD HYDRANT.

INSET 1

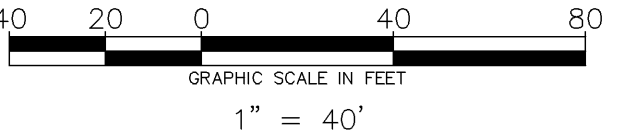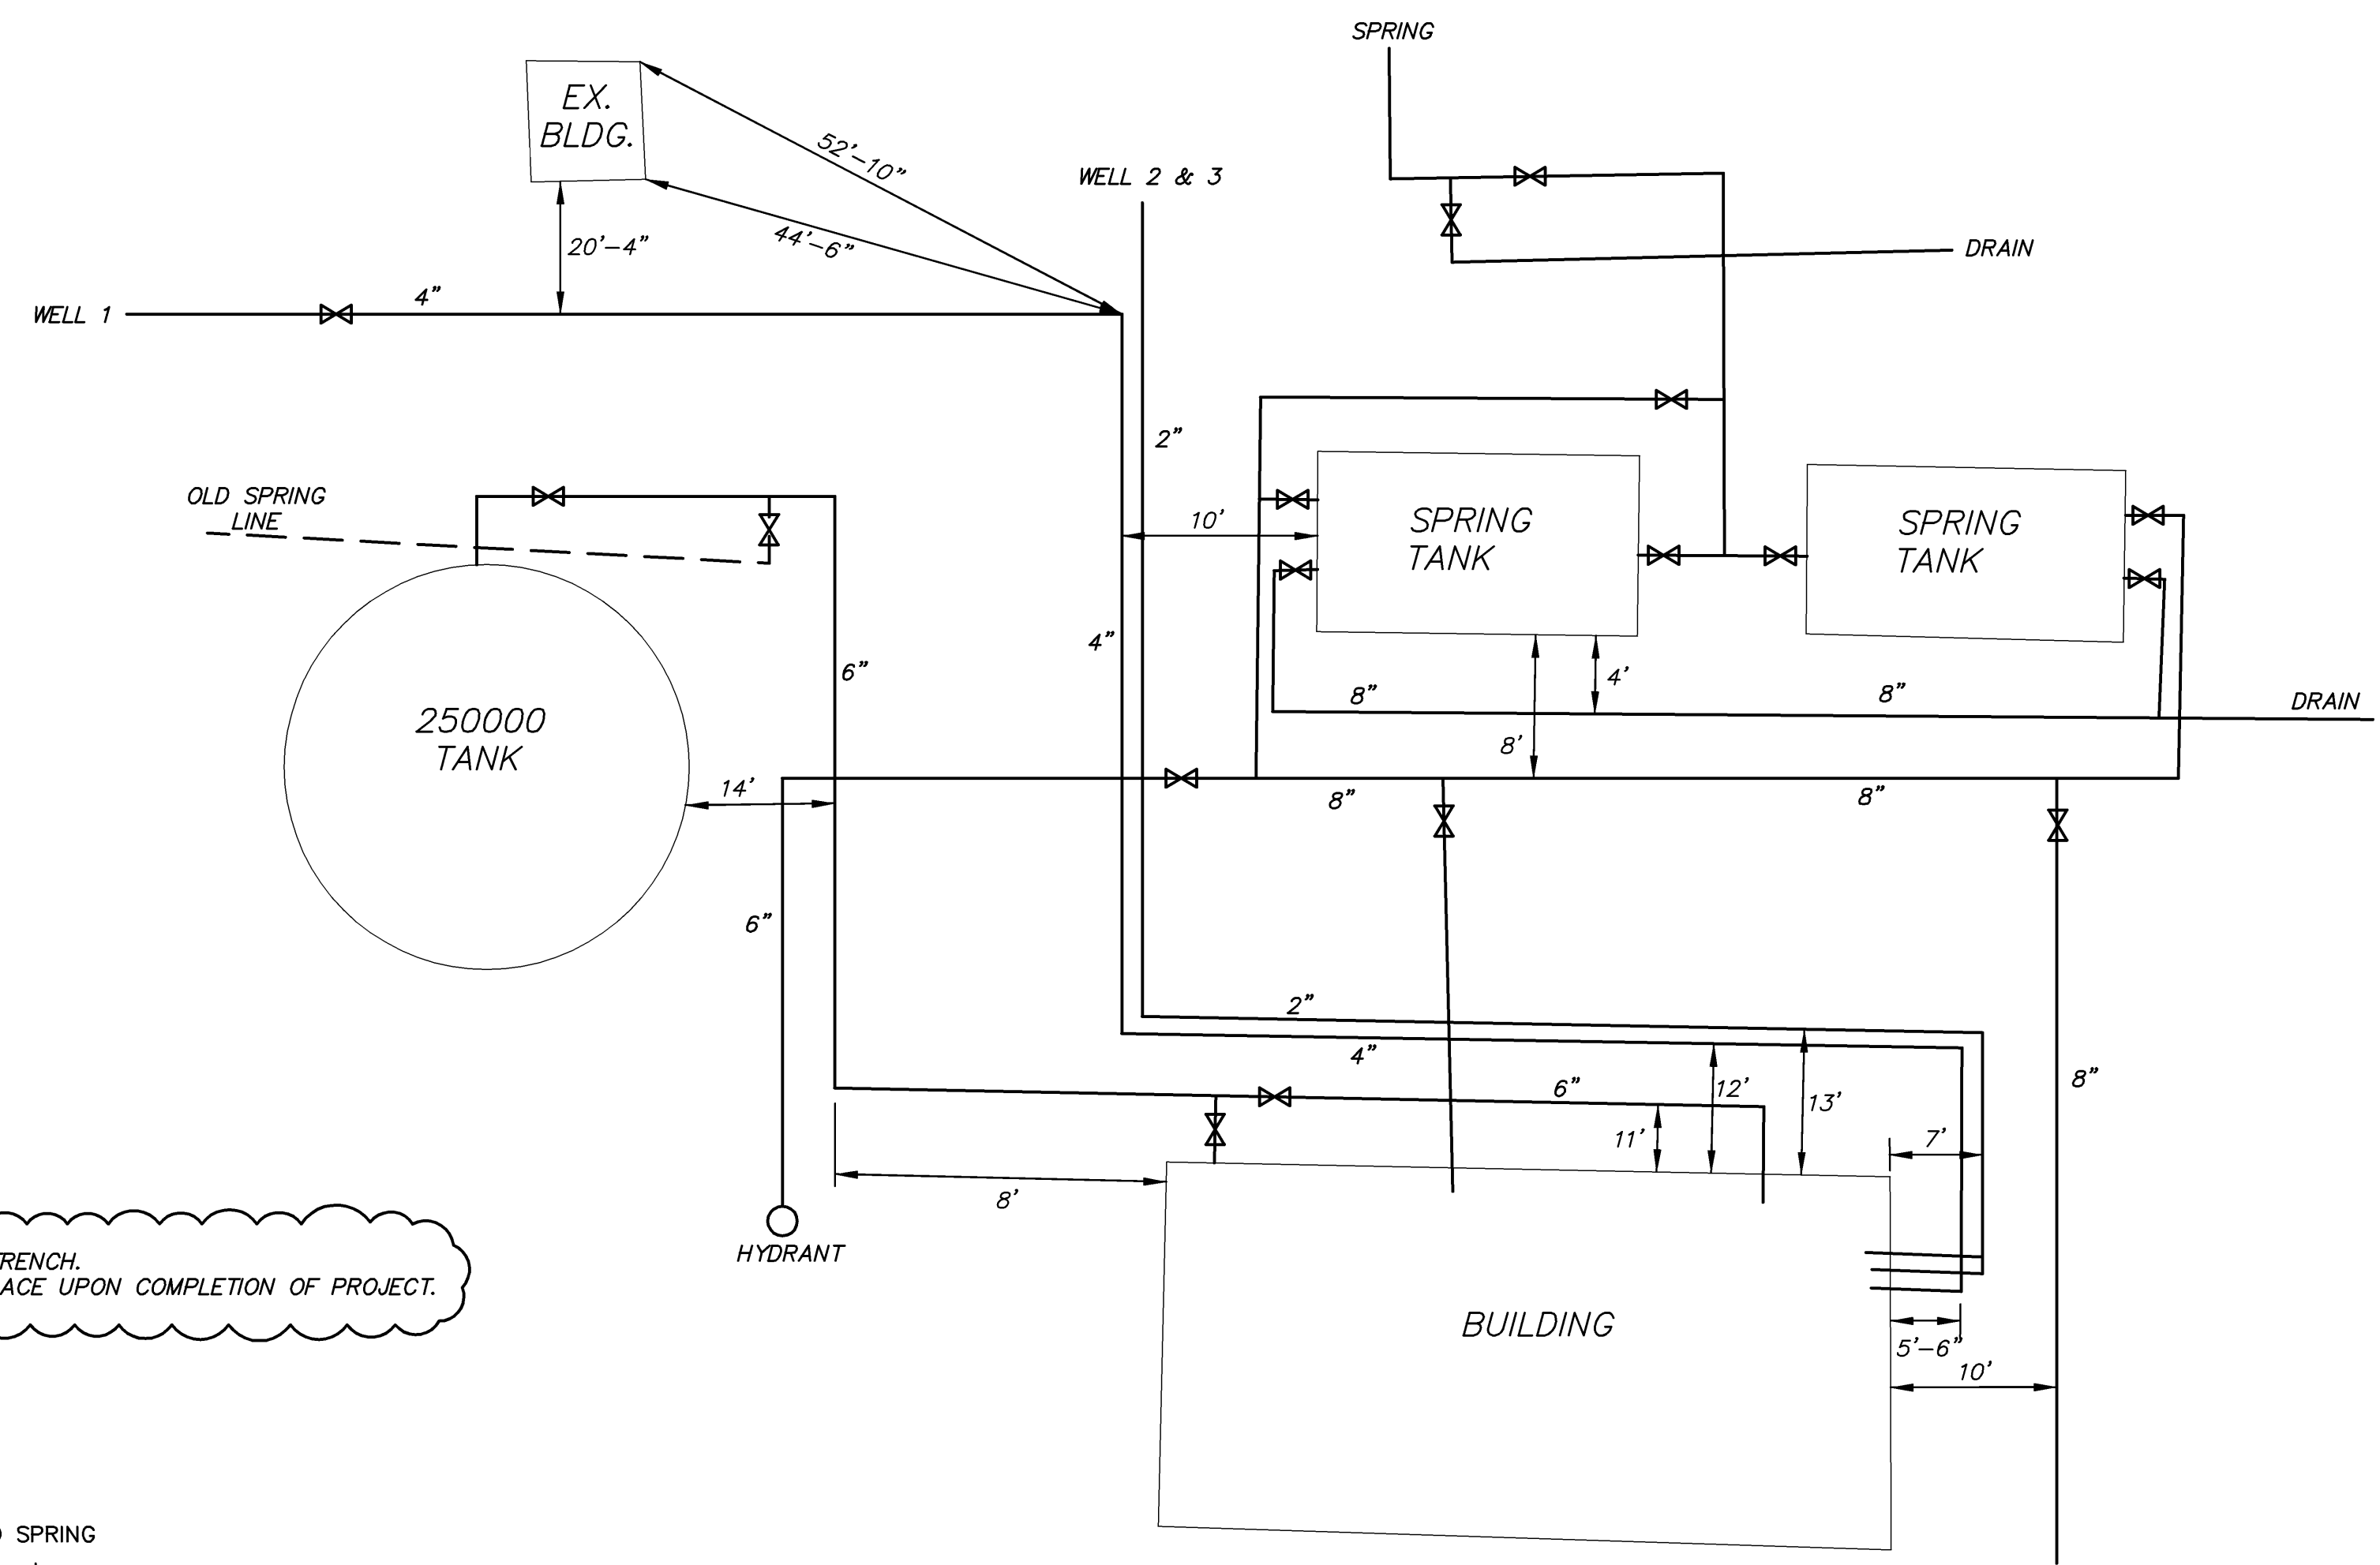

1	8/28/09	VDH/OWNER COMMENTS
2	9/3/09	VDH/OWNER COMMENTS
3	10/7/09	ADDENDUM #2
4	11/17/09	FRANKLIN COUNTY COMMENTS
5	3/14/12	ASBUILTS


**HURT & PROFFITT**  
INCORPORATED  
2524 LANGHORNE ROAD  
LYNCHBURG VA 24501  
800.242.4906 TOLL FREE  
434.847.7796 MAIN  
434.847.0047 FAX

**TANK SITE UTILITY PLAN-ASBUILT**  
FOR  
**TOWN OF BOONES MILL WATER SYSTEM REPLACEMENT, VOLUME 2**  
**TOWN OF BOONES MILL, BOONE DISTRICT, FRANKLIN COUNTY, VA**

PROJECT NO.	20080815
G.L. NO.	297-03-A3.9
FILE NO.	G-12675
DATE:	7/31/09
DRAWN BY:	ASK
CHECKED BY:	BLC

**HURT & PROFFITT**



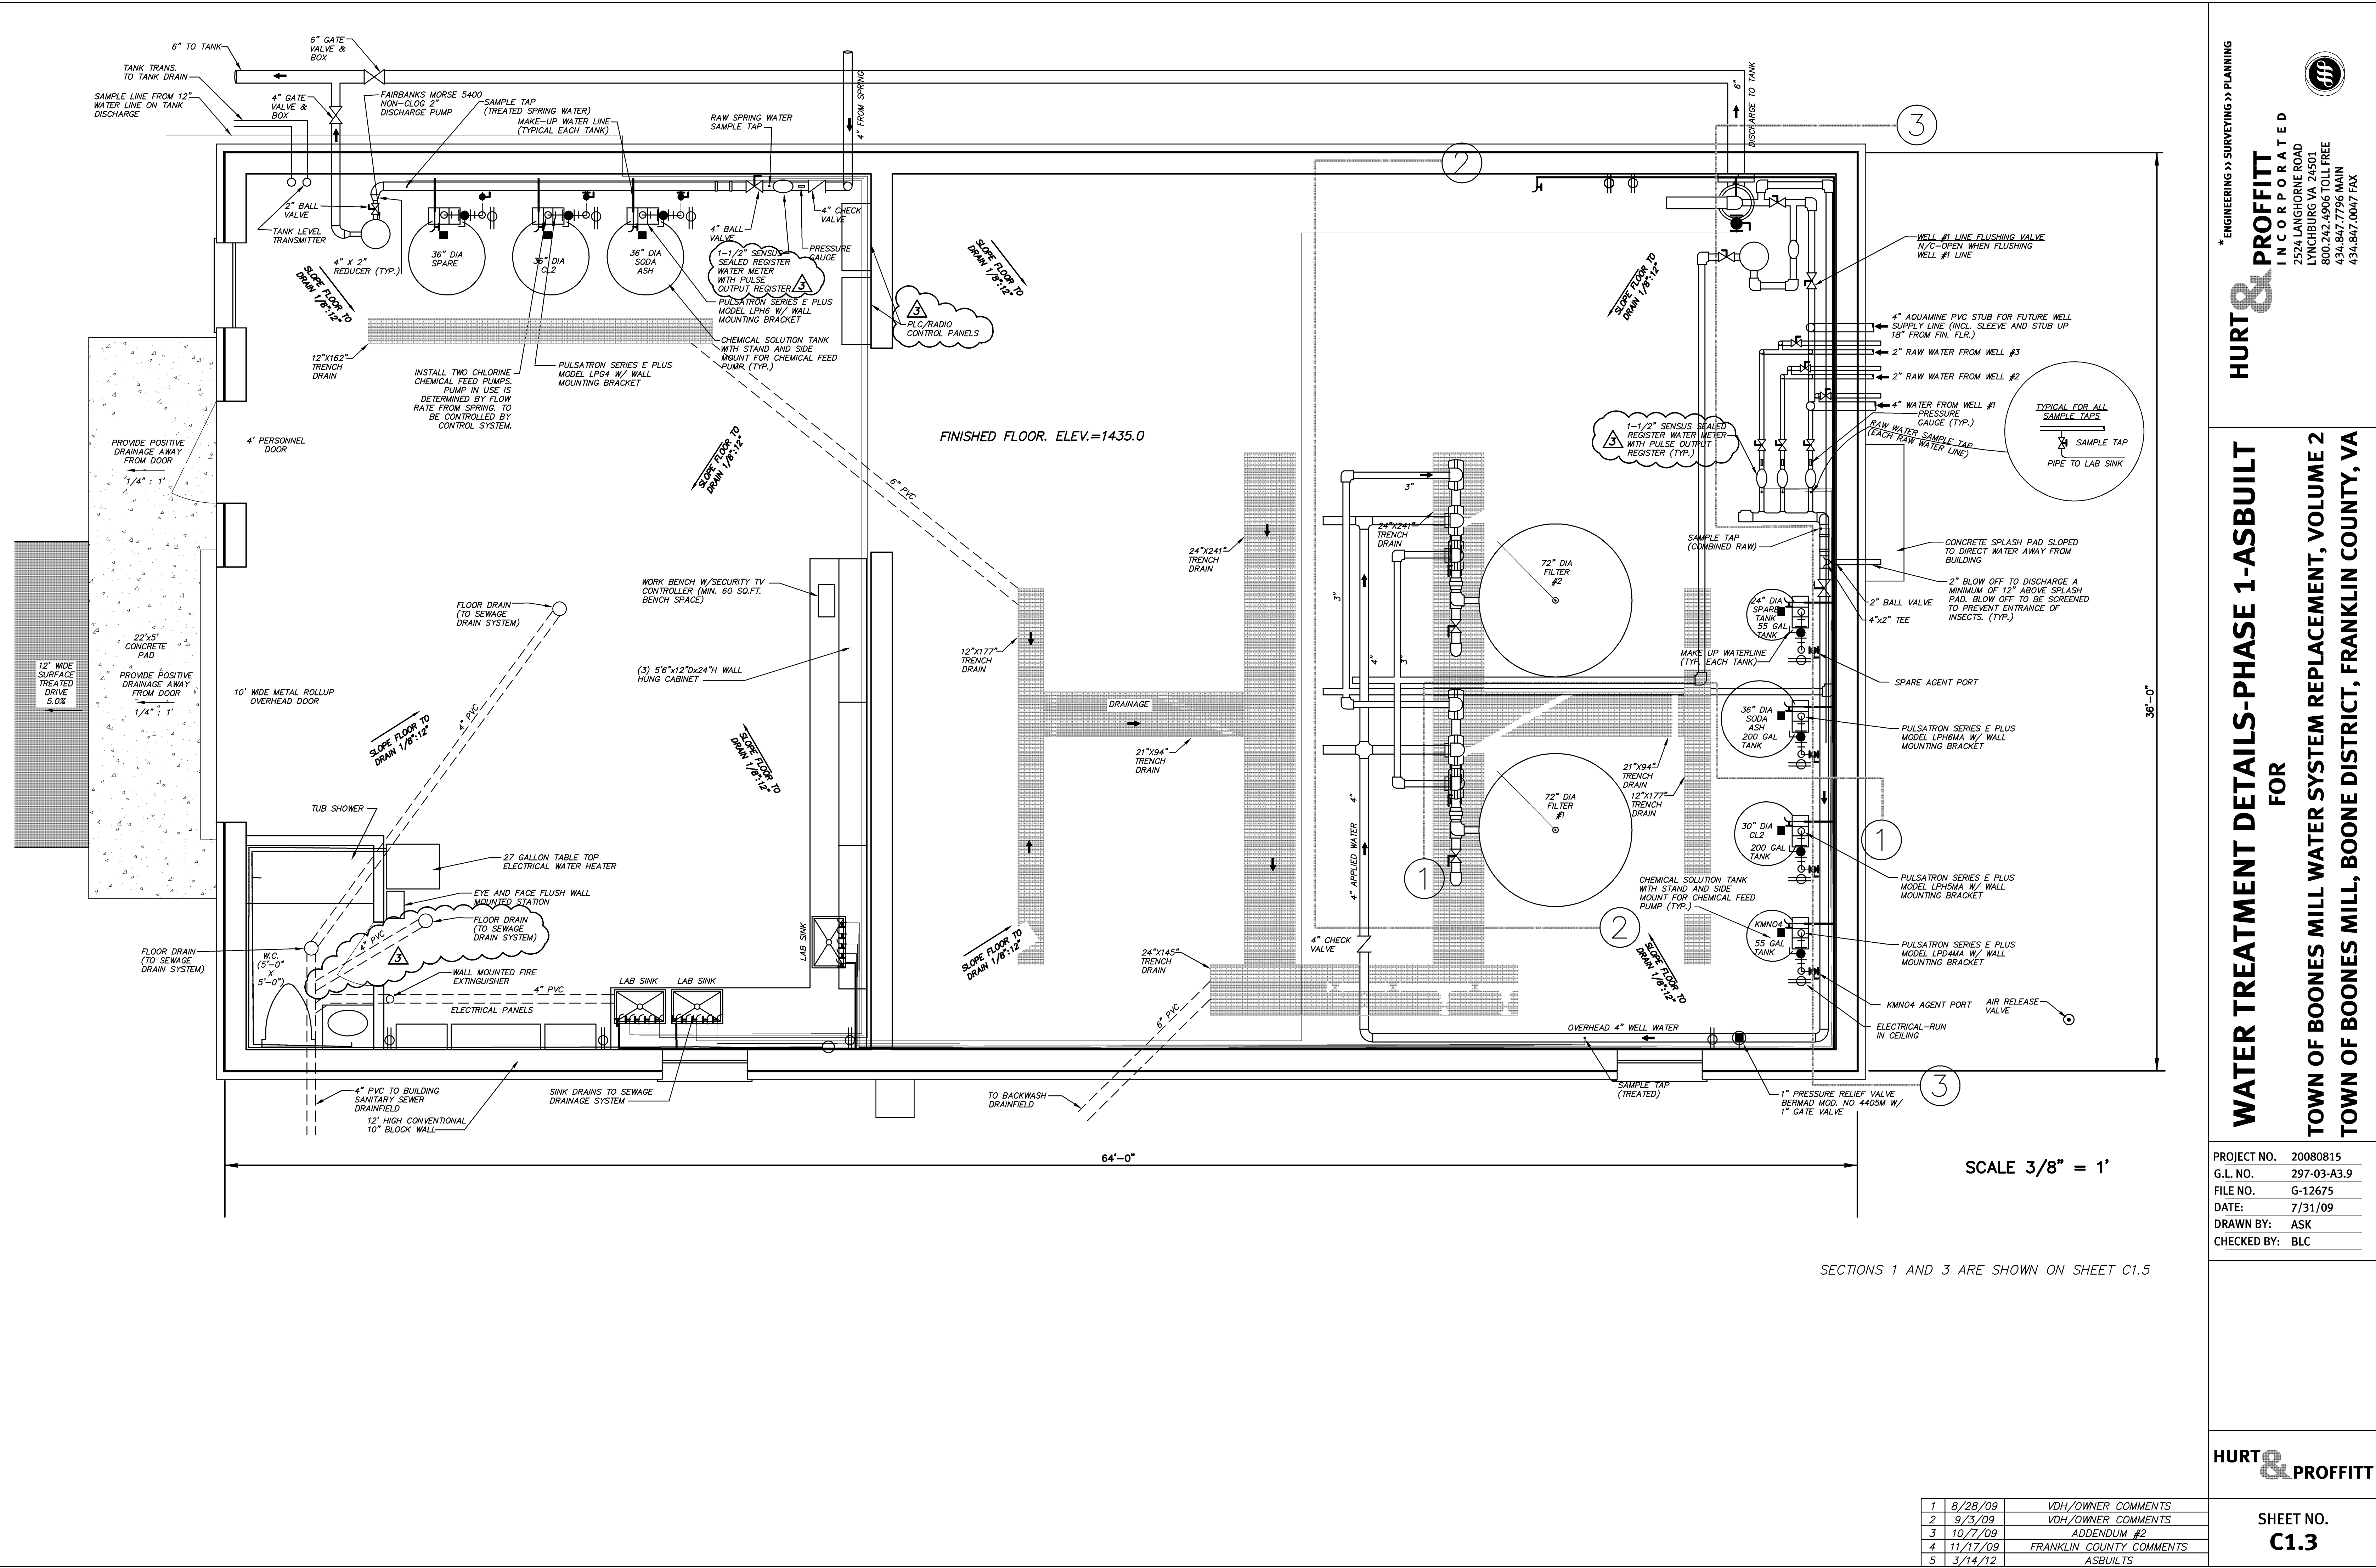

ENGINEERING >> SURVEYING >> PLANNING

HURT & PROFFITT

INCORPORATED

2524 LANGHORNE ROAD  
LYNCHBURG VA 24501  
800.242.4906 TOLL FREE  
434.847.7796 MAIN  
434.847.0047 FAX

WATER TREATMENT DETAILS-PHASE 1-ASBUILT

FOR

TOWN OF BOONES MILL WATER SYSTEM REPLACEMENT, VOLUME 2

TOWN OF BOONES MILL, BOONE DISTRICT, FRANKLIN COUNTY, VA

PROJECT NO. 20080815

G.L. NO. 297-03-A3.9

FILE NO. G-12675

DATE: 7/31/09

DRAWN BY: ASK

CHECKED BY: BLC

HURT & PROFFITT



SHEET NO. C1.3

1	8/28/09	VDH/OWNER COMMENTS
2	9/3/09	VDH/OWNER COMMENTS
3	10/7/09	ADDENDUM #2
4	11/17/09	FRANKLIN COUNTY COMMENTS
5	3/14/12	ASBUILTS



Mar 14, 2012 - 4:08pm V:\LandProjects\20080815\dwg\ASbults-WTP\ASBUILT-SITE-TANK.dwg





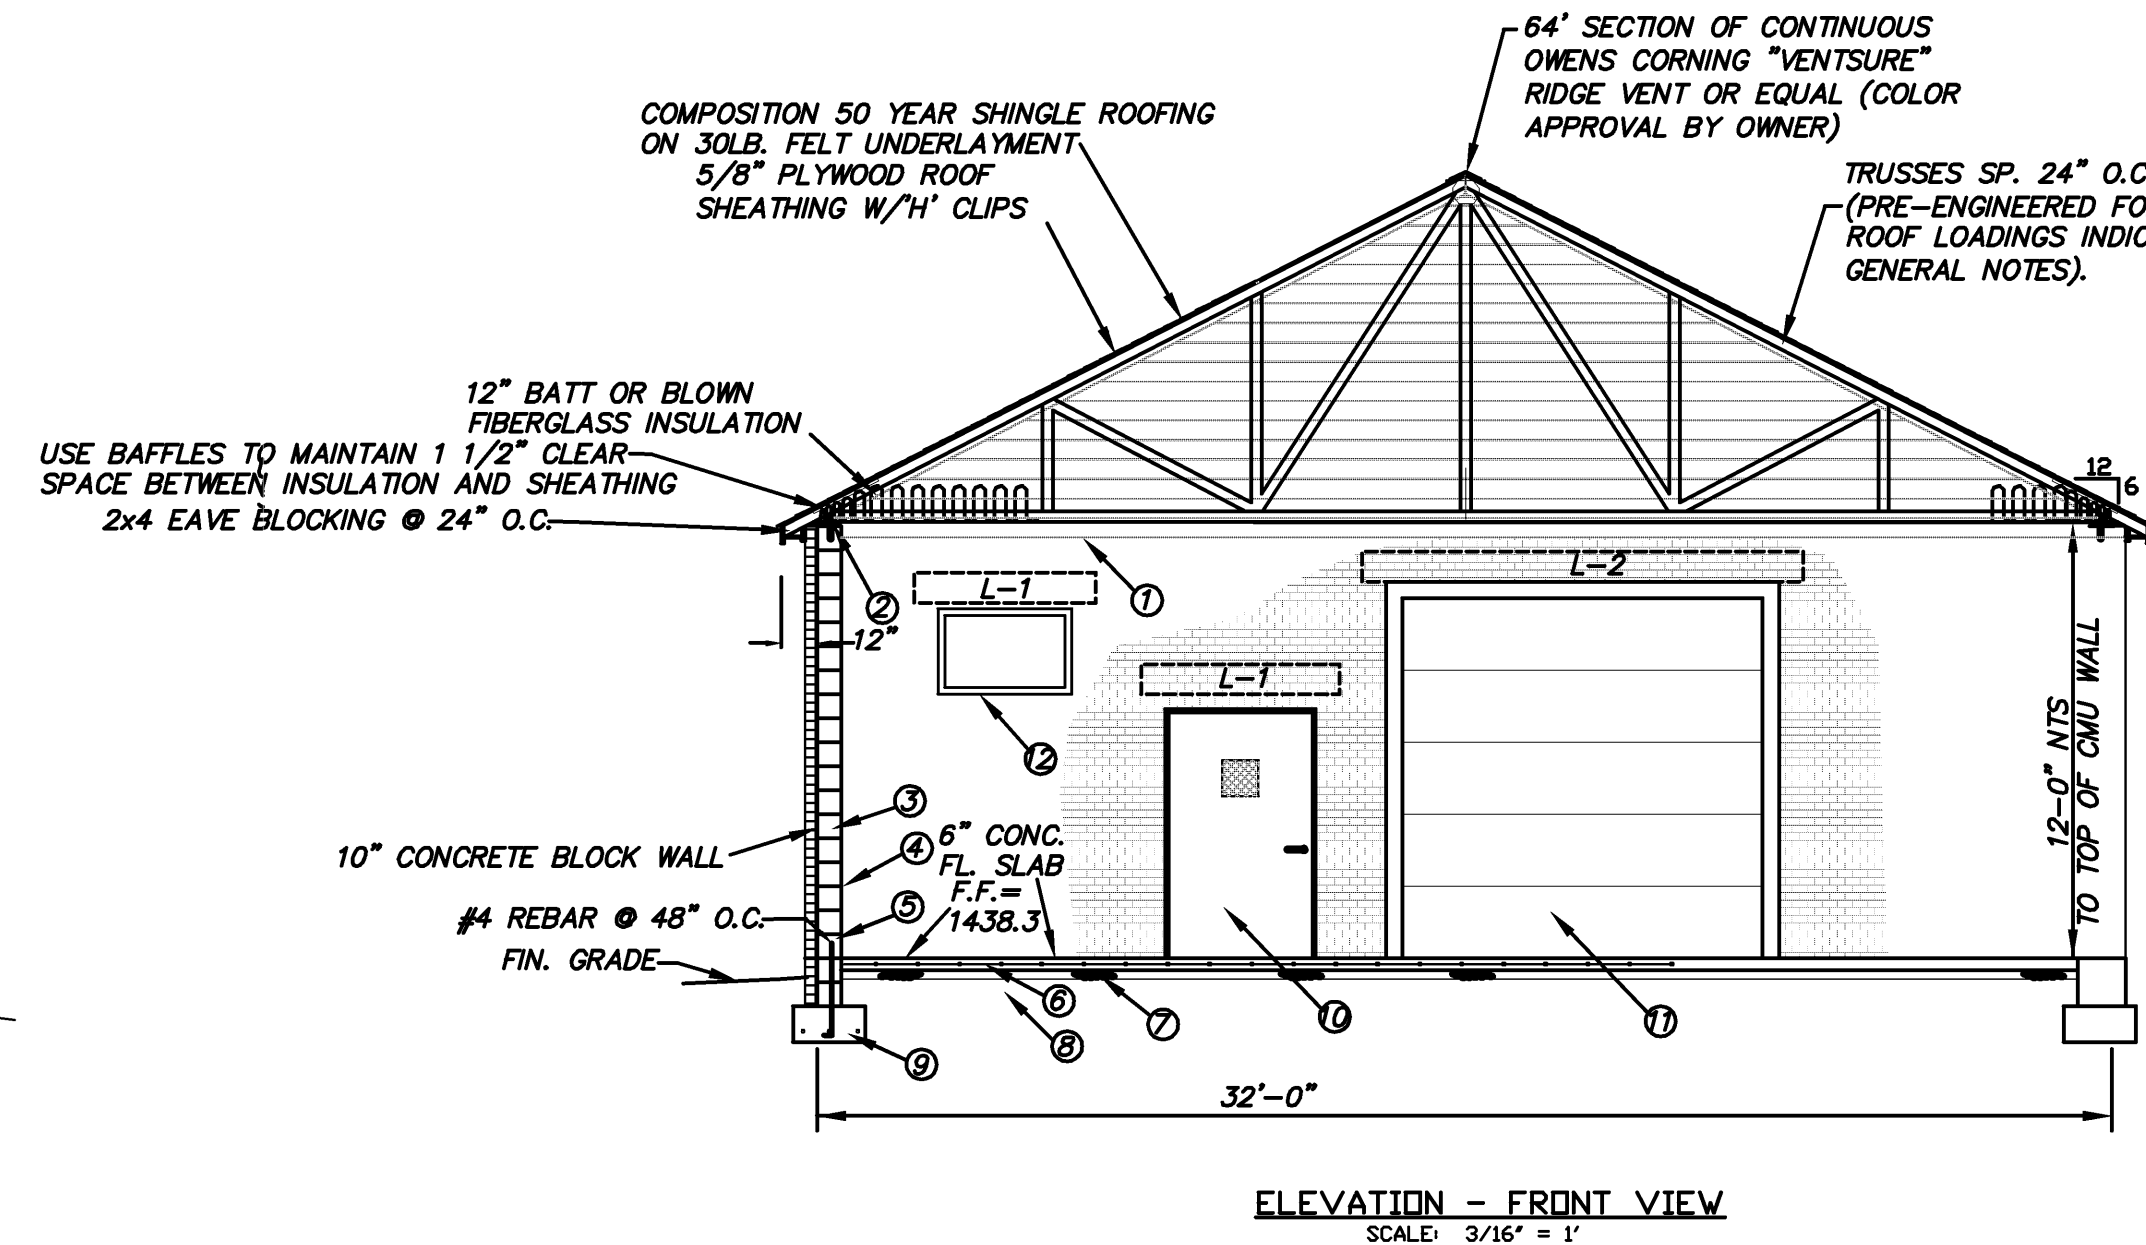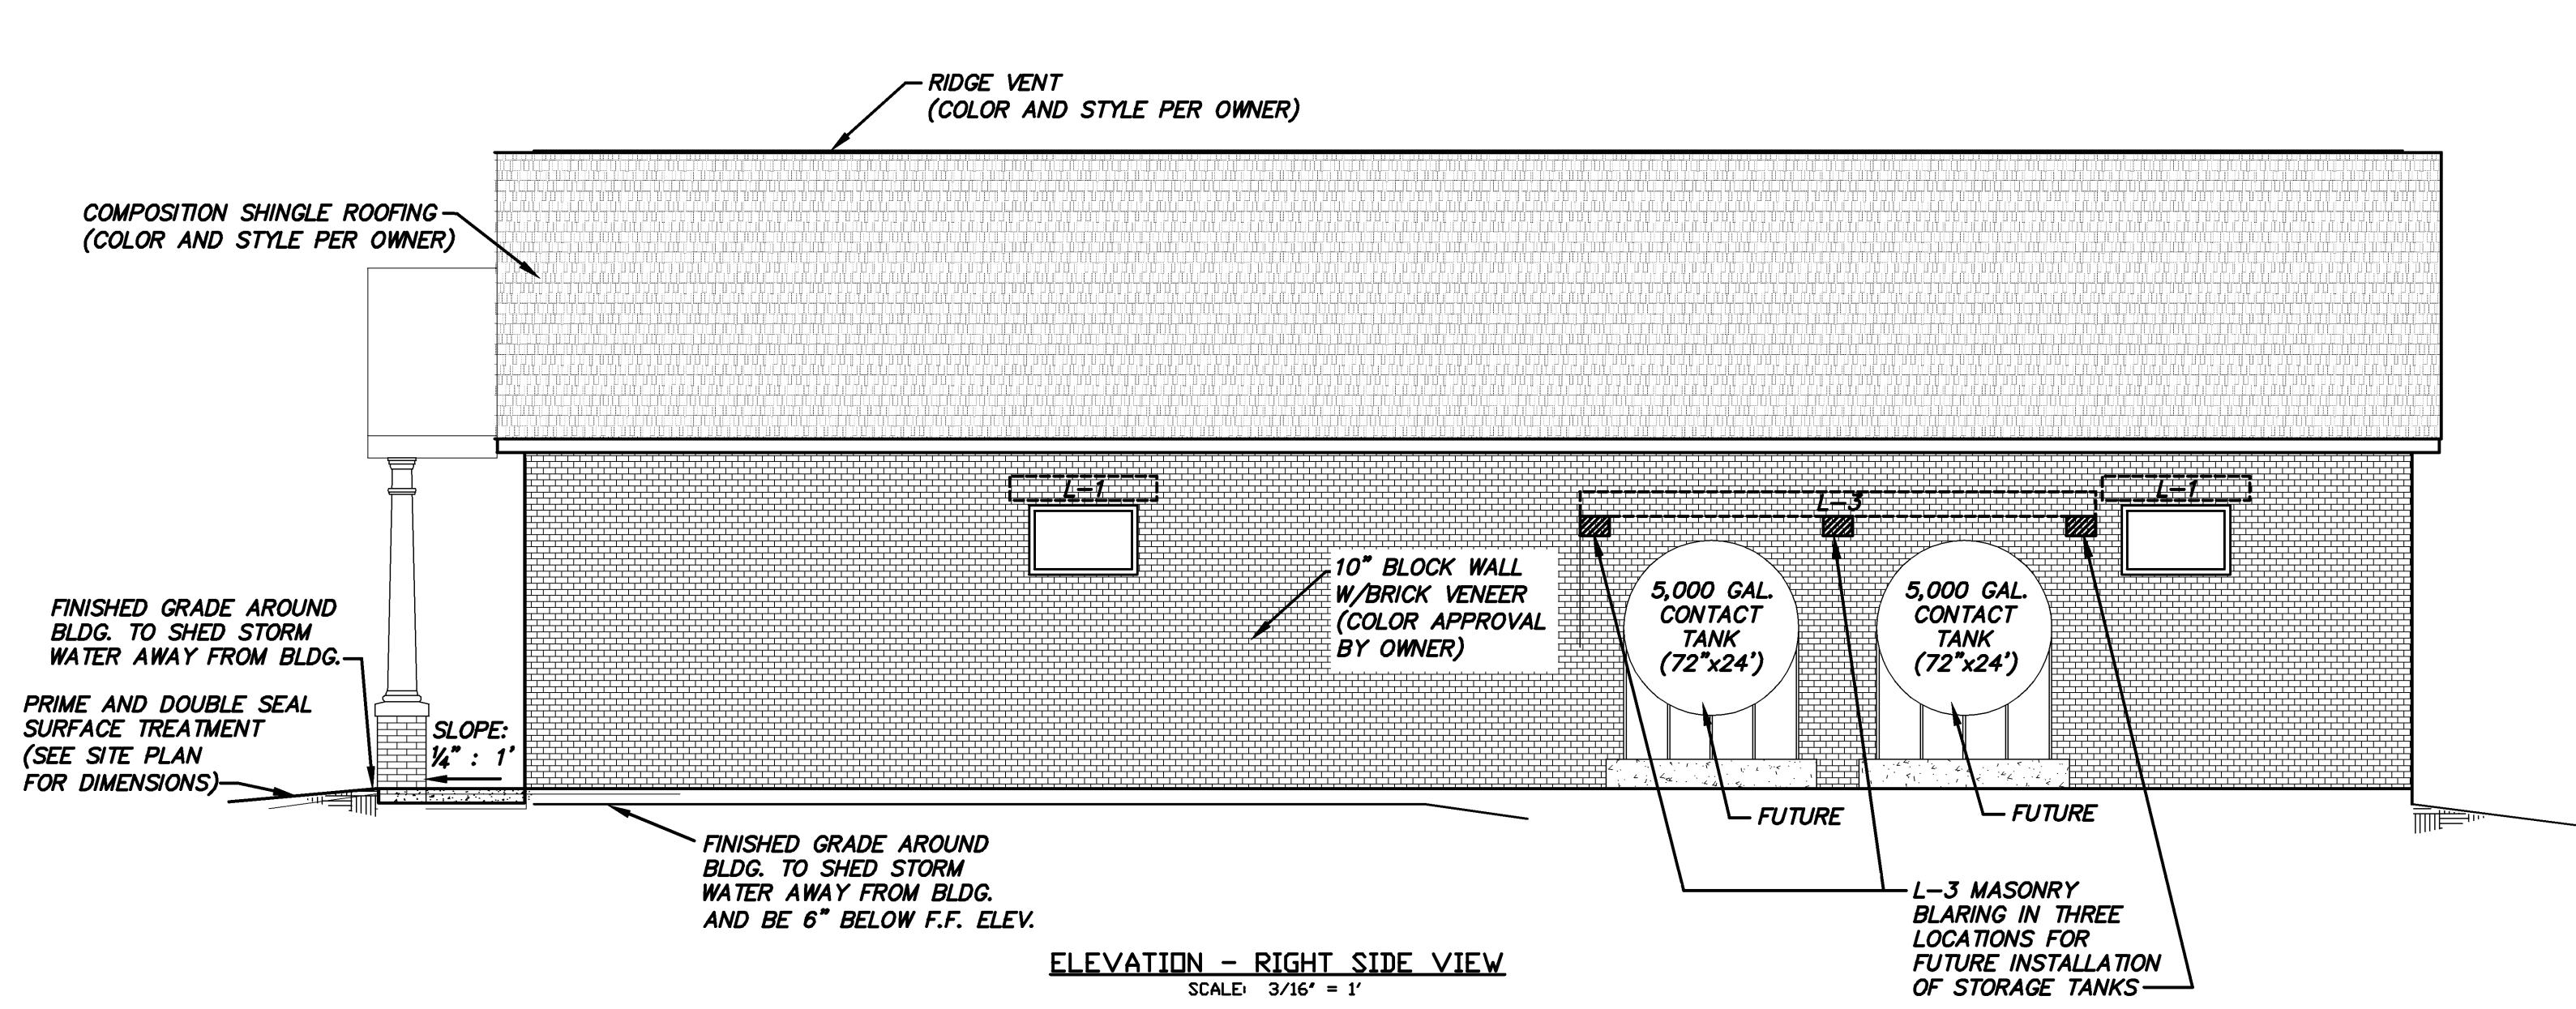

- ALL RAKE, FACIA, & CORNICE WORK TO BE ALUMINUM COVERED, WOOD SHALL BE PRIME COATED PRIOR TO ALUM. COVERING
1. FIN. CEILING: 5/8" MOISTURE RESISTANT GYPSUM BOARD TAPED, FINISHED, & PAINTED
  2. PRESSURE TREATED (2) 2x8 BOLTED W/ 5/8" # "J" ANCHOR BOLTS @ 48" O.C. (EMBEDDED IN BOND BEAM GROUT.)
  3. FILL BLOCK VOIDS WITH INSULATION
  4. MTL - WIRE REINFORCEMENT CONTIN. (COURSES 16" O.C.)
  5. GROUT REBAR FILLED COURSE (ONLY)
  6. 6X6 - W1.4 x W1.4
  7. 4" STONE FILL
  8. COMPACTED, LEVELED SUB-GRADE
  9. NOT USED
  10. (1) 4'x7' INSULATED STEEL DOOR W/METAL FRAME, THRESHOLD & HARDWARE (DEADBOLTS REQ'D.) SIMILAR TO JEN-WELD GLADIATOR STEEL ENTRANCE DOOR 6 PANEL DOOR W/ GLASS INSERT
  11. (1) 10'x10' INSULATED METAL O.H. DOOR W/METAL FRAME, THRESHOLD & HARDWARE. (TOP & BOTTOM BOLTS & DEADBOLTS REQ'D.) SIMILAR TO OVERHEAD DOOR CO. BANNER 313/319 SERIES W/ MOTORIZED DOOR OPERATOR
  12. (2) AWNING TYPE VINYL WINDOW W/ 3/4" INSULATED GLASS SIMILAR TO JEN-WELD 48" X 30" AWNING WINDOW

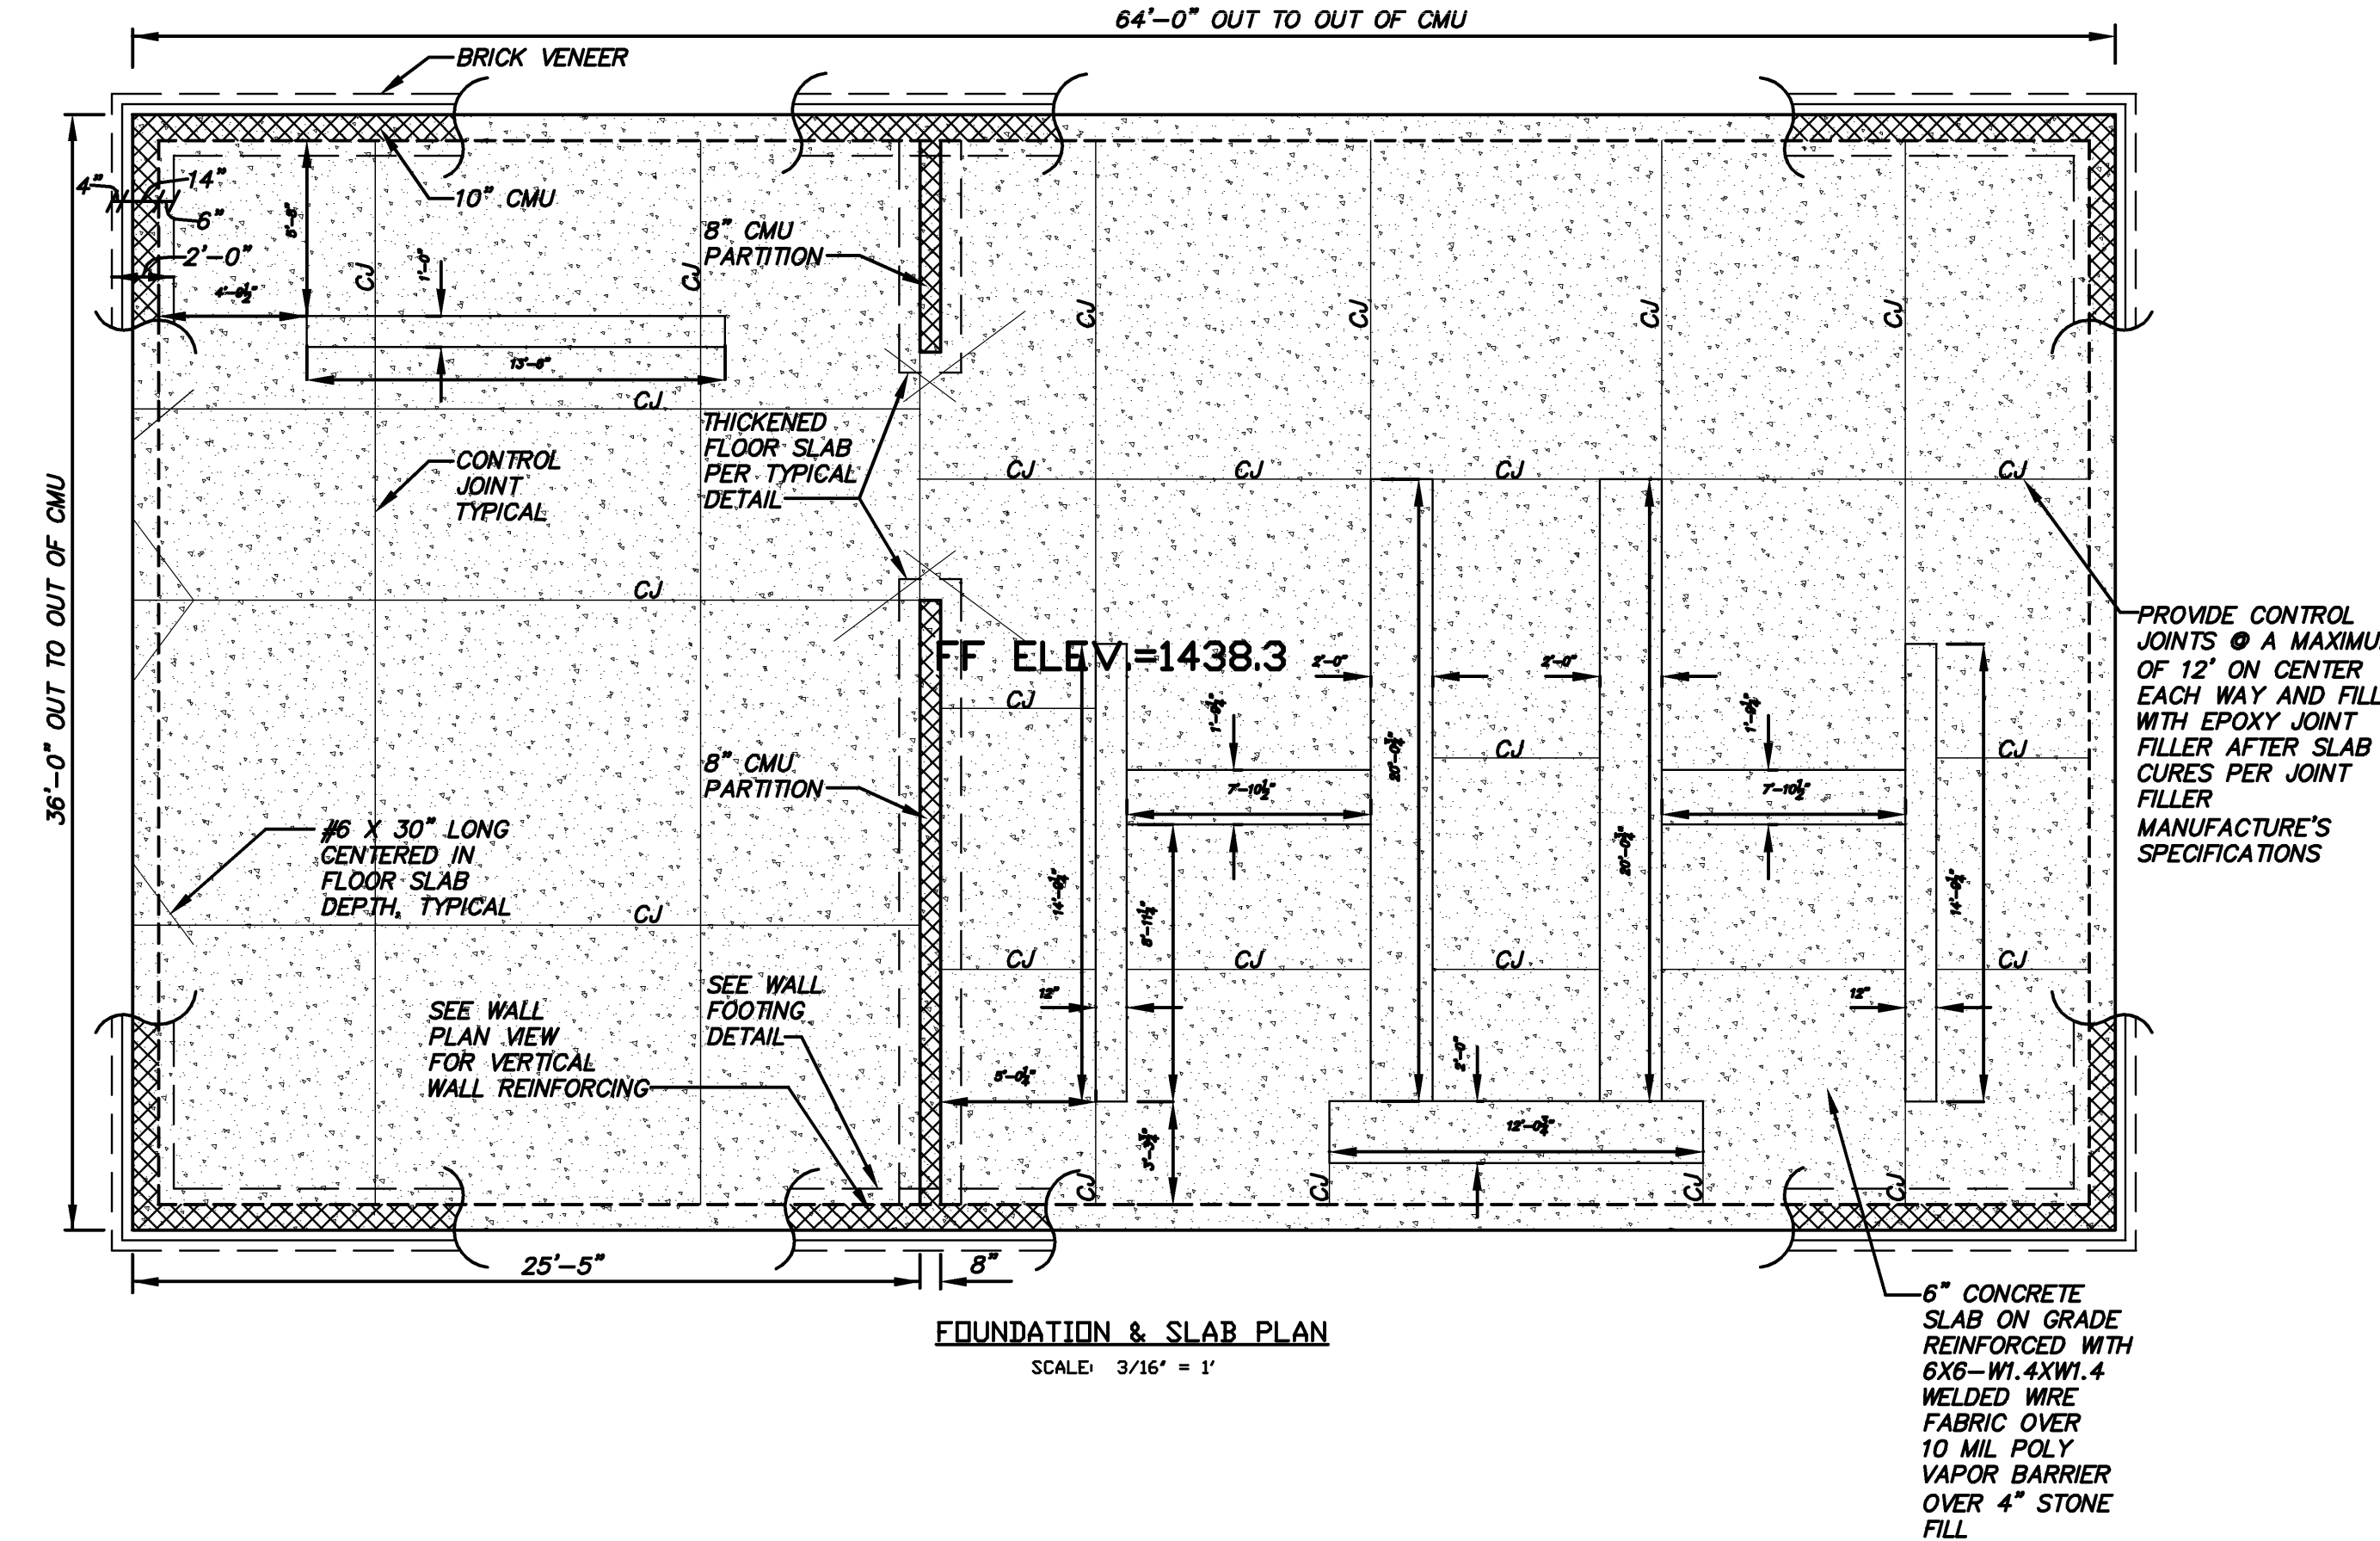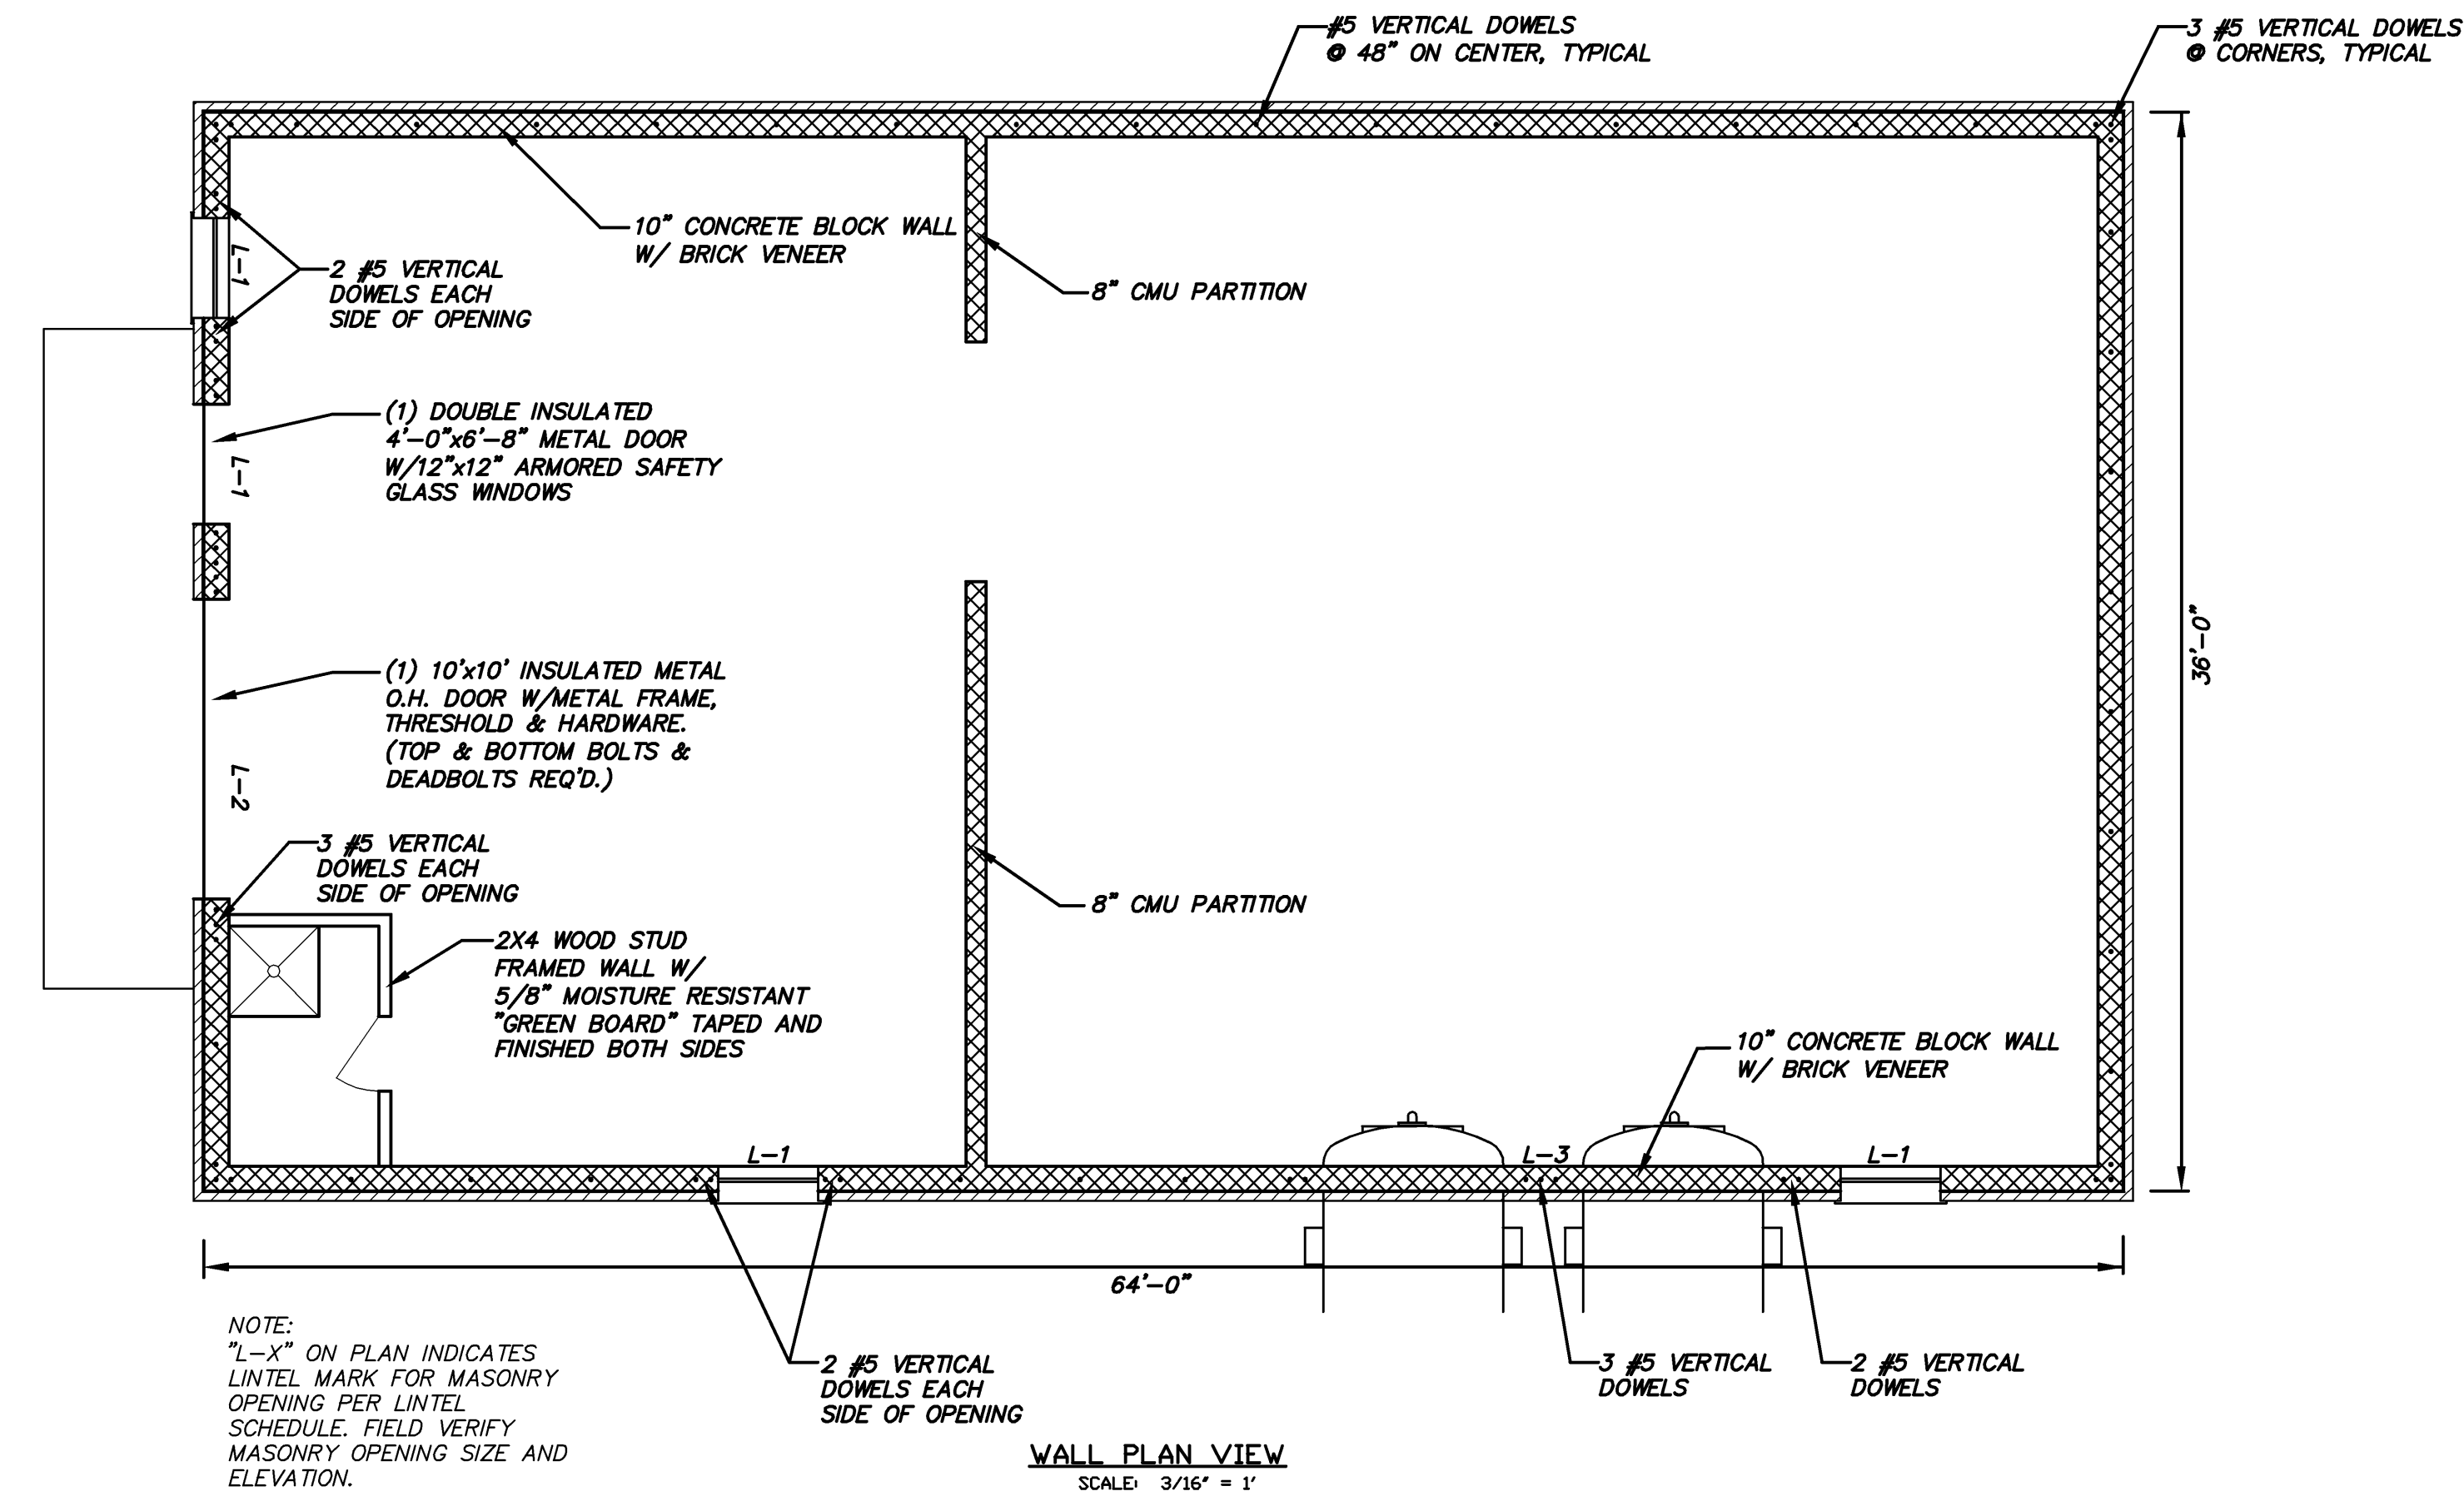

ENGINEERING >>> SURVEYING >> PLANNING

HURT & PROFFITT

INCORPORATED

2524 LANGHORNE ROAD  
LYNCHBURG VA 24501  
800.242.4906 TOLL FREE  
434.847.7796 MAIN  
434.847.0047 FAX

WATER TREATMENT DETAILS-ASBUILT

FOR

TOWN OF BOONES MILL WATER SYSTEM REPLACEMENT, VOLUME 2

TOWN OF BOONES MILL, BOONE DISTRICT, FRANKLIN COUNTY, VA

PROJECT NO. 20080815

G.L. NO. 297-03-A3.9

FILE NO. G-12675

DATE: 7/31/09

DRAWN BY: ASK


CHECKED BY: BLC

HURT & PROFFITT




SHEET NO. C1.5

1	8/28/09	VDH/OWNER COMMENTS
2	9/3/09	VDH/OWNER COMMENTS
4	11/17/09	FRANKLIN COUNTY COMMENTS
5	3/14/12	ASBUILTS

Mar 14, 2012 4:09pm V:\LandProjects\20080815\dwg\Asbults-WTP\ASBUILT-SITE-TANK.dwg

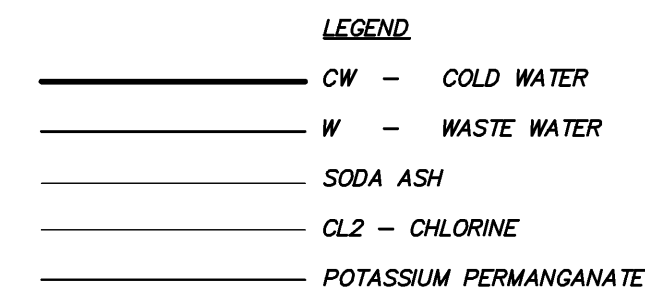


LAYER	DEPTH	SIZE	DESCRIPTION	UNIFORMITY COEFFICIENT
TOP	12"	0.8–2.0mm	ANTHRACITE	LESS THAN 1.7
2ND	22"	0.3–0.35mm	GREENSAND	LESS THAN 1.7
3RD	2"	3/16"–3/32"	GRADED GRAVEL	LESS THAN 1.7
4TH	3"	1/2"–3/16"	GRADED GRAVEL	—
5TH	3"	3/4"–1/2"	GRADED GRAVEL	—
BOTTOM	6"	1 1/2"–2 1/4"	GRADED GRAVEL	—

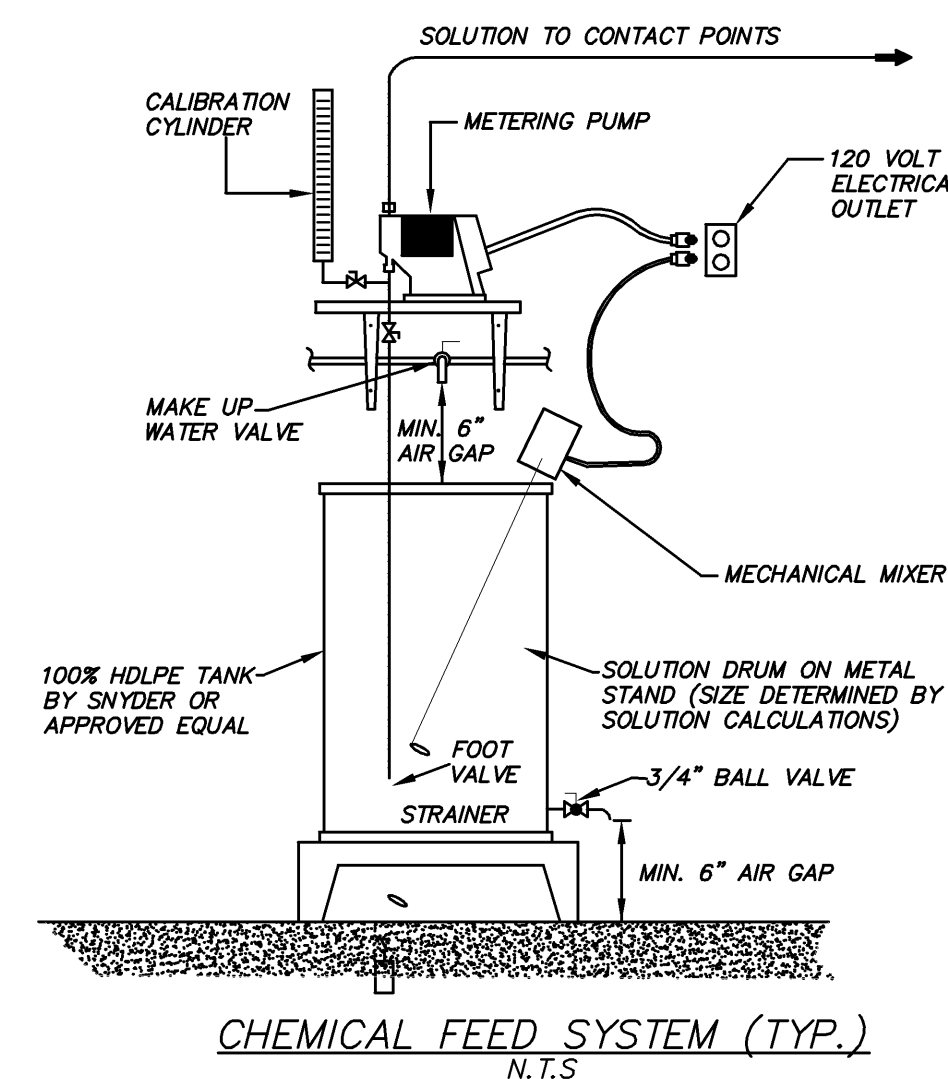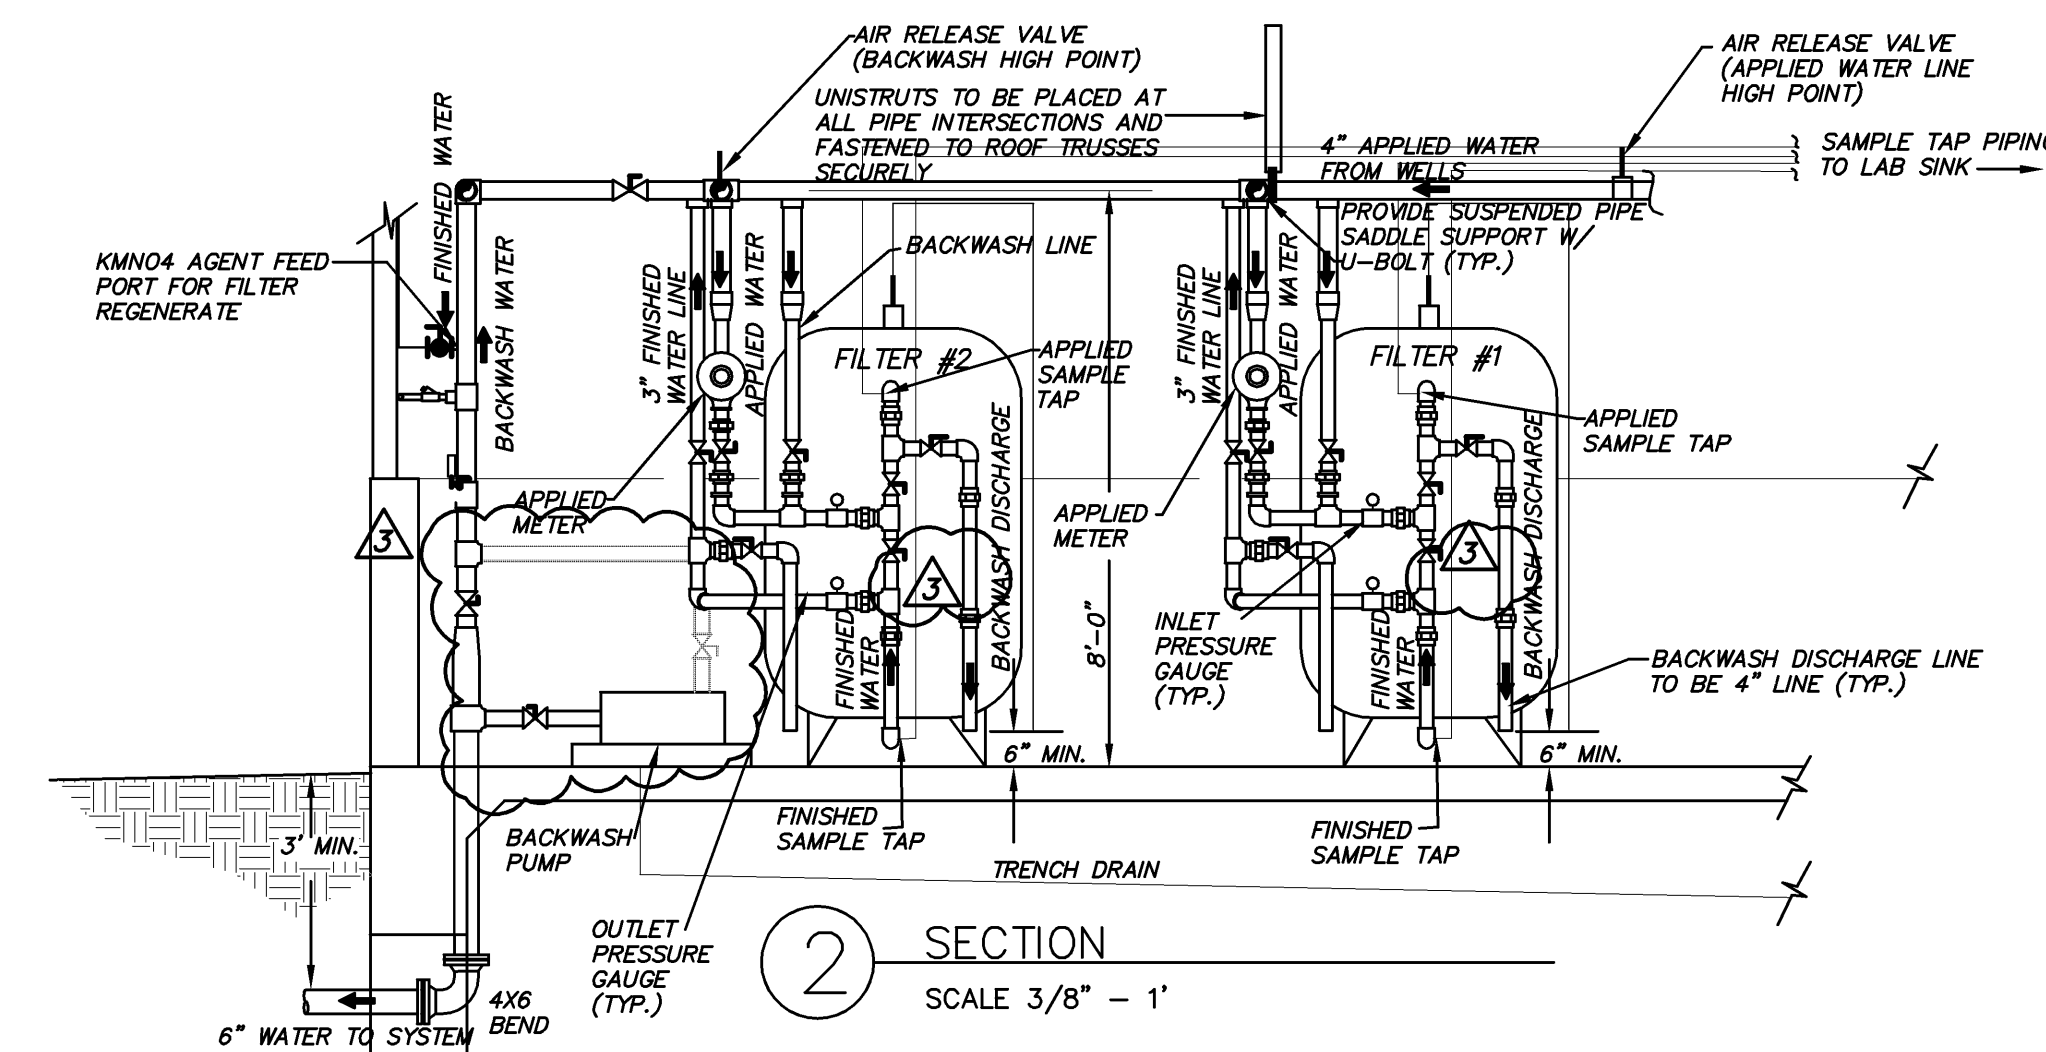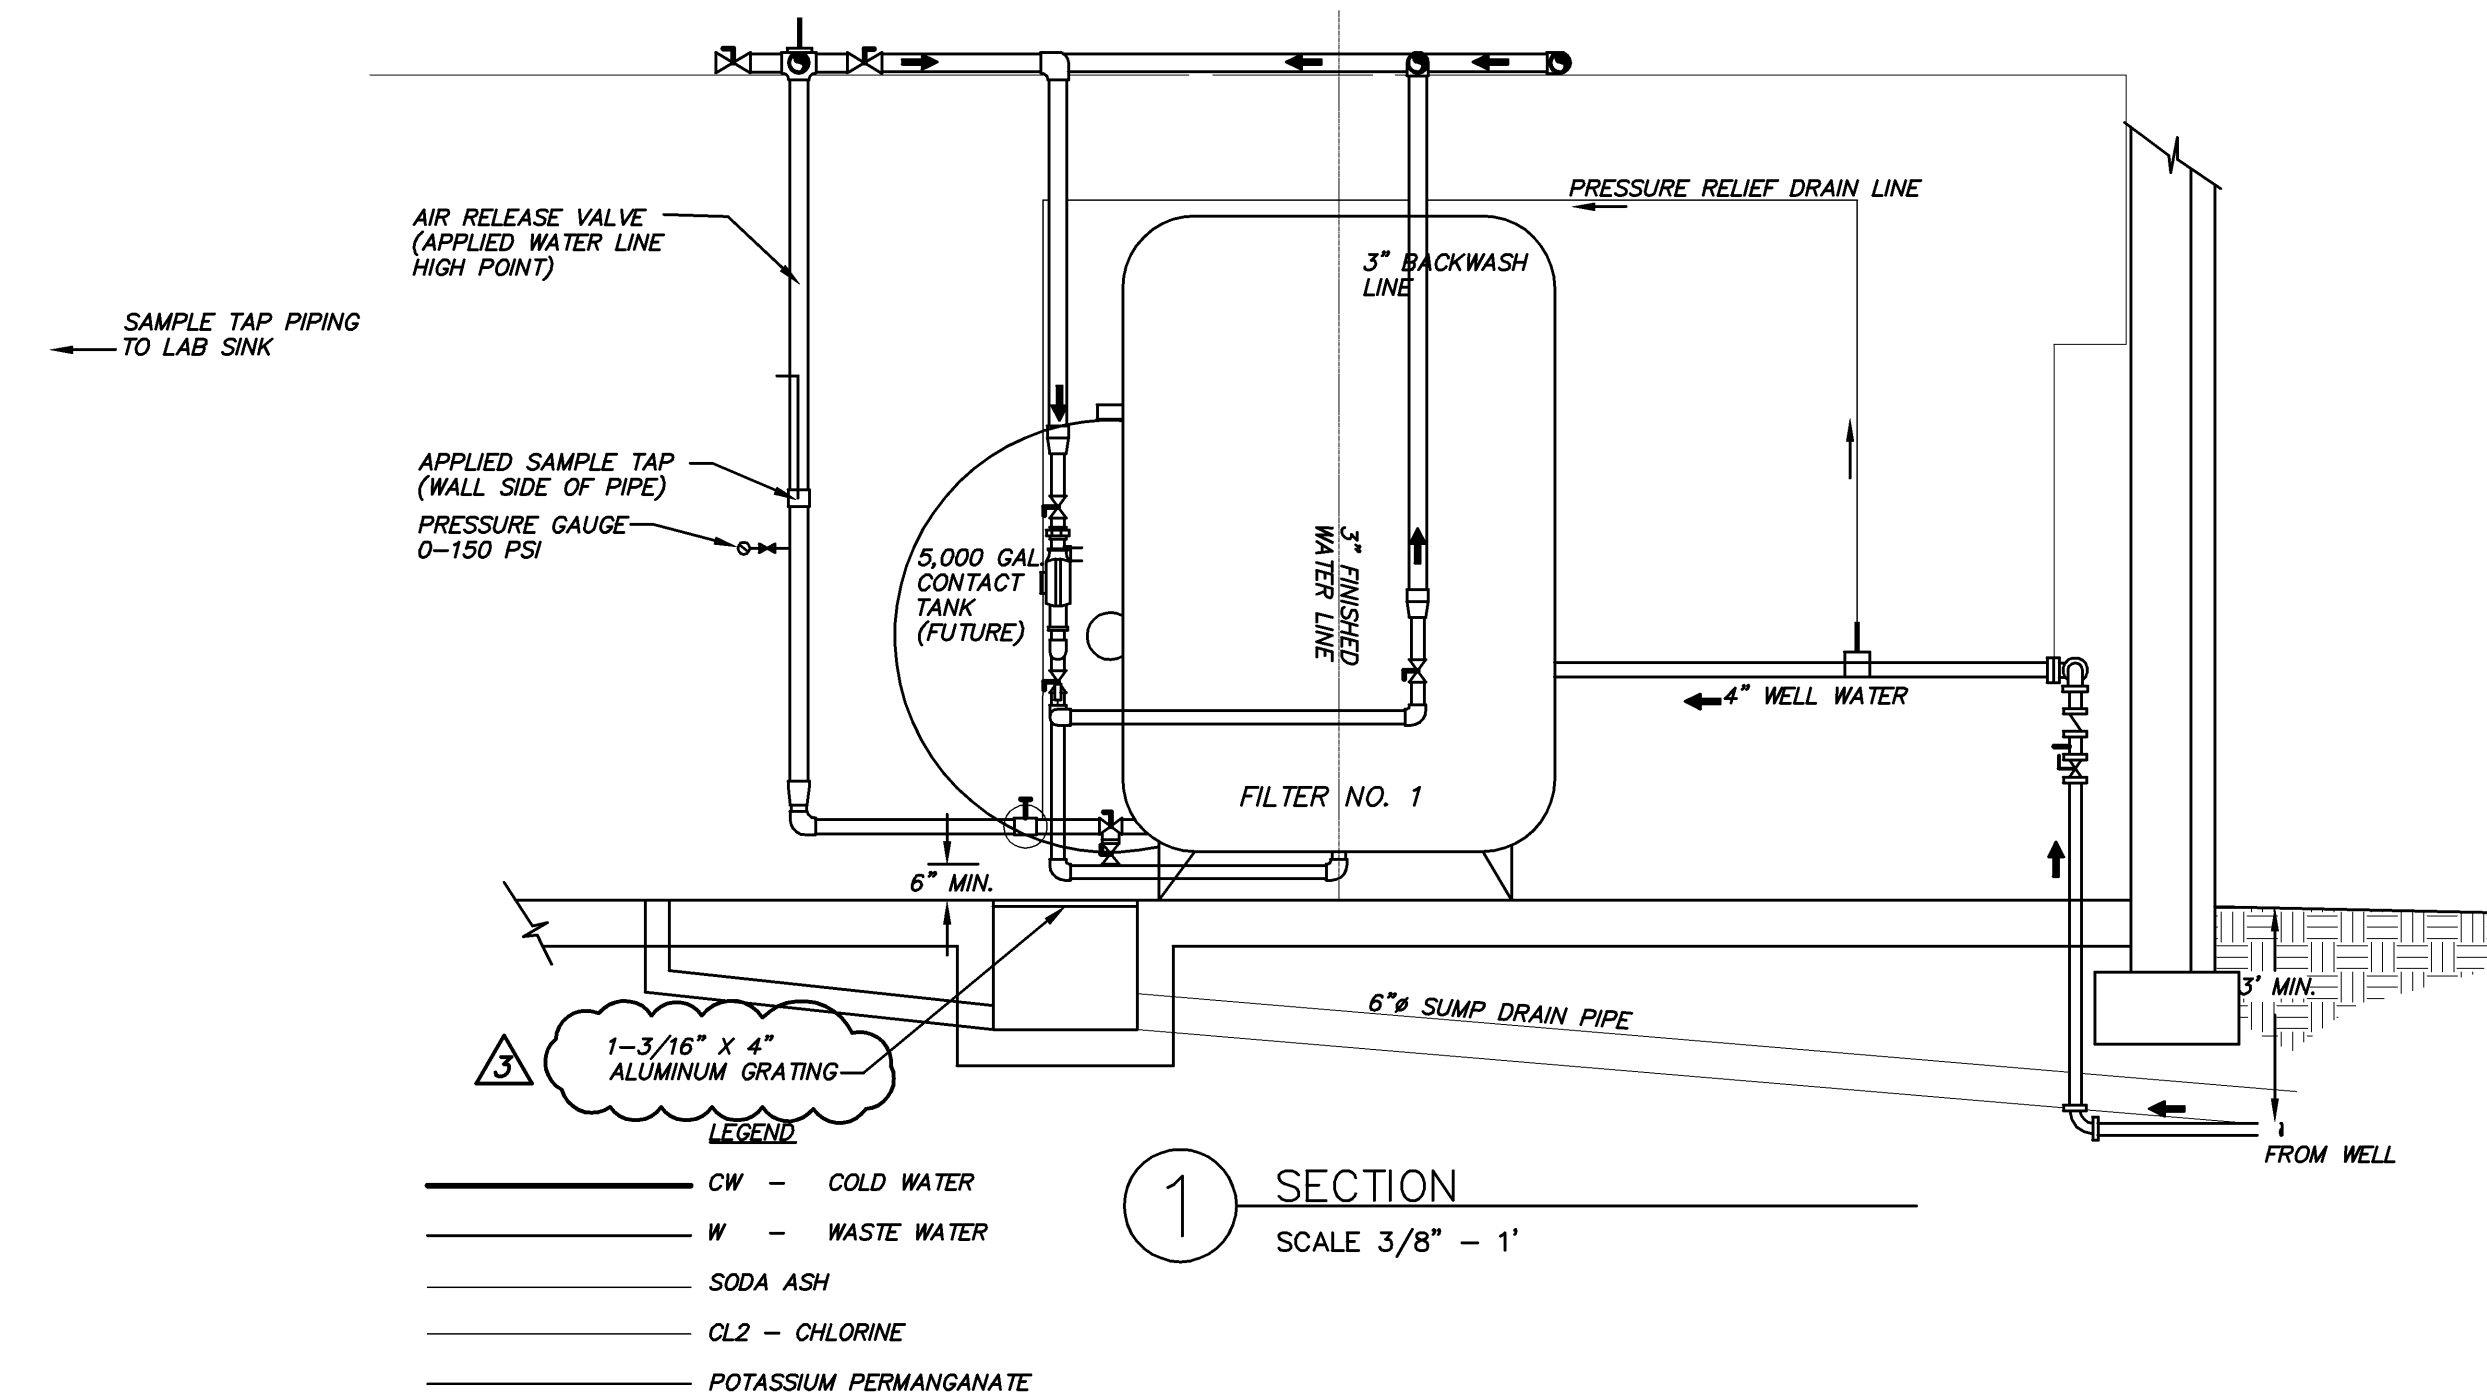


1	8/28/09	VDH/OWNER COMMENTS
2	9/3/09	VDH/OWNER COMMENTS
3	10/7/09	ADDENDUM #2
4	11/17/09	FRANKLIN COUNTY COMMENTS
5	3/14/12	ASBUILTS



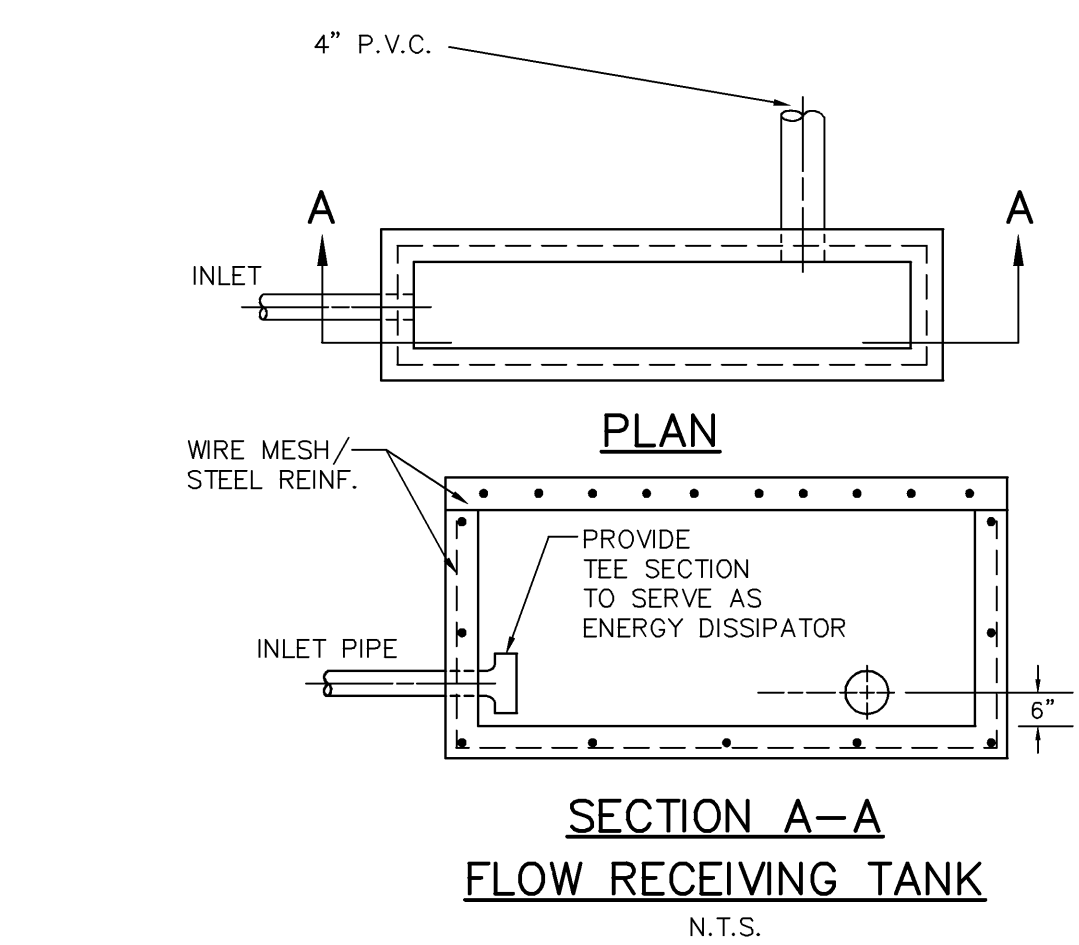

TANKS MUST BE CONSTRUCTED USING A CONCRETE MIXTURE THAT ACHIEVES A FINAL COMPRESSIVE STRENGTH OF NO LESS THAN 3,000 PSI IN A 28 DAY CURING PERIOD.

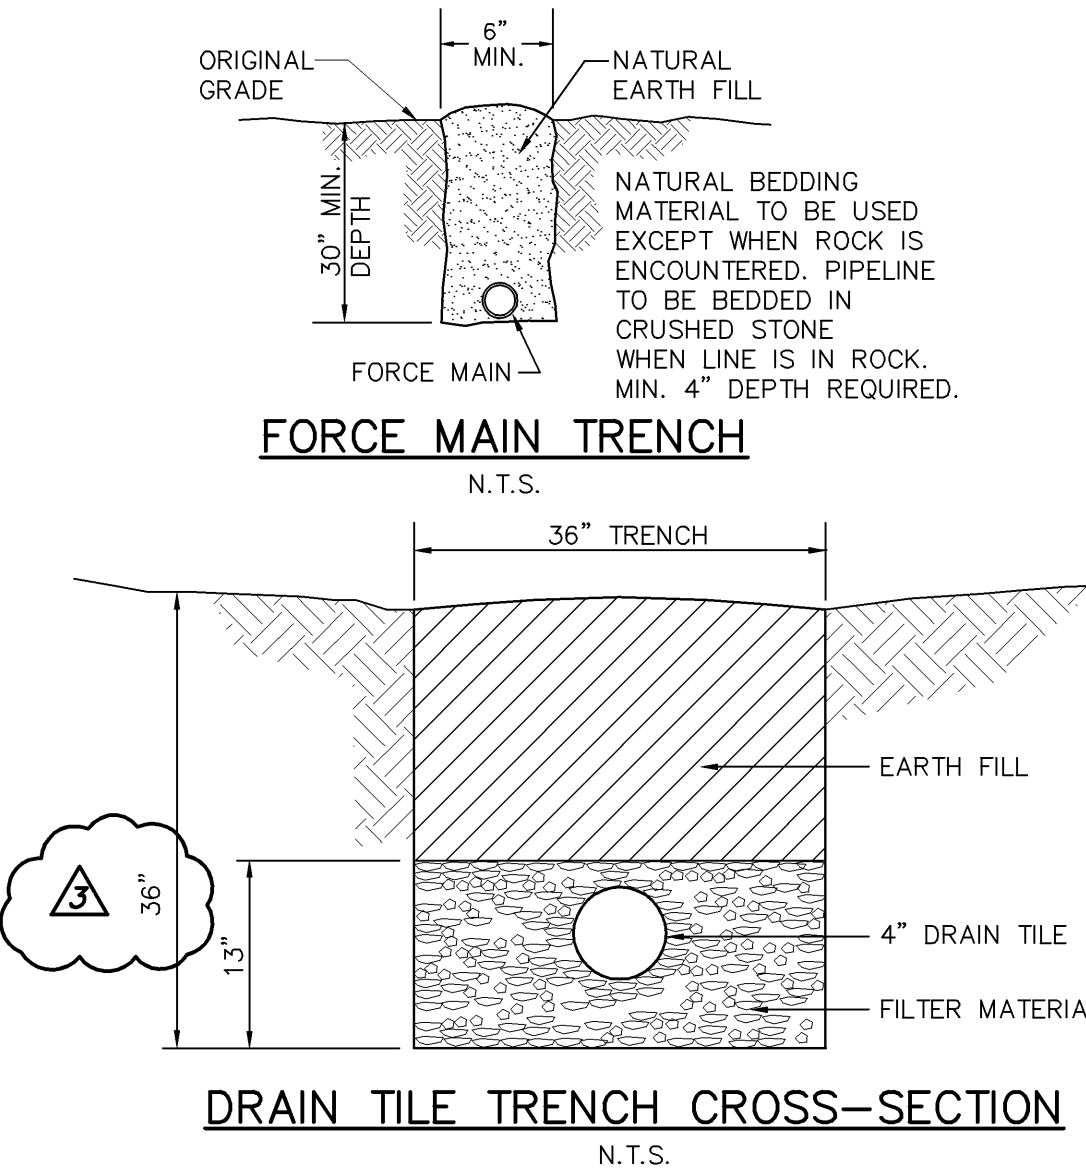

#### EFFLUENT PUMP:

THE EFFLUENT PUMP SHALL BE EQUAL TO GOULDS SUBMERSIBLE EFFLUENT PUMP MODEL 3885 - WE0511H CAPABLE OF DELIVERING 45 GALLONS PER MINUTE AGAINST A TOTAL DYNAMIC HEAD OF 20 FEET. THE MOTOR SHALL BE SINGLE PHASE, 115 VOLTS, 3,450 R.P.M., 1/2 H.P.

#### CONTROL PANEL:

THE CONTROL PANEL SHALL BE AN ORENCO MVP-S2 SERIES OR AQUAWORX BY INFILTRATOR OR EQUIVALENT. THE TIMER SHALL BE SET TO OPERATE THE PUMP FOR APPROX. 13.5 MINUTES (PUMPING 602 GAL. PER CYCLE @ 45 GPM) THE PUMP SHALL OPERATE 2 TIMES PER DAY (TOTAL RUN TIME OF 27 MIN. PER DAY), TOTAL PUMPED PER DAY IS 1204 GALLONS. A FLOAT SHALL BE SET 1" BELOW THE 'PUMP OFF' POSITION TO DEACTIVATE THE PUMP, SHOULD THE TIMER MALFUNCTION OR THE EFFLUENT LEVEL DROP TOO LOW. A SINGLE FLOAT SET AT THE 'ALARM ON' POSITION SHALL ACTIVATE THE ALARM. THE TIMER SHALL AUTOMATICALLY RESET TO NORMAL OPERATION WHEN LIQUID LEVELS RETURN TO NORMAL LEVELS.



#### PIPING & VALVE:

ALL PIPING WITHIN THE PUMP STATION SHALL BE SCHEDULE 40 P.V.C. WITH FITTINGS. THE FORCE MAIN SHALL HAVE A LIFT-OUT ADAPTER PLACED JUST BEYOND THE 90° ELBOW ON THE RISER PIPE. ON THE OUTLET SIDE OF THE ADAPTER SHALL BE A 2" CHECK VALVE. THE CHECK VALVE SHALL BE GOULDS MODEL A9-2L. THE P.V.C. FORCE MAIN SHALL BE SCHEDULE 40 WITH PRESSURE RATED JOINTS. ALL FORCE MAIN PIPING SHALL BE 2" DIAMETER. THE LIFT-OUT ADAPTER SHALL BE GOULDS MODEL AF-20. THE CONTRACTOR SHALL PROVIDE CONCRETE ANCHOR BLOCKS AT ALL BENDS IN FORCE MAIN.

#### PUMP STATION CHAMBER & FLOW RECEIVING TANK:

THE PUMP STATION CHAMBER SHALL BE A 2,000 GALLON SEPTIC TANK WITH A 36" DIAMETER CONCRETE PIPE SET OVER ONE ACCESS HOLE. THE 36" DIAMETER ACCESS SHALL HAVE A FITTED ALUM. TOP SET ON THE PIPE. THE FLOW RECEIVING TANK SHALL BE A STANDARD DISTRIBUTION BOX WITH ONLY AN INLET AND OUTLET PORT OPENED. ALL ELECTRICAL CONNECTIONS SHALL BE MADE IN A GOULDS JUNCTION BOX, MODEL 8J-1J. ALL ELECTRICAL CONNECTIONS SHALL BE IN ACCORDANCE WITH ALL APPLICABLE LOCAL CODES. THE CONTRACTOR SHALL BE RESPONSIBLE FOR OBTAINING ANY BUILDING PERMITS THAT ARE APPLICABLE. THE ALUM. OR CONC. TOP SHALL HAVE A FITTED RING ANCHORED TO THE END OF THE CONC. ENTRY TUBE. THE TOP SHALL BE REMOVABLE WITH A LOCK ASSEMBLY PROVIDED.

\*THIS IS NOT A PERMIT.  
REFER TO PERMIT DRAWING (BY OTHERS) FOR COMPLETE DRAINFIELD LOCATIONS DIMMENSIONS AND SPECIFICATIONS.

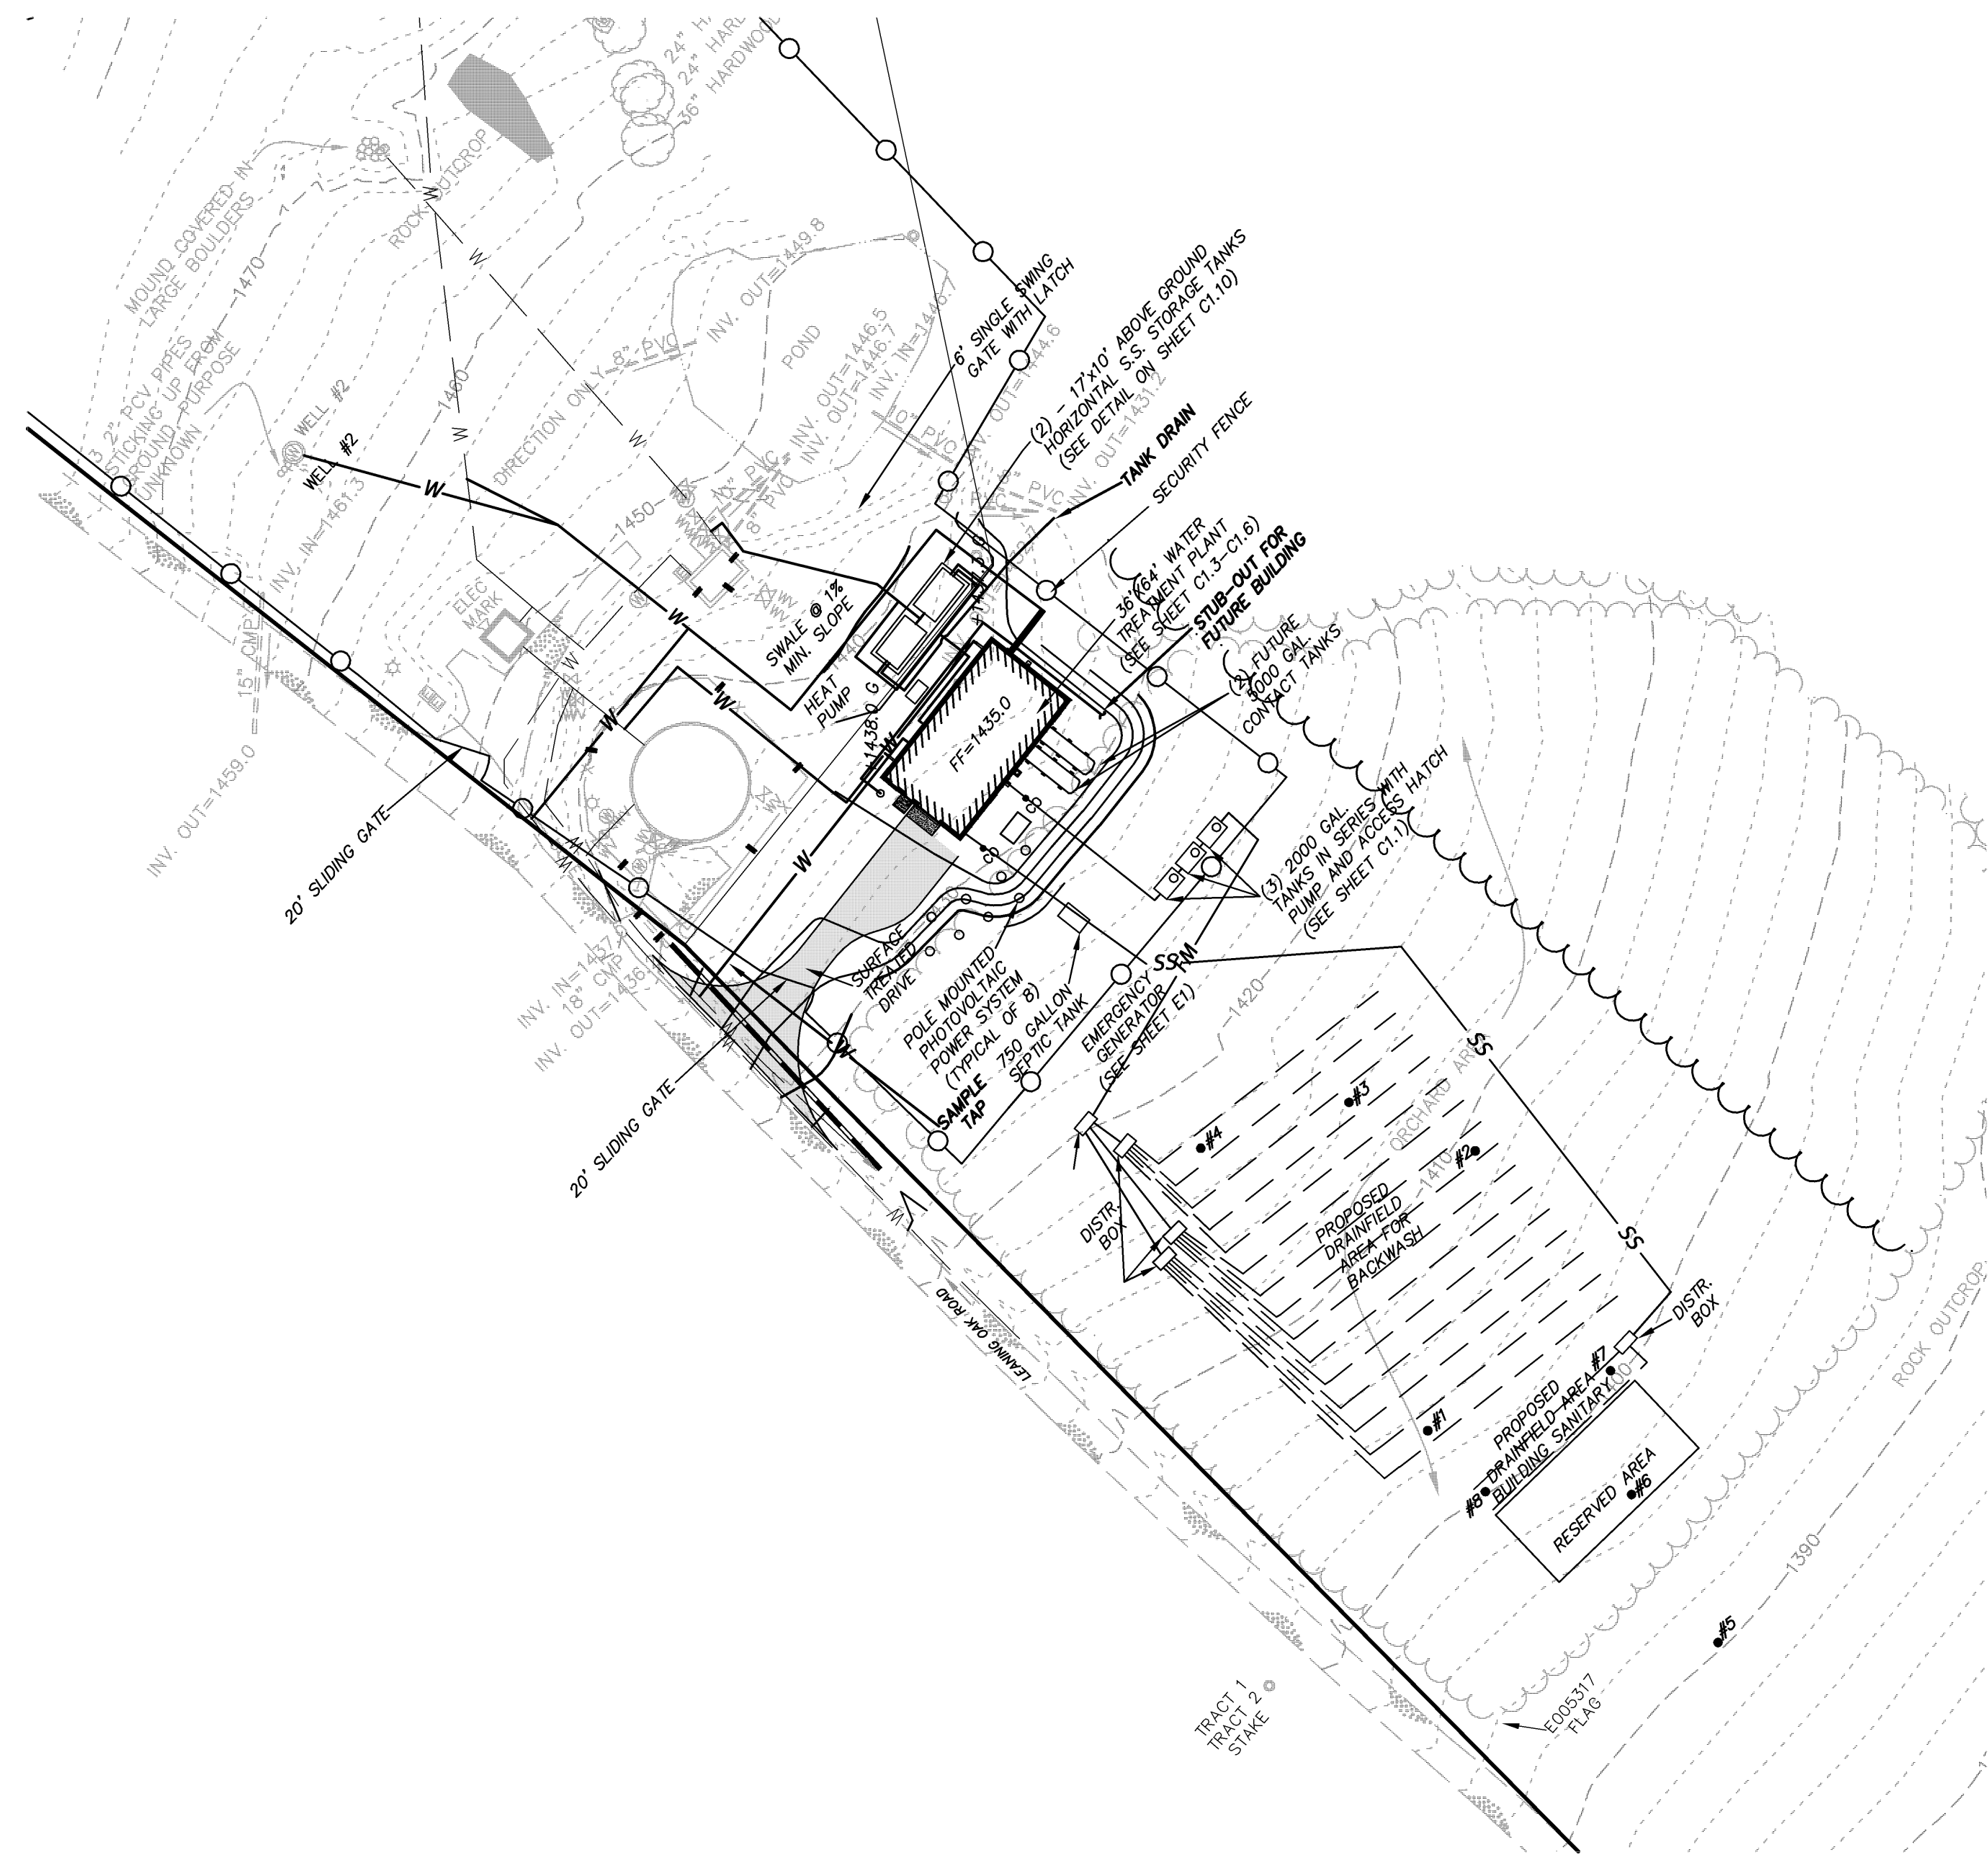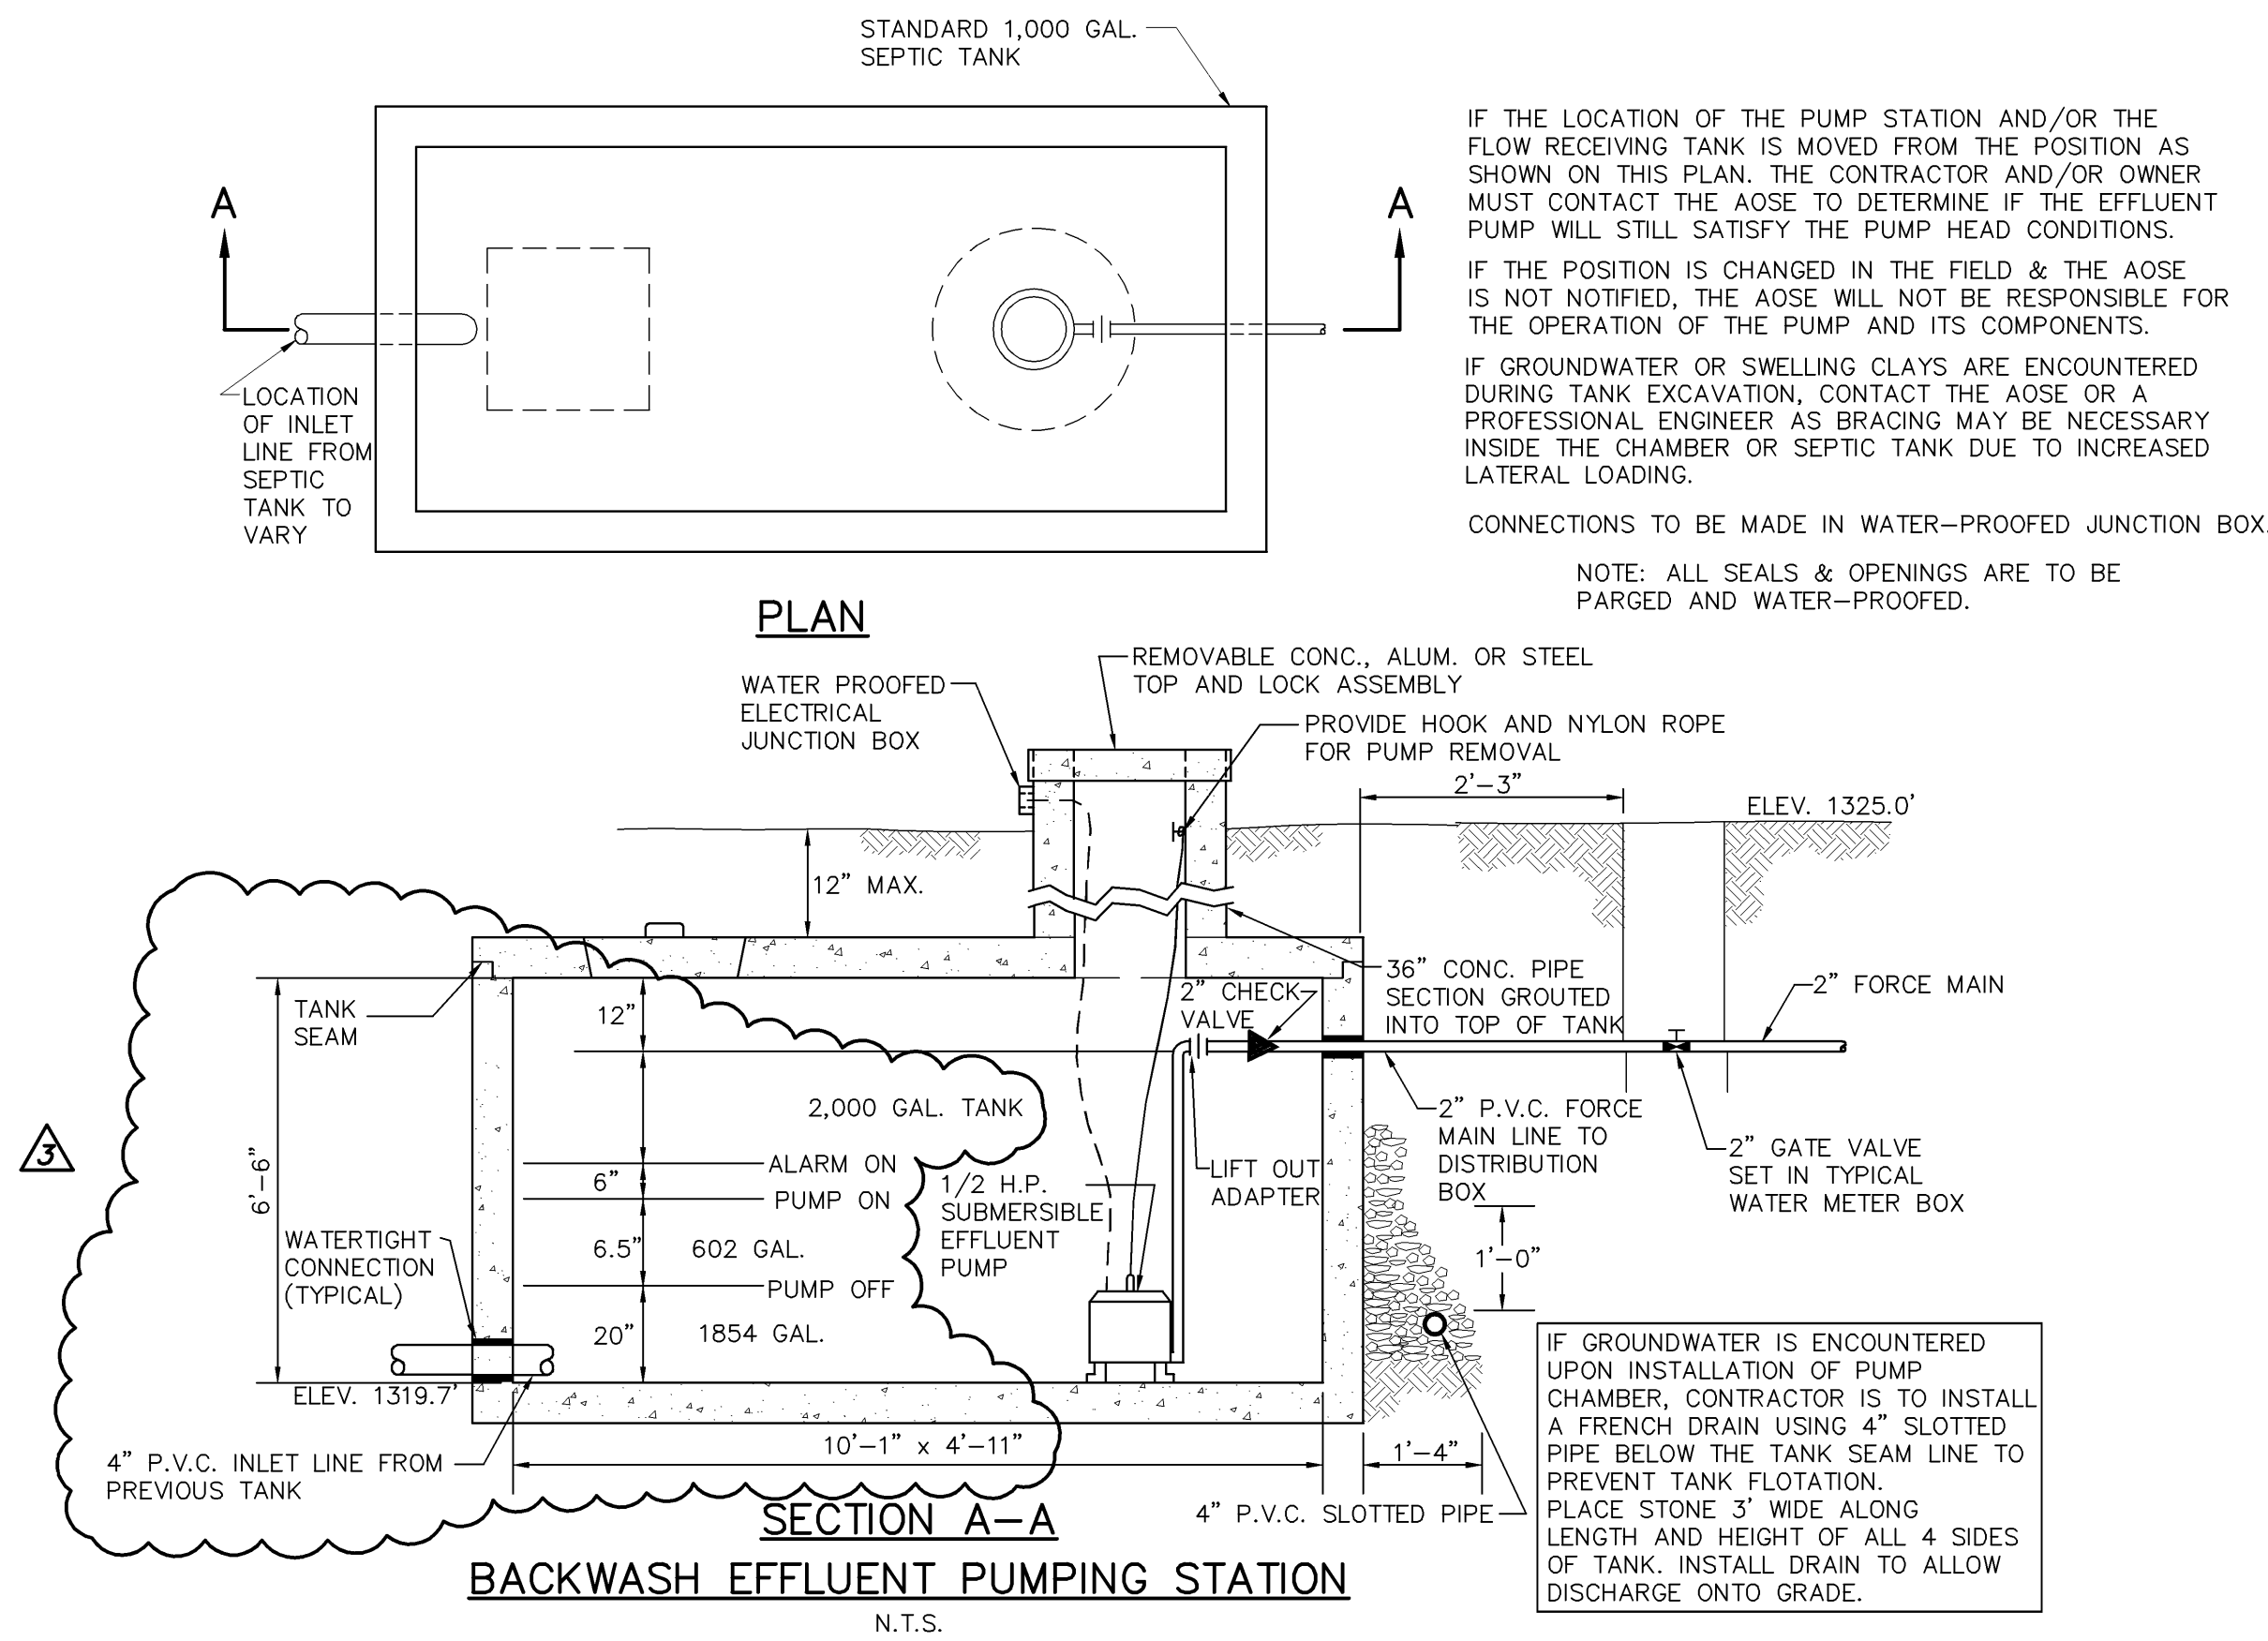

1	8/28/09	VDH/OWNER COMMENTS
2	9/3/09	VDH/OWNER COMMENTS
3	10/7/09	ADDENDUM #2
4	11/17/09	FRANKLIN COUNTY COMMENTS
5	3/14/12	ASBUILTS

\*ENGINEERING >> SURVEYING >> PLANNING





**HURT & PROFFITT**  
INCORPORATED  
2524 LANGHORNE ROAD  
LYNCHBURG VA 24501  
800.242.4906 TOLL FREE  
434.847.0047 FAX

## EFFLUENT PUMP PLAN DETAILS-ASBUILT FOR TOWN OF BOONES MILL WATER SYSTEM REPLACEMENT, VOLUME 2 TOWN OF BOONES MILL, BOONE DISTRICT, FRANKLIN COUNTY, VA

PROJECT NO. 20080815  
G.L. NO. 297-03-A3.9  
FILE NO. G-12675  
DATE: 7/31/09  
DRAWN BY: ASK  
CHECKED BY: BLC


**HURT & PROFFITT**

SHEET NO.  
**C1.7**

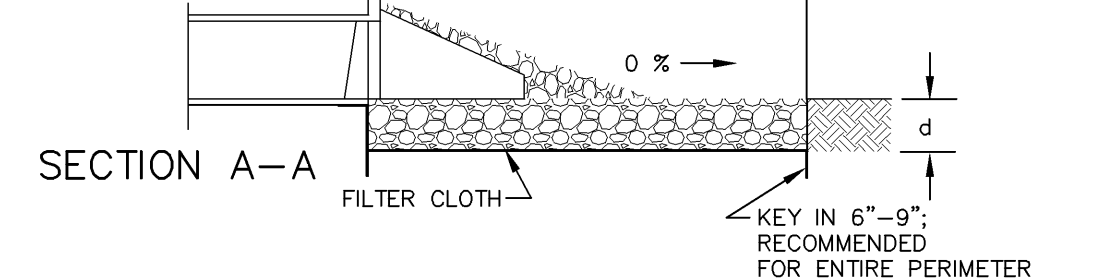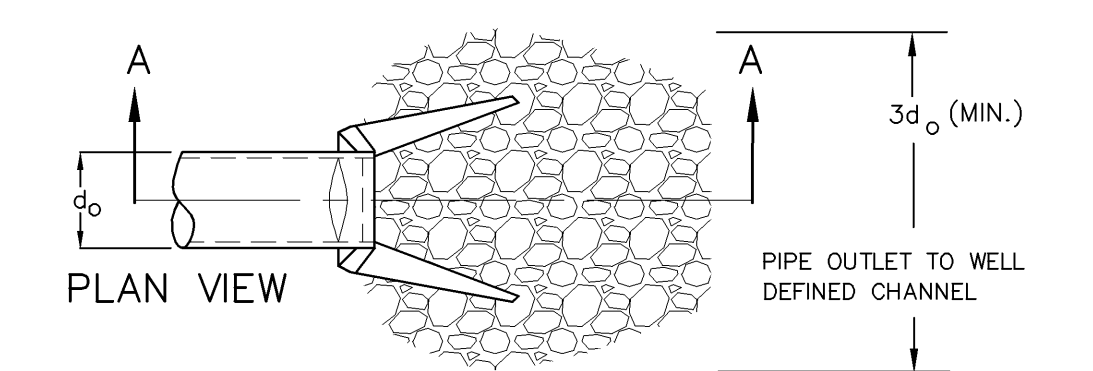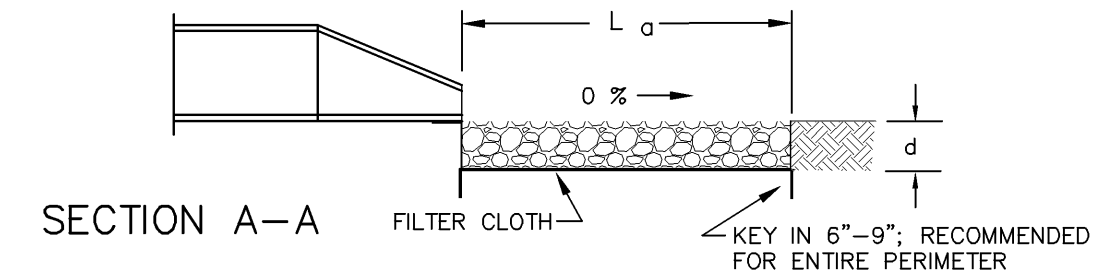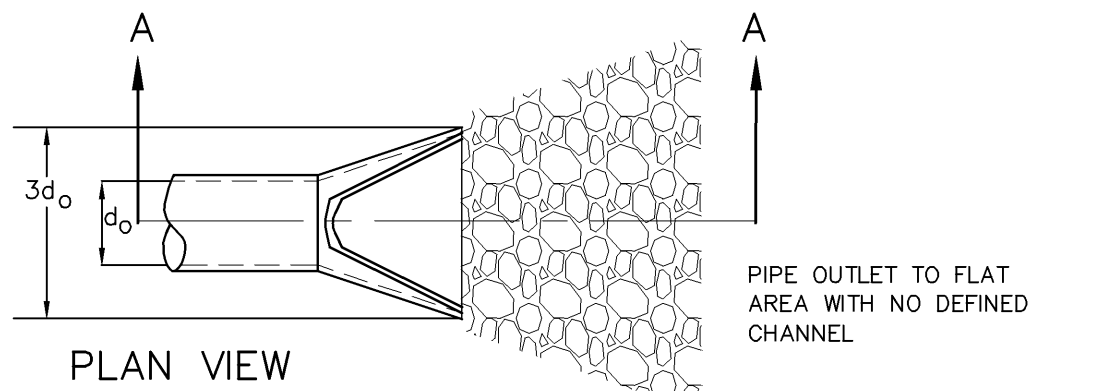


NOTES:  
1. APRON LINING MAY BE RIPRAP, GROUTED RIPRAP, GABION BASKET, OR CONCRETE.  
2. L<sub>o</sub> IS THE LENGTH OF THE RIPRAP APRON AS CALCULATED USING PLATES 3.18-3 AND 3.18-4.  
3. d = 1.5 TIMES THE MAXIMUM STONE DIAMETER, BUT NOT LESS THAN 6 INCHES.


PIPE OUTLET PROTECTION  
N.T.S.

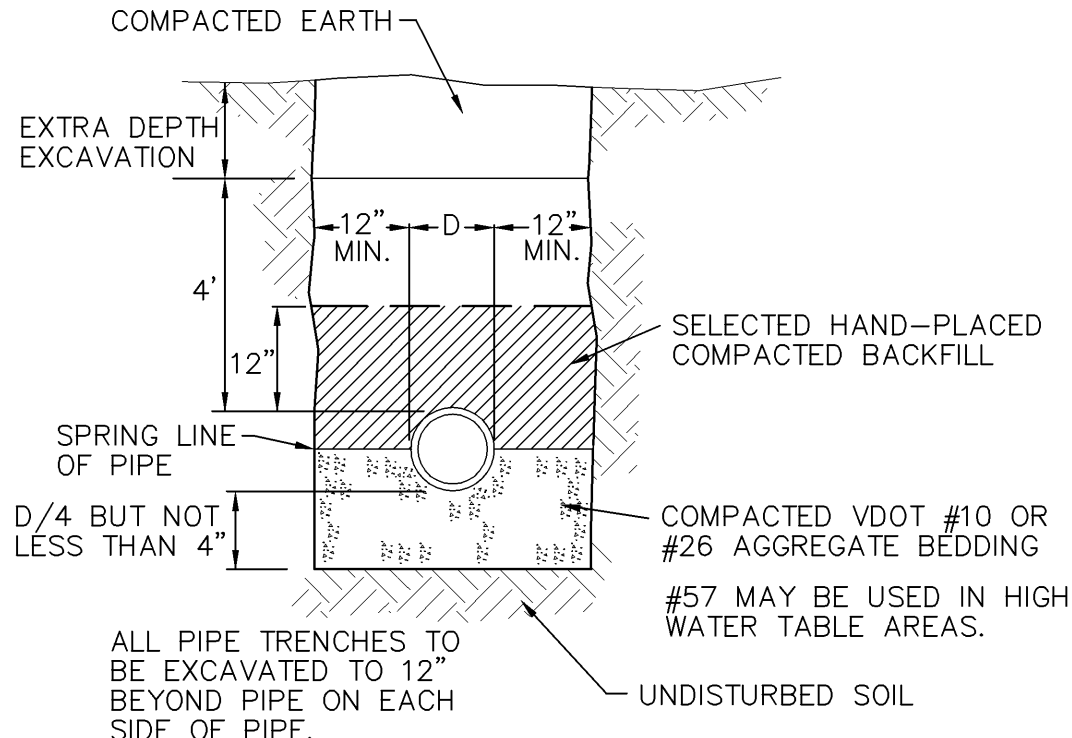

SANITARY SEWER TRENCH  
N.T.S.

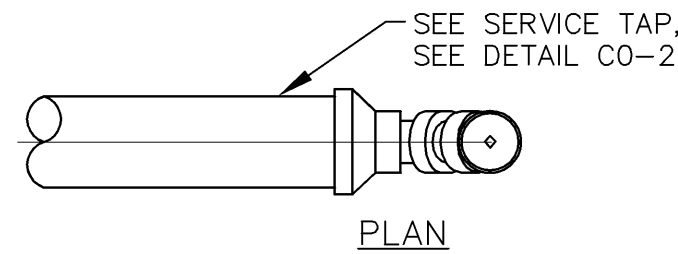

PLAN

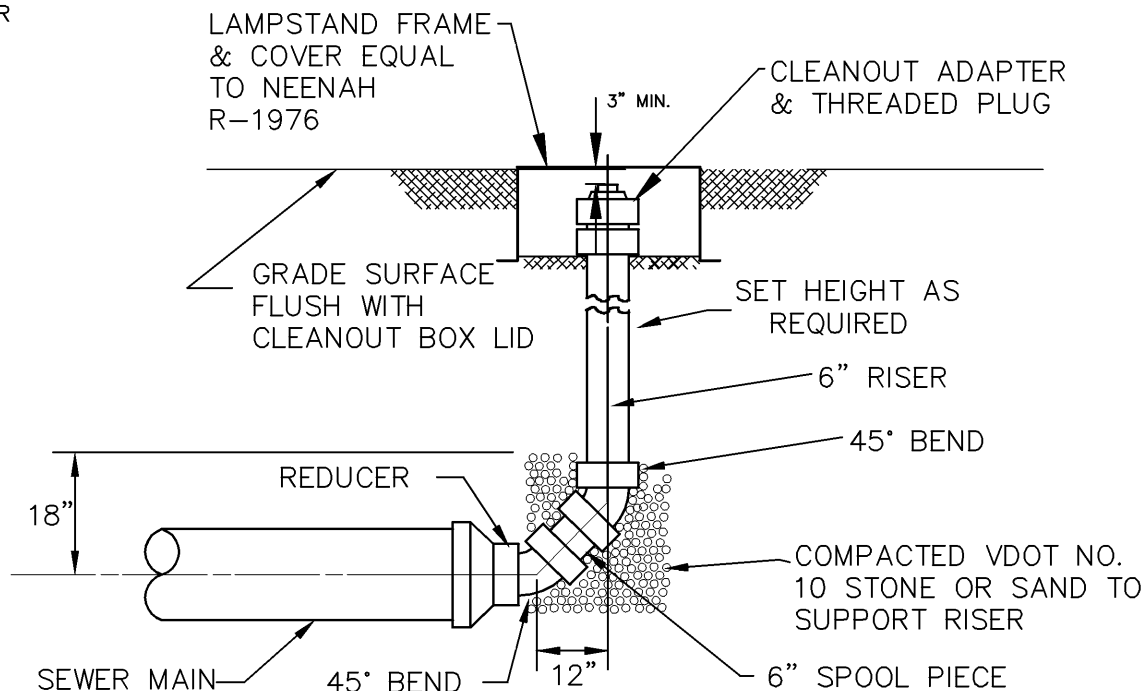


ELEVATION


FITTINGS REQUIRED FOR EACH CLEANOUT

	Ø	WYE	45° BEND	22 1/2° BEND	11 1/4° BEND	CLEANOUT ADAPT.
STRAIGHT THRU	0	0	2	0	0	1


LAMPSTAND  
SANITARY CLEANOUT TYPE I  
TERMINAL LINE CLEANOUT  
N.T.S.

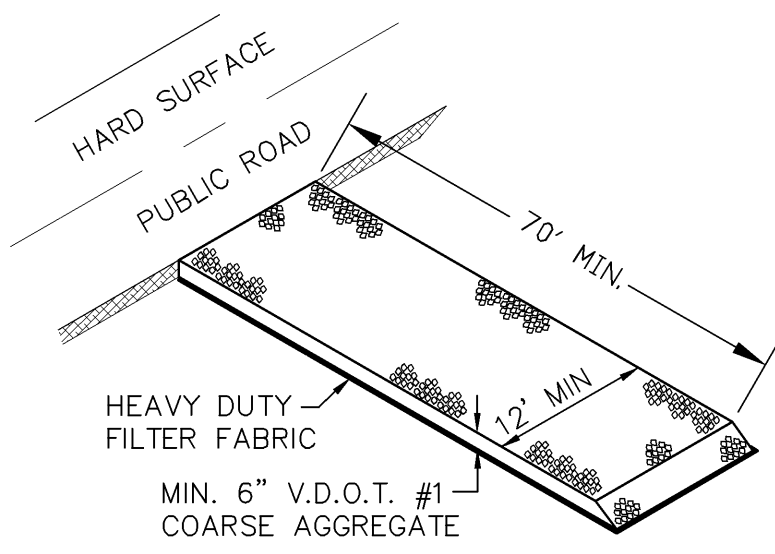


TEMPORARY  
CONSTRUCTION ENTRANCE  
N.T.S.

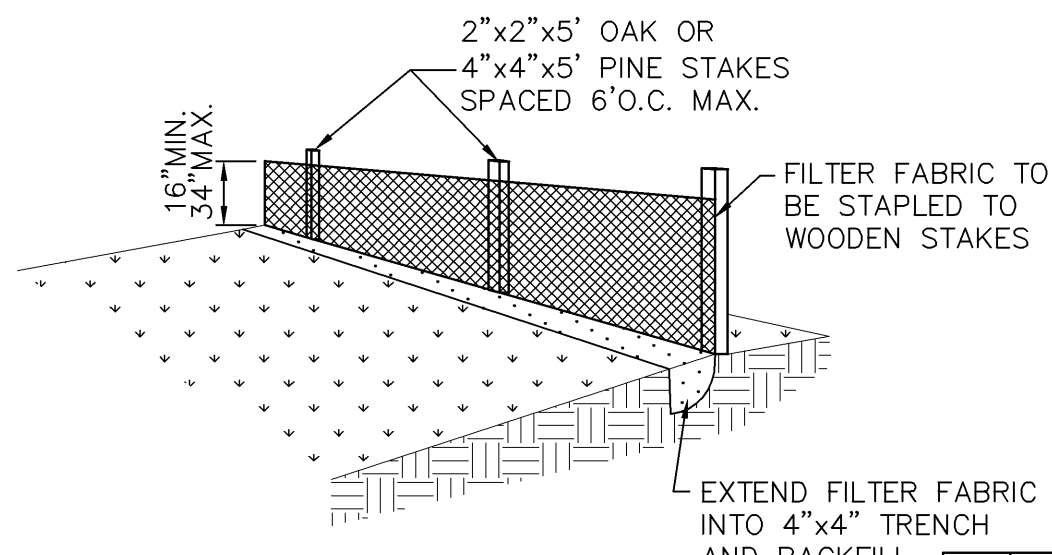


SILT FENCE  
(WITHOUT WIRE SUPPORT)  
N.T.S.

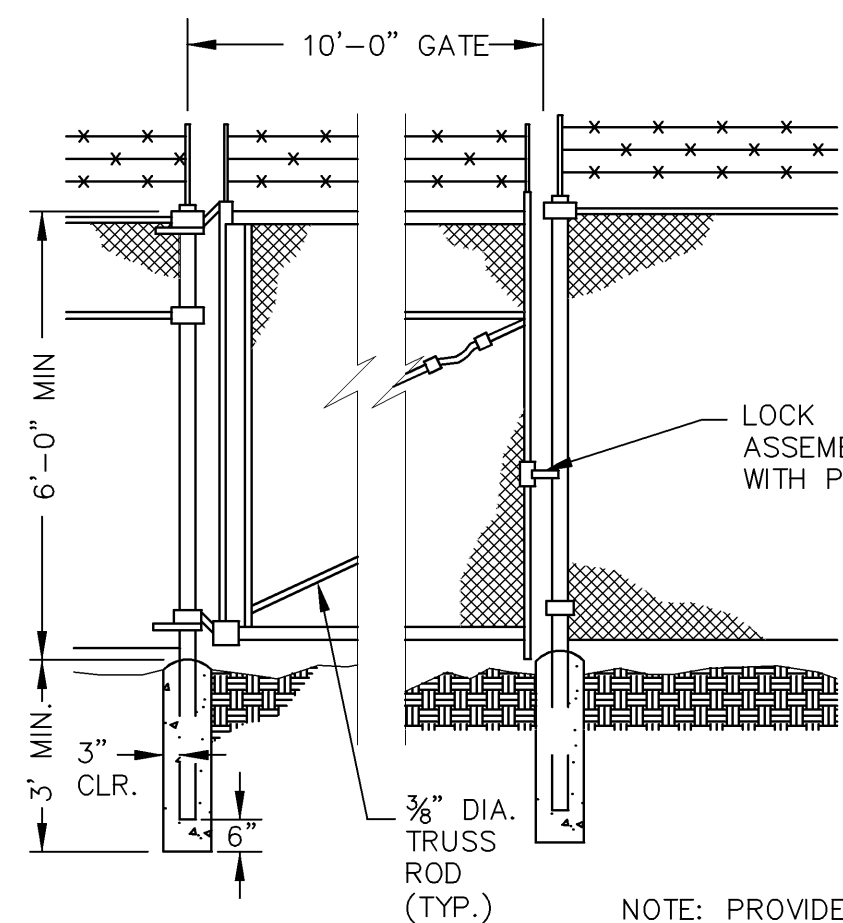

SINGLE GATE  
NOT TO SCALE  
N.T.S.

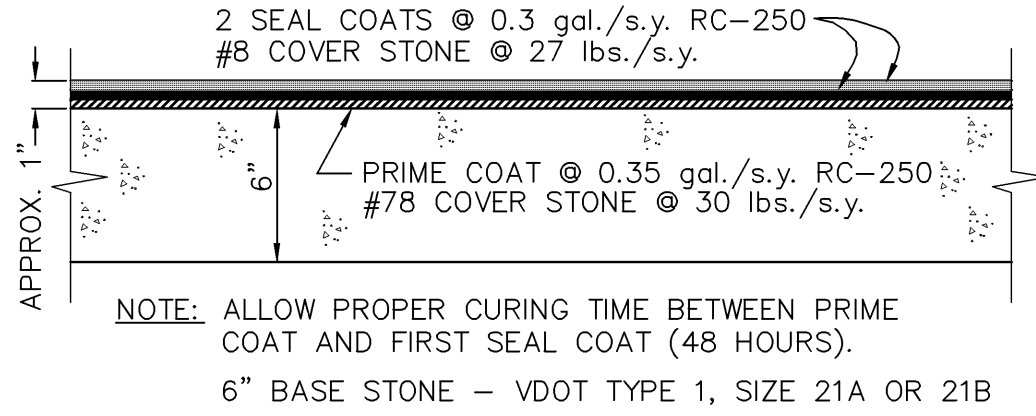

PRIME AND DOUBLE SEAL  
SURFACE TREATMENT  
N.T.S.

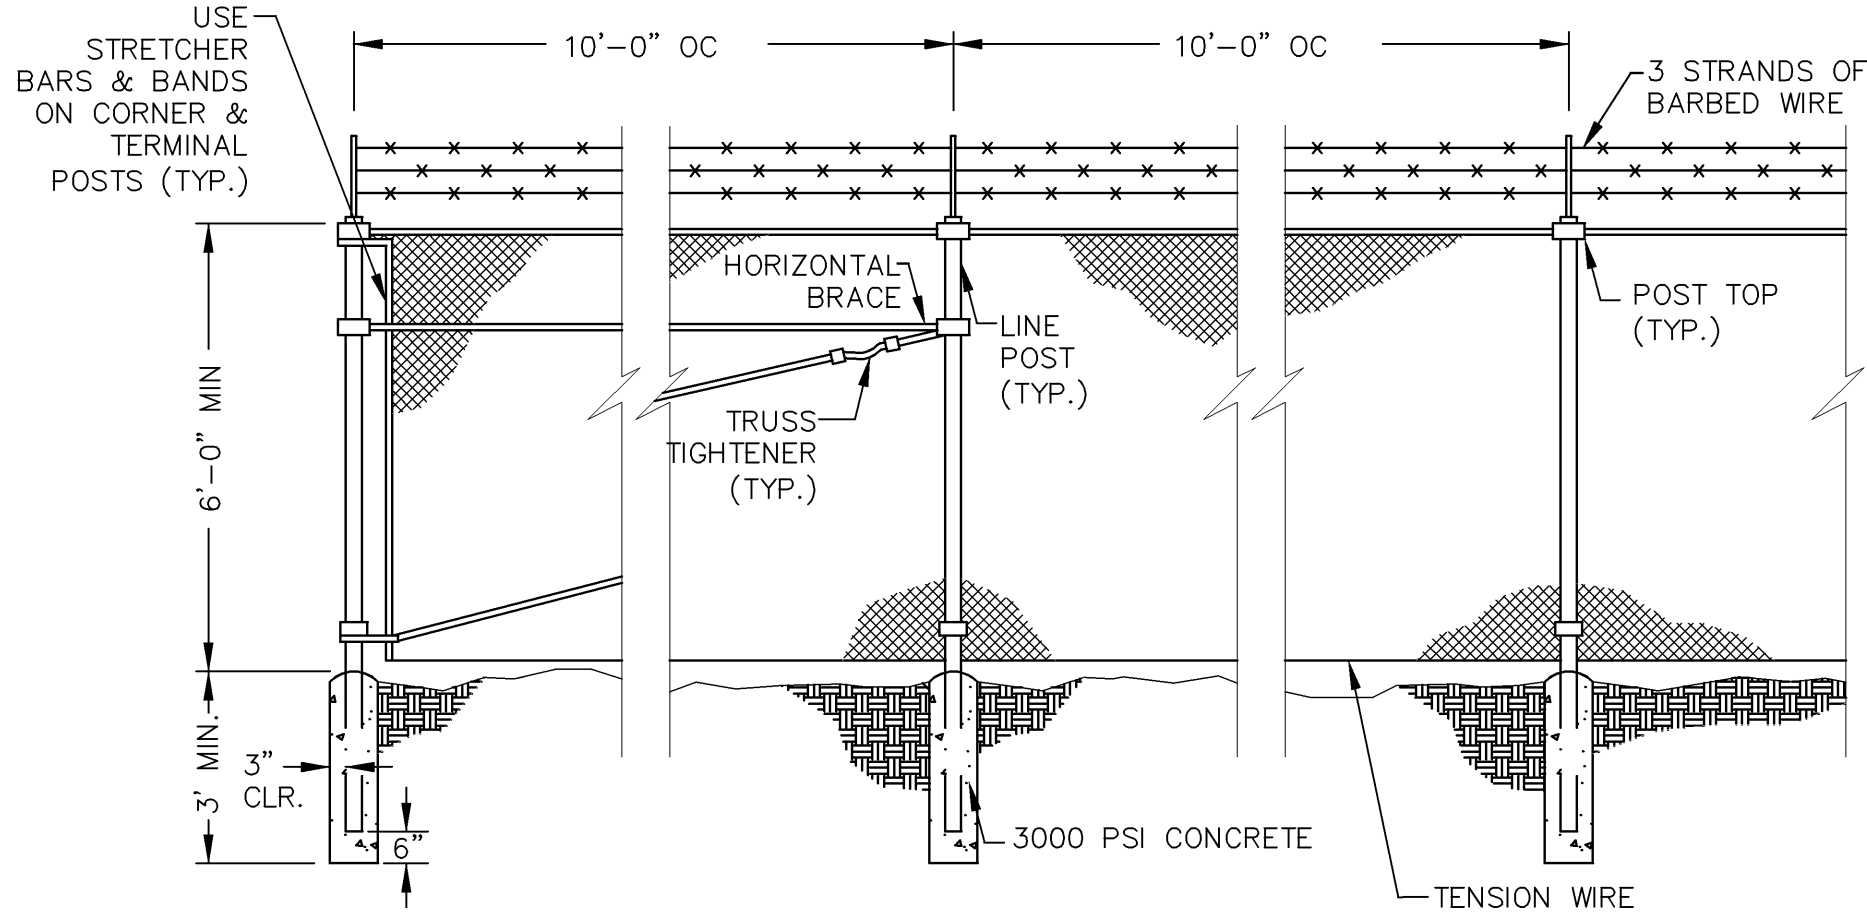

FENCE DETAIL  
NOT TO SCALE  
N.T.S.

\* ENGINEERING >> SURVEYING >> PLANNING


**HURT & PROFFITT**  
INCORPORATED  
2524 LANGHORNE ROAD  
LYNCHBURG VA 24501  
800.242.4906 TOLL FREE  
434.847.7796 MAIN  
434.847.0047 FAX

**TANK SITE DETAILS-ASBUILT**  
FOR  
**TOWN OF BOONES MILL WATER SYSTEM REPLACEMENT, VOLUME 2**  
**TOWN OF BOONES MILL, BOONE DISTRICT, FRANKLIN COUNTY, VA**

PROJECT NO.	20080815
G.L. NO.	297-03-A3.9
FILE NO.	G-12675
DATE:	7/31/09
DRAWN BY:	ASK
CHECKED BY:	BLC

**HURT & PROFFITT**





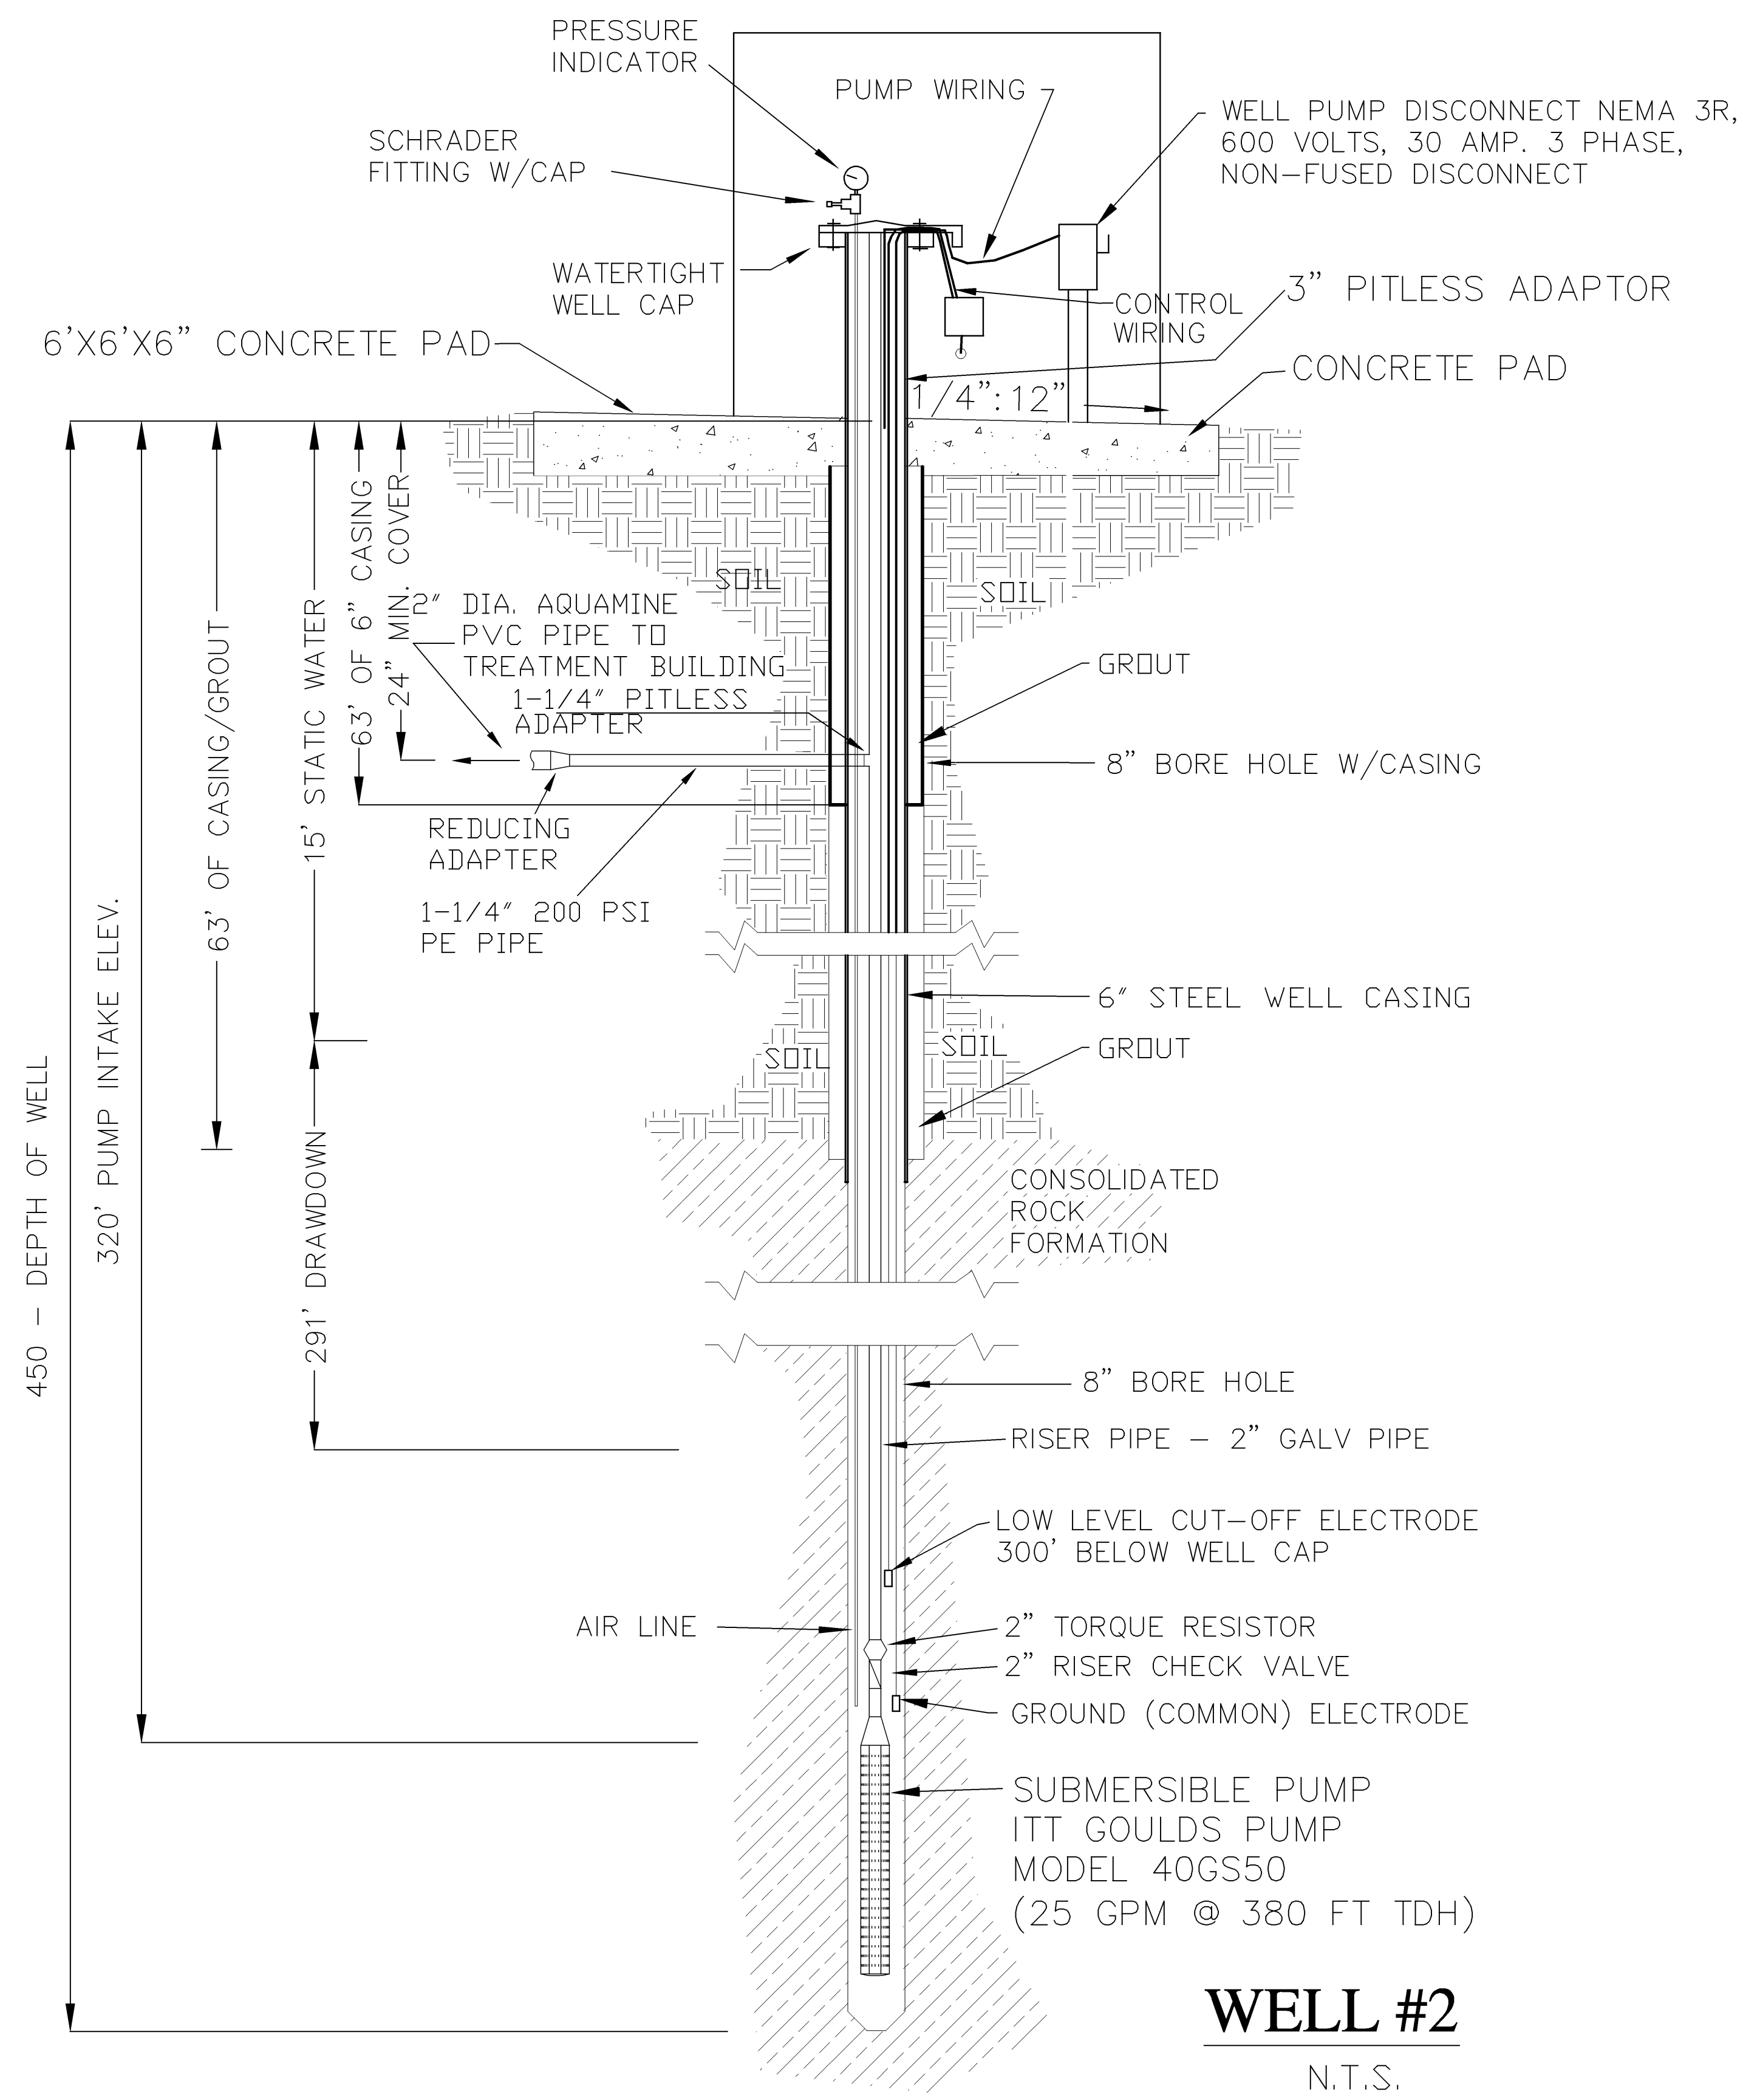

**WELL DEVELOPMENT DETAILS-ASBUILT**  
FOR  
**TOWN OF BOONES MILL WATER SYSTEM REPLACEMENT, VOLUME 2**  
**TOWN OF BOONES MILL, BOONE DISTRICT, FRANKLIN COUNTY, VA**

PROJECT NO.	20080815
G.L. NO.	297-03-A3.9
FILE NO.	G-12675
DATE:	7/31/09
DRAWN BY:	ASK
CHECKED BY:	BLC




1	8/28/09	VDH/OWNER COMMENTS
2	9/3/09	VDH/OWNER COMMENTS
4	11/17/09	FRANKLIN COUNTY COMMENTS
5	3/14/12	ASBUILTS

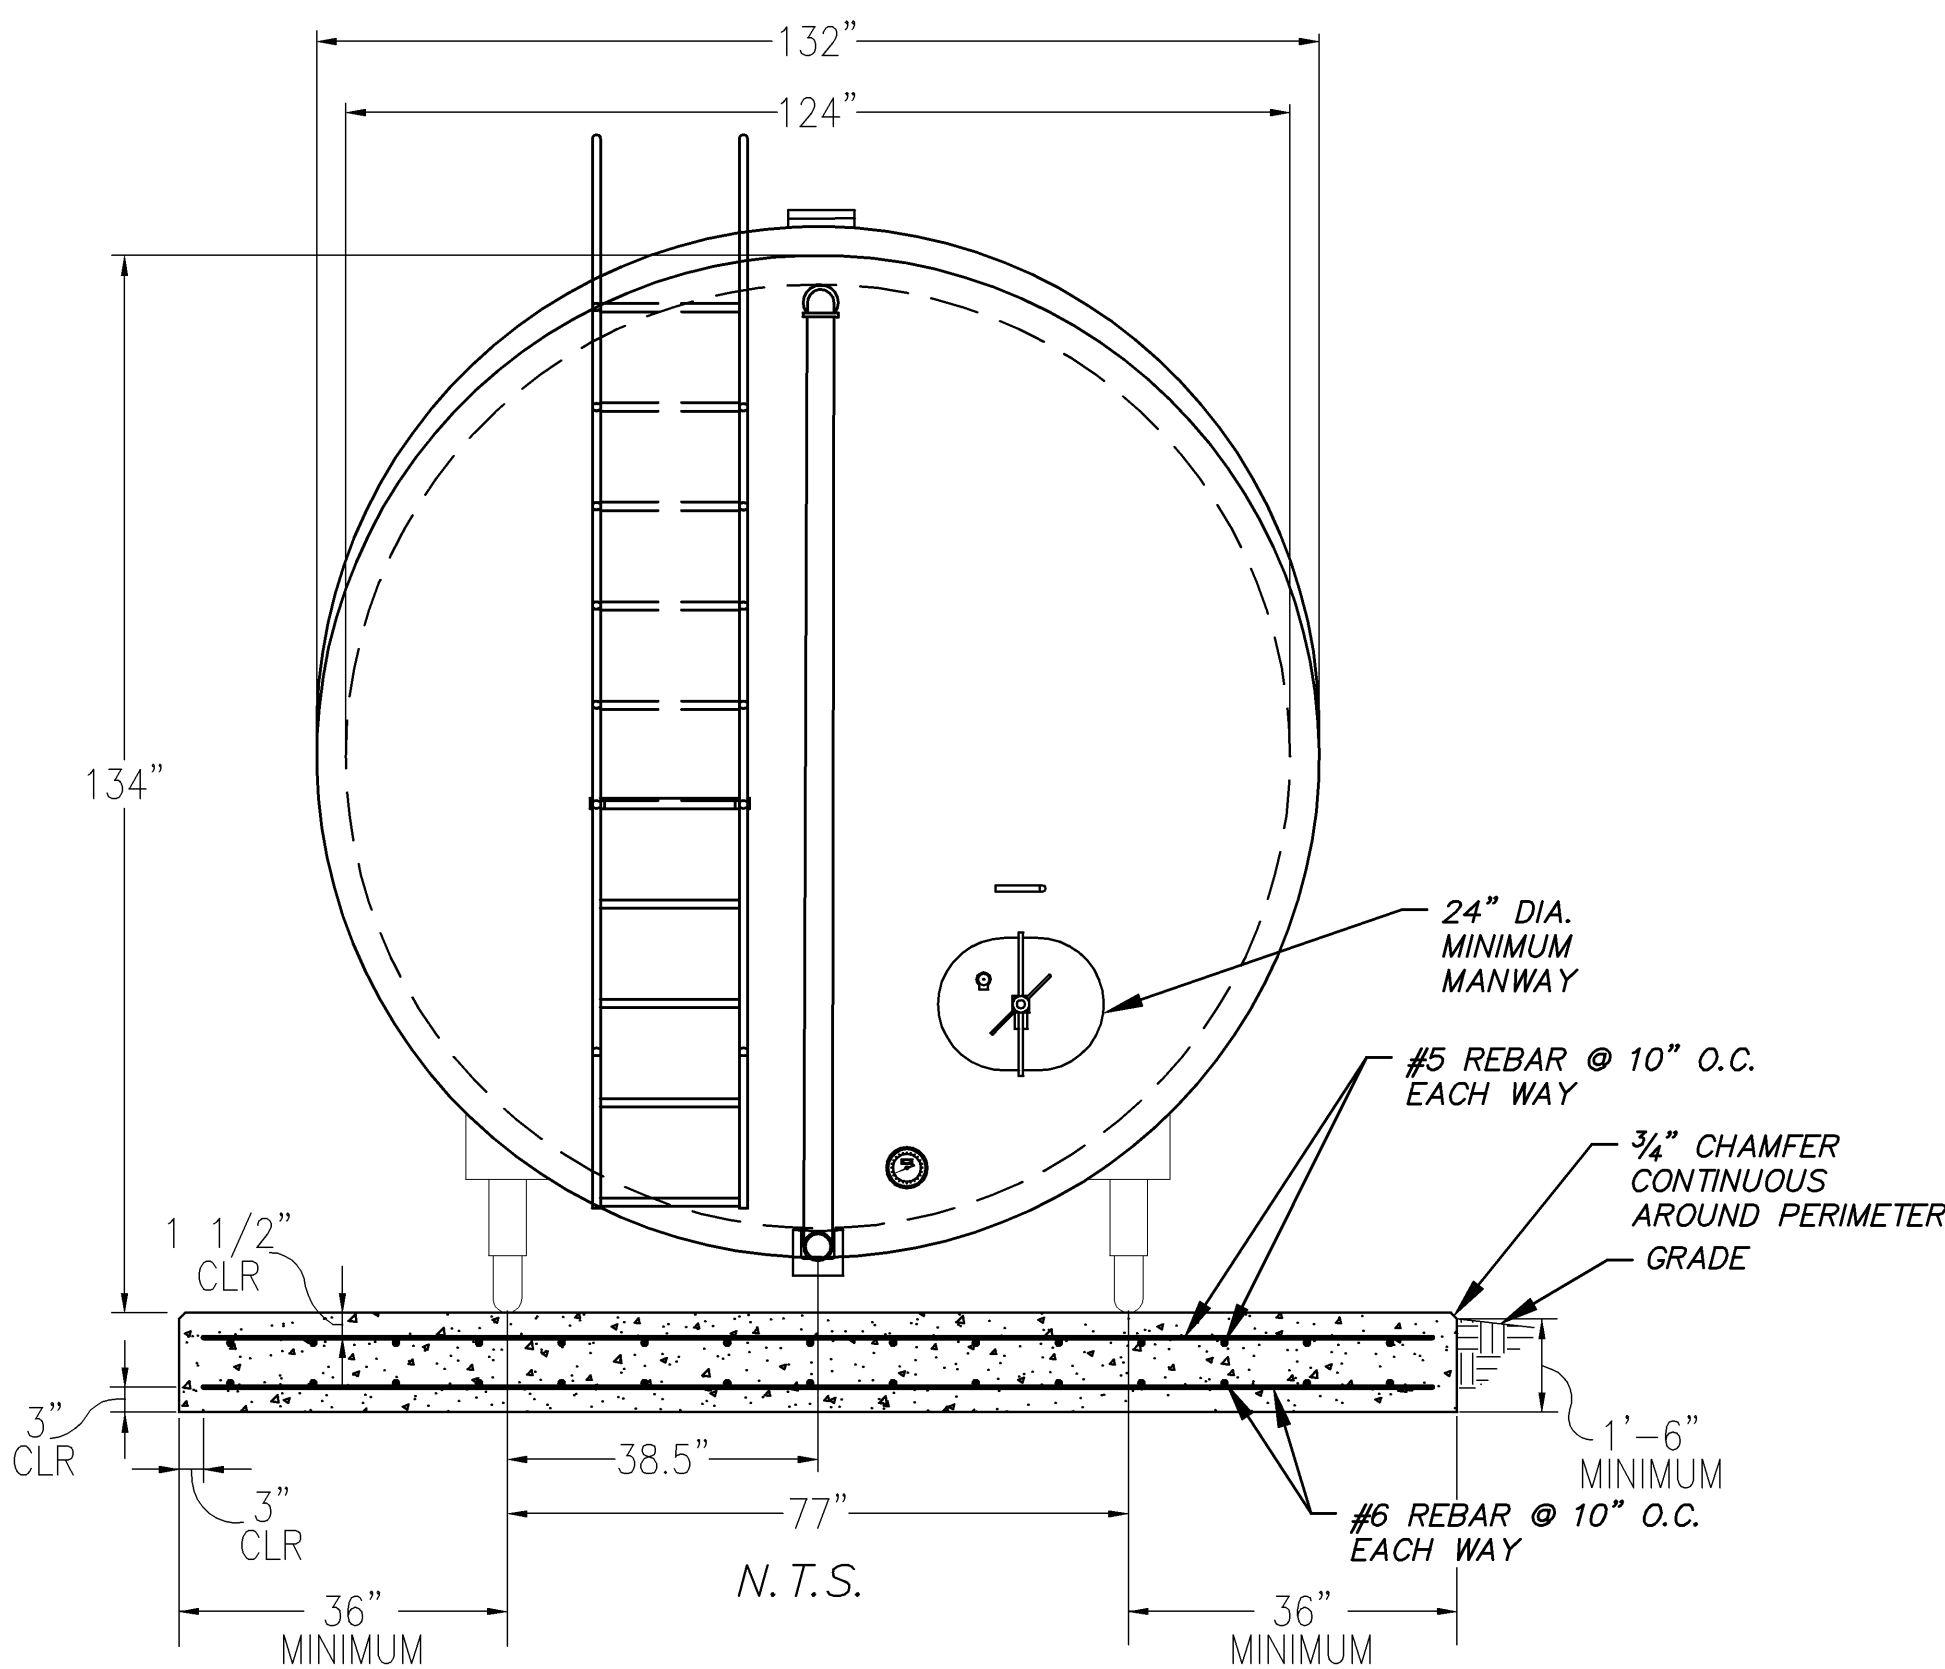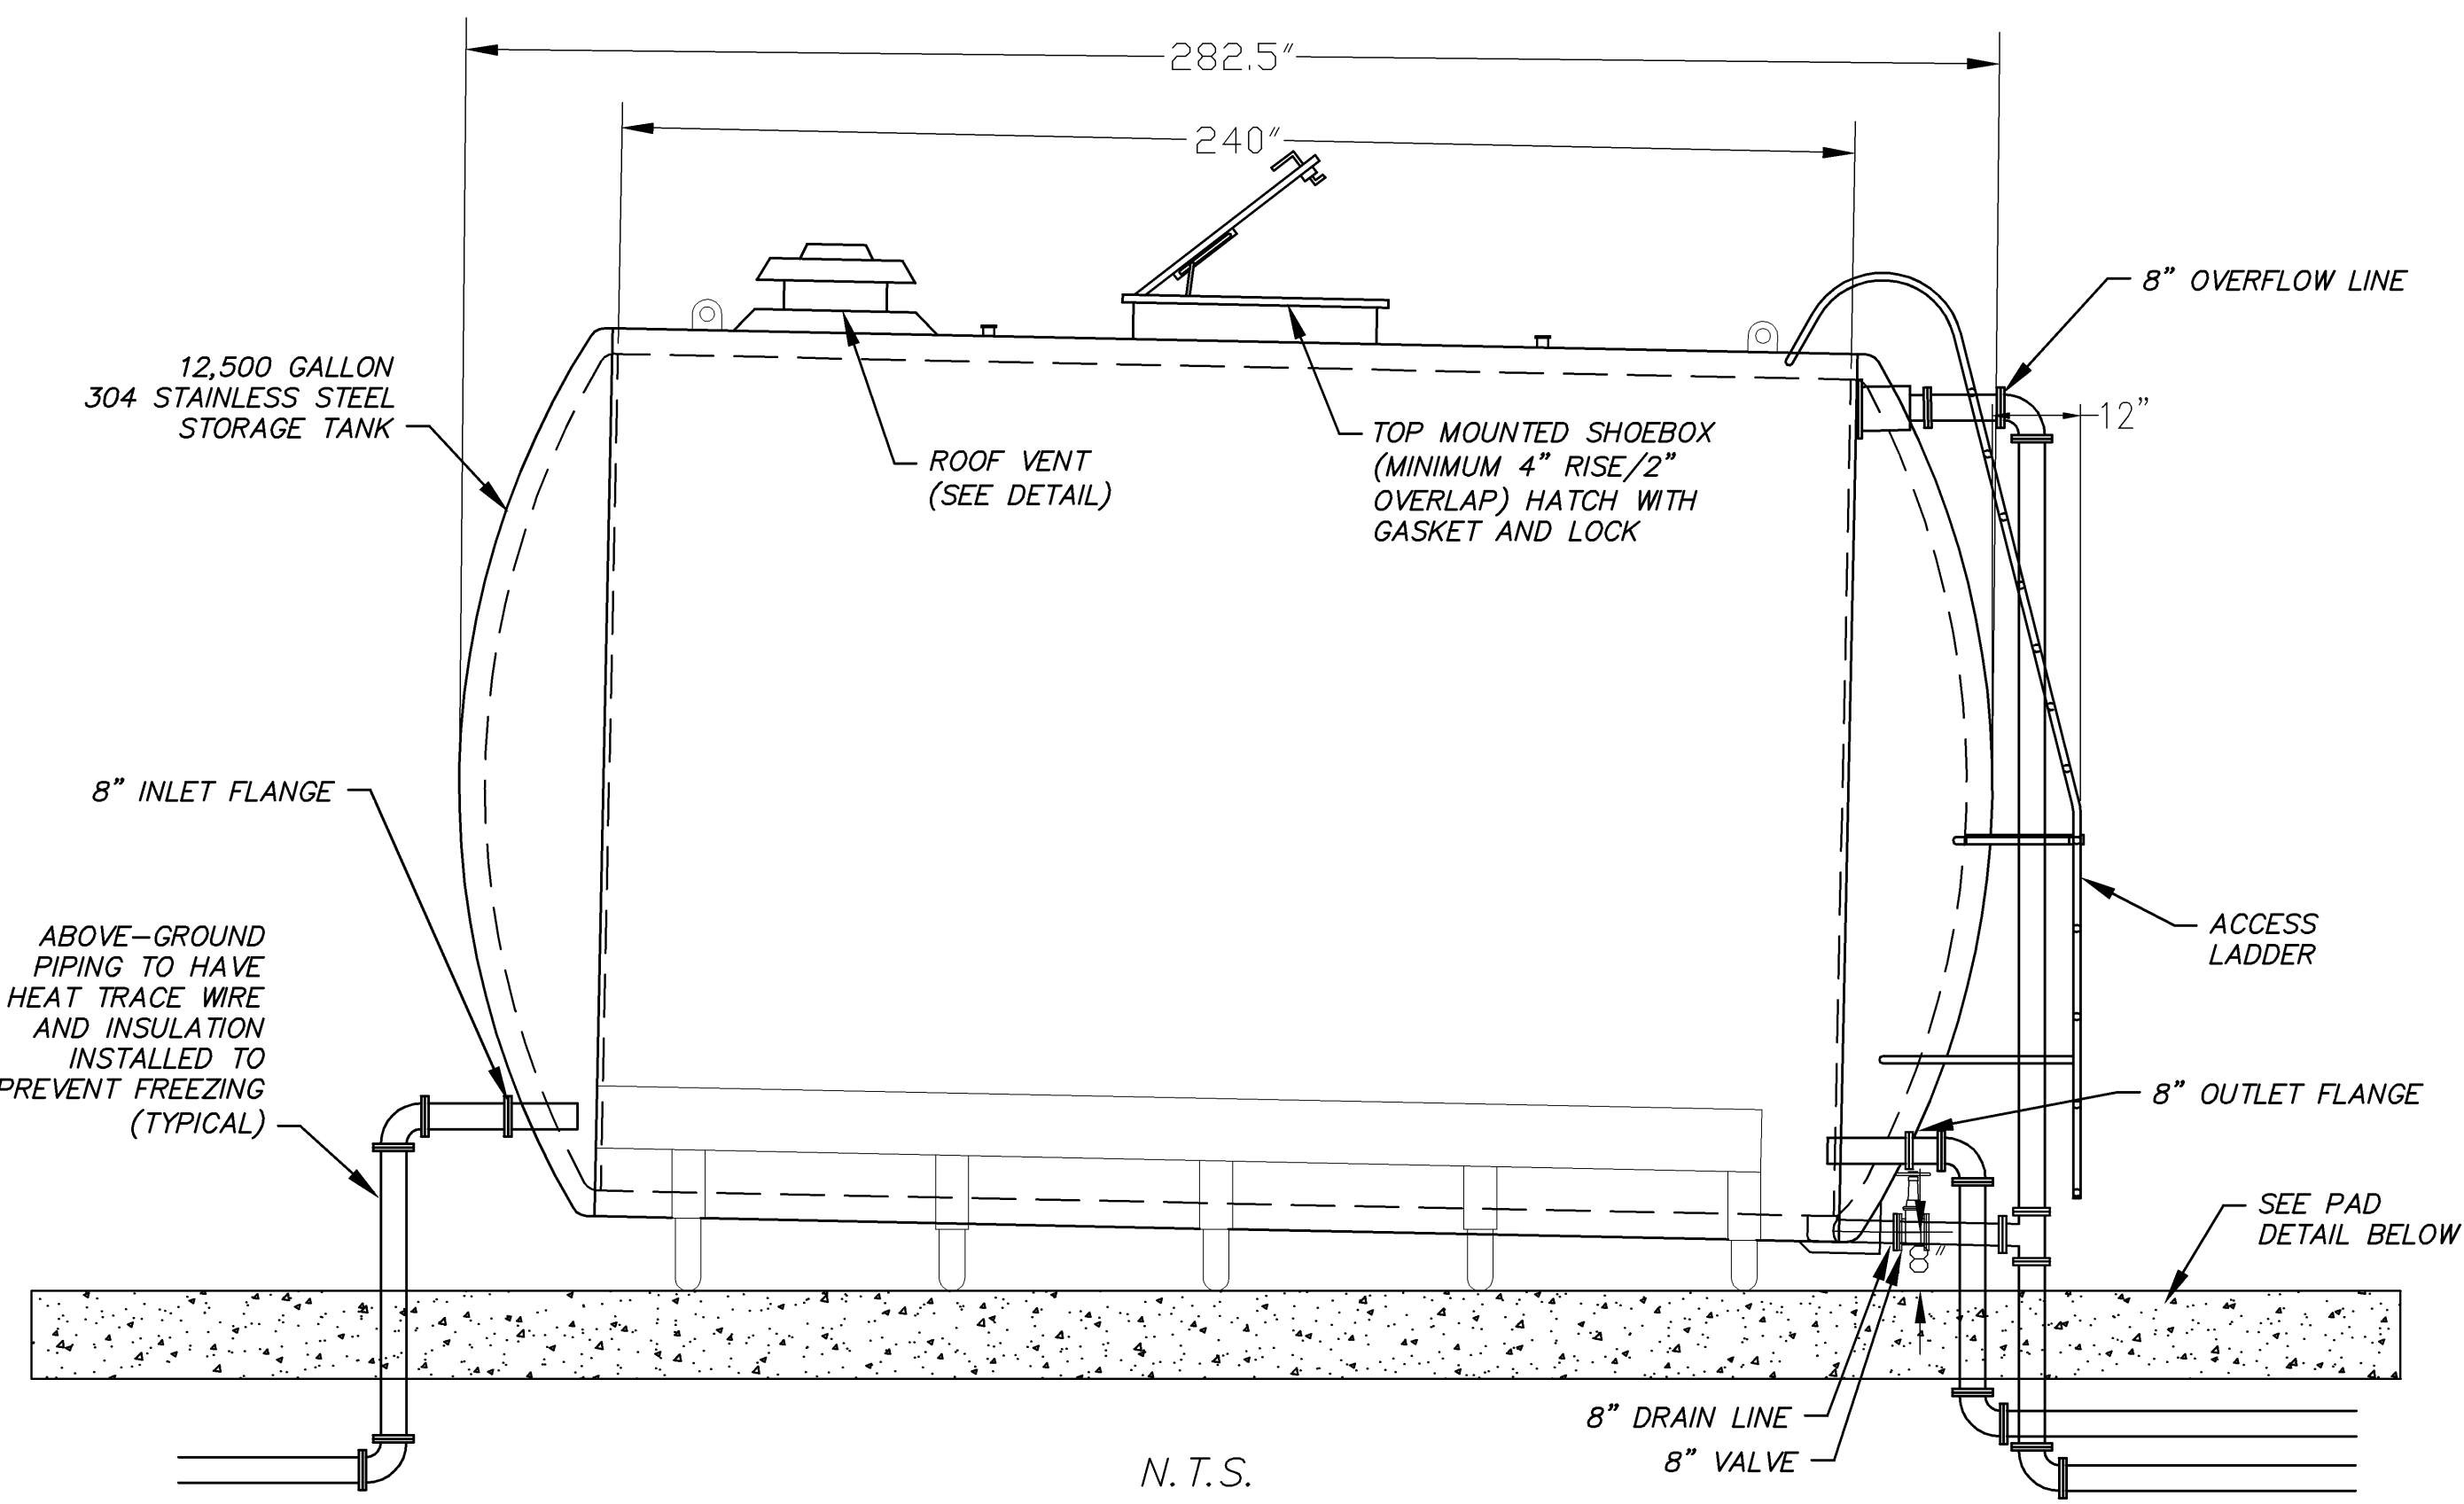


1	8/28/09	VDH/OWNER COMMENTS
2	9/3/09	VDH/OWNER COMMENTS
4	11/17/09	FRANKLIN COUNTY COMMENTS
5	3/14/12	ASBUILTS




# WELL 1 SITE PLAN

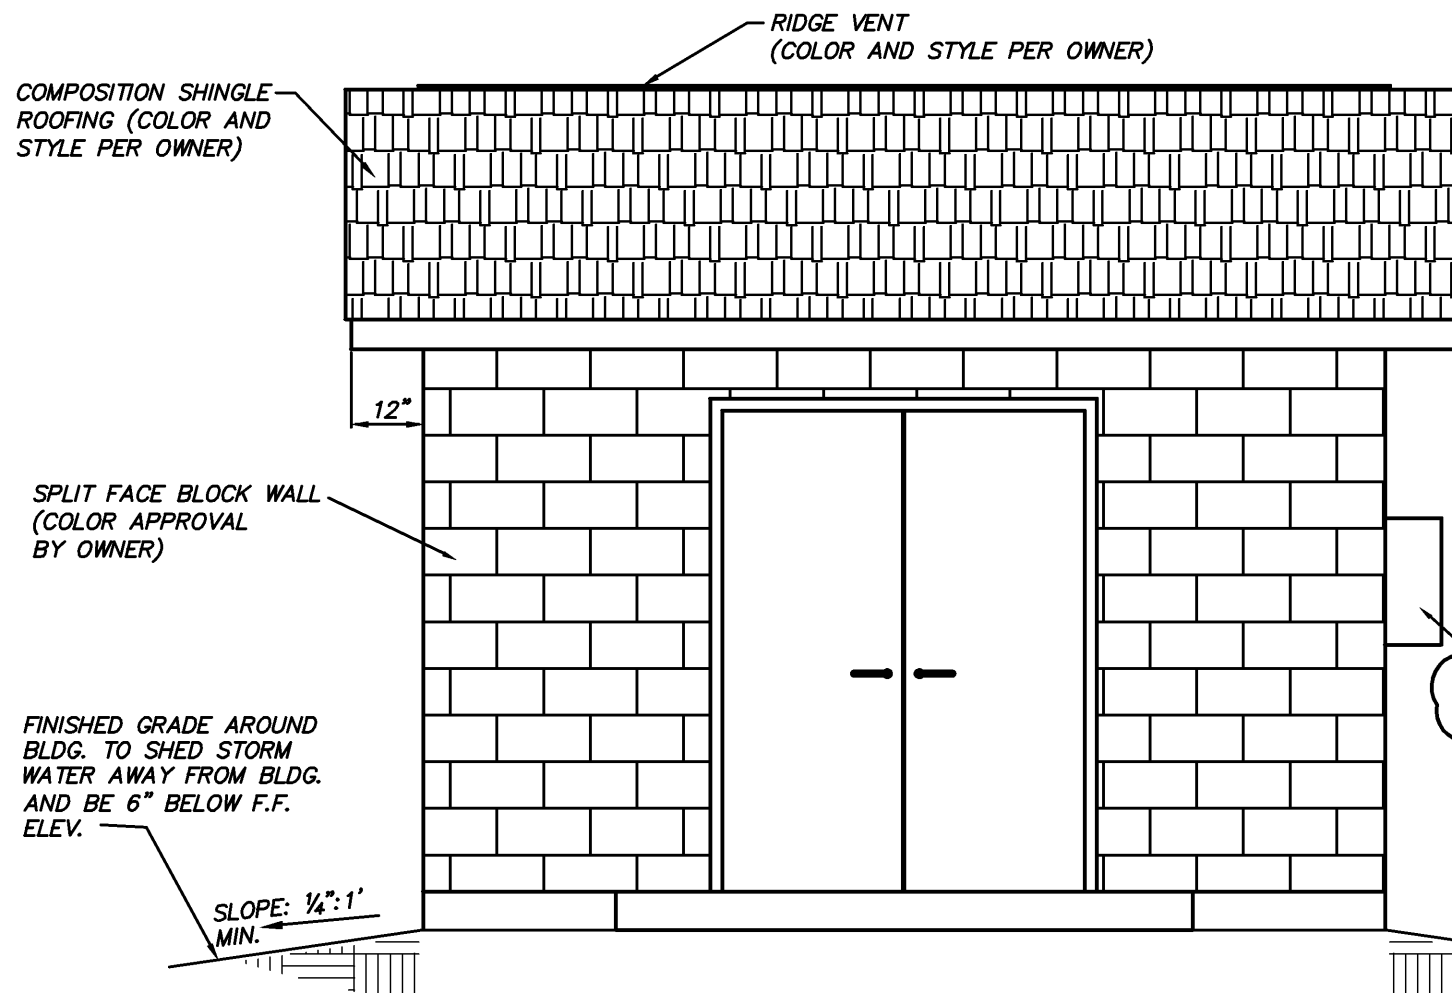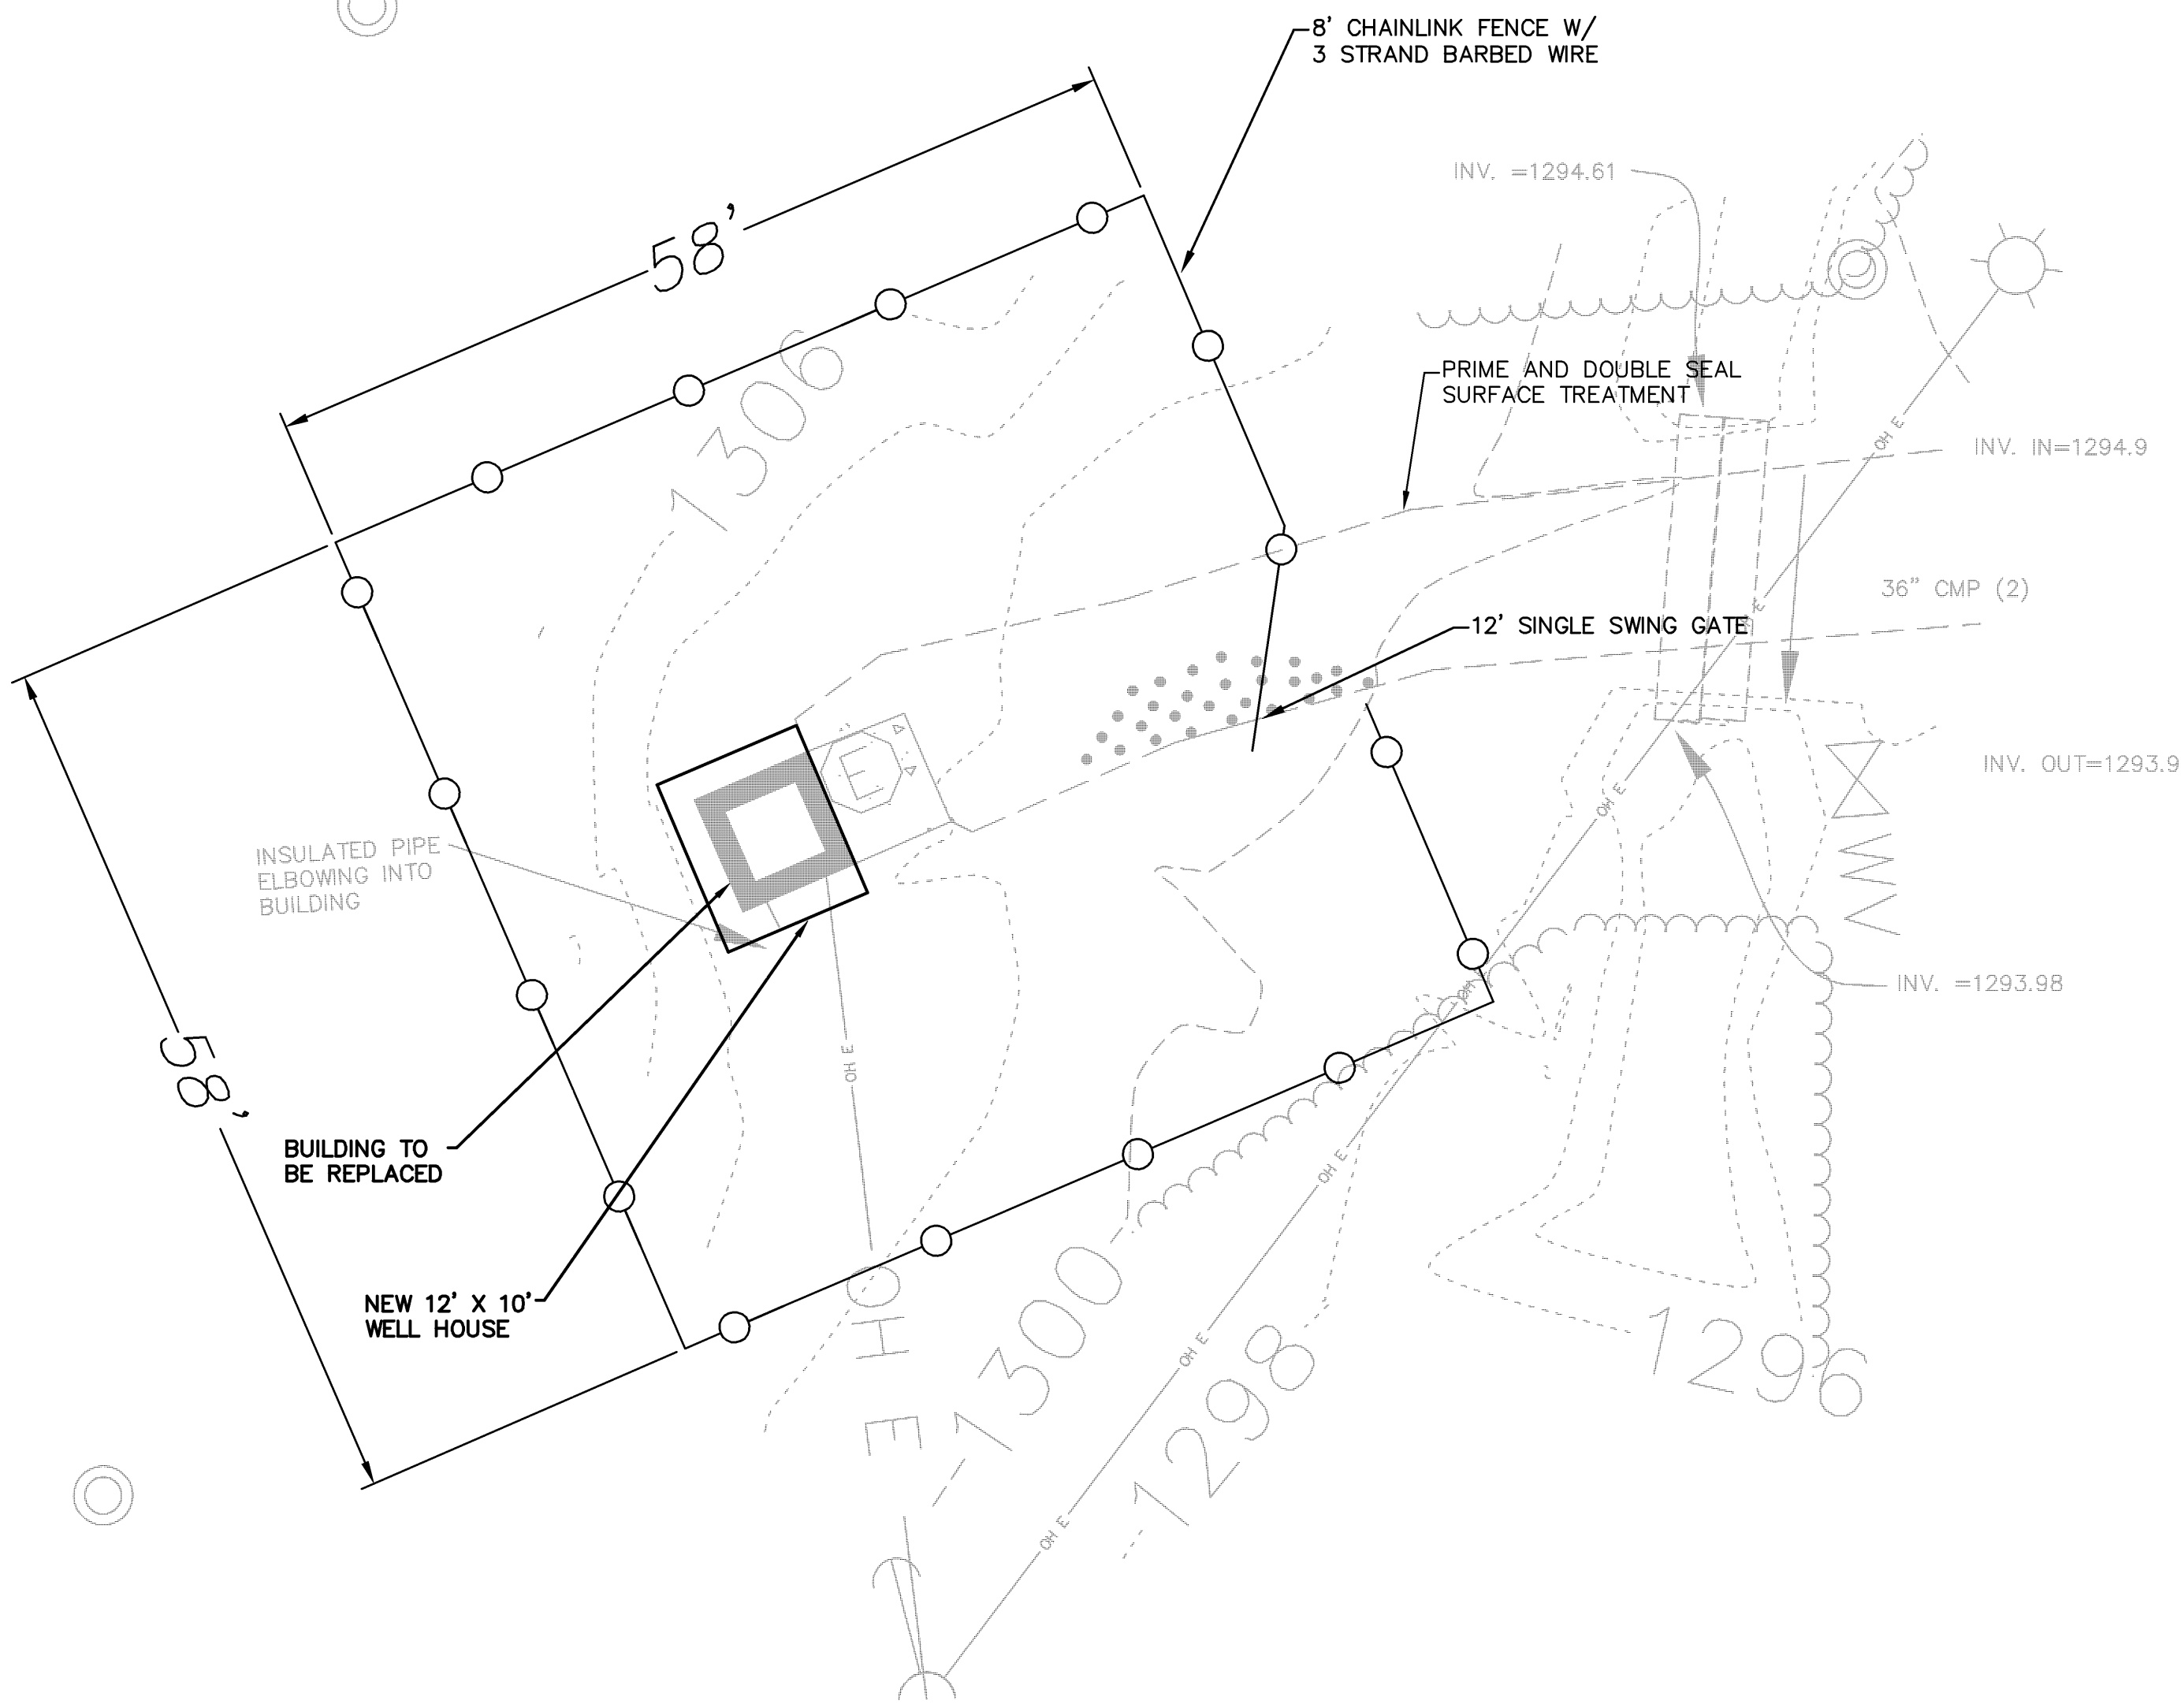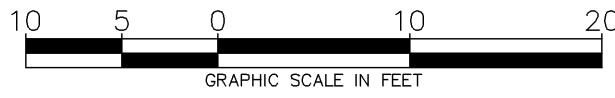


ELEVATION - FRONT VIEW  
N.T.S.

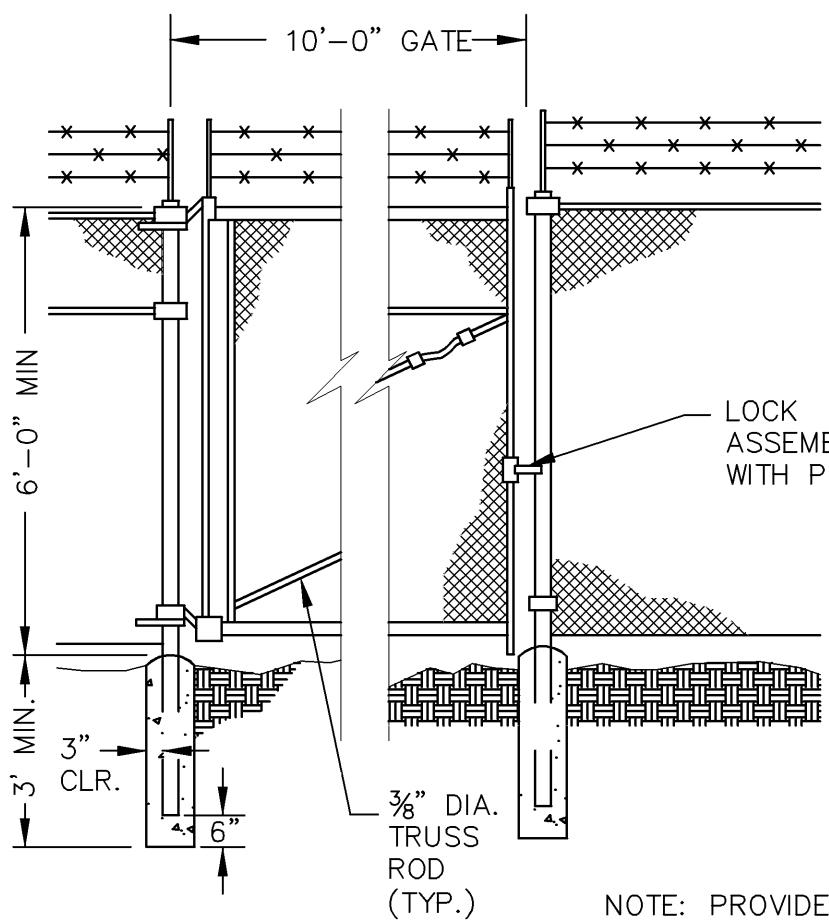


SINGLE GATE  
NOT TO SCALE  
N.T.S.

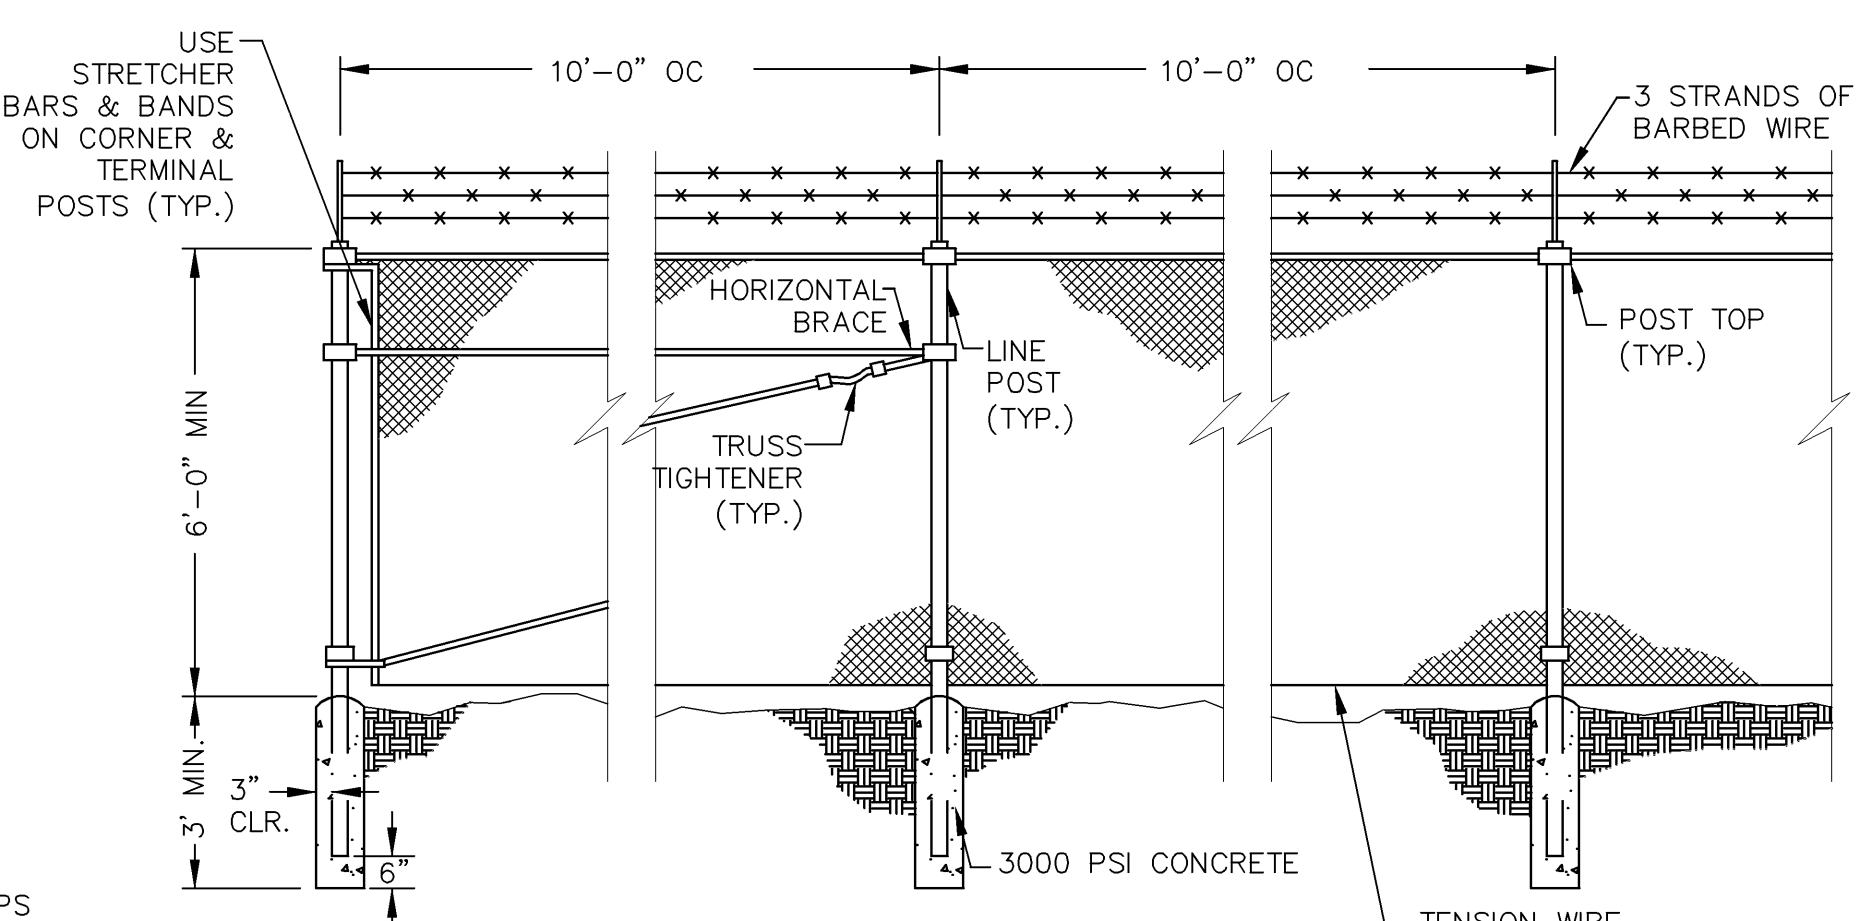


FENCE DETAIL  
NOT TO SCALE  
N.T.S.

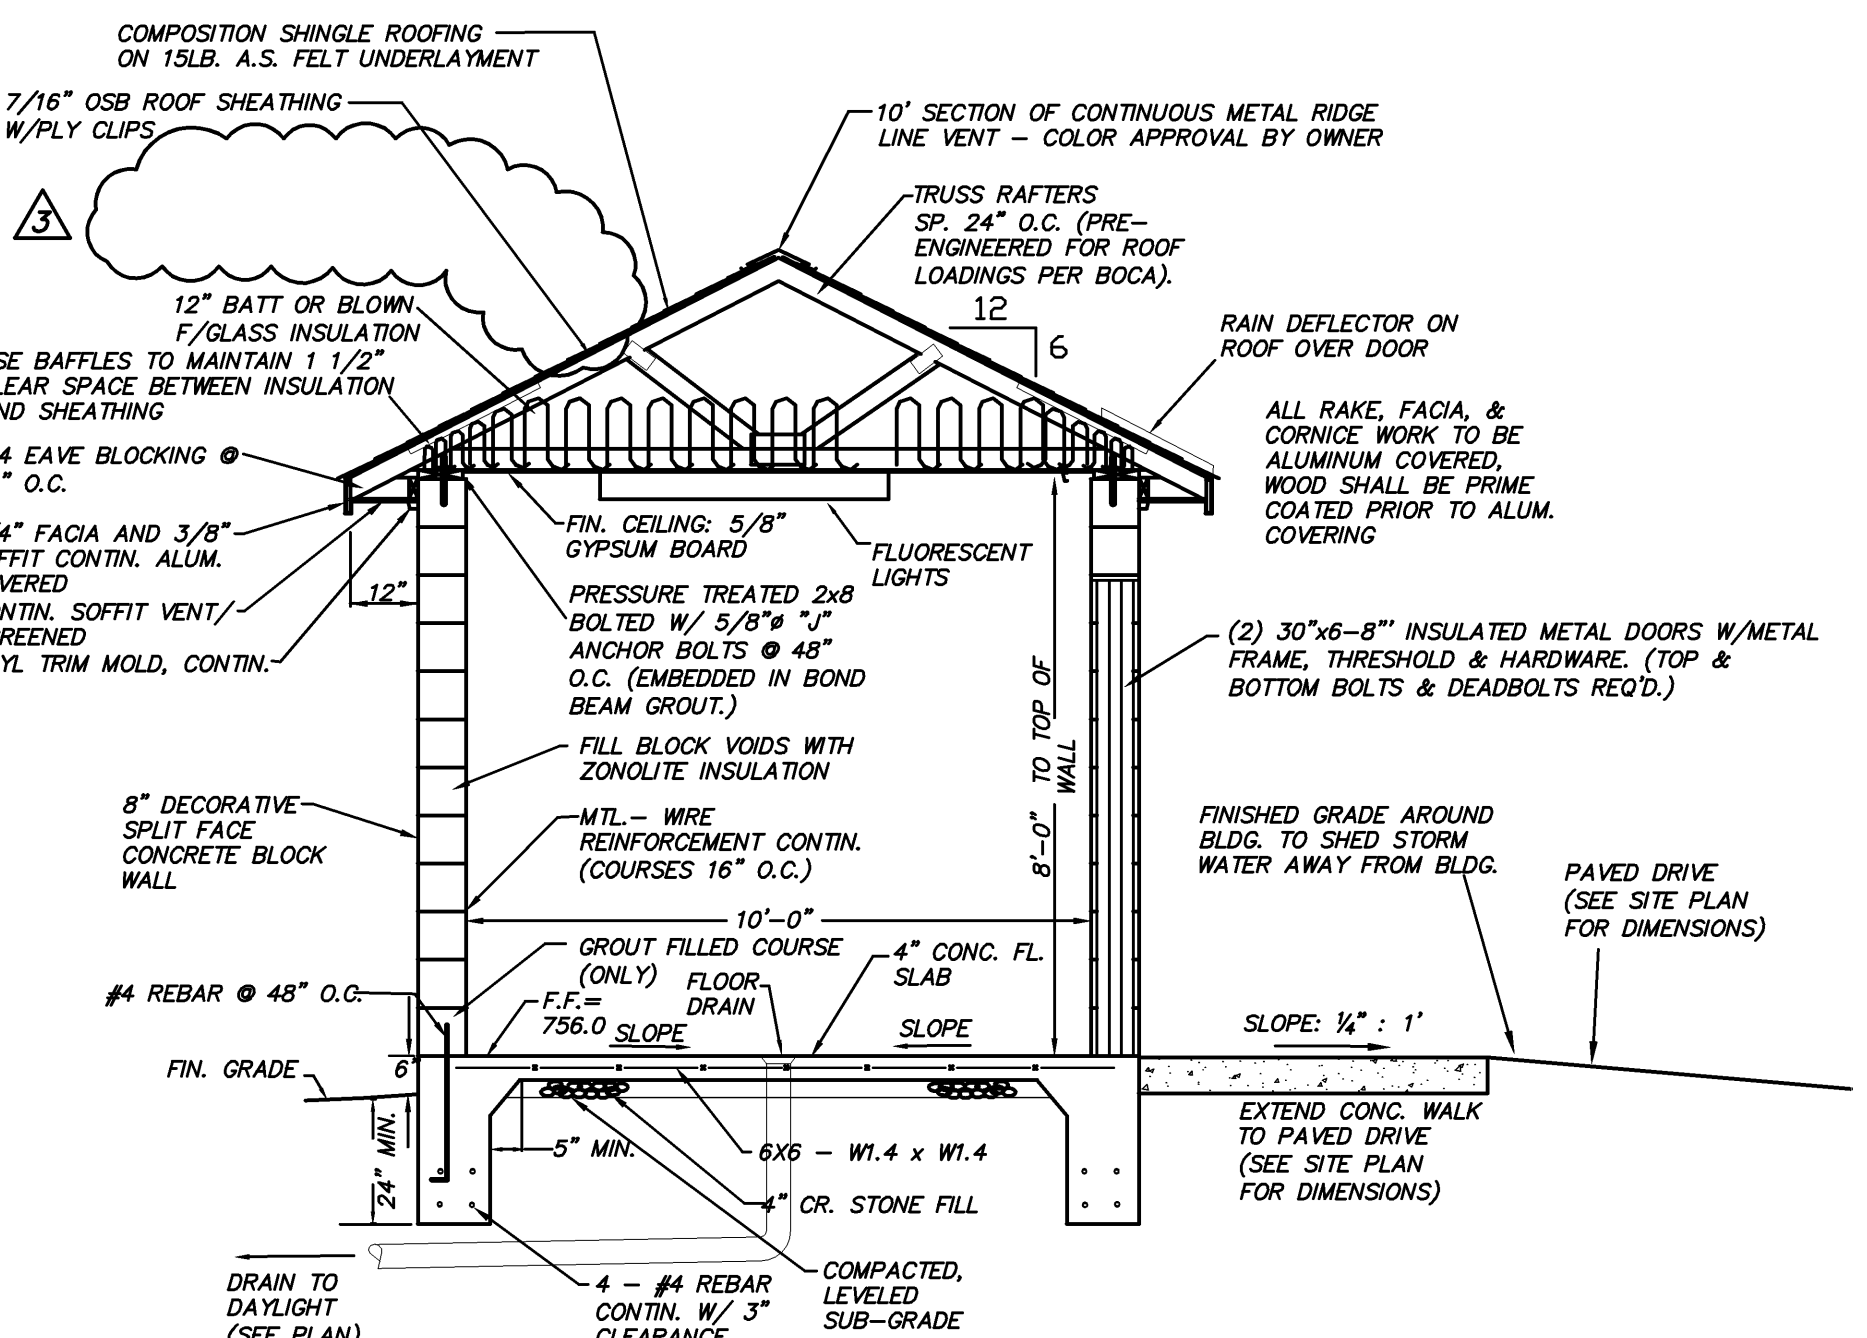

SECTION - MAIN WALL & ROOF  
N.T.S.  
WELL 1 BUILDING

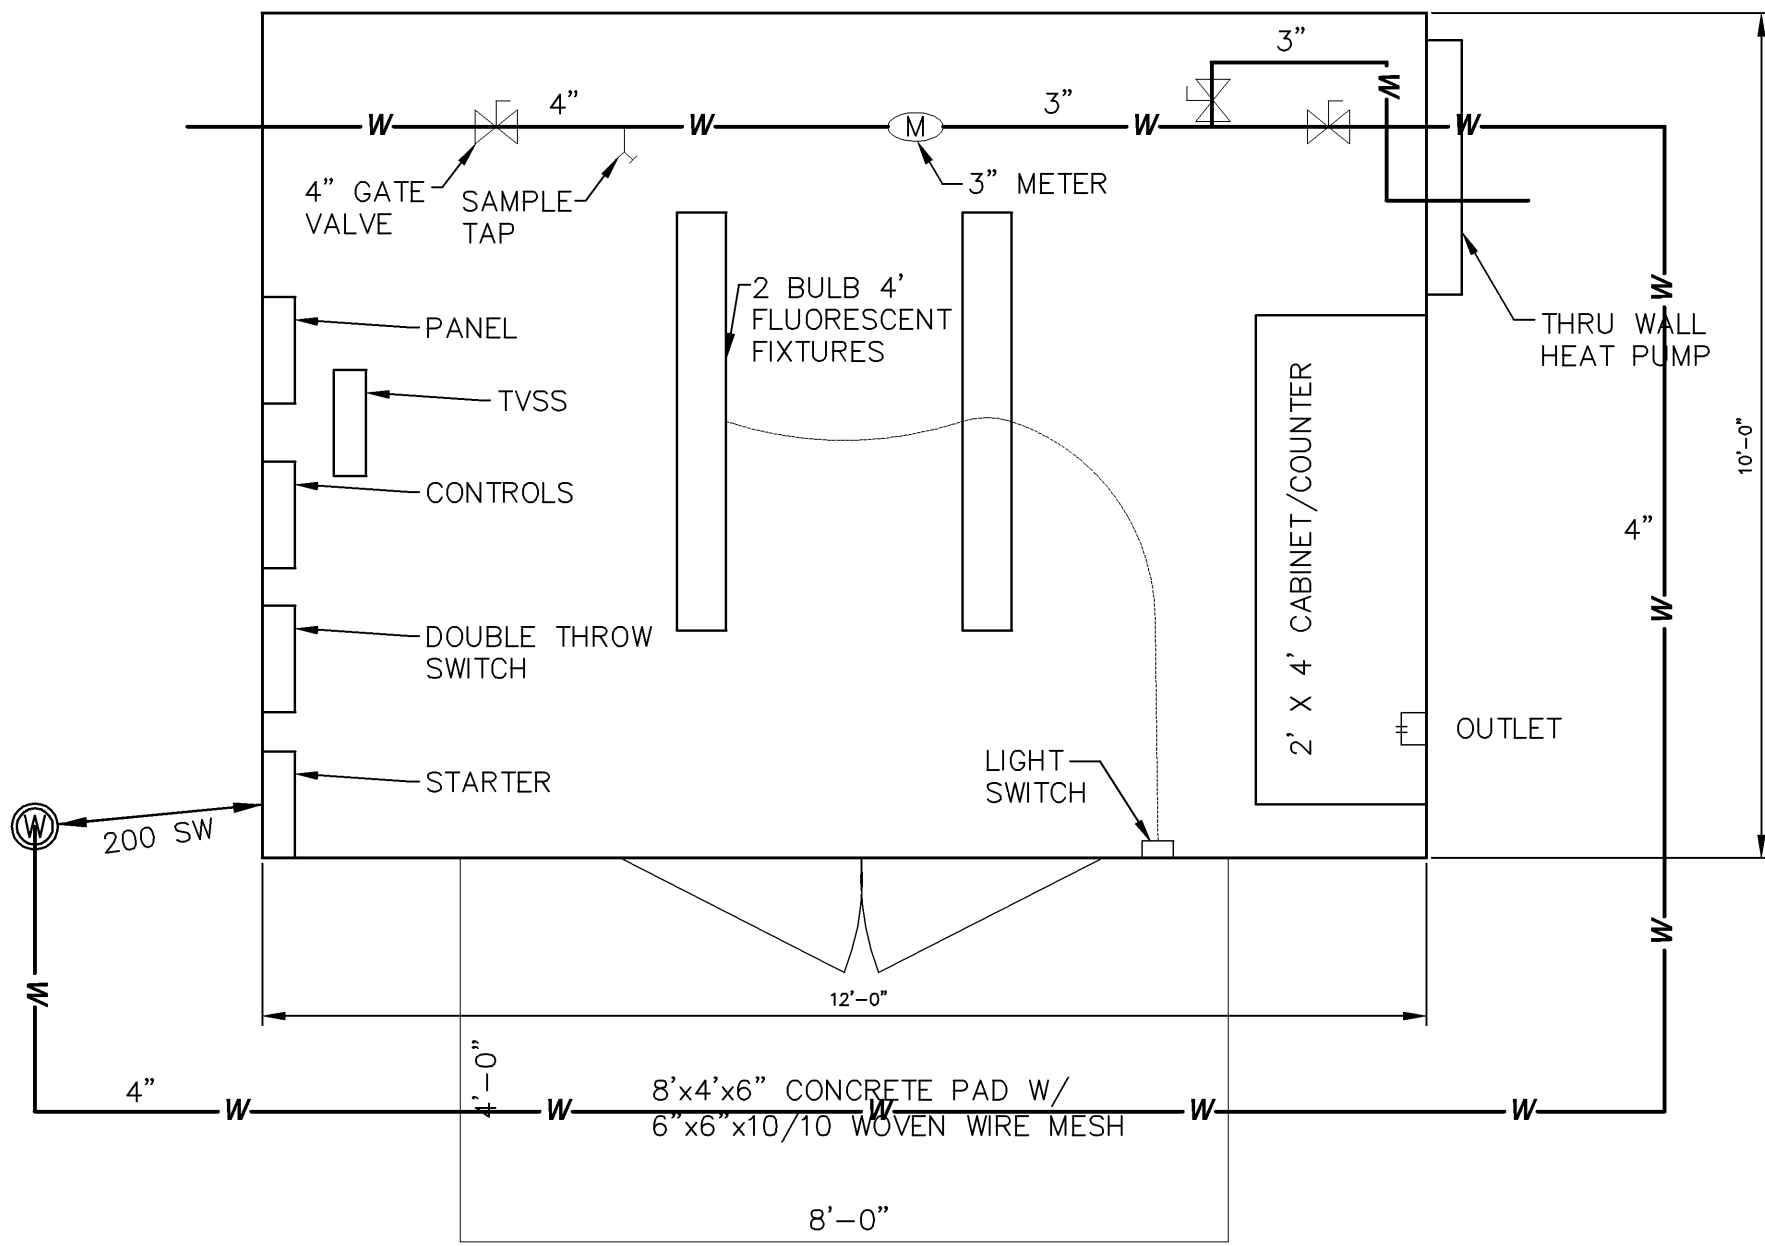

WELL 1 LAYOUT  
N.T.S.

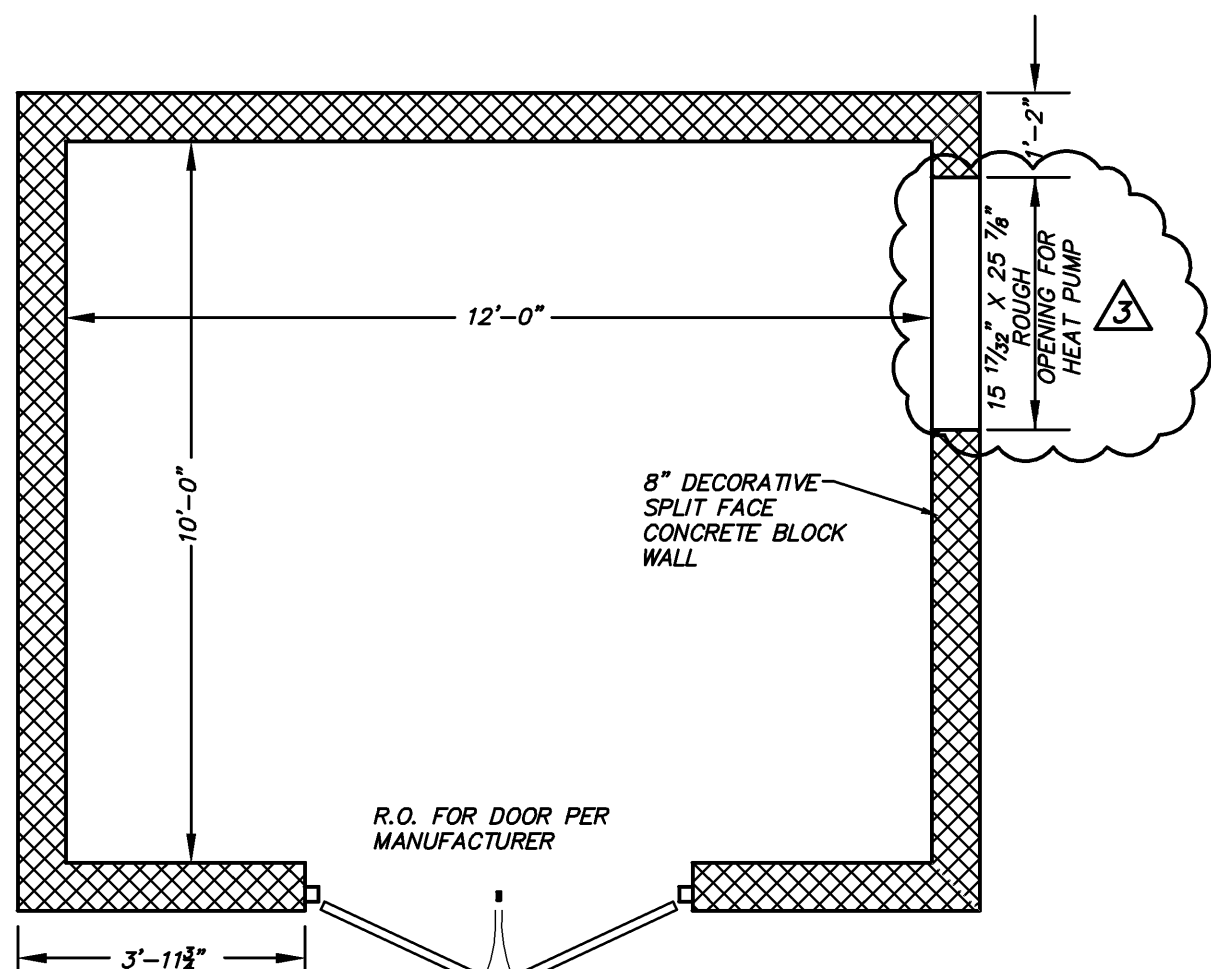

WALL PLAN VIEW  
N.T.S.

1	8/28/09	VDH/OWNER COMMENTS
2	9/3/09	VDH/OWNER COMMENTS
3	10/7/09	ADDENDUM #2
4	11/17/09	FRANKLIN COUNTY COMMENTS
5	3/14/12	ASBUILTS

\*ENGINEERING >>> SURVEYING >>> PLANNING

**HURT & PROFFITT**  
INCORPORATED  
2524 LANGHORNE ROAD  
LYNCHBURG VA 24501  
800.242.4906 TOLL FREE  
434.847.7796 MAIN  
434.847.0047 FAX


**WELL #1 SITE PLAN AND DETAILS-ASBUILT**  
FOR  
**TOWN OF BOONES MILL WATER SYSTEM REPLACEMENT, VOLUME 2**  
**TOWN OF BOONES MILL, BOONE DISTRICT, FRANKLIN COUNTY, VA**

PROJECT NO.	20080815
G.L. NO.	297-03-A3.9
FILE NO.	G-12675
DATE:	7/31/09
DRAWN BY:	WCH
CHECKED BY:	BLC


**HURT & PROFFITT**

SHEET NO.  
**C1.11**


Mar 14, 2012 - 4:10pm - V:\LandProjects\20080815.dwg\asbuilts-WTP\ASBUILD-Details.dwg

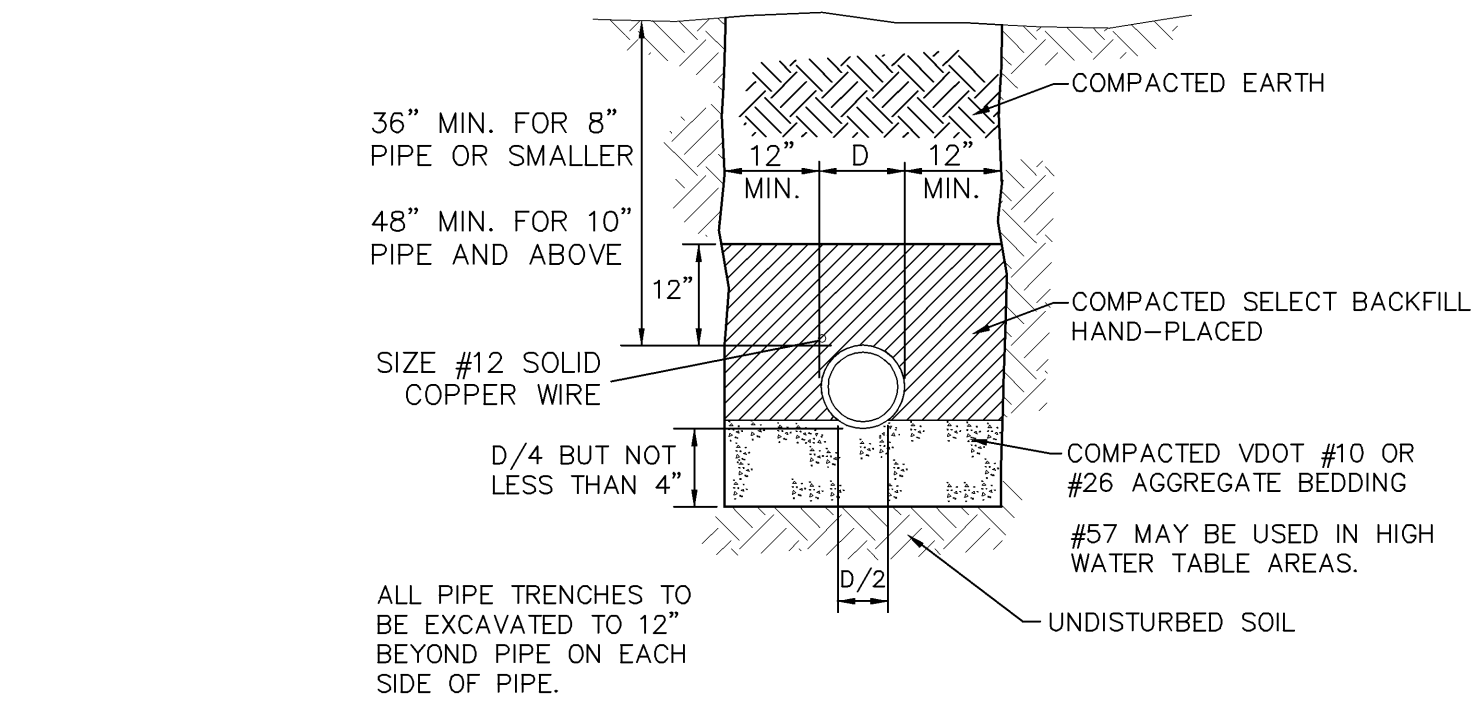


WATER LINE TRENCH  
N.T.S.

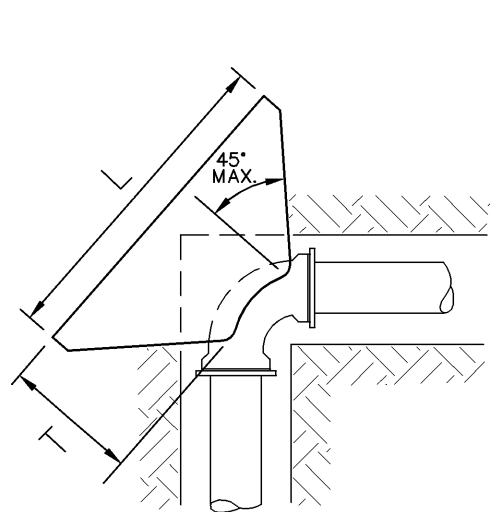


FOR ALL BENDS

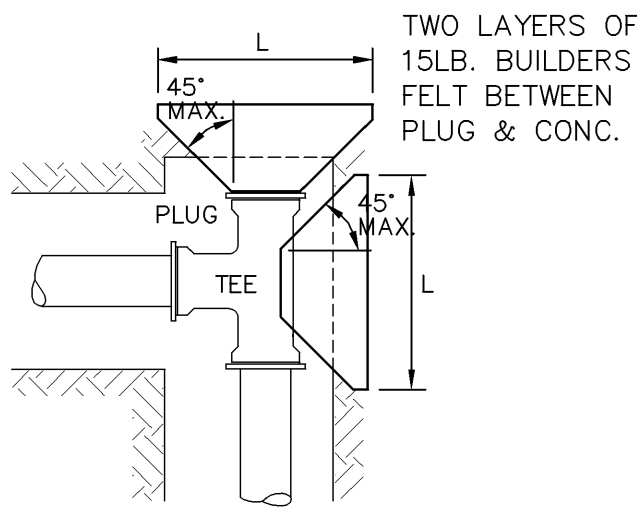

FOR TEE AND PLUG FITTINGS

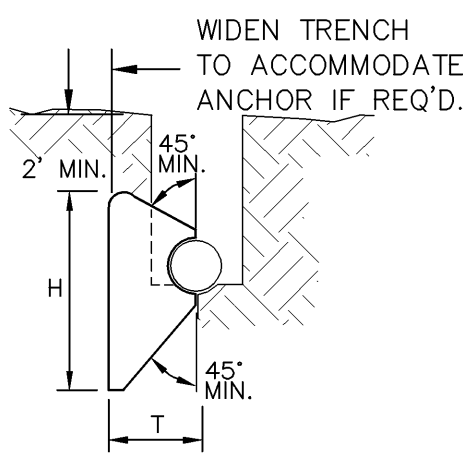


SECTION FOR BEND  
AND TEE ANCHORS

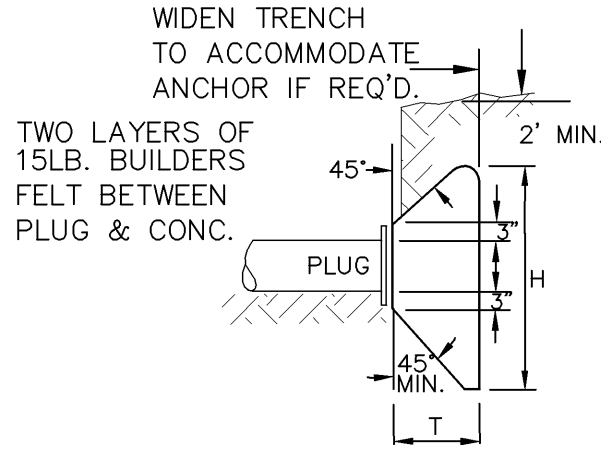

SECTION FOR  
PLUG ANCHORS

TYPE FITTING	PIPE SIZE, INCH	DIMENSIONS (FT)			VOL. CONC. CU. YARDS
		L	H	T	
90°	4	2.33	2.33	2.81	0.19
45°	4	1.33	1.83	2.42	0.08
22.5°	4	1.33	1.83	2.35	0.07
11.25°	4	1.33	1.83	2.33	0.07
TEE	4	1.83	2.08	2.33	0.11
PLUG	4	1.83	2.08	2.33	0.11
90°	6	3.50	3.00	3.01	0.41
45°	6	2.50	2.50	2.60	0.21
22.5°	6	1.50	2.00	2.52	0.10
11.25°	6	1.50	2.00	2.50	0.10
TEE	6	3.00	2.75	2.50	0.26
PLUG	6	3.00	2.75	2.50	0.26
90°	8	4.75	3.74	3.21	0.71
45°	8	3.66	3.16	2.77	0.42
22.5°	8	2.40	2.41	2.69	0.19
11.25°	8	1.80	2.16	2.67	0.13
TEE	8	4.16	3.41	2.66	0.49
PLUG	8	4.16	3.41	2.66	0.49

CONCRETE ANCHOR BLOCK  
N.T.S.

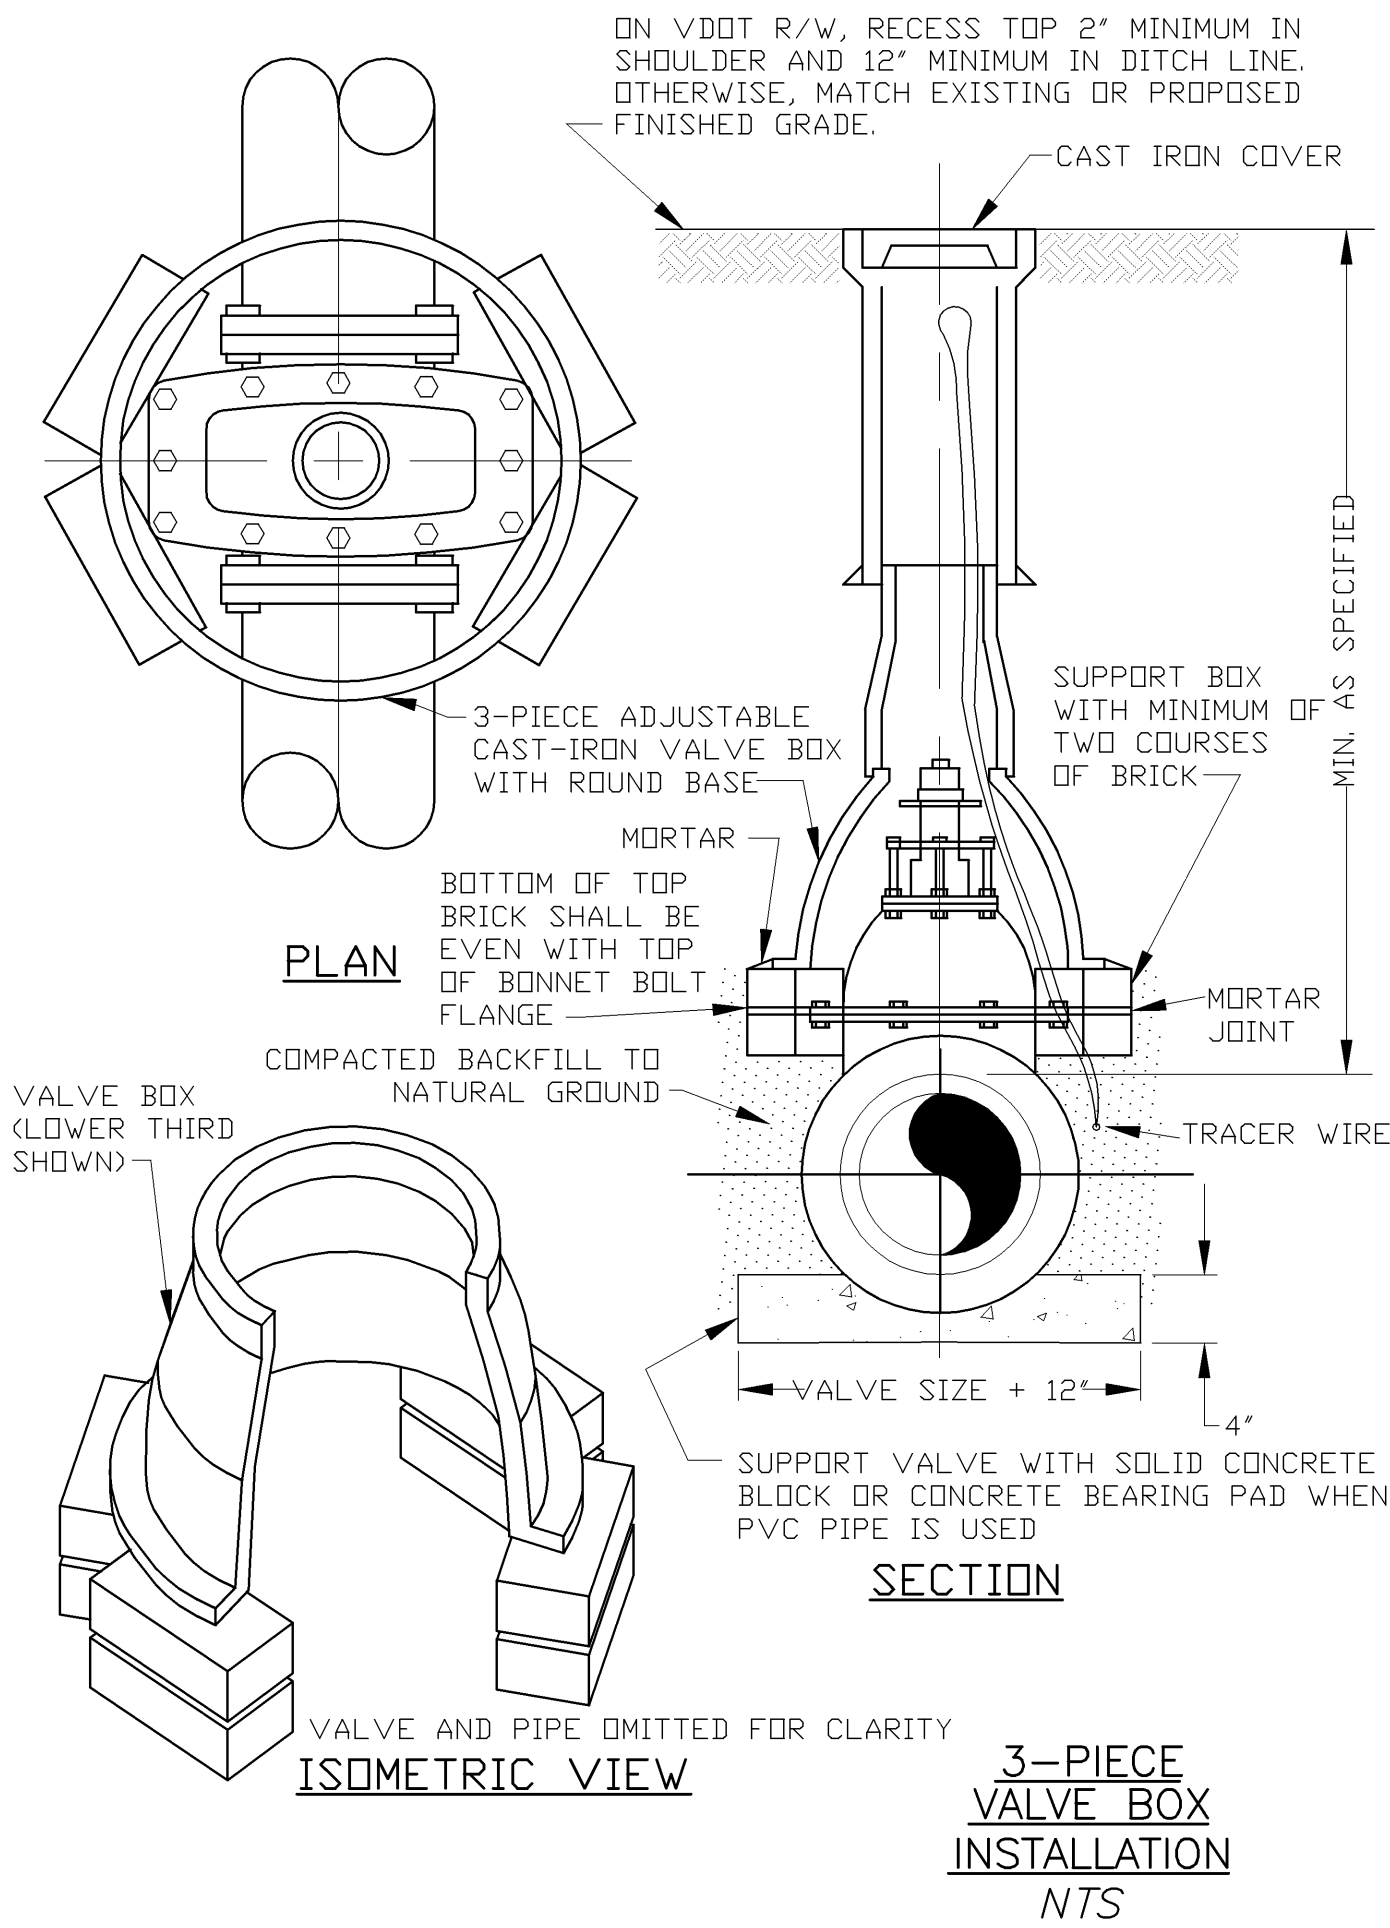

3-PIECE  
VALVE BOX  
INSTALLATION  
NTS

\*ENGINEERING >> SURVEYING >> PLANNING

HURT & PROFFITT  
INCORPORATED



2524 LANGHORNE ROAD  
LYNCHBURG VA 24501  
800.242.4906 TOLL FREE  
434.847.7796 MAIN  
434.847.0047 FAX

WATER LINE DETAILS-ASBUILT  
FOR

TOWN OF BOONES MILL WATER SYSTEM REPLACEMENT, VOLUME 2  
TOWN OF BOONES MILL, BOONE DISTRICT, FRANKLIN COUNTY, VA

PROJECT NO.	20080815
G.L. NO.	297-03-A3.9
FILE NO.	G-12675
DATE:	7/31/09
DRAWN BY:	WCH
CHECKED BY:	BLC

HURT & PROFFITT

SHEET NO.  
C2.0

1	8/28/09	VDH/OWNER COMMENTS
2	9/3/09	VDH/OWNER COMMENTS
3	10/7/09	ADDENDUM #2
4	11/17/09	FRANKLIN COUNTY COMMENTS
5	3/14/12	ASBUILTS



Mar 14, 2012 -- 4:10pm V:\unp\projects\20080815.dwg\asb\title--WTF\ASB\TITLE--TANK--DETAILS.dwg

GENERAL:

1. GOVERNING BUILDING CODE:  
2006 VIRGINIA UNIFORM STATEWDE BUILDING CODE  
(2006 INTERNATIONAL BUILDING CODE)

2. UNIFORM FLOOR LIVE LOADS:  
ALL FLOORS, EXCEPT AS NOTED 250 PSF

3. ROOF LIVE LOAD (NON-REDUCIBLE) 20 PSF

4. WIND LOAD CRITERIA:  
BASIC WIND SPEED 90 MPH  
WIND IMPORTANCE FACTOR (IW) 1.15  
WIND EXPOSURE CONDITION C  
INTERNAL PRESSURE COEFFICIENT (GCPI) 0.18  
BUILDING CATEGORY III

5. SNOW LOAD CRITERIA:  
GROUND SNOW LOAD (PG) 25 PSF  
FLAT ROOF SNOW LOAD (PF) 20 PSF  
SNOW EXPOSURE FACTOR (CE) 1.0  
SNOW IMPORTANCE FACTOR (IS) 1.1  
SNOW THERMAL FACTOR (CT) 1.0

6. SEISMIC LOAD CRITERIA:  
SEISMIC IMPORTANCE FACTOR (IE) 1.25  
SEISMIC OCCUPANCY CATEGORY III  
MAPPED SPECTRAL RESPONSE COEFFICIENT, (SS) 0.25  
MAPPED SPECTRAL RESPONSE COEFFICIENT, (S1) 0.07  
SITE CLASS (ASSUMED/PER GEOTECHNICAL REPORT) D  
SPECTRAL RESPONSE COEFFICIENT, (SDS) 0.267  
SPECTRAL RESPONSE COEFFICIENT, (SD1) 0.112  
SEISMIC DESIGN CATEGORY C  
DESIGN BASE SHEAR 14 KIPS  
SEISMIC RESPONSE COEFFICIENT, (CS)0.11  
RESPONSE MODIFICATION FACTOR (R) 3

7. SUBMIT SHOP DRAWINGS AND MATERIAL CERTIFICATIONS FOR REVIEW FOR THE FOLLOWING ITEMS. DO NOT FABRICATE MATERIALS UNTIL SHOP DRAWINGS HAVE BEEN REVIEWED AND ALL EXCEPTIONS HAVE BEEN RESOLVED.  
A. CONCRETE MIX DESIGNS, TESTS AND CERTIFICATES  
B. CONCRETE REINFORCING STEEL SHOP DRAWINGS  
C. MASONRY UNIT TESTS AND CERTIFICATES  
D. MASONRY REINFORCING STEEL SHOP DRAWINGS  
E. MASONRY MORTAR AND GROUT MIX DESIGNS, TESTS AND CERTIFICATES  
F. ROOF TRUSS SHOP DRAWINGS AND DESIGN CALCULATION BEARING THE SEAL OF A REGISTERED PROFESSIONAL ENGINEER.

8. CONTRACT DRAWINGS SHALL NOT BE MARKED AND SUBMITTED AS SHOP DRAWINGS.

9. THE CONTRACTOR SHALL VERIFY ALL EXISTING FIELD CONDITIONS, DIMENSIONS, AND ELEVATIONS BEFORE PROCEEDING WITH CONSTRUCTION. THE CONTRACTOR SHALL LOCATE ALL EXISTING UNDERGROUND UTILITIES AND PROTECT FROM DAMAGE DURING EXCAVATION AND BACKFILLING OPERATIONS.

10. STRUCTURAL FRAMING SHALL BE TEMPORARILY BRACED UNTIL ERECTION IS COMPLETE AND PERMANENT CONNECTIONS AND BRACING MEMBERS ARE INSTALLED.

11. ALL STRUCTURAL MATERIALS, COMPONENTS AND SYSTEMS SHALL BE TESTED AND INSPECTED IN ACCORDANCE WITH THE REQUIREMENTS OF THE APPLICABLE BUILDING CODE. SUBMIT INSPECTION REPORTS FOR REVIEW BY THE A/E. CONTRACTOR SHALL PROVIDE TEST AND INSPECTION SERVICES BY A QUALIFIED TESTING AND INSPECTION FIRM.

FOUNDATIONS:

1. DESIGN SOIL BEARING CAPACITY: 2,000 PSF (ASSUMED).

2. WHERE FOOTING OR SLAB ON GRADE IS TO BE PLACED ON FILL, ALL TOPSOIL, ROOTS TRASH AND OTHER EXTRANEIOUS MATERIALS SHALL BE REMOVED AND REPLACED WITH SELECT FILL COMPACTED TO A MINIMUM OF 95% OF ITS MAXIMUM DENSITY AT ITS OPTIMUM MOISTURE CONTENT AS MEASURED BY THE TOP 12" SHALL BE COMPACTED TO A MINIMUM OF 98% EACH LAYER OF FILL SHALL BE NO GREATER THAN 8" THICK AND SHALL BE COMPACTED AS SPECIFIED PRIOR TO PLACEMENT OF THE FOLLOWING LAYER.

3. THE CONTRACTOR SHALL RETAIN AN INDEPENDENT TESTING AGENCY WITH A QUALIFIED GEOTECHNICAL ENGINEER LICENSED IN THE COMMONWEALTH OF VIRGINIA TO INSPECT AND APPROVE THE SUBGRADE INCLUDING FILL AND BACKFILL MATERIALS AND OPERATIONS. ALL FOUNDATION BEARING STRATA SHALL BE INSPECTED AND APPROVED BY THE GEOTECHNICAL ENGINEER PRIOR TO ANY CONCRETE PLACEMENT. IF UNSUITABLE SOILS ARE ENCOUNTERED, THE GEOTECHNICAL ENGINEER AND THE A/E SHALL DETERMINE THE MEANS OF CORRECTIVE ACTION INCLUDING BUT, NOT LIMITED TO ITEMS 4 OR 5 BELOW.

4. FOOTING BEARING ELEVATIONS SHALL BE LOWERED WHERE REQUIRED TO OBTAIN THE DESIGN SOIL BEARING CAPACITY HEREIN SPECIFIED.

5. FOOTINGS MAY BE UNDERCUT AND BACKFILLED WITH COMPACTED STONE OR INCREASED IN THICKNESS AS REQUIRED.

6. IT SHALL BE THE CONTRACTOR'S RESPONSIBILITY TO PROVIDE WELL-BRACED SHORING AT EXCAVATIONS NEAR EXISTING BUILDINGS AND CONSTRUCTION TO PREVENT SETTLEMENT AND TO PREVENT CAVE-INS.

7. ALL SLABS ON GRADE SHALL BE PLACED 10 MIL POLYETHYLENE VAPOR BARRIER OVER 4" BASE OF WELL-COMPACTED GRAVEL. THE GRAVEL SHALL BE PLACED ON ORIGINAL SOIL OR ON COMPACTED EARTH FILL AS DESCRIBED ABOVE.

8. PLACE CONCRETE FOR SLAB ON GRADE IN CONTINUOUS STRIPS AND PROVIDE CRACK CONTROL JOINTS AT LOCATIONS A MAXIMUM SPACING OF 15 FEET ON CENTER, UNLESS OTHERWISE NOTED.

CONCRETE:

1. ALL CONCRETE SHALL BE 145 PCF NORMAL WEIGHT WITH A COMPRESSIVE STRENGTH OF 4,000 PSI AT 28 DAYS:

2. ALL DETAILING, FABRICATION AND PROCEDURES OF CONCRETE PLACEMENT SHALL CONFORM WITH THE LATEST EDITIONS OF ACI 301 -- "SPECIFICATIONS FOR STRUCTURAL CONCRETE FOR BUILDINGS", ACI 315 -- "DETAILS AND DETAILING OF CONCRETE REINFORCEMENT", AND ACI 318 -- "BUILDING CODE REQUIREMENTS FOR REINFORCED CONCRETE.

3. REINFORCING BARS SHALL BE ROLLED FROM NEW BILLET STEEL CONFORMING WITH ASTM A615/A615M, GRADE 60, UNLESS OTHERWISE NOTED.

4. WELDED WIRE FABRIC SHALL CONFORM TO ASTM A185 AND A82.

5. THE FOLLOWING MINIMUM CONCRETE COVER SHALL BE PROVIDED FOR ALL REINFORCEMENT, UNLESS OTHERWISE NOTED:  
A. CONCRETE CAST AGAINST AND PERMANENTLY EXPOSED TO EARTH 3"  
B. CONCRETE EXPOSED TO EARTH OR WEATHER:  
#6 THROUGH #18 BARS 2"  
#5 BAR AND SMALLER 1 1/2"  
C. CONCRETE NOT EXPOSED TO EARTH OR WEATHER:  
SLABS, WALLS, AND JOISTS 3/4"  
BEAMS AND COLUMNS 1 1/2"

6. ISOLATION JOINT MATERIAL SHALL BE 1/2" THICK, UNLESS OTHERWISE NOTED.

7. PROVIDE CORNER BARS AT ALL FOOTING STEPS AND CORNERS UNLESS OTHERWISE NOTED. BARS SHALL BE A MINIMUM OF 2'-6" LONG AND SHALL HAVE THE SAME SIZE AND SPACING AS THE HORIZONTAL REINFORCING.

8. LAP ALL REINFORCING SPLICES AT LEAST 48 BAR DIAMETERS (24" MINIMUM) UNLESS OTHERWISE NOTED.

9. WELDED WIRE FABRIC SHALL HAVE END LAPS OF ONE FULL MESH PLUS 2" BETWEEN CROSS WIRES AND EDGE LAPS OBTAINED BY OVERLAPPING LONGITUDINAL SELVAGE WIRES 2" AND WIRING ALL LAPS SECURELY TOGETHER. WELDED WIRE FABRIC SHALL EXTEND INTO SUPPORT BEAMS AND WALLS FOR ANCHORAGE UNLESS AN EXPANSION JOINT IS INDICATED.

10. ALL REINFORCING SHALL BE SECURELY WIRED TOGETHER IN FORMS AS CALLED FOR IN "PLACING REINFORCING BARS" BY CRSI.

11. CHAMFER EXPOSED EDGES OF CONCRETE 3/4" UNLESS OTHERWISE NOTED.

STRUCTURAL STEEL:

1. STEEL MATERIALS SHALL CONFORM TO THE FOLLOWING SPECIFICATIONS:  
STRUCTURAL SHAPES AND PLATES ASTM A992/A992M, GRADE 50  
ANCHOR BOLTS ASTM A307 OR A36/A36M  
HIGH STRENGTH BOLTS ASTM A325

2. DESIGN, FABRICATION, ERECTION, AND WORKMANSHIP SHALL CONFORM TO THE "SPECIFICATION FOR STRUCTURAL STEEL BUILDINGS ALLOWABLE STRESS DESIGN AND PLASTIC DESIGN," AISC ASD, NINTH EDITION.

3. ALL SHOP AND FIELD WELDING SHALL BE EXECUTED BY WELDERS AND WELDING OPERATORS WHO HAVE BEEN PREVIOUSLY QUALIFIED BY TEST AS PRESCRIBED IN THE "CODE FOR WELDING IN BUILDING CONSTRUCTION", AWS D1.1, OF THE AMERICAN WELDING SOCIETY TO PERFORM THE TYPES OF WELDS REQUIRED ON THIS PROJECT.

4. ALL WELDING ELECTRODES SHALL BE E70XX SERIES.

5. SHOP PAINTING: ALL SURFACES SHALL BE PRIME PAINTED IN THE SHOP WITH AN APPROVED PRIMER COMPATIBLE WITH THE TOP COAT. PRIMER COAT SHALL HAVE A MINIMUM OF 2 MILS DRY FILM THICKNESS. SPOT PAINT ALL FIELD WELDS AND SERIOUS ABRASIONS TO THE SHOP COAT WITH PAINT COMPATIBLE WITH THE SHOP COAT. DO NOT PAINT STEEL SURFACES THAT ARE TO BE EMBEDDED IN CONCRETE OR MORTAR OR WHICH ARE TO RECEIVE SPRAYED-ON FIREPROOFING.

6. ALL EXPOSED STEEL SHALL BE PAINTED.

7. FLOOR GRATING SHALL BE GALVANIZED STEEL, WELDED TYPE WITH 1 3/4" X 1/8" BEARING BARS AT 1 3/16" ON CENTER AND CROSS BARS AT 4" ON CENTER, UNLESS OTHERWISE NOTED. METAL GRATING SHALL BE GALVANIZED COATING IN ACCORDANCE WITH ASTM A123/A123M, G90.

CONCRETE/BRICK MASONRY:

1. ALL DETAILING, FABRICATION, AND PROCEDURES OF CONCRETE MASONRY SHALL CONFORM WITH THE LATEST EDITIONS OF ACI 530.1 -- "SPECIFICATIONS FOR MASONRY STRUCTURES", AND ACI 530 -- "BUILDING CODE REQUIREMENTS FOR MASONRY STRUCTURES"

2. CONCRETE MASONRY UNITS SHALL CONFORM TO ASTM C90, GRADE N-1 UNLESS OTHERWISE NOTED. COMPRESSIVE STRENGTH ON NET CROSS SECTIONAL AREA OF INDIVIDUAL MASONRY UNIT SHALL BE 1900 PSI. NET AREA COMPRESSIVE STRENGTH OF MASONRY (FM) SHALL BE 1500 PSI.

3. MASONRY SHALL BE LAID IN ASTM C270, TYPE "S" MORTAR, UNLESS NOTED AND SHALL HAVE FULL MORTAR COVERAGE OF THE FACE SHELLS IN BOTH HORIZONTAL AND VERTICAL JOISTS.

4. GROUT FOR REINFORCED MASONRY SHALL CONFORM TO ASTM C476.

5. GROUT FOR REINFORCED MASONRY SHALL HAVE A COMPRESSIVE STRENGTH OF 3000 PSI AT 28 DAYS AND A SLUMP OF 8" TO 11".

6. MAXIMUM HEIGHT TO WHICH MASONRY SHALL BE LAID BEFORE FILLING IS 3 FEET FOR PEA GRAVEL CONCRETE AND 6 FEET FOR FINE GROUT.

7. PROVIDE CLEANOUT OPENINGS AT THE BOTTOM OF EACH GROUT LIFT. CLEANOUT OPENINGS SHALL BE PROVIDED AT EACH CELL TO BE FILLED WITH GROUT.

8. REINFORCING GRADE AND DETAILS SHALL BE THE SAME AS FOR CONCRETE. TIE IN POSITION AND PLACE CONCRETE AROUND REINFORCING DURING CONSTRUCTION OF MASONRY. DO NOT PUSH REINFORCING DOWN INTO PREVIOUSLY PLACED GROUT FILL. SET BOLT SIMILARLY.

9. HORIZONTAL BARS MAY BE SPLICED WITH A MINIMUM LAP OF 48 TIMES THE BAR DIAMETER, UNLESS OTHERWISE NOTED.

10. PROVIDE HORIZONTAL REINFORCING AT 16" ON VERTICAL CENTER AND IN JOINTS IMMEDIATELY ABOVE AND BELOW ALL OPENINGS. EXTEND REINFORCEMENT A MINIMUM OF 2'-0" BEYOND THE JAMB ON EACH SIDE OF AN OPENING. HORIZONTAL JOINT REINFORCING SHALL BE LAPPED A MINIMUM OF 8". JOINT REINFORCING SHALL STOP AT CONTROL JOINTS. HORIZONTAL REINFORCING SHALL BE GALVANIZED LADDER TYPE JOINT REINFORCEMENT WITH (2) 9 GAGE (W1.7) RODS AND 9 GAGE CROSS RODS, HOT-DIPPED GALVANIZED AFTER FABRICATION PER ASTM A153 -- CLASS B-2.

11. SPLICED VERTICAL REINFORCING BARS SHALL OCCUPY THE SAME CELL. MINIMUM LAP SPLICE SHALL BE 24" FOR #3 AND #4 BARS AND 36" FOR #5 AND #6 BARS. SPLICED BARS SHALL BE TIED TOGETHER.

12. VERTICAL REINFORCEMENT IN WALLS SHALL BE SUPPORTED AND SECURED AGAINST DISPLACEMENT AT 4 FOOT MAXIMUM INTERVALS.

13. IN ADDITION TO VERTICAL REINFORCING DETAILED ON THE DRAWINGS, PROVIDE VERTICAL REINFORCING TO MATCH SIZE DETAILED AT THE FOLLOWING LOCATIONS:  
a. CELLS EACH SIDE OF OPENINGS (SUCH AS DOORS, WINDOWS, ETC.)  
b. CELLS EACH SIDE OF CONTROL JOINTS.  
c. CELL AT END OF A WALL.  
d. AT INTERSECTIONS (CELL WITHIN 8" OF INTERSECTION).  
e. THREE BARS EACH CORNER (CORNER CELL AND ADJACENT CELLS IN EACH DIRECTION).

14. THE MASONRY CONTRACTOR SHALL PROVIDE AND PLACE SUCH SPECIAL UNITS AS MAY BE REQUIRED TO FORM ALL CORNERS, RETURNS, AND OFFSETS WHILE MAINTAINING THE PROPER BOND.

15. WHERE INTERIOR CONCRETE MASONRY PARTITIONS INTERSECT WITH OTHER INTERIOR PARTITIONS OR EXTERIOR WALLS, A MASONRY BOND, OR THE EQUIVALENT IN APPROVED METAL TIES, SHALL BE PROVIDED UNLESS NOTED OTHERWISE ON THE DRAWINGS.

16. FACE SHELL BEDDING SHALL BE USED WITH COMPLETE COVERAGE OF FACE SHELLS. FURROWING OF THE MORTAR SHALL NOT BE PERMITTED.

17. MORTAR JOINTS SHALL BE 3/8" THICK WITH FULL MORTAR COVERAGE ON VERTICAL AND HORIZONTAL FACE SHELLS.

18. PROVIDE BOND BEAMS AT MASONRY ELEVATIONS AS SHOWN ON THE DRAWINGS. BOND BEAMS SHALL HAVE TWO #5 BARS, CONTINUOUS, UNLESS OTHERWISE NOTED. BOND BEAMS SHALL BE CONTINUOUS AROUND THE PERIMETER OF THE BUILDING AND ALONG INTERIOR PARTITIONS, UNLESS OTHERWISE NOTED. BOND BEAM REINFORCING SHALL BE CONTINUOUS THROUGH CONTROL JOINTS. CUT IN OR RAKE OUT A VERTICAL JOINT MATCHING THE CONTROL JOINT AS REQUIRED.

19. LINTELS OVER ALL OPENINGS IN INTERIOR MASONRY PARTITIONS, NOT OTHERWISE DETAILED, SHALL BE OF PRECAST CONCRETE MASONRY WITH THICKNESS EQUAL TO THE WALL THICKNESS. DEPTH SHALL BE 8" FOR SPANS UP TO 6'-0" REINFORCED WITH ONE (1) #5 BAR FOR EACH 4" OF WALL THICKNESS.

WOOD FRAMING AND PLYWOOD:

1. ALL WOOD FRAMING SHALL BE KILN DRIED NO. 2 DENSE (OR BETTER) DIMENSION SOUTHERN YELLOW PINE CONFORMING TO SOUTHERN PINE INSPECTION BUREAU GRADING RULES, AND SHALL KILN DRIED TO 19% MAXIMUM MOISTURE CONTENT, UNLESS OTHERWISE NOTED.

2. PLYWOOD FOR SHEATHING SHALL CONFORM TO THE GRADING RULES OF U.S. PRODUCT STANDARD PS 1, LATEST EDITION, AND SHALL HAVE APPROPRIATE GRADE TRADE MARK OF AN AMERICAN PLYWOOD ASSOCIATION APPROVED AGENCY ON EACH PLYWOOD PANEL. SHEATHING SHALL BE APA STRUCTURAL I RATED, EXTERIOR GRADE, IN THICKNESS SHOWN ON DRAWINGS. SHEATHING SHALL BE APPLIED IN FULL SHEETS, OR AS SHOWN ON THE PLANS OR IN LARGEST PIECES FOR THE AREA BEING COVERED WITH A MINIMUM TWO SPAN CONTINUOUS CONDITION WITH LONGER FACTORY EDGE PERPENDICULAR TO THE FRAMING MEMBERS, WITH END JOINTS STAGGERED, AND SHEET ENDS BEARING ON FRAMING MEMBERS.

3. ALL NAILING FOR WOOD CONSTRUCTION SHALL BE IN ACCORDANCE WITH INTERNATIONAL BUILDING CODE'S FASTENING SCHEDULE (TABLE 2304.9.1).

WOOD TRUSSES:

1. SUBMIT WOOD TRUSS DESIGN CALCULATIONS AND SHOP DRAWINGS FOR REVIEW PRIOR TO FABRICATION. SHOP DRAWING FOR WOOD TRUSSES SHALL BEAR THE SEAL OF AN ENGINEER REGISTERED IN THE STATE WHERE THE PROJECT IS LOCATED AND SHALL BE APPROVED BY THE ENGINEER OR ARCHITECT BEFORE FABRICATION. SHOP DRAWINGS SHALL SHOW SPECIES AND MOISTURE CONTENT OF WOOD BEING USED. ALLOWABLE STRESSES SHALL CONFORM TO THE LATEST EDITION OF "NATIONAL DESIGN SPECIFICATION FOR STRESS-GRADE LUMBER AND ITS FASTENING", AS RECOMMENDED BY THE NATIONAL FOREST PRODUCTS ASSOCIATION.

2. LUMBER IN TRUSSES SHALL BE GRADE MARKED, NO. 2 DIMENSION, KILN-DRIED SOUTHERN ONE, OR BETTER, UNLESS OTHERWISE INDICATED ON THE DETAILS EXCEPT TRUSS WEB MEMBERS MAY BE NO. 3, KILN-DRIED, GRADE MARKED, SOUTHERN PINE. MAXIMUM ALLOWABLE MOISTURE CONTENT =15%.

3. PROVIDE WASHERS BETWEEN ALL BOLT HEADS AND WOOD AND BETWEEN ALL NUTS AND WOOD.

4. MAXIMUM TRUSS SPACING = 2'-0" ON CENTER, UNLESS OTHERWISE NOTED.

5. CENTROIDAL LINES OF MEMBERS SHALL INTERSECT AT A POINT UNLESS OTHERWISE NOTED.

6. ENDS OF ALL COMPRESSION MEMBERS SHALL BE CUT TO FIT INTERSECTING MEMBERS FOR POSITIVE END BEARING.

7. TRUSS JOINT CONNECTIONS SHALL BE MADE USING GALVANIZED STEEL CONNECTOR PLATES, 20 GAGE MINIMUM THICKNESS. THE TRUSS JOINT CONNECTOR PLATES SHALL BE SIZED BY THE FABRICATOR USING THE TRUSS MEMBER FORCES RESULTING IN THE DESIGN LOADS SHOWN BELOW AND IN THE DESIGN CRITERIA.

8. THE LUMBER SPECIES, TRUSS OVERALL CONFIGURATION AND MINIMUM MEMBER SIZES AND TRADES SHALL NOT BE ALTERED OR REDUCED. MEMBER SPECIES, SIZE AND GRADES OF EQUAL OR GREATER STRENGTH ARE ACCEPTABLE.

9. THE CONTRACTOR SHALL PROVIDE ALL CONNECTION MATERIALS, CONNECTOR PLATES, FRAMING ANCHORS AND ACCESSORIES AS REQUIRED FOR THE SUPPORT OF THE WOOD TRUSSES AND WOOD FRAMING.

10. WOOD TRUSSES SHALL BE CAMBERED AS REQUIRED TO OFFSET THE FULL DEAD LOAD DEFLECTION.

11. WOOD TRUSSES SHALL BE DESIGNED BY THE MANUFACTURER FOR THE WIND AND SEISMIC LOADS INDICATED IN THE DESIGN CRITERIA ALONG WITH THE FULL TRUSS DEAD LOAD AND THE FOLLOWING SUPERIMPOSED GRAVITY LOADS:  
A. SUPERIMPOSED DEAD LOADS:  
TOP CHORD 15 PSF  
BOTTOM CHORD 10 PSF  
B. LIVE LOADS:  
TOP CHORD 20 PSF  
BOTTOM CHORD 20 PSF (CENTER 1/3 OF TRUSS LENGTH)

GENERAL:

1. GOVERNING BUILDING CODE:  
2006 VIRGINIA UNIFORM STATEWDE BUILDING CODE  
(2006 INTERNATIONAL BUILDING CODE)

2. UNIFORM FLOOR LIVE LOADS:  
ALL FLOORS, EXCEPT AS NOTED 250 PSF

3. ROOF LIVE LOAD (NON-REDUCIBLE) 20 PSF

4. WIND LOAD CRITERIA:  
BASIC WIND SPEED 90 MPH  
WIND IMPORTANCE FACTOR (IW) 1.15  
WIND EXPOSURE CONDITION C  
INTERNAL PRESSURE COEFFICIENT (GCPI) 0.18  
BUILDING CATEGORY III

5. SNOW LOAD CRITERIA:  
GROUND SNOW LOAD (PG) 25 PSF  
FLAT ROOF SNOW LOAD (PF) 20 PSF  
SNOW EXPOSURE FACTOR (CE) 1.0  
SNOW IMPORTANCE FACTOR (IS) 1.1  
SNOW THERMAL FACTOR (CT) 1.0

6. SEISMIC LOAD CRITERIA:  
SEISMIC IMPORTANCE FACTOR (IE) 1.25  
SEISMIC OCCUPANCY CATEGORY III  
MAPPED SPECTRAL RESPONSE COEFFICIENT, (SS) 0.25  
MAPPED SPECTRAL RESPONSE COEFFICIENT, (S1) 0.07  
SITE CLASS (ASSUMED/PER GEOTECHNICAL REPORT) D  
SPECTRAL RESPONSE COEFFICIENT, (SDS) 0.267  
SPECTRAL RESPONSE COEFFICIENT, (SD1) 0.112  
SEISMIC DESIGN CATEGORY C  
DESIGN BASE SHEAR 14 KIPS  
SEISMIC RESPONSE COEFFICIENT, (CS)0.11  
RESPONSE MODIFICATION FACTOR (R) 3

7. SUBMIT SHOP DRAWINGS AND MATERIAL CERTIFICATIONS FOR REVIEW FOR THE FOLLOWING ITEMS. DO NOT FABRICATE MATERIALS UNTIL SHOP DRAWINGS HAVE BEEN REVIEWED AND ALL EXCEPTIONS HAVE BEEN RESOLVED.  
A. CONCRETE MIX DESIGNS, TESTS AND CERTIFICATES  
B. CONCRETE REINFORCING STEEL SHOP DRAWINGS  
C. MASONRY UNIT TESTS AND CERTIFICATES  
D. MASONRY REINFORCING STEEL SHOP DRAWINGS  
E. MASONRY MORTAR AND GROUT MIX DESIGNS, TESTS AND CERTIFICATES  
F. ROOF TRUSS SHOP DRAWINGS AND DESIGN CALCULATION BEARING THE SEAL OF A REGISTERED PROFESSIONAL ENGINEER.

8. CONTRACT DRAWINGS SHALL NOT BE MARKED AND SUBMITTED AS SHOP DRAWINGS.

9. THE CONTRACTOR SHALL VERIFY ALL EXISTING FIELD CONDITIONS, DIMENSIONS, AND ELEVATIONS BEFORE PROCEEDING WITH CONSTRUCTION. THE CONTRACTOR SHALL LOCATE ALL EXISTING UNDERGROUND UTILITIES AND PROTECT FROM DAMAGE DURING EXCAVATION AND BACKFILLING OPERATIONS.

10. STRUCTURAL FRAMING SHALL BE TEMPORARILY BRACED UNTIL ERECTION IS COMPLETE AND PERMANENT CONNECTIONS AND BRACING MEMBERS ARE INSTALLED.

11. ALL STRUCTURAL MATERIALS, COMPONENTS AND SYSTEMS SHALL BE TESTED AND INSPECTED IN ACCORDANCE WITH THE REQUIREMENTS OF THE APPLICABLE BUILDING CODE. SUBMIT INSPECTION REPORTS FOR REVIEW BY THE A/E. CONTRACTOR SHALL PROVIDE TEST AND INSPECTION SERVICES BY A QUALIFIED TESTING AND INSPECTION FIRM.

FOUNDATIONS:

1. DESIGN SOIL BEARING CAPACITY: 2,000 PSF (ASSUMED).

2. WHERE FOOTING OR SLAB ON GRADE IS TO BE PLACED ON FILL, ALL TOPSOIL, ROOTS TRASH AND OTHER EXTRANEIOUS MATERIALS SHALL BE REMOVED AND REPLACED WITH SELECT FILL COMPACTED TO A MINIMUM OF 95% OF ITS MAXIMUM DENSITY AT ITS OPTIMUM MOISTURE CONTENT AS MEASURED BY THE TOP 12" SHALL BE COMPACTED TO A MINIMUM OF 98% EACH LAYER OF FILL SHALL BE NO GREATER THAN 8" THICK AND SHALL BE COMPACTED AS SPECIFIED PRIOR TO PLACEMENT OF THE FOLLOWING LAYER.

3. THE CONTRACTOR SHALL RETAIN AN INDEPENDENT TESTING AGENCY WITH A QUALIFIED GEOTECHNICAL ENGINEER LICENSED IN THE COMMONWEALTH OF VIRGINIA TO INSPECT AND APPROVE THE SUBGRADE INCLUDING FILL AND BACKFILL MATERIALS AND OPERATIONS. ALL FOUNDATION BEARING STRATA SHALL BE INSPECTED AND APPROVED BY THE GEOTECHNICAL ENGINEER PRIOR TO ANY CONCRETE PLACEMENT. IF UNSUITABLE SOILS ARE ENCOUNTERED, THE GEOTECHNICAL ENGINEER AND THE A/E SHALL DETERMINE THE MEANS OF CORRECTIVE ACTION INCLUDING BUT, NOT LIMITED TO ITEMS 4 OR 5 BELOW.

4. FOOTING BEARING ELEVATIONS SHALL BE LOWERED WHERE REQUIRED TO OBTAIN THE DESIGN SOIL BEARING CAPACITY HEREIN SPECIFIED.

5. FOOTINGS MAY BE UNDERCUT AND BACKFILLED WITH COMPACTED STONE OR INCREASED IN THICKNESS AS REQUIRED.

6. IT SHALL BE THE CONTRACTOR'S RESPONSIBILITY TO PROVIDE WELL-BRACED SHORING AT EXCAVATIONS NEAR EXISTING BUILDINGS AND CONSTRUCTION TO PREVENT SETTLEMENT AND TO PREVENT CAVE-INS.

7. ALL SLABS ON GRADE SHALL BE PLACED 10 MIL POLYETHYLENE VAPOR BARRIER OVER 4" BASE OF WELL-COMPACTED GRAVEL. THE GRAVEL SHALL BE PLACED ON ORIGINAL SOIL OR ON COMPACTED EARTH FILL AS DESCRIBED ABOVE.

8. PLACE CONCRETE FOR SLAB ON GRADE IN CONTINUOUS STRIPS AND PROVIDE CRACK CONTROL JOINTS AT LOCATIONS A MAXIMUM SPACING OF 15 FEET ON CENTER, UNLESS OTHERWISE NOTED.

CONCRETE:

1. ALL CONCRETE SHALL BE 145 PCF NORMAL WEIGHT WITH A COMPRESSIVE STRENGTH OF 4,000 PSI AT 28 DAYS:

2. ALL DETAILING, FABRICATION AND PROCEDURES OF CONCRETE PLACEMENT SHALL CONFORM WITH THE LATEST EDITIONS OF ACI 301 -- "SPECIFICATIONS FOR STRUCTURAL CONCRETE FOR BUILDINGS", ACI 315 -- "DETAILS AND DETAILING OF CONCRETE REINFORCEMENT", AND ACI 318 -- "BUILDING CODE REQUIREMENTS FOR REINFORCED CONCRETE.

3. REINFORCING BARS SHALL BE ROLLED FROM NEW BILLET STEEL CONFORMING WITH ASTM A615/A615M, GRADE 60, UNLESS OTHERWISE NOTED.

4. WELDED WIRE FABRIC SHALL CONFORM TO ASTM A185 AND A82.

5. THE FOLLOWING MINIMUM CONCRETE COVER SHALL BE PROVIDED FOR ALL REINFORCEMENT, UNLESS OTHERWISE NOTED:  
A. CONCRETE CAST AGAINST AND PERMANENTLY EXPOSED TO EARTH 3"  
B. CONCRETE EXPOSED TO EARTH OR WEATHER:  
#6 THROUGH #18 BARS 2"  
#5 BAR AND SMALLER 1 1/2"  
C. CONCRETE NOT EXPOSED TO EARTH OR WEATHER:  
SLABS, WALLS, AND JOISTS 3/4"  
BEAMS AND COLUMNS 1 1/2"

6. ISOLATION JOINT MATERIAL SHALL BE 1/2" THICK, UNLESS OTHERWISE NOTED.

7. PROVIDE CORNER BARS AT ALL FOOTING STEPS AND CORNERS UNLESS OTHERWISE NOTED. BARS SHALL BE A MINIMUM OF 2'-6" LONG AND SHALL HAVE THE SAME SIZE AND SPACING AS THE HORIZONTAL REINFORCING.

8. LAP ALL REINFORCING SPLICES AT LEAST 48 BAR DIAMETERS (24" MINIMUM) UNLESS OTHERWISE NOTED.

9. WELDED WIRE FABRIC SHALL HAVE END LAPS OF ONE FULL MESH PLUS 2" BETWEEN CROSS WIRES AND EDGE LAPS OBTAINED BY OVERLAPPING LONGITUDINAL SELVAGE WIRES 2" AND WIRING ALL LAPS SECURELY TOGETHER. WELDED WIRE FABRIC SHALL EXTEND INTO SUPPORT BEAMS AND WALLS FOR ANCHORAGE UNLESS AN EXPANSION JOINT IS INDICATED.

10. ALL REINFORCING SHALL BE SECURELY WIRED TOGETHER IN FORMS AS CALLED FOR IN "PLACING REINFORCING BARS" BY CRSI.

11. CHAMFER EXPOSED EDGES OF CONCRETE 3/4" UNLESS OTHERWISE NOTED.

STRUCTURAL STEEL:

1. STEEL MATERIALS SHALL CONFORM TO THE FOLLOWING SPECIFICATIONS:  
STRUCTURAL SHAPES AND PLATES ASTM A992/A992M, GRADE 50  
ANCHOR BOLTS ASTM A307 OR A36/A36M  
HIGH STRENGTH BOLTS ASTM A325

2. DESIGN, FABRICATION, ERECTION, AND WORKMANSHIP SHALL CONFORM TO THE "SPECIFICATION FOR STRUCTURAL STEEL BUILDINGS ALLOWABLE STRESS DESIGN AND PLASTIC DESIGN," AISC ASD, NINTH EDITION.

3. ALL SHOP AND FIELD WELDING SHALL BE EXECUTED BY WELDERS AND WELDING OPERATORS WHO HAVE BEEN PREVIOUSLY QUALIFIED BY TEST AS PRESCRIBED IN THE "CODE FOR WELDING IN BUILDING CONSTRUCTION", AWS D1.1, OF THE AMERICAN WELDING SOCIETY TO PERFORM THE TYPES OF WELDS REQUIRED ON THIS PROJECT.

4. ALL WELDING ELECTRODES SHALL BE E70XX SERIES.

5. SHOP PAINTING: ALL SURFACES SHALL BE PRIME PAINTED IN THE SHOP WITH AN APPROVED PRIMER COMPATIBLE WITH THE TOP COAT. PRIMER COAT SHALL HAVE A MINIMUM OF 2 MILS DRY FILM THICKNESS. SPOT PAINT ALL FIELD WELDS AND SERIOUS ABRASIONS TO THE SHOP COAT WITH PAINT COMPATIBLE WITH THE SHOP COAT. DO NOT PAINT STEEL SURFACES THAT ARE TO BE EMBEDDED IN CONCRETE OR MORTAR OR WHICH ARE TO RECEIVE SPRAYED-ON FIREPROOFING.

6. ALL EXPOSED STEEL SHALL BE PAINTED.

7. FLOOR GRATING SHALL BE GALVANIZED STEEL, WELDED TYPE WITH 1 3/4" X 1/8" BEARING BARS AT 1 3/16" ON CENTER AND CROSS BARS AT 4" ON CENTER, UNLESS OTHERWISE NOTED. METAL GRATING SHALL BE GALVANIZED COATING IN ACCORDANCE WITH ASTM A123/A123M, G90.

CONCRETE/BRICK MASONRY:

1. ALL DETAILING, FABRICATION, AND PROCEDURES OF CONCRETE MASONRY SHALL CONFORM WITH THE LATEST EDITIONS OF ACI 530.1 -- "SPECIFICATIONS FOR MASONRY STRUCTURES", AND ACI 530 -- "BUILDING CODE REQUIREMENTS FOR MASONRY STRUCTURES"

2. CONCRETE MASONRY UNITS SHALL CONFORM TO ASTM C90, GRADE N-1 UNLESS OTHERWISE NOTED. COMPRESSIVE STRENGTH ON NET CROSS SECTIONAL AREA OF INDIVIDUAL MASONRY UNIT SHALL BE 1900 PSI. NET AREA COMPRESSIVE STRENGTH OF MASONRY (FM) SHALL BE 1500 PSI.

3. MASONRY SHALL BE LAID IN ASTM C270, TYPE "S" MORTAR, UNLESS NOTED AND SHALL HAVE FULL MORTAR COVERAGE OF THE FACE SHELLS IN BOTH HORIZONTAL AND VERTICAL JOISTS.

4. GROUT FOR REINFORCED MASONRY SHALL CONFORM TO ASTM C476.

5. GROUT FOR REINFORCED MASONRY SHALL HAVE A COMPRESSIVE STRENGTH OF 3000 PSI AT 28 DAYS AND A SLUMP OF 8" TO 11".

6. MAXIMUM HEIGHT TO WHICH MASONRY SHALL BE LAID BEFORE FILLING IS 3 FEET FOR PEA GRAVEL CONCRETE AND 6 FEET FOR FINE GROUT.

7. PROVIDE CLEANOUT OPENINGS AT THE BOTTOM OF EACH GROUT LIFT. CLEANOUT OPENINGS SHALL BE PROVIDED AT EACH CELL TO BE FILLED WITH GROUT.

8. REINFORCING GRADE AND DETAILS SHALL BE THE SAME AS FOR CONCRETE. TIE IN POSITION AND PLACE CONCRETE AROUND REINFORCING DURING CONSTRUCTION OF MASONRY. DO NOT PUSH REINFORCING DOWN INTO PREVIOUSLY PLACED GROUT FILL. SET BOLT SIMILARLY.

9. HORIZONTAL BARS MAY BE SPLICED WITH A MINIMUM LAP OF 48 TIMES THE BAR DIAMETER, UNLESS OTHERWISE NOTED.

10. PROVIDE HORIZONTAL REINFORCING AT 16" ON VERTICAL CENTER AND IN JOINTS IMMEDIATELY ABOVE AND BELOW ALL OPENINGS. EXTEND REINFORCEMENT A MINIMUM OF 2'-0" BEYOND THE JAMB ON EACH SIDE OF AN OPENING. HORIZONTAL JOINT REINFORCING SHALL BE LAPPED A MINIMUM OF 8". JOINT REINFORCING SHALL STOP AT CONTROL JOINTS. HORIZONTAL REINFORCING SHALL BE GALVANIZED LADDER TYPE JOINT REINFORCEMENT WITH (2) 9 GAGE (W1.7) RODS AND 9 GAGE CROSS RODS, HOT-DIPPED GALVANIZED AFTER FABRICATION PER ASTM A153 -- CLASS B-2.

11. SPLICED VERTICAL REINFORCING BARS SHALL OCCUPY THE SAME CELL. MINIMUM LAP SPLICE SHALL BE 24" FOR #3 AND #4 BARS AND 36" FOR #5 AND #6 BARS. SPLICED BARS SHALL BE TIED TOGETHER.

12. VERTICAL REINFORCEMENT IN WALLS SHALL BE SUPPORTED AND SECURED AGAINST DISPLACEMENT AT 4 FOOT MAXIMUM INTERVALS.

13. IN ADDITION TO VERTICAL REINFORCING DETAILED ON THE DRAWINGS, PROVIDE VERTICAL REINFORCING TO MATCH SIZE DETAILED AT THE FOLLOWING LOCATIONS:  
a. CELLS EACH SIDE OF OPENINGS (SUCH AS DOORS, WINDOWS, ETC.)  
b. CELLS EACH SIDE OF CONTROL JOINTS.  
c. CELL AT END OF A WALL.  
d. AT INTERSECTIONS (CELL WITHIN 8" OF INTERSECTION).  
e. THREE BARS EACH CORNER (CORNER CELL AND ADJACENT CELLS IN EACH DIRECTION).

14. THE MASONRY CONTRACTOR SHALL PROVIDE AND PLACE SUCH SPECIAL UNITS AS MAY BE REQUIRED TO FORM ALL CORNERS, RETURNS, AND OFFSETS WHILE MAINTAINING THE PROPER BOND.

15. WHERE INTERIOR CONCRETE MASONRY PARTITIONS INTERSECT WITH OTHER INTERIOR PARTITIONS OR EXTERIOR WALLS, A MASONRY BOND, OR THE EQUIVALENT IN APPROVED METAL TIES, SHALL BE PROVIDED UNLESS NOTED OTHERWISE ON THE DRAWINGS.

16. FACE SHELL BEDDING SHALL BE USED WITH COMPLETE COVERAGE OF FACE SHELLS. FURROWING OF THE MORTAR SHALL NOT BE PERMITTED.

17. MORTAR JOINTS SHALL BE 3/8" THICK WITH FULL MORTAR COVERAGE ON VERTICAL AND HORIZONTAL FACE SHELLS.

18. PROVIDE BOND BEAMS AT MASONRY ELEVATIONS AS SHOWN ON THE DRAWINGS. BOND BEAMS SHALL HAVE TWO #5 BARS, CONTINUOUS, UNLESS OTHERWISE NOTED. BOND BEAMS SHALL BE CONTINUOUS AROUND THE PERIMETER OF THE BUILDING AND ALONG INTERIOR PARTITIONS, UNLESS OTHERWISE NOTED. BOND BEAM REINFORCING SHALL BE CONTINUOUS THROUGH CONTROL JOINTS. CUT IN OR RAKE OUT A VERTICAL JOINT MATCHING THE CONTROL JOINT AS REQUIRED.

19. LINTELS OVER ALL OPENINGS IN INTERIOR MASONRY PARTITIONS, NOT OTHERWISE DETAILED, SHALL BE OF PRECAST CONCRETE MASONRY WITH THICKNESS EQUAL TO THE WALL THICKNESS. DEPTH SHALL BE 8" FOR SPANS UP TO 6'-0" REINFORCED WITH ONE (1) #5 BAR FOR EACH 4" OF WALL THICKNESS.

WOOD FRAMING AND PLYWOOD:

1. ALL WOOD FRAMING SHALL BE KILN DRIED NO. 2 DENSE (OR BETTER) DIMENSION SOUTHERN YELLOW PINE CONFORMING TO SOUTHERN PINE INSPECTION BUREAU GRADING RULES, AND SHALL KILN DRIED TO 19% MAXIMUM MOISTURE CONTENT, UNLESS OTHERWISE NOTED.

2. PLYWOOD FOR SHEATHING SHALL CONFORM TO THE GRADING RULES OF U.S. PRODUCT STANDARD PS 1, LATEST EDITION, AND SHALL HAVE APPROPRIATE GRADE TRADE MARK OF AN AMERICAN PLYWOOD ASSOCIATION APPROVED AGENCY ON EACH PLYWOOD PANEL. SHEATHING SHALL BE APA STRUCTURAL I RATED, EXTERIOR GRADE, IN THICKNESS SHOWN ON DRAWINGS. SHEATHING SHALL BE APPLIED IN FULL SHEETS, OR AS SHOWN ON THE PLANS OR IN LARGEST PIECES FOR THE AREA BEING COVERED WITH A MINIMUM TWO SPAN CONTINUOUS CONDITION WITH LONGER FACTORY EDGE PERPENDICULAR TO THE FRAMING MEMBERS, WITH END JOINTS STAGGERED, AND SHEET ENDS BEARING ON FRAMING MEMBERS.

3. ALL NAILING FOR WOOD CONSTRUCTION SHALL BE IN ACCORDANCE WITH INTERNATIONAL BUILDING CODE'S FASTENING SCHEDULE (TABLE 2304.9.1).

WOOD TRUSSES:

1. SUBMIT WOOD TRUSS DESIGN CALCULATIONS AND SHOP DRAWINGS FOR REVIEW PRIOR TO FABRICATION. SHOP DRAWING FOR WOOD TRUSSES SHALL BEAR THE SEAL OF AN ENGINEER REGISTERED IN THE STATE WHERE THE PROJECT IS LOCATED AND SHALL BE APPROVED BY THE ENGINEER OR ARCHITECT BEFORE FABRICATION. SHOP DRAWINGS SHALL SHOW SPECIES AND MOISTURE CONTENT OF WOOD BEING USED. ALLOWABLE STRESSES SHALL CONFORM TO THE LATEST EDITION OF "NATIONAL DESIGN SPECIFICATION FOR STRESS-GRADE LUMBER AND ITS FASTENING", AS RECOMMENDED BY THE NATIONAL FOREST PRODUCTS ASSOCIATION.

2. LUMBER IN TRUSSES SHALL BE GRADE MARKED, NO. 2 DIMENSION, KILN-DRIED SOUTHERN ONE, OR BETTER, UNLESS OTHERWISE INDICATED ON THE DETAILS EXCEPT TRUSS WEB MEMBERS MAY BE NO. 3, KILN-DRIED, GRADE MARKED, SOUTHERN PINE. MAXIMUM ALLOWABLE MOISTURE CONTENT =15%.

3. PROVIDE WASHERS BETWEEN ALL BOLT HEADS AND WOOD AND BETWEEN ALL NUTS AND WOOD.

4. MAXIMUM TRUSS SPACING = 2'-0" ON CENTER, UNLESS OTHERWISE NOTED.

5. CENTROIDAL LINES OF MEMBERS SHALL INTERSECT AT A POINT UNLESS OTHERWISE NOTED.

6. ENDS OF ALL COMPRESSION MEMBERS SHALL BE CUT TO FIT INTERSECTING MEMBERS FOR POSITIVE END BEARING.

7. TRUSS JOINT CONNECTIONS SHALL BE MADE USING GALVANIZED STEEL CONNECTOR PLATES, 20 GAGE MINIMUM THICKNESS. THE TRUSS JOINT CONNECTOR PLATES SHALL BE SIZED BY THE FABRICATOR USING THE TRUSS MEMBER FORCES RESULTING IN THE DESIGN LOADS SHOWN BELOW AND IN THE DESIGN CRITERIA.

8. THE LUMBER SPECIES, TRUSS OVERALL CONFIGURATION AND MINIMUM MEMBER SIZES AND TRADES SHALL NOT BE ALTERED OR REDUCED. MEMBER SPECIES, SIZE AND GRADES OF EQUAL OR GREATER STRENGTH ARE ACCEPTABLE.

9. THE CONTRACTOR SHALL PROVIDE ALL CONNECTION MATERIALS, CONNECTOR PLATES, FRAMING ANCHORS AND ACCESSORIES AS REQUIRED FOR THE SUPPORT OF THE WOOD TRUSSES AND WOOD FRAMING.

10. WOOD TRUSSES SHALL BE CAMBERED AS REQUIRED TO OFFSET THE FULL DEAD LOAD DEFLECTION.

11. WOOD TRUSSES SHALL BE DESIGNED BY THE MANUFACTURER FOR THE WIND AND SEISMIC LOADS INDICATED IN THE DESIGN CRITERIA ALONG WITH THE FULL TRUSS DEAD LOAD AND THE FOLLOWING SUPERIMPOSED GRAVITY LOADS:  
A. SUPERIMPOSED DEAD LOADS:  
TOP CHORD 15 PSF  
BOTTOM CHORD 10 PSF  
B. LIVE LOADS:  
TOP CHORD 20 PSF  
BOTTOM CHORD 20 PSF (CENTER 1/3 OF TRUSS LENGTH)

GENERAL:

1. GOVERNING BUILDING CODE:  
2006 VIRGINIA UNIFORM STATEWDE BUILDING CODE  
(2006 INTERNATIONAL BUILDING CODE)

2. UNIFORM FLOOR LIVE LOADS:  
ALL FLOORS, EXCEPT AS NOTED 250 PSF

3. ROOF LIVE LOAD (NON-REDUCIBLE) 20 PSF

4. WIND LOAD CRITERIA:  
BASIC WIND SPEED 90 MPH  
WIND IMPORTANCE FACTOR (IW) 1.15  
WIND EXPOSURE CONDITION C  
INTERNAL PRESSURE COEFFICIENT (GCPI) 0.18  
BUILDING CATEGORY III

5. SNOW LOAD CRITERIA:  
GROUND SNOW LOAD (PG) 25 PSF  
FLAT ROOF SNOW LOAD (PF) 20 PSF  
SNOW EXPOSURE FACTOR (CE) 1.0  
SNOW IMPORTANCE FACTOR (IS) 1.1  
SNOW THERMAL FACTOR (CT) 1.0

6. SEISMIC LOAD CRITERIA:  
SEISMIC IMPORTANCE FACTOR (IE) 1.25  
SEISMIC OCCUPANCY CATEGORY III  
MAPPED SPECTRAL RESPONSE COEFFICIENT, (SS) 0.25  
MAPPED SPECTRAL RESPONSE COEFFICIENT, (S1) 0.07  
SITE CLASS (ASSUMED/PER GEOTECHNICAL REPORT) D  
SPECTRAL RESPONSE COEFFICIENT, (SDS) 0.267  
SPECTRAL RESPONSE COEFFICIENT, (SD1) 0.112  
SEISMIC DESIGN CATEGORY C  
DESIGN BASE SHEAR 14 KIPS  
SEISMIC RESPONSE COEFFICIENT, (CS)0.11  
RESPONSE MODIFICATION FACTOR (R) 3

7. SUBMIT SHOP DRAWINGS AND MATERIAL CERTIFICATIONS FOR REVIEW FOR THE FOLLOWING ITEMS. DO NOT FABRICATE MATERIALS UNTIL SHOP DRAWINGS HAVE BEEN REVIEWED AND ALL EXCEPTIONS HAVE BEEN RESOLVED.  
A. CONCRETE MIX DESIGNS, TESTS AND CERTIFICATES  
B. CONCRETE REINFORCING STEEL SHOP DRAWINGS  
C. MASONRY UNIT TESTS AND CERTIFICATES  
D. MASONRY REINFORCING STEEL SHOP DRAWINGS  
E. MASONRY MORTAR AND GROUT MIX DESIGNS, TESTS AND CERTIFICATES  
F. ROOF TRUSS SHOP DRAWINGS AND DESIGN CALCULATION BEARING THE SEAL OF A REGISTERED PROFESSIONAL ENGINEER.

8. CONTRACT DRAWINGS SHALL NOT BE MARKED AND SUBMITTED AS SHOP DRAWINGS.

9. THE CONTRACTOR SHALL VERIFY ALL EXISTING FIELD CONDITIONS, DIMENSIONS, AND ELEVATIONS BEFORE PROCEEDING WITH CONSTRUCTION. THE CONTRACTOR SHALL LOCATE ALL EXISTING UNDERGROUND UTILITIES AND PROTECT FROM DAMAGE DURING EXCAVATION AND BACKFILLING OPERATIONS.

10. STRUCTURAL FRAMING SHALL BE TEMPORARILY BRACED UNTIL ERECTION IS COMPLETE AND PERMANENT CONNECTIONS AND BRACING MEMBERS ARE INSTALLED.

11. ALL STRUCTURAL MATERIALS, COMPONENTS AND SYSTEMS SHALL BE TESTED AND INSPECTED IN ACCORDANCE WITH THE REQUIREMENTS OF THE APPLICABLE BUILDING CODE. SUBMIT INSPECTION REPORTS FOR REVIEW BY THE A/E. CONTRACTOR SHALL PROVIDE TEST AND INSPECTION SERVICES BY A QUALIFIED TESTING AND INSPECTION FIRM.

FOUNDATIONS:

1. DESIGN SOIL BEARING CAPACITY: 2,000 PSF (ASSUMED).

2. WHERE FOOTING OR SLAB ON GRADE IS TO BE PLACED ON FILL, ALL TOPSOIL, ROOTS TRASH AND OTHER EXTRANEIOUS MATERIALS SHALL BE REMOVED AND REPLACED WITH SELECT FILL COMPACTED TO A MINIMUM OF 95% OF ITS MAXIMUM DENSITY AT ITS OPTIMUM MOISTURE CONTENT AS MEASURED BY THE TOP 12" SHALL BE COMPACTED TO A MINIMUM OF 98% EACH LAYER OF FILL SHALL BE NO GREATER THAN 8" THICK AND SHALL BE COMPACTED AS SPECIFIED PRIOR TO PLACEMENT OF THE FOLLOWING LAYER.

3. THE CONTRACTOR SHALL RETAIN AN INDEPENDENT TESTING AGENCY WITH A QUALIFIED GEOTECHNICAL ENGINEER LICENSED IN THE COMMONWEALTH OF VIRGINIA TO INSPECT AND APPROVE THE SUBGRADE INCLUDING FILL AND BACKFILL MATERIALS AND OPERATIONS. ALL FOUNDATION BEARING STRATA SHALL BE INSPECTED AND APPROVED BY THE GEOTECHNICAL ENGINEER PRIOR TO ANY CONCRETE PLACEMENT. IF UNSUITABLE SOILS ARE ENCOUNTERED, THE GEOTECHNICAL ENGINEER AND THE A/E SHALL DETERMINE THE MEANS OF CORRECTIVE ACTION INCLUDING BUT, NOT LIMITED TO ITEMS 4 OR 5 BELOW.

4. FOOTING BEARING ELEVATIONS SHALL BE LOWERED WHERE REQUIRED TO OBTAIN THE DESIGN SOIL BEARING CAPACITY HEREIN SPECIFIED.

5. FOOTINGS MAY BE UNDERCUT AND BACKFILLED WITH COMPACTED STONE OR INCREASED IN THICKNESS AS REQUIRED.

6. IT SHALL BE THE CONTRACTOR'S RESPONSIBILITY TO PROVIDE WELL-BRACED SHORING AT EXCAVATIONS NEAR EXISTING BUILDINGS AND CONSTRUCTION TO PREVENT SETTLEMENT AND TO PREVENT CAVE-INS.

7. ALL SLABS ON GRADE SHALL BE PLACED 10 MIL POLYETHYLENE VAPOR BARRIER OVER 4" BASE OF WELL-COMPACTED GRAVEL. THE GRAVEL SHALL BE PLACED ON ORIGINAL SOIL OR ON COMPACTED EARTH FILL AS DESCRIBED ABOVE.

8. PLACE CONCRETE FOR SLAB ON GRADE IN CONTINUOUS STRIPS AND PROVIDE CRACK CONTROL JOINTS AT LOCATIONS A MAXIMUM SPACING OF 15 FEET ON CENTER, UNLESS OTHERWISE NOTED.

CONCRETE:

1. ALL CONCRETE SHALL BE 145 PCF NORMAL WEIGHT WITH A COMPRESSIVE STRENGTH OF 4,000 PSI AT 28 DAYS:

2. ALL DETAILING, FABRICATION AND PROCEDURES OF CONCRETE PLACEMENT SHALL CONFORM WITH THE LATEST EDITIONS OF ACI 301 -- "SPECIFICATIONS FOR STRUCTURAL CONCRETE FOR BUILDINGS", ACI 315 -- "DETAILS AND DETAILING OF CONCRETE REINFORCEMENT", AND ACI 318 -- "BUILDING CODE REQUIREMENTS FOR REINFORCED CONCRETE.

3. REINFORCING BARS SHALL BE ROLLED FROM NEW BILLET STEEL CONFORMING WITH ASTM A615/A615M, GRADE 60, UNLESS OTHERWISE NOTED.

4. WELDED WIRE FABRIC SHALL CONFORM TO ASTM A185 AND A82.

5. THE FOLLOWING MINIMUM CONCRETE COVER SHALL BE PROVIDED FOR ALL REINFORCEMENT, UNLESS OTHERWISE NOTED:  
A. CONCRETE CAST AGAINST AND PERMANENTLY EXPOSED TO EARTH 3"  
B. CONCRETE EXPOSED TO EARTH OR WEATHER:  
#6 THROUGH #18 BARS 2"  
#5 BAR AND SMALLER 1 1/2"  
C. CONCRETE NOT EXPOSED TO EARTH OR WEATHER:  
SLABS, WALLS, AND JOISTS 3/4"  
BEAMS AND COLUMNS 1 1/2"

6. ISOLATION JOINT MATERIAL SHALL BE 1/2" THICK, UNLESS OTHERWISE NOTED.

7. PROVIDE CORNER BARS AT ALL FOOTING STEPS AND CORNERS UNLESS OTHERWISE NOTED. BARS SHALL BE A MINIMUM OF 2'-6" LONG AND SHALL HAVE THE SAME SIZE AND SPACING AS THE HORIZONTAL REINFORCING.

8. LAP ALL REINFORCING SPLICES AT LEAST 48 BAR DIAMETERS (24" MINIMUM) UNLESS OTHERWISE NOTED.

9. WELDED WIRE FABRIC SHALL HAVE END LAPS OF ONE FULL MESH PLUS 2" BETWEEN CROSS WIRES AND EDGE LAPS OBTAINED BY OVERLAPPING LONGITUDINAL SELVAGE WIRES 2" AND WIRING ALL LAPS SECURELY TOGETHER. WELDED WIRE FABRIC SHALL EXTEND INTO SUPPORT BEAMS AND WALLS FOR ANCHORAGE UNLESS AN EXPANSION JOINT IS INDICATED.

10. ALL REINFORCING SHALL BE SECURELY WIRED TOGETHER IN FORMS AS CALLED FOR IN "PLACING REINFORCING BARS" BY CRSI.

11. CHAMFER EXPOSED EDGES OF CONCRETE 3/4" UNLESS OTHERWISE NOTED.

STRUCTURAL STEEL:

1. STEEL MATERIALS SHALL CONFORM TO THE FOLLOWING SPECIFICATIONS:  
STRUCTURAL SHAPES AND PLATES ASTM A992/A992M, GRADE 50  
ANCHOR BOLTS ASTM A307 OR A36/A36M  
HIGH STRENGTH BOLTS ASTM A325

2. DESIGN, FABRICATION, ERECTION, AND WORKMANSHIP SHALL CONFORM TO THE "SPECIFICATION FOR STRUCTURAL STEEL BUILDINGS ALLOWABLE STRESS DESIGN AND PLASTIC DESIGN," AISC ASD, NINTH EDITION.</

Mar 14, 2012 4:11pm V:\entp\projects\20080815.dwg\asbuilts-WTP\ASBUILT-SITE-TANK-DETAILS.dwg

- BRICK VENEER:**
- FACE BRICK SHALL CONFORM TO ASTM C 216 WITH A GRADE OF SW AND BE TYPE FBS. SIZE OF BRICK SHALL BE 3 5/8 INCHES WIDE BY 2 1/4 INCHES HIGH BY 7 5/8 INCHES LONG. USE SPECIAL SHAPES FOR APPLICATIONS WHERE SHAPES PRODUCED BY SAWING WOULD RESULT IN SAWED SURFACES BEING EXPOSED TO VIEW.
  - MORTAR SHALL CONFORM TO ASTM C 270 PROPORTION SPECIFICATION. DO NOT USE CALCIUM CHLORIDE IN MORTAR. USE TYPE S MORTAR. FOR FACE BRICK USE COLORED CEMENT OR CEMENT-LIME MIX OF COLOR SELECTED.
  - JOINT REINFORMENT SHALL CONFORM TO ASTM A 951. REINFORMENT SHALL BE HOT-DIP GALVANIZED. THE WIRE DIAMETER FOR SIDE RODS SHALL BE W2.8 OR 0.188 INCHES. THE WIRE DIAMETER FOR CROSS RODS SHALL BE W2.8 OR 0.188 INCHES. FOR MULTIPLYTHE MASONRY, PROVIDE LADDER DESIGN WITH THREE SIDE RODS.
  - SHEET METAL FLASHING SHALL BE COPPER WITH 10-OZ/SQ. FT WEIGHT OR 0.0135 INCH THICK FOR FULLY CONCEALED FLASHING, 16 OZ/SQ. FT. WEIGHT OR 0.0216 INCH THICK ELSWHERE.
  - LAMINATED FLASHING SHALL BE 7 OZ/SQ. FT. COPPER SHEET BONDED WITH ASPHALT BETWEEN 2 LAYERS OF GLASS-FIBER CLOTH.
  - WEEP HOLES SHALL BE COTTON OR POLYESTER ROPE, 1/4 TO 3/8 INCH IN DIAMETER AND 24 INCHES LONG.
  - PROPIETARY ACIDIC MASONRY CLEANER SHALL BE A PRODUCT EXPRESSLY APPROVED FOR INTENDED USE BY CLEANER MANUFACTURER AND MANUFACTURER OF MASONRY UNITS.
  - GENERAL INSTALLATION:
    - CUT MASONRY UNITS WITH SAW. INSTALL WITH CUT SURFACES AND, AND WHERE POSSIBLE, CUT EDGES CONCEALED.
    - MIX UNITS FOR EXPOSED UNIT MASONRY FROM SEVERAL PALLETS OR CUBES AS THEY ARE PLACED TO PRODUCE UNIFORM BLEND OF COLORS AND TEXTURES.
    - MATCH EXISTING MASONRY BY MATCHING THE COURSING, BONDING, COLOR, AND TEXTURE OF EXISTING MASONRY.
    - WHEN STOPPING AND RESUMING WORK, RACK BACK UNITS AND DO NOT TOOTH.
    - TOOL EXPOSED JOINTS SLIGHTLY CONCAVE WHEN THUMBPRINT HARD, UNLESS OTHERWISE INDICATED.
    - KEEP CAVITIES CLEAN OF MORTAR DROPPINGS AND OTHER MATERIALS DURING CONSTRUCTION.
  - LINTELS:
    - INSTALL LINTELS WHERE INDICATED.
    - MINIMUM BEARING OF 8 INCHES AT EACH JAMB, UNLESS OTHERWISE INDICATED.
  - FLASHING AND WEEP HOLES:
    - INSTALL EMBEDDED FLASHING AND WEEP HOLES IN MASONRY AT SHELF ANGLES, LINTELS, LEDGES, OTHER OBSTRUCTIONS TO THE DOWNWARD FLOW OF WATER IN THE WALL, AND WHERE INDICATED.
    - PLACE THROUGH-WALL FLASHING ON SLOPING BED OF MORTAR AND COVER WITH MORTAR. SEAL PENETRATIONS IN FLASHING BEFORE COVERING WITH MORTAR. EXTEND FLASHING 4 INCHES INTO MASONRY AT EACH END AND TURN UP 2 INCHES TO FORM A PAN.
    - TRIM WICKING MATERIAL USED IN WEEP HOLES FLUSH WITH OUTSIDE FACE OF WALL AFTER MORTAR HAS SET.
  - CLEANING:
    - CLEAN MASONRY AS WORK PROGRESSES. REMOVE MORTAR FINS AND SMEARS BEFORE TOOLING JOINTS.
    - FINAL CLEANING MAY BE STARTED AFTER MORTAR IS THOROUGHLY CURES. CLEAN EXPOSED MASONRY. IF ACIDIC CLEANER IS TO BE USED, WET WALL SURFACES WITH WATER BEFORE APPLYING ACIDIC CLEANER, THEN REMOVE CLEANER PROMPTLY BY RINSING THOROUGHLY WITH CLEAR WATER. CLEAN MASONRY WITH A PROPRIETARY ACIDIC CLEANER APPLIED ACCORDING TO MANUFACTURER'S WRITTEN INSTRUCTIONS.
  - BUILDING INSULATION:
    - INSULATION PRODUCTS:
      - KRAFT-FACED, GLASS-FIBER BLANKET INSULATION: ASTM C 665, TYPE II (NON-REFLECTIVE FACED), CLASS C (FACED SURFACE NOT RATED FOR FLAME PROPAGATION), CATEGORY 1 (MEMBRANE IS A VAPOR BARRIER).
      - FOAMED-IN-PLACE BUILDING INSULATION FOR EXTERIOR CMU WALLS. ACCEPTABLE PRODUCTS/MANUFACTURERS OR APPROVED EQUALS:
        - TRIPOLYMER BY C.P. CHEMICAL CO., INC., [WWW.TRIPOLYMER.COM](http://WWW.TRIPOLYMER.COM)
        - POLYMASTER R-501 FOAM INSULATION BY POLYMASTER, INC., [WWW.POLYMASTER.COM](http://WWW.POLYMASTER.COM)
        - THERMOCO BY THERMAL CORPORATION OF AMERICA, [WWW.THERMOCOFOAM.COM](http://WWW.THERMOCOFOAM.COM)
    - ACCESSORIES:
      - EAVE VENTILATION TROUGHS SHALL BE PREFORMED, RIGID FIBERBOARD OR PLASTIC SHEETS DESIGNED TO FIT BETWEEN ROOF FRAMING MEMBERS AND TO PROVIDE CROSS-VENTILATION BETWEEN ATTIC SPACES AND VENIED EAVES.
    - INSTALLATION:
      - INSTALL INSULATION IN AREAS AND IN THICKNESSES INDICATED OR REQUIRED TO PRODUCE R-VALUES INDICATED. CUT AND FIT TIGHTLY AROUND OBSTRUCTIONS AND FILL VOIDS WITH INSULATION.
      - EXCEPT FOR LOOSE-FILL INSULATION AND INSULATION THAT IS FRICTION FITTED IN STUD CAVITIES, BOND UNITS TO SUBSTRATE WITH ADHESIVE OR USE MECHANICAL ANCHORAGE TO PROVIDE PERMANENT PLACEMENT AND SUPPORT OF UNITS.

**ASPHALT SHINGLES:**

    - FIBERGLASS SHINGLES SHALL COMPLY WITH ASTM D 3462 AND BE MULTITAB-STRIP ASPHALT SHINGLES SHALL BE MINERAL-GRANULE SURFACED AND SELF-SEALING. THREE TABS, REGULARLY SPACED WITH STAGGER CUT BUTT EDGE.
    - ACCESSORIES:
      - FELTS SHALL COMPLY WITH ASTM D 226, TYPE I, ASPHALT-SATURATED ORGANIC FELTS.
      - SELF-ADHERING SHEET UNDERLAYMENT SHALL COMPLY WITH ASTM D 1970, SBS-MODIFIED ASPHALT, MINERAL-GRANULE OR SLIP-RESISTING-POLYETHYLENE SURFACED, WITH RELEASE PAPER BACKING, AND COLD-APPLIED.
      - RIDGE-VENT SHALL BE RIGID UV-STABILIZED PLASTIC RIDGE-VENT WITH NONWOVEN GEOTEXTILE FILTER STRIPS, FOR USE UNDER RIDGE SHINGLES.
      - ROOFING NAILS SHALL BE ALUMINUM, STAINLESS STEEL, OR HOT-DIP GALVANIZED-STEEL SHINGLE NAILS, MINIMUM 0.120 INCH DIAMETER, OF SUFFICIENT LENGTH TO PENETRATE 3/4 INCH INTO SOLID WOOD DECKING OR EXTEND AT LEAST 1/8 INCH THROUGH OSB OR PLYWOOD SHEATHING.
    - SHEET METAL FLASHING AND TRIM:
      - SHEET METAL SHALL BE COPPER.
      - FABRICATE SHEET METAL FLASHING AND TRIM TO COMPLY WITH RECOMMENDATIONS IN SMACNA'S "ARCHITECTURAL SHEET METAL MANUAL."
      - DRIP EDGE SHALL BE FORMED SHEET METAL WITH AT LEAST A 2 INCH ROOF DECK FLANGE AND A 1-1/2 INCH FASCIA FLANGE WITH A 3/8 INCH DRIP AT LOWER EDGE.
    - INSTALLATION:
      - COMPLY WITH RECOMMENDATIONS IN ARMA'S "RESIDENTIAL ASPHALT ROOFING MANUAL" AND WITH ASPHALT SHINGLE RECOMMENDATIONS IN NRCA'S "THE NRCA ROOFING AND WATERPROOFING MANUAL."
      - APPLY SELF-ADHERING SHEET UNDERLAYMENT AT EAVES AND RAKES FROM EDGES TO ROOF TO AT LEAST 24 INCHES INSIDE EXTERIOR WALL LINE.
      - INSTALL FIRST AND REMAINING COURSES OF ASPHALT SHINGLES STAIR-STEPPING DIAGONALLY ACROSS ROOF DECK WITH MANUFACTURER'S RECOMMENDED OFFSET PATTERN AT SUCCEEDING COURSES, MAINTAINING UNIFORM EXPOSURE.

- GYPSUM BOARD:**
- PANEL PRODUCTS:
    - PROVIDE IN MAXIMUM LENGTHS AVAILABLE TO MINIMIZE END-TO-END BUTT JOINTS.
    - MOISTURE RESISTANT GYPSUM BOARD: WATER-RESISTANT GYPSUM BACKING BOARD SHALL COMPLY WITH ASTM C 630 OR ASTM C 1396, IN THICKNESS INDICATED. REGULAR TYPE UNLESS OTHERWISE INDICATED.
  - ACCESSORIES:
    - JOINT TREATMENT MATERIALS SHALL COMPLY WITH ASTM C 475.
    - JOINT TAPE SHALL BE PAPER UNLESS OTHERWISE RECOMMENDED BY PANEL MANUFACTURER.
    - JOINT COMPOUNDS SHALL BE SETTING-TYPE TAPING COMPOUND AND DRYING-TYPE, READY-MIXED, COMPOUNDS FOR TOPPING.
  - INSTALLATION:
    - INSTALL GYPSUM BOARD TO COMPLY WITH ASTM C 840.
    - FOR SINGLE-LAYER FASTENING METHODS, FASTEN GYPSUM PANELS TO SUPPORTS WITH SCREWS.
    - FINISHING GYPSUM BOARD SHALL COMPLY WITH ASTM C 840.
    - AT CONCEALED AREAS, UNLESS A HIGHER LEVEL OF FINISH IS REQUIRED FOR FIRE-RESISTANCE-RATED ASSEMBLIES, PROVIDE LEVEL 1 FINISH: EMBED TAPE AT JOINTS.
    - UNLESS OTHERWISE INDICATED, PROVIDE LEVEL 4 FINISH: EMBED TAPE AND APPLY SEPARATE FIRST, FILL, AND FINISH COATS OF JOINT COMPOUND TO TAPE, FASTENERS, AND TRIM FLANGES.

- PAINTING:**
- PAINT PRODUCTS AND MATERIALS SHALL BE COMPATIBLE WITH ONE ANOTHER AND WITH SUBSTRATES.
  - FOR EACH COAT IN A PAINT SYSTEM, PROVIDE PRODUCTS RECOMMENDED IN WRITING BY MANUFACTURERS OF TOPCOAT FOR USE IN PAINT SYSTEM AND ON SUBSTRATE INDICATED.
  - COLOR SHALL BE AS SELECTED FROM MANUFACTURER'S FULL RANGE.
  - SURFACE PREPARATION:
    - REMOVE HARDWARE, LIGHTING FIXTURES, AND SIMILAR ITEMS THAT ARE NOT TO BE PAINTED. MASK ITEMS THAT CANNOT BE REMOVED. REINSTALL ITEMS IN EACH AREA AFTER PAINTING IS COMPLETE.
    - CLEAN AND PREPARE SURFACES IN AN AREA BEFORE BEGINNING PAINTING IN THAT AREA. SCHEDULE PAINTING SO CLEANING OPERATIONS WILL NOT DAMAGE NEWLY PAINTED SURFACES.
  - PAINT APPLICATION:
    - APPLY PAINTS ACCORDING TO MANUFACTURER'S WRITTEN INSTRUCTIONS.
    - USE BRUSHES ONLY FOR EXTERIOR PAINTING AND WHERE THE USE OF OTHER APPLICATORS IS NOT PRACTICAL.
    - USE ROLLERS FOR FINISH COAT ON INTERIOR WALLS AND CEILINGS.
    - APPLYING PAINTS TO PRODUCE SURFACE FILMS WITHOUT CLOUDINESS, SPOTTING, HOLIDAYS, LAPS, BRUSH MARKS, ROLLER TRACKING, RUNS, SAGS, ROPINESS, OR OTHER SURFACE IMPERFECTIONS. CUT IN SHARP LINES AND COLOR BREAKS.
    - IF UNDERCOATS OR OTHER CONDITIONS SHOW THROUGH TOPCOAT, APPLY ADDITIONAL COATS UNTIL CURED FILM HAS A UNIFORM PAINT FINISH, COLOR, AND APPEARANCE.
  - EXTERIOR PAINT APPLICATION SCHEDULE:
    - STEEL (LINTELS, DOORS, FRAMES, ETC.): SEMIGLOSS, ALKYD ENAMEL SHALL HAVE TWO COATS OVER RUST-INHIBITIVE PRIMER THAT COMPLIES WITH MPI EXT 5.1D.
    - GALVANIZED METAL: SEMIGLOSS, ALKYD ENAMEL SHALL HAVE TWO COATS OVER CEMENTITIOUS GALVANIZED-METAL PRIMER THAT COMPLIES WITH MPI EXT 5.3B.
    - HARDIE BOARD SIDING FOR FASCIA AND SOFFIT: PAINT WITH MANUFACTURER'S RECOMMENDED PAINT SYSTEM.
  - INTERIOR PAINT APPLICATION SCHEDULE:
    - CONCRETE MASONRY UNITS (ALL INTERIOR MASONRY WALLS: SEMIGLOSS LATEX SHALL HAVE TWO COATS OVER LATEX BLOCK FILLER THAT COMPLIES WITH MPI INT 4.2C.
    - STEEL: SEMIGLOSS, ALKYD ENAMEL SHALL HAVE TWO COATS OVER ALKYD ANTICORROSIVE PRIMER THAT COMPLIES WITH MPI INT 5.1E.
    - GALVANIZED METAL: SEMIGLOSS, ALKYD ENAMEL SHALL HAVE TWO COATS OVER CEMENTITIOUS GALVANIZED-METAL PRIMER THAT COMPLIES WITH MPI INT 5.1C.
    - GYPSUM BOARD: EGGSHELL ALKYD SHALL HAVE TWO COATS OVER LATEX PRIMER/SEALER THAT COMPLIES WITH MPI INT 9.2C.

GENERAL STRUCTURAL NOTES-ASBUILT

FOR



TOWN OF BOONES MILL WATER SYSTEM REPLACEMENT, VOLUME 2

TOWN OF BOONES MILL, BOONE DISTRICT, FRANKLIN COUNTY, VA


PROJECT NO.	20080815
G.L. NO.	297-03-A3.9
FILE NO.	G-12675
DATE:	7/31/09
DRAWN BY:	ASK
CHECKED BY:	BC

2	9/3/09	OWNER COMMENTS
4	11/17/09	FRANKLIN COUNTY COMMENTS
5	3/14/12	ASBUILTS





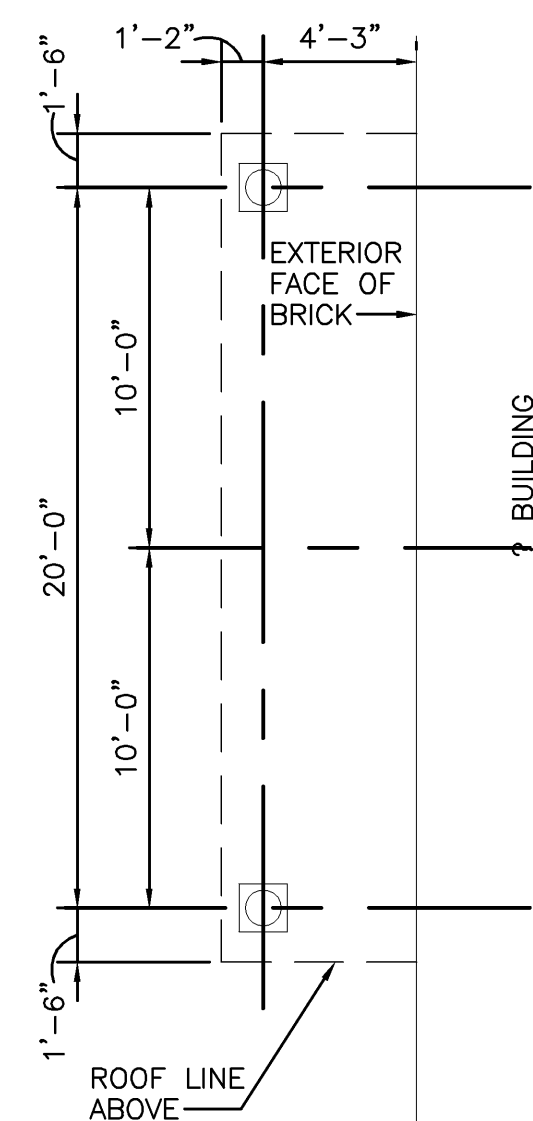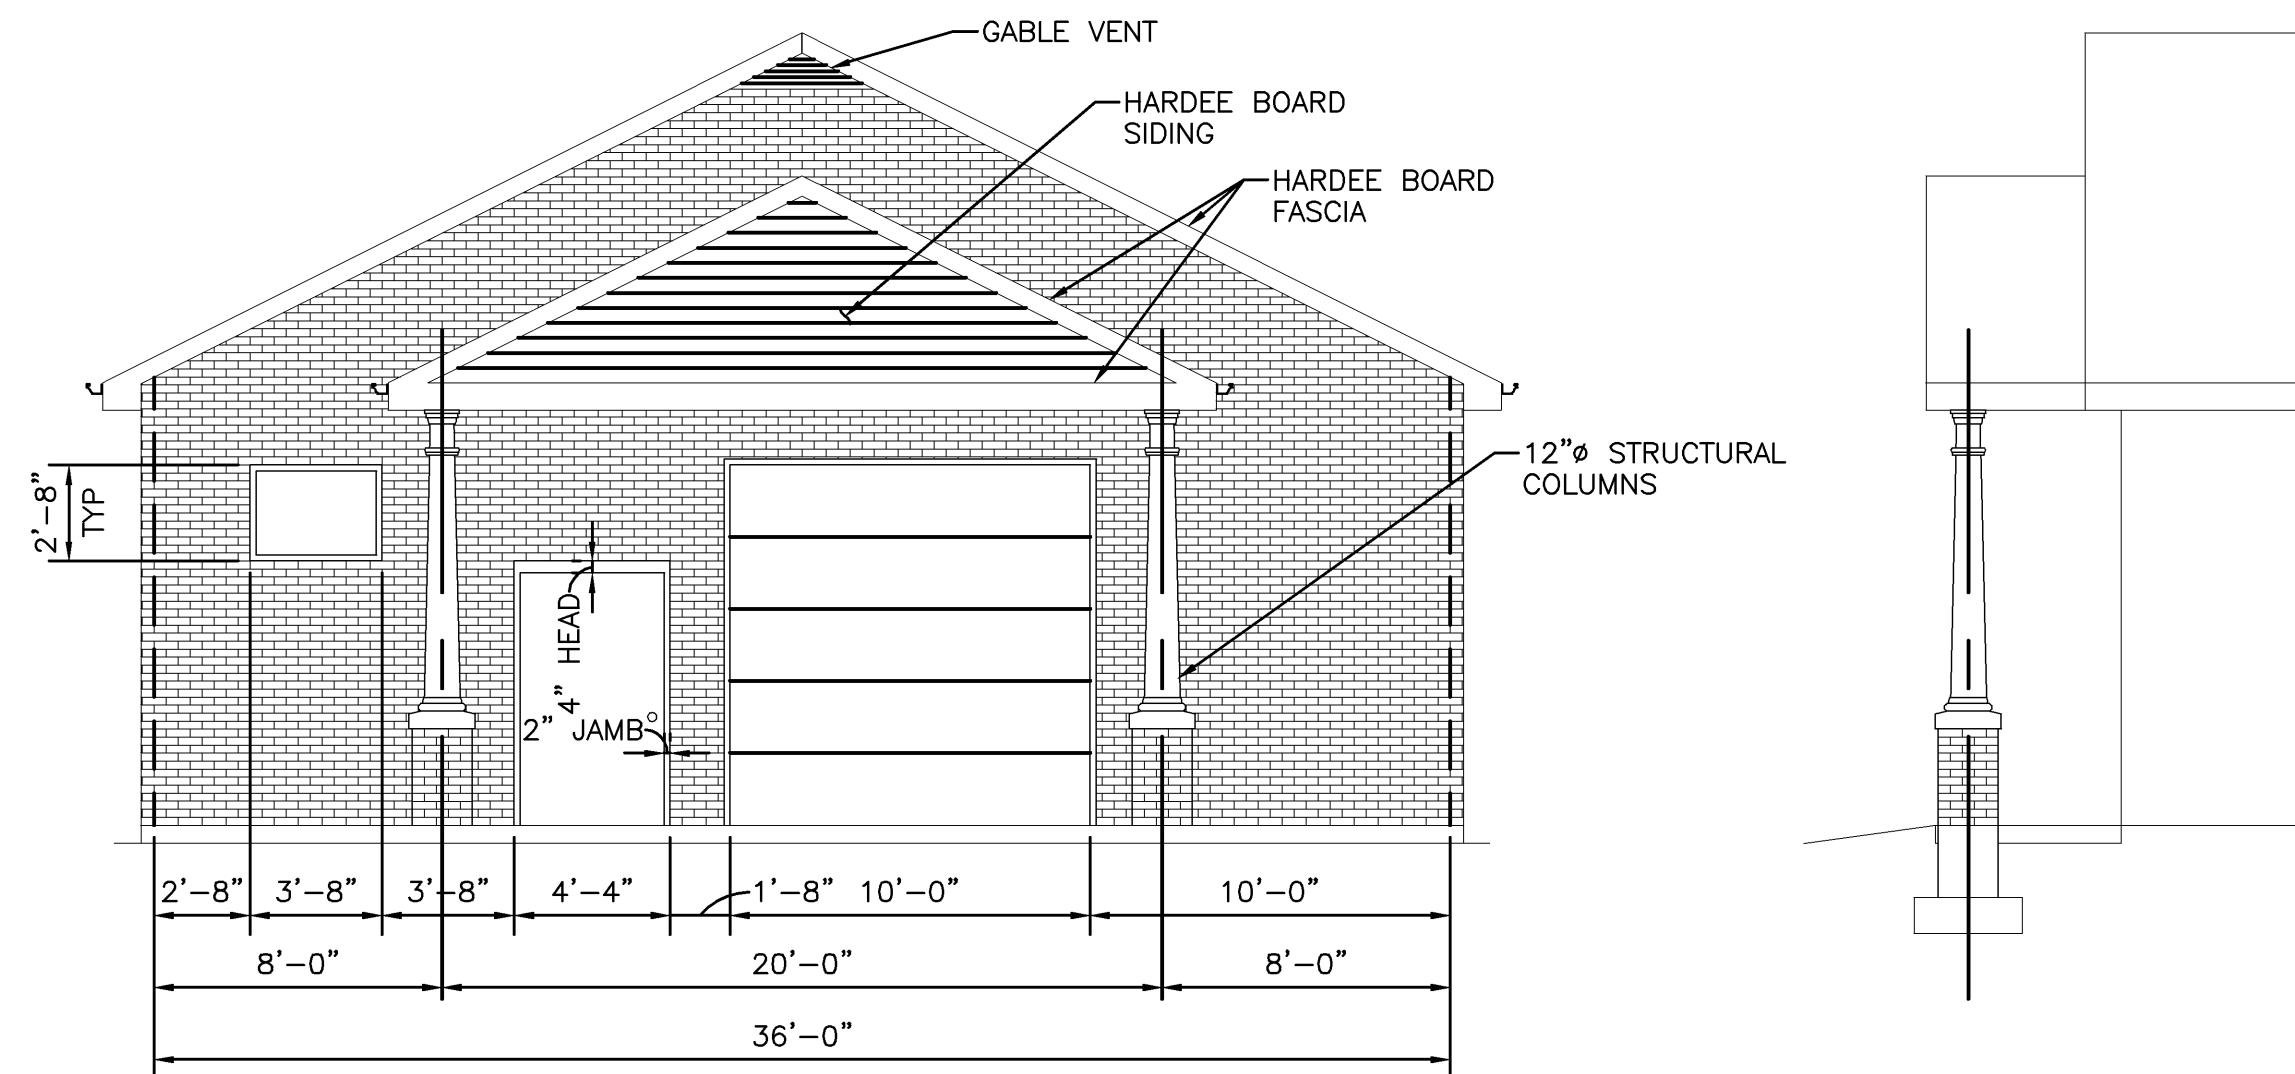


ELEVATION — FRONT VIEW  
SCALE:  $3/16" = 1'-0"$

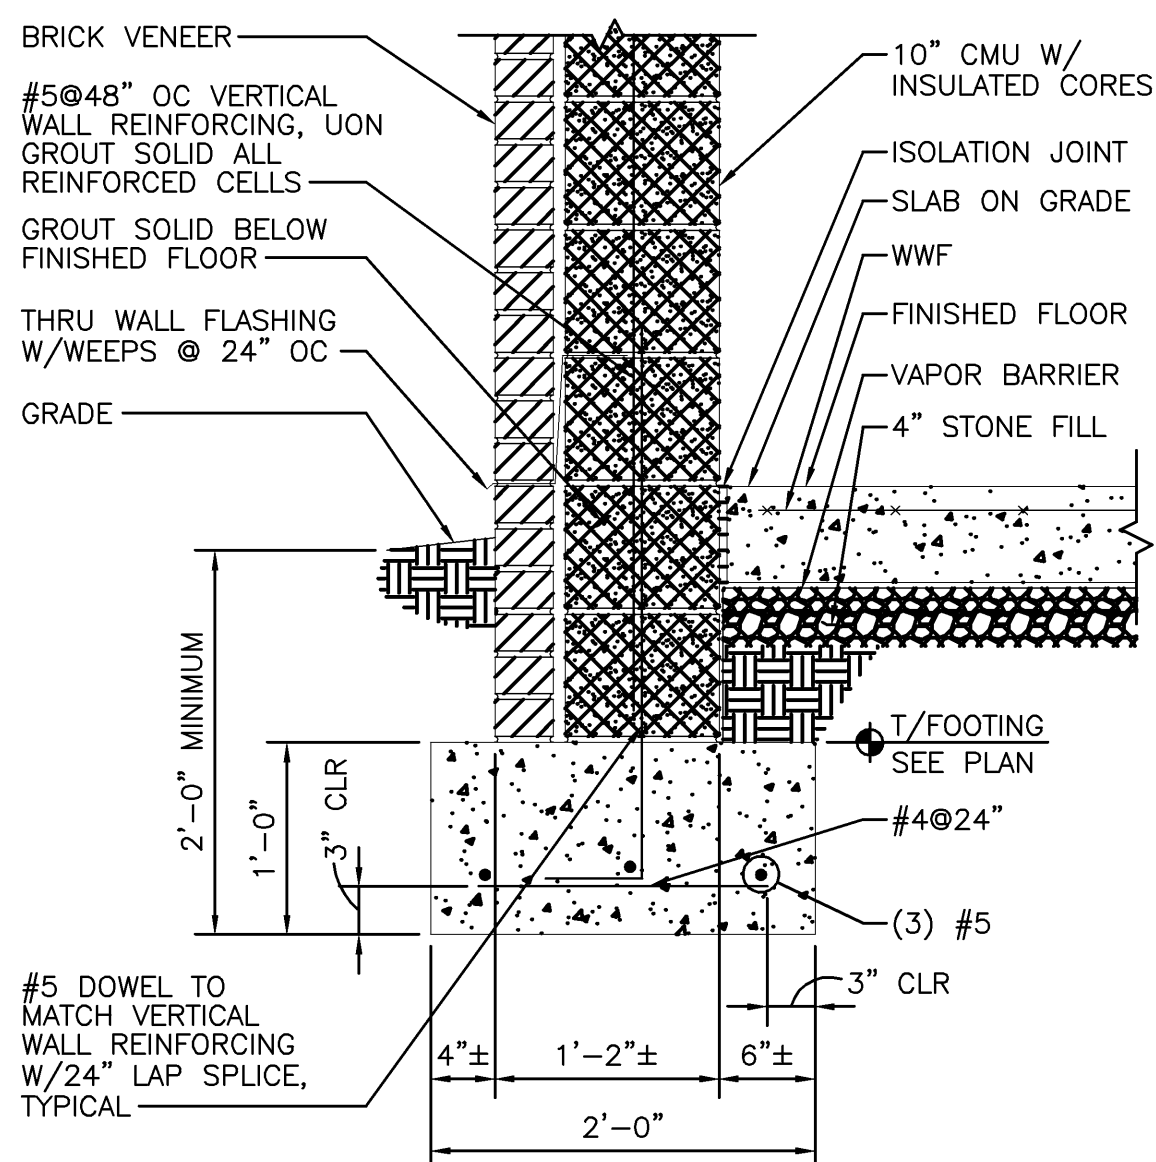

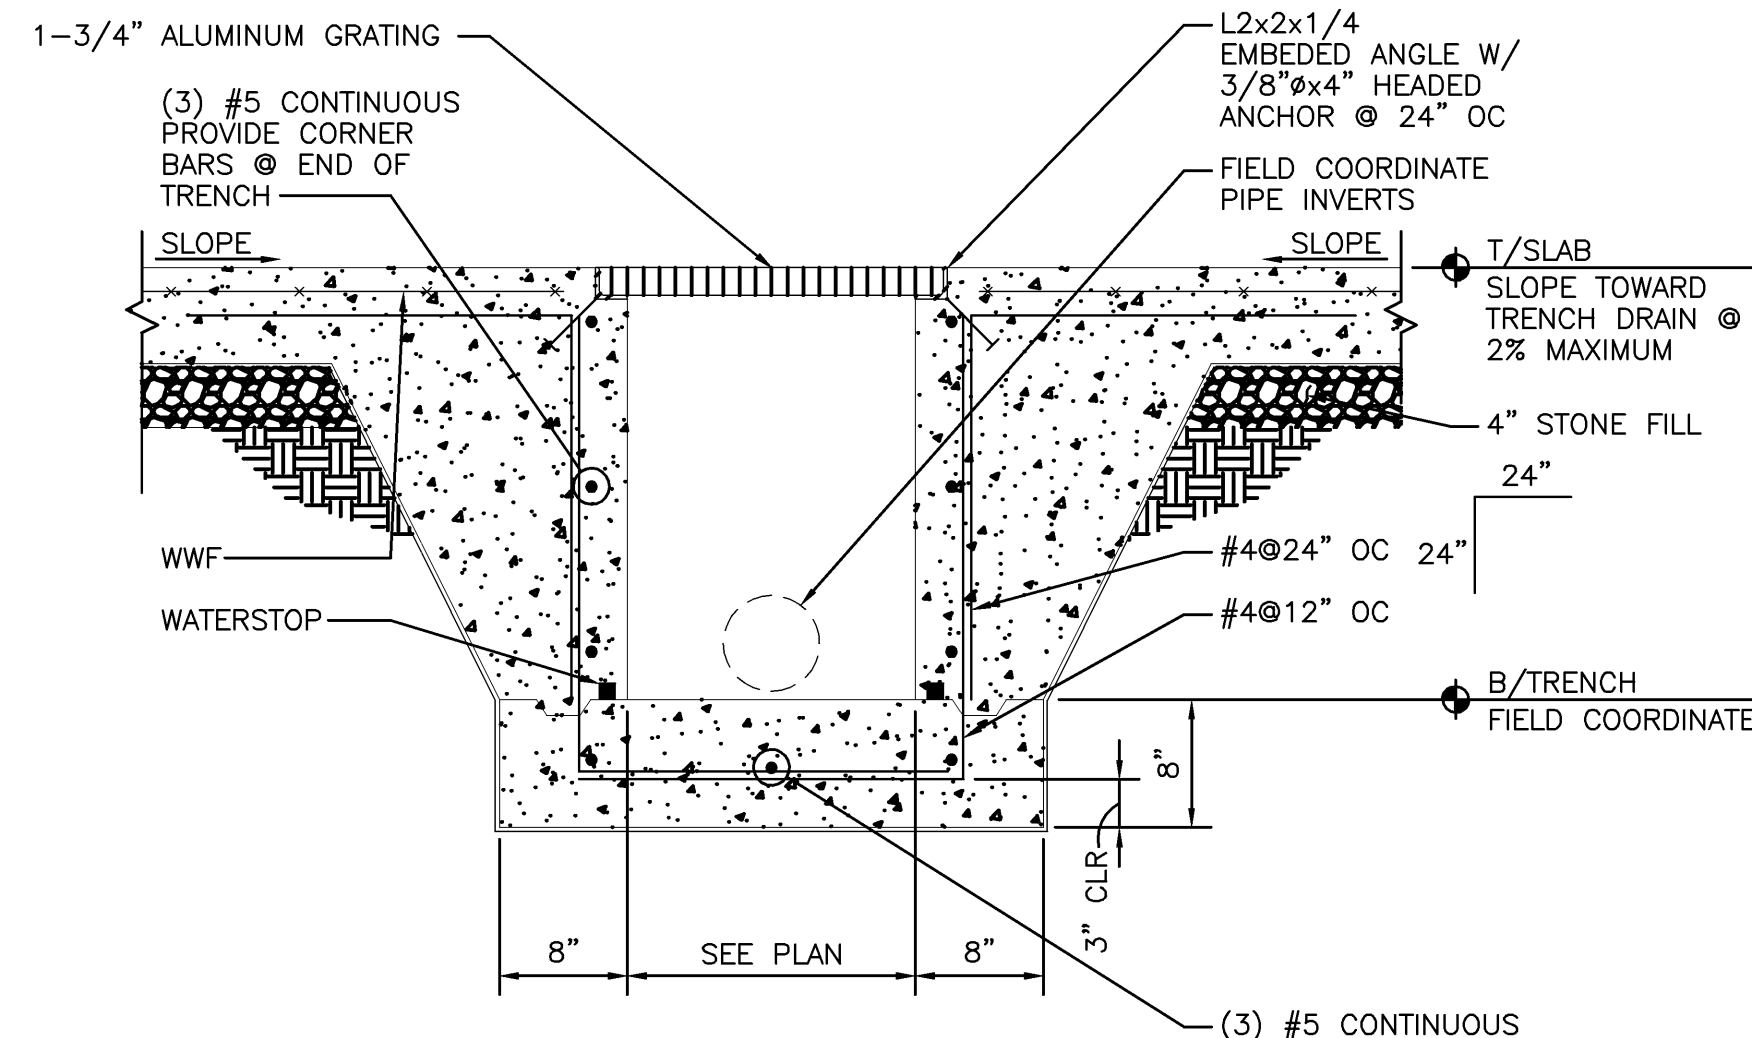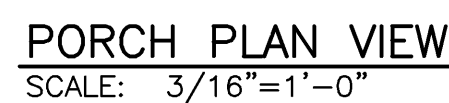


WALL AND FOOTING SECTION  
SCALE: 1"=1'-0"

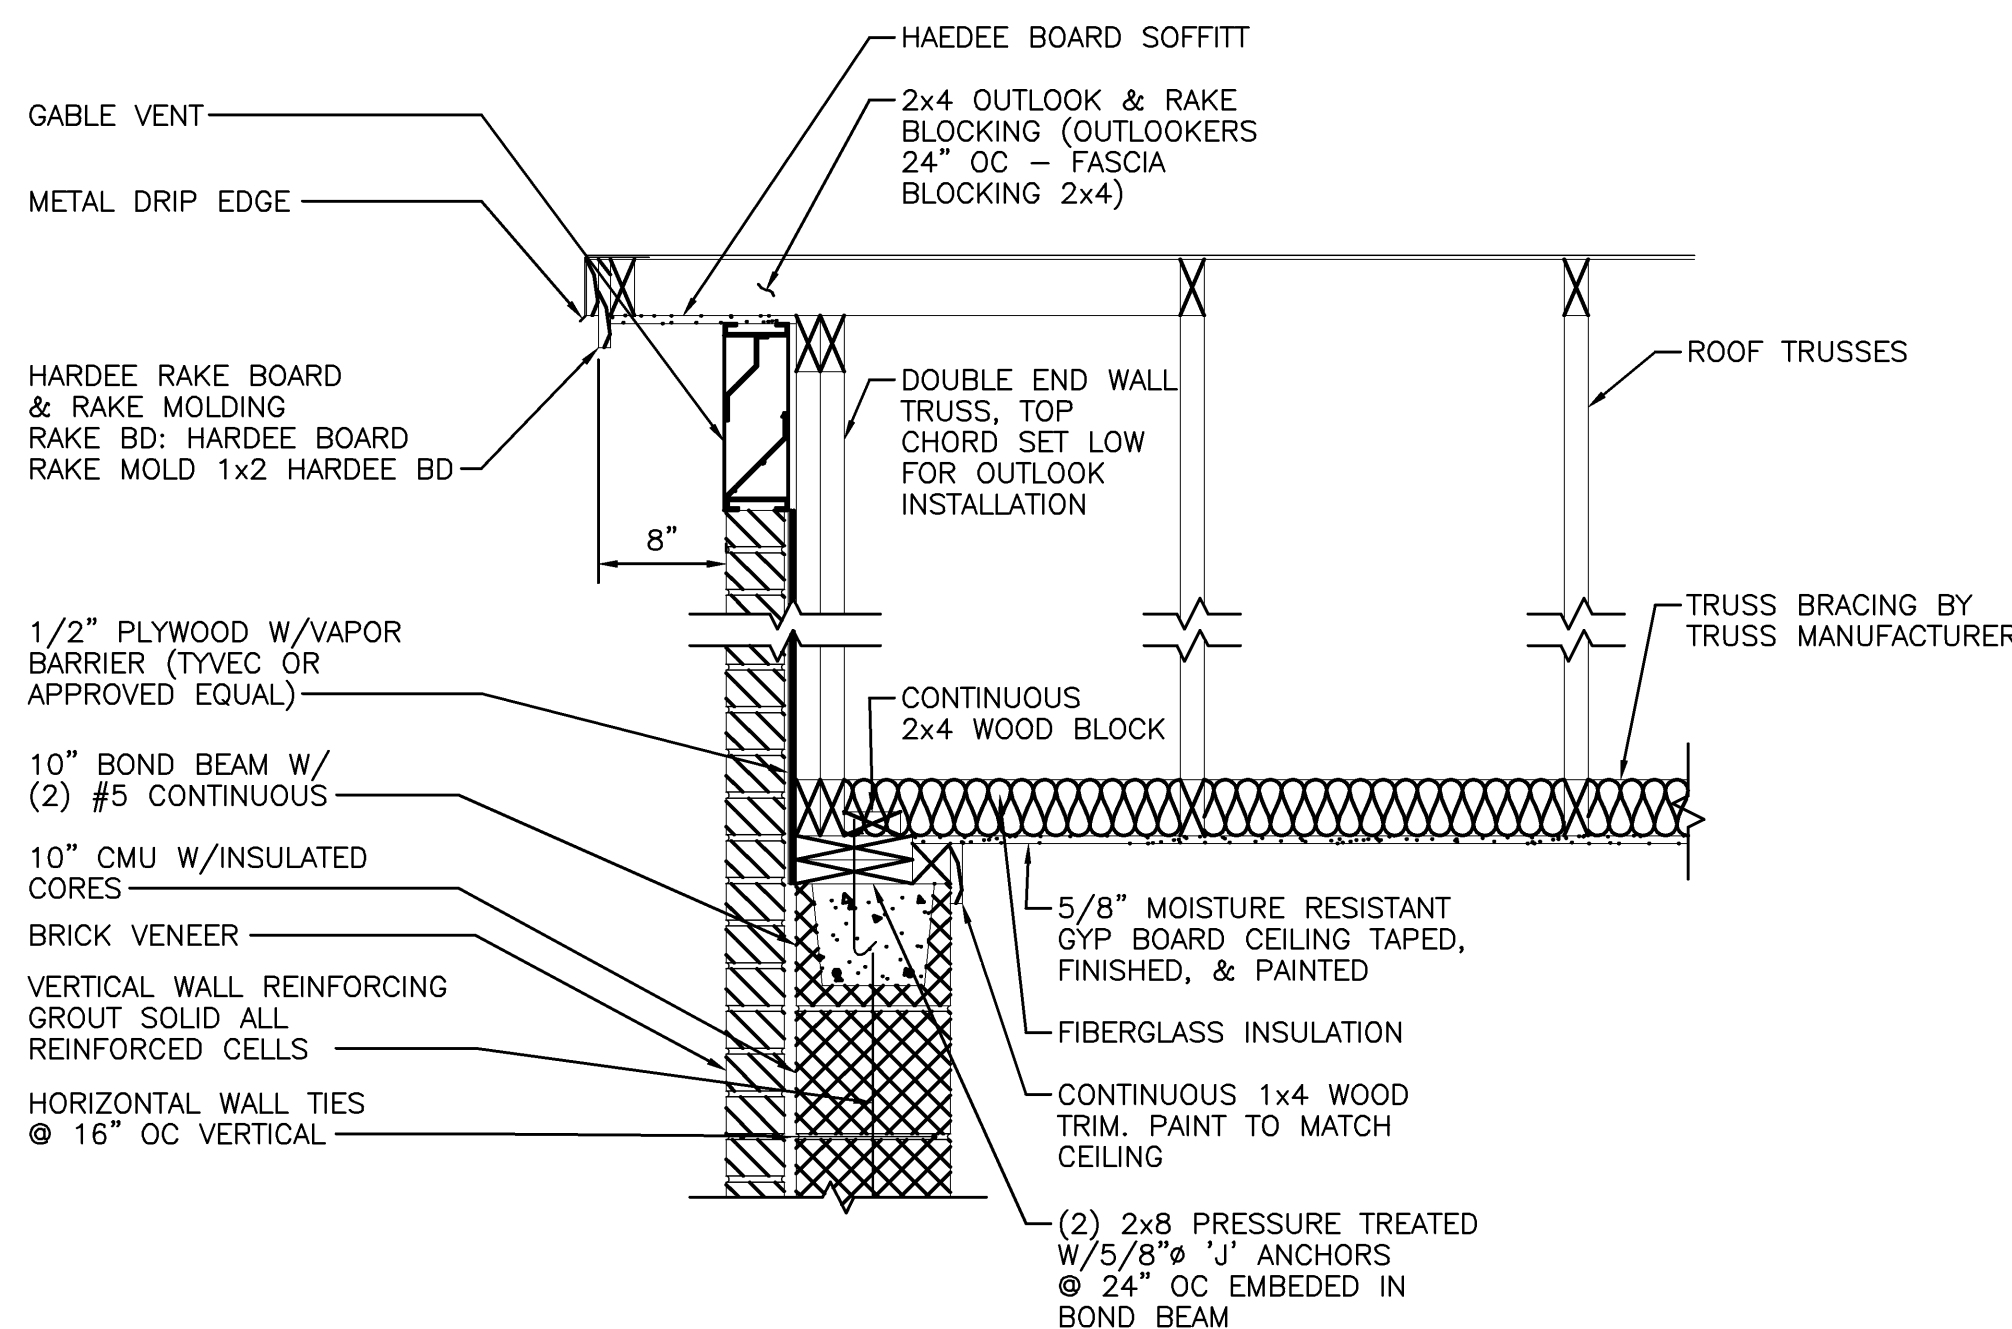

CAST-IN-PLACE TRENCH DETAIL  
SCALE: 1"=1'-0"



GABLE WALL SECTION  
SCALE: 1"=1'-0"


LINTEL SCHEDULE				
MARK	TYPE	DESCRIPTION	BOTTOM OF LINTEL	MASONRY OPENING
L-1		10" BOND BEAM W/(2) #5 CONTINUOUS W/L4x3 1/2x1/4 LLV. 8" BEARING @ EACH END.	7'-4" @ DOORS 10'-0" @ WINDOWS	4'-4"Wx7'-4"H @ DOORS 3'-8"Wx2'-8"H @ WINDOWS
L-2		(2) 10" BOND BEAM W/(4) #5 CONTINUOUS W/L6x4x3/8 LLV & 5/8"Ø HILTI @ 24" OC. 8" BEARING @ EACH END.	10'-0"	10'-0"x10'-0"
L-3		(2) 10" BOND BEAM W/(4) #5 CONTINUOUS W/L6x4x3/8 LLV & 5/8"Ø HILTI @ 24" OC. 8" BRC @ EACH END & MIDDLE.	9'-4"± FIELD VERIFY W/FUTURE TANKS	FUTURE OPENINGS IN MASONRY WALL FOR FUTURE CONTACT TANKS
NOTE: PROVIDE THRU WALL FLASHING WITH WEEPS @ 24" OC ABOVE ALL DOOR AND WINDOW OPENINGS.				

2	9/3/09	OWNER COMMENTS
3	10/7/09	ADDENDUM #2
4	11/17/09	FRANKLIN COUNTY COMMENTS
5	3/14/12	ASBUILTS

**WATER TREATMENT BUILDING DETAILS-ASBUILT  
FOR  
TOWN OF BOONES MILL WATER SYSTEM REPLACEMENT, VOLUME 2  
TOWN OF BOONES MILL, BOONE DISTRICT, FRANKLIN COUNTY, VA**

PROJECT NO.	20080815
G.L. NO.	297-03-A3.9
FILE NO.	G-12675
DATE:	7/31/09
DRAWN BY:	ASK
CHECKED BY:	BLC

Mar 14, 2012 - 4:11pm V:\unaprojects\20080815.dwg\asbults-WTP\ASBULT-SITE-TANK-DETAILS.dwg

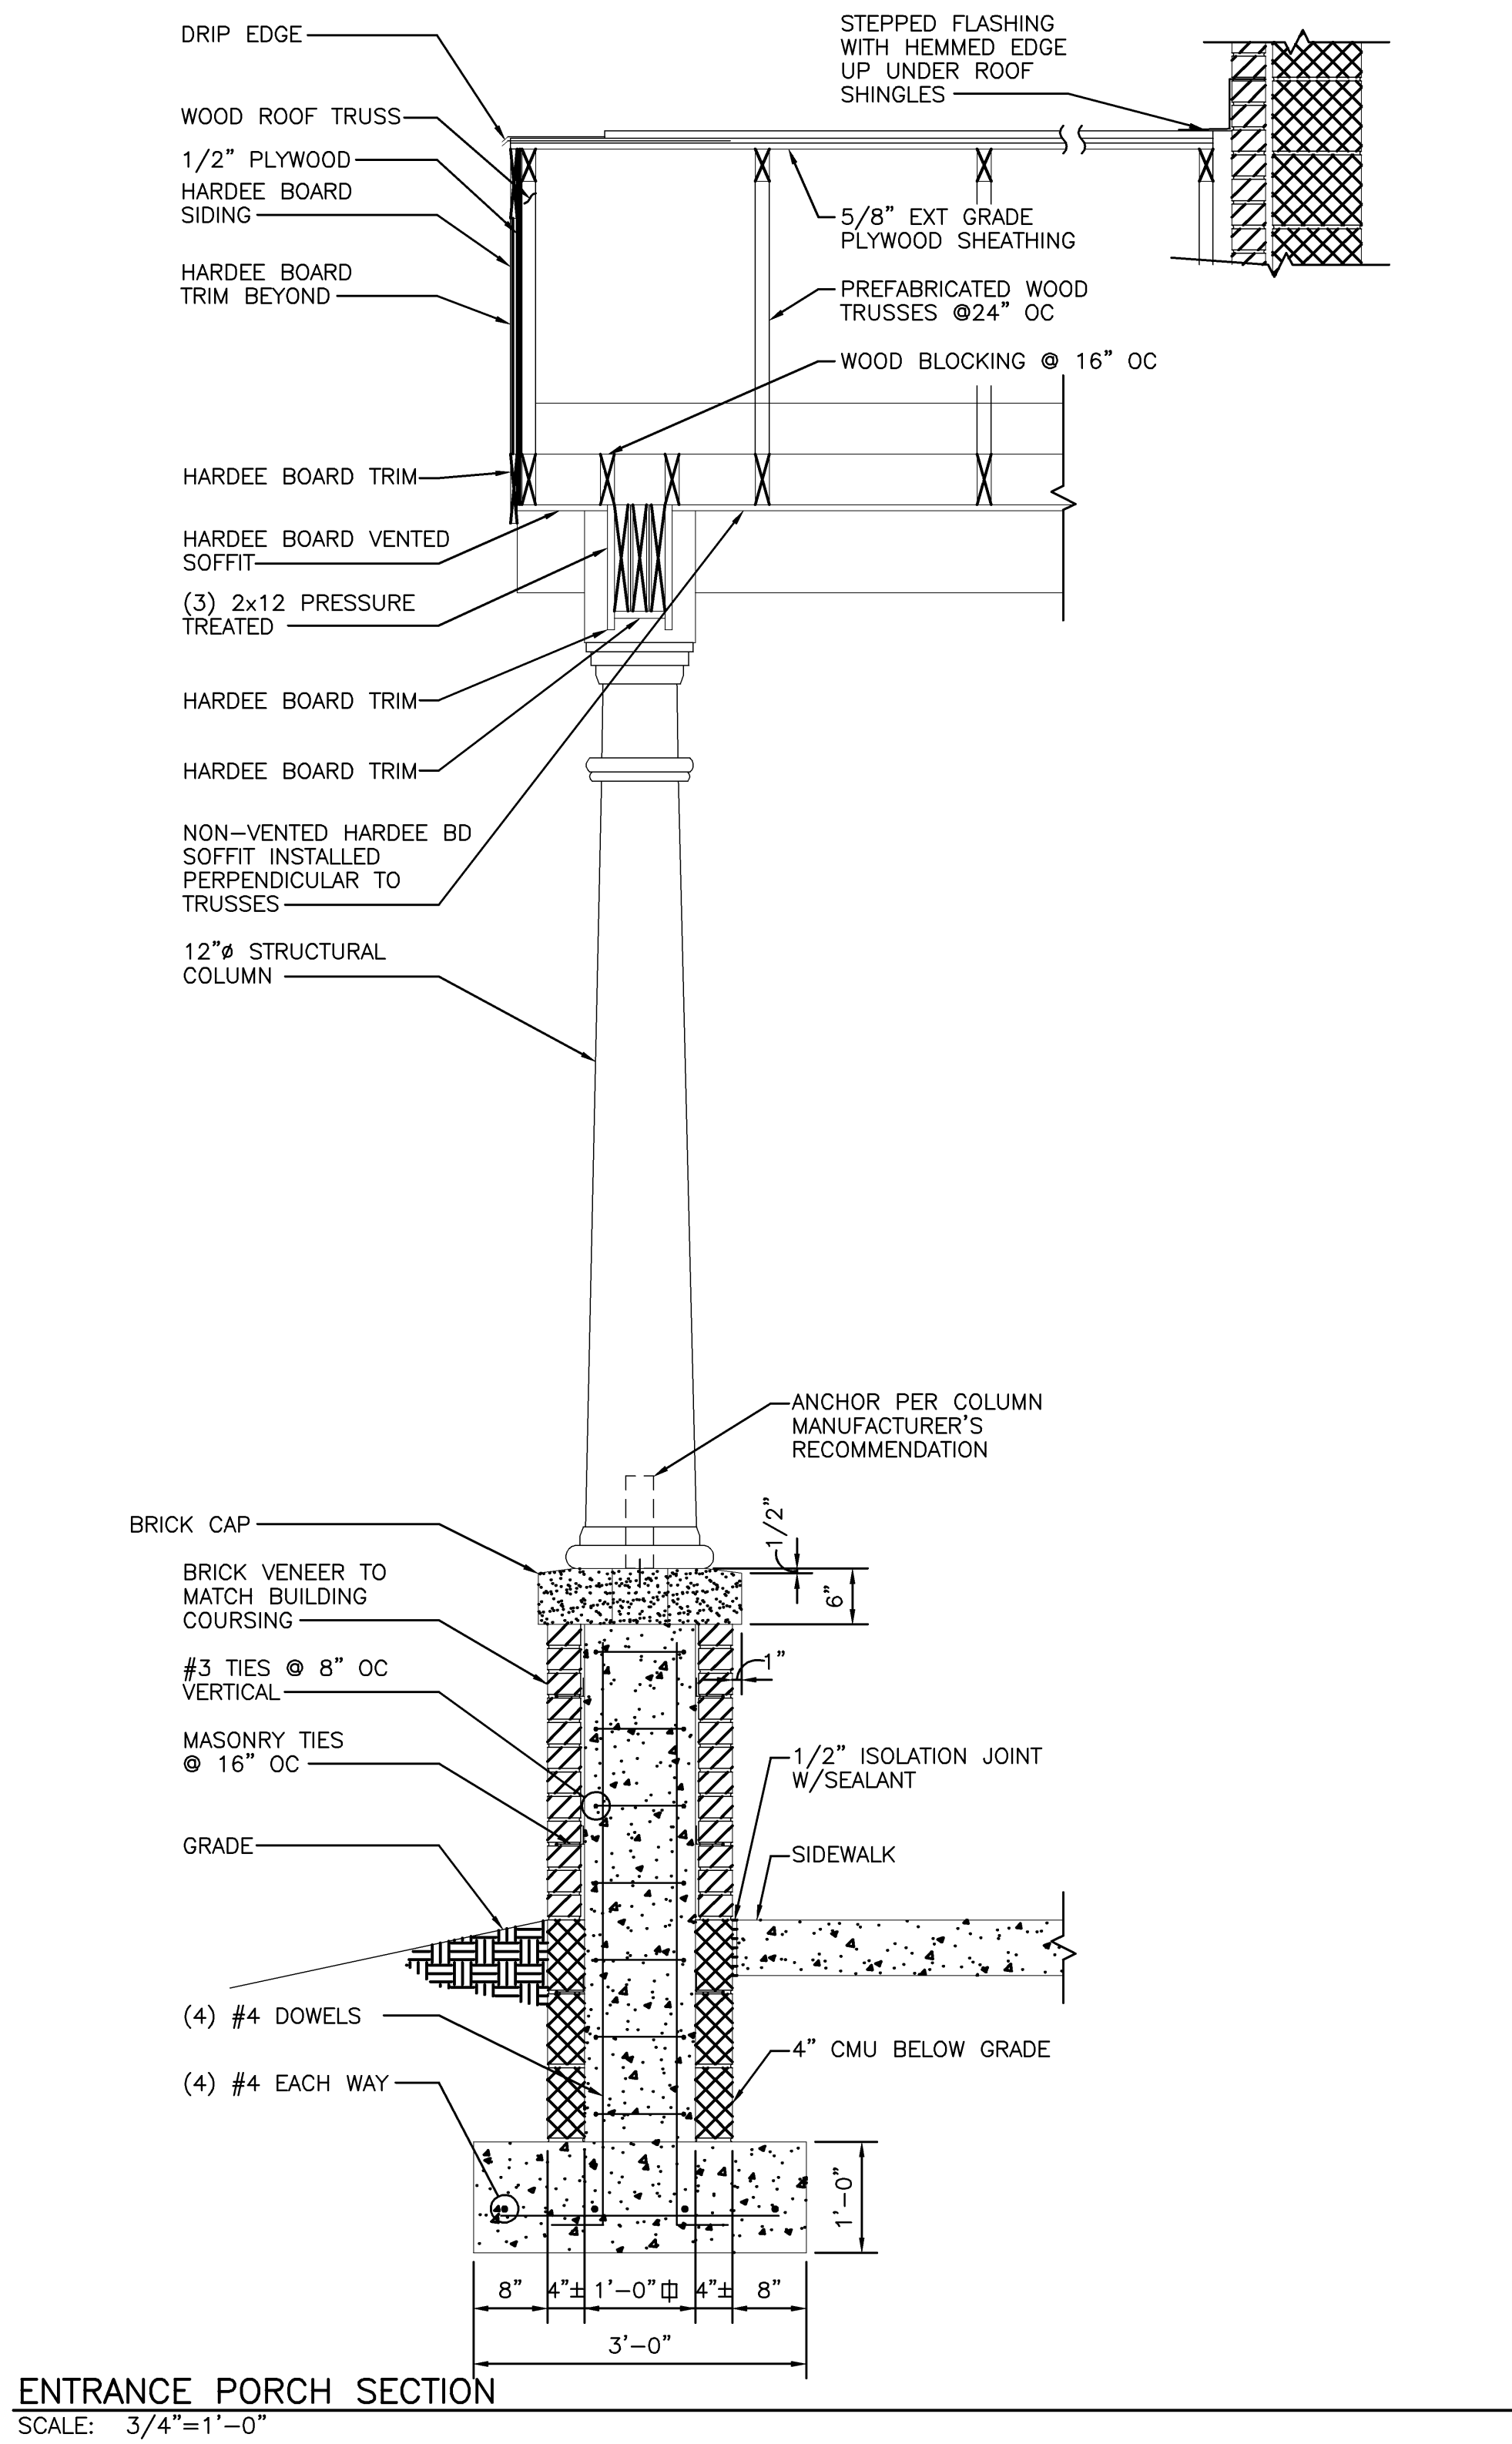

\*ENGINEERING >> SURVEYING >> PLANNING

**HURT & PROFFITT**  
INCORPORATED  
2524 LANGHORNE ROAD  
LYNCHBURG VA 24501  
800.242.4906 TOLL FREE  
434.847.7796 MAIN  
434.847.0047 FAX

**WATER TREATMENT BUILDING DETAILS-ASBUILT**  
**FOR**  
**TOWN OF BOONES MILL WATER SYSTEM REPLACEMENT, VOLUME 2**  
**TOWN OF BOONES MILL, BOONE DISTRICT, FRANKLIN COUNTY, VA**

PROJECT NO. 20080815  
G.L. NO. 297-03-A3.9  
FILE NO. G-12675  
DATE: 7/31/09  
DRAWN BY: ASK  
CHECKED BY: BLC


**HURT & PROFFITT**

SHEET NO.  
**S1.3**


2	9/3/09	OWNER COMMENTS
4	11/17/09	FRANKLIN COUNTY COMMENTS
5	3/14/12	ASBUILTS





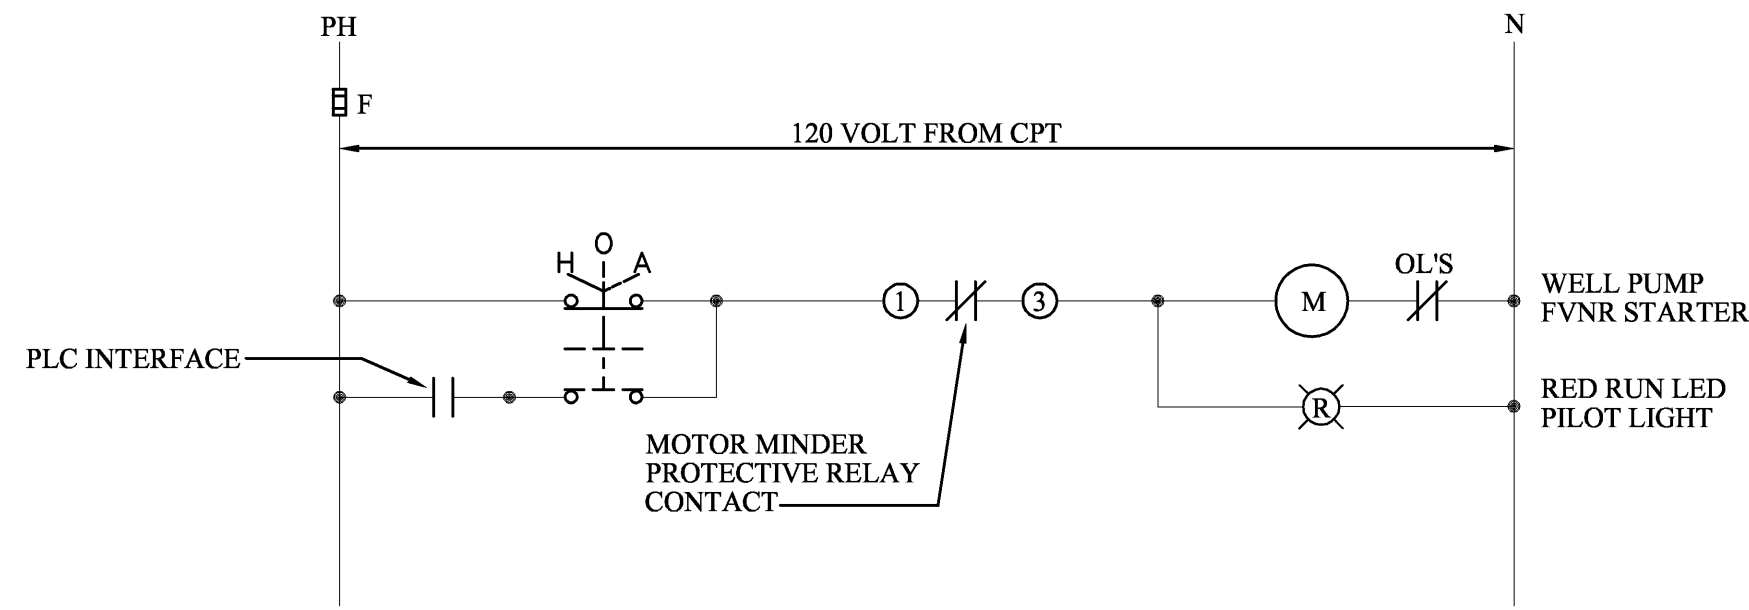

WELL PUMP #2 & #3 CONTROL DIAGRAM

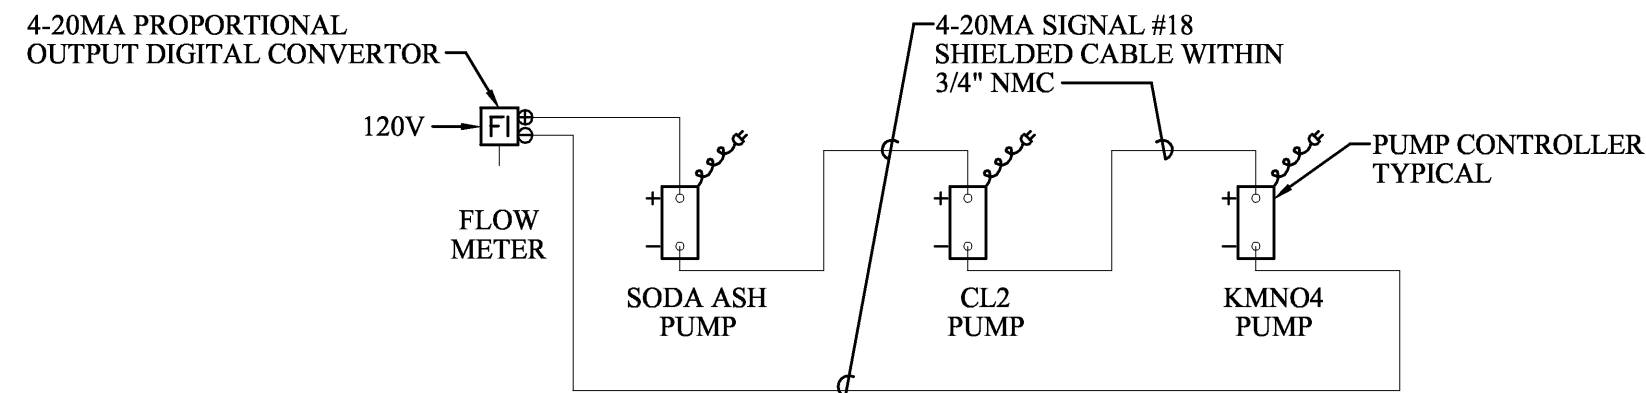


CHEMICAL FEED PUMPS CONTROL DIAGRAM

PANEL "WT" SCHEDULE									
PANELBOARD CHARACTERISTICS: VOLTS: 120/240 PHASES: 1 WIRES: 3 SOLID NEUTRAL, GROUND BAR									
CKT. NO.	POLE NO.	DESCRIPTION	LOAD TYPE	CONN. KVA	CONN. AMPS		BREAKER		NO. & WIRE SIZE
					A	B	P	AT	PHASE NEUT. GND COND. SIZE
1	1	GENERATOR BATTERY CHARGER	E	1.0	8.3	8.3	1	20	10 10 12 1"
3	3	GENERATOR BLOCK HEATER	E	2.0	8.3	8.3	2	20	10 - 12 1"
7	7	PACKAGE RTU-1, 5 TONS, 18KW	M	25.8	107.5	107.5	2	150	1/0 - 6 1 1/2"
11	11	BACKWASH PUMP - 3.0HP	E	3.9	16.3	16.3	2	40	10 - 10 3/4"
15	15	WATER PUMP - 1 1/2 HP	E	2.3	9.6	9.6	2	30	10 - 10 1"
17	17	WELL PUMP #2 - 5HP	E	6.4	26.7	26.7	2	50	10 - 10 1 1/2"
23	23	WELL PUMP #3 - 5 HP	E	6.4	26.7	26.7	2	50	10 - 10 1 1/2"
27	27	SECURITY SYSTEM - RECEPTACLE	E	1.0	8.3	8.3	1	20	12 12 12 3/4"
29	29	FLOW METER	E	0.3	2.5	2.5	1	20	12 12 12 3/4"
31	31	TANK LEVEL INSTRUMENT	E	0.3	2.5	2.5	1	20	12 12 12 3/4"
33	33	SEPTIC DOSING PUMP	E	0.9	7.5	7.5	1	20	12 12 12 3/4"
35	35	DOMESTIC WATER HEATER	M	4.5	18.8	18.8	2	30	10 - 10 3/4"
39	39	PLC & RADIO CONTROL PANEL	E	1.0	8.3	8.3	1	20	12 12 12 3/4"
41	41	EXHAUST FAN EF-2	E	0.5	4.2	4.2	1	20	12 12 12 3/4"
2	2	LIGHTING - LAB	L	1.0	8.3	8.3	1	20	12 12 12 3/4"
6	6	LIGHTING - LAB	L	1.5	10.8	10.8	1	20	12 12 12 3/4"
8	8	LIGHTING & FAN TOILET	L	1.0	8.3	8.3	1	20	12 12 12 3/4"
10	10	SITE LIGHTING	L	1.5	6.3	6.3	2	20	8 - 12 1"
12	12	RECEPTACLES - LAB ROOM	R	1.0	8.3	8.3	1	20	12 12 12 3/4"
14	14	RECEPTACLES - LAB	R	1.0	8.3	8.3	1	20	12 12 12 3/4"
16	16	RECEPTACLES - MNO4, CL2, SODA ASH	R	1.5	12.5	12.5	1	20	12 12 12 3/4"
18	18	RECEPTACLES - KMNO4, CL2	R	1.0	8.3	8.3	1	20	12 12 12 3/4"
20	20	RECEPTACLES - SODA ASH, SPARE TANK	R	1.0	8.3	8.3	1	20	12 12 12 3/4"
22	22	RECEPTACLES - KMNO4, CL2	R	1.0	8.3	8.3	1	20	12 12 12 3/4"
24	24	RECEPTACLES - SODA ASH, SPARE TANK	R	1.0	8.3	8.3	1	20	12 12 12 3/4"
26	26	RECEPTACLES - TOILET & MISC.	R	0.5	4.2	4.2	1	20	12 12 12 3/4"
28	28	RECEPTACLES - TANK ROOM	R	0.5	4.2	4.2	1	20	12 12 12 3/4"
30	30	RECEPTACLES - MISC.	R	0.5	4.2	4.2	1	20	12 12 12 3/4"
32	32	HEAT TRACING @ TANK	E	1.2	10.0	10.0	1	* 20	12 12 12 3/4"
34	34	EF-3 & EF-4	E	1.0	8.3	8.3	1	20	12 12 12 3/4"
36	36	PANEL WTA					2	100	1 6 1 1/4"
38	38	SOLAR PV SYSTEM INverter					2	60	6 6 1 1/2"
40	40	4.5KW SYSTEM							
TOTALS				72.3	300.8	301.7			


\* GROUND FAULT BREAKER

LIGHTING FIXTURE SCHEDULE						
TYPE	MANUFACTURER	CATALOG NUMBER	FIXTURE VOLTAGE	LAMPS No.	LAMPS TYPE	MOUNTING
A	LITHONIA	DM-3-32-MVOLT-GEB101S	120	3	F32T8/SPX35	SURFACE
B	LITHONIA	TWS-42TRT-MVOLT-LPI	120	1	CF42TRT	WALL
C	LITHONIA	WP-2-17-MVOLT-WHITE	120	2	F17T8-24"	WALL
SLI	LITHONIA	FIXTURE: KAD-400M-R4-240-SPD04-LPI-DF-PEI-DDBT	240	1	400W/MH	POLE
		POLE: COMPOSITE DIRECT BURY-RTFDB-30-8-3X-DM I9-DDBT	-	-	25" NM, MH	
EMX	LITHONIA	LHQM-S-W-1-R-120-N	120	2+		WALL
						COMBINATION EXIT/EMERG

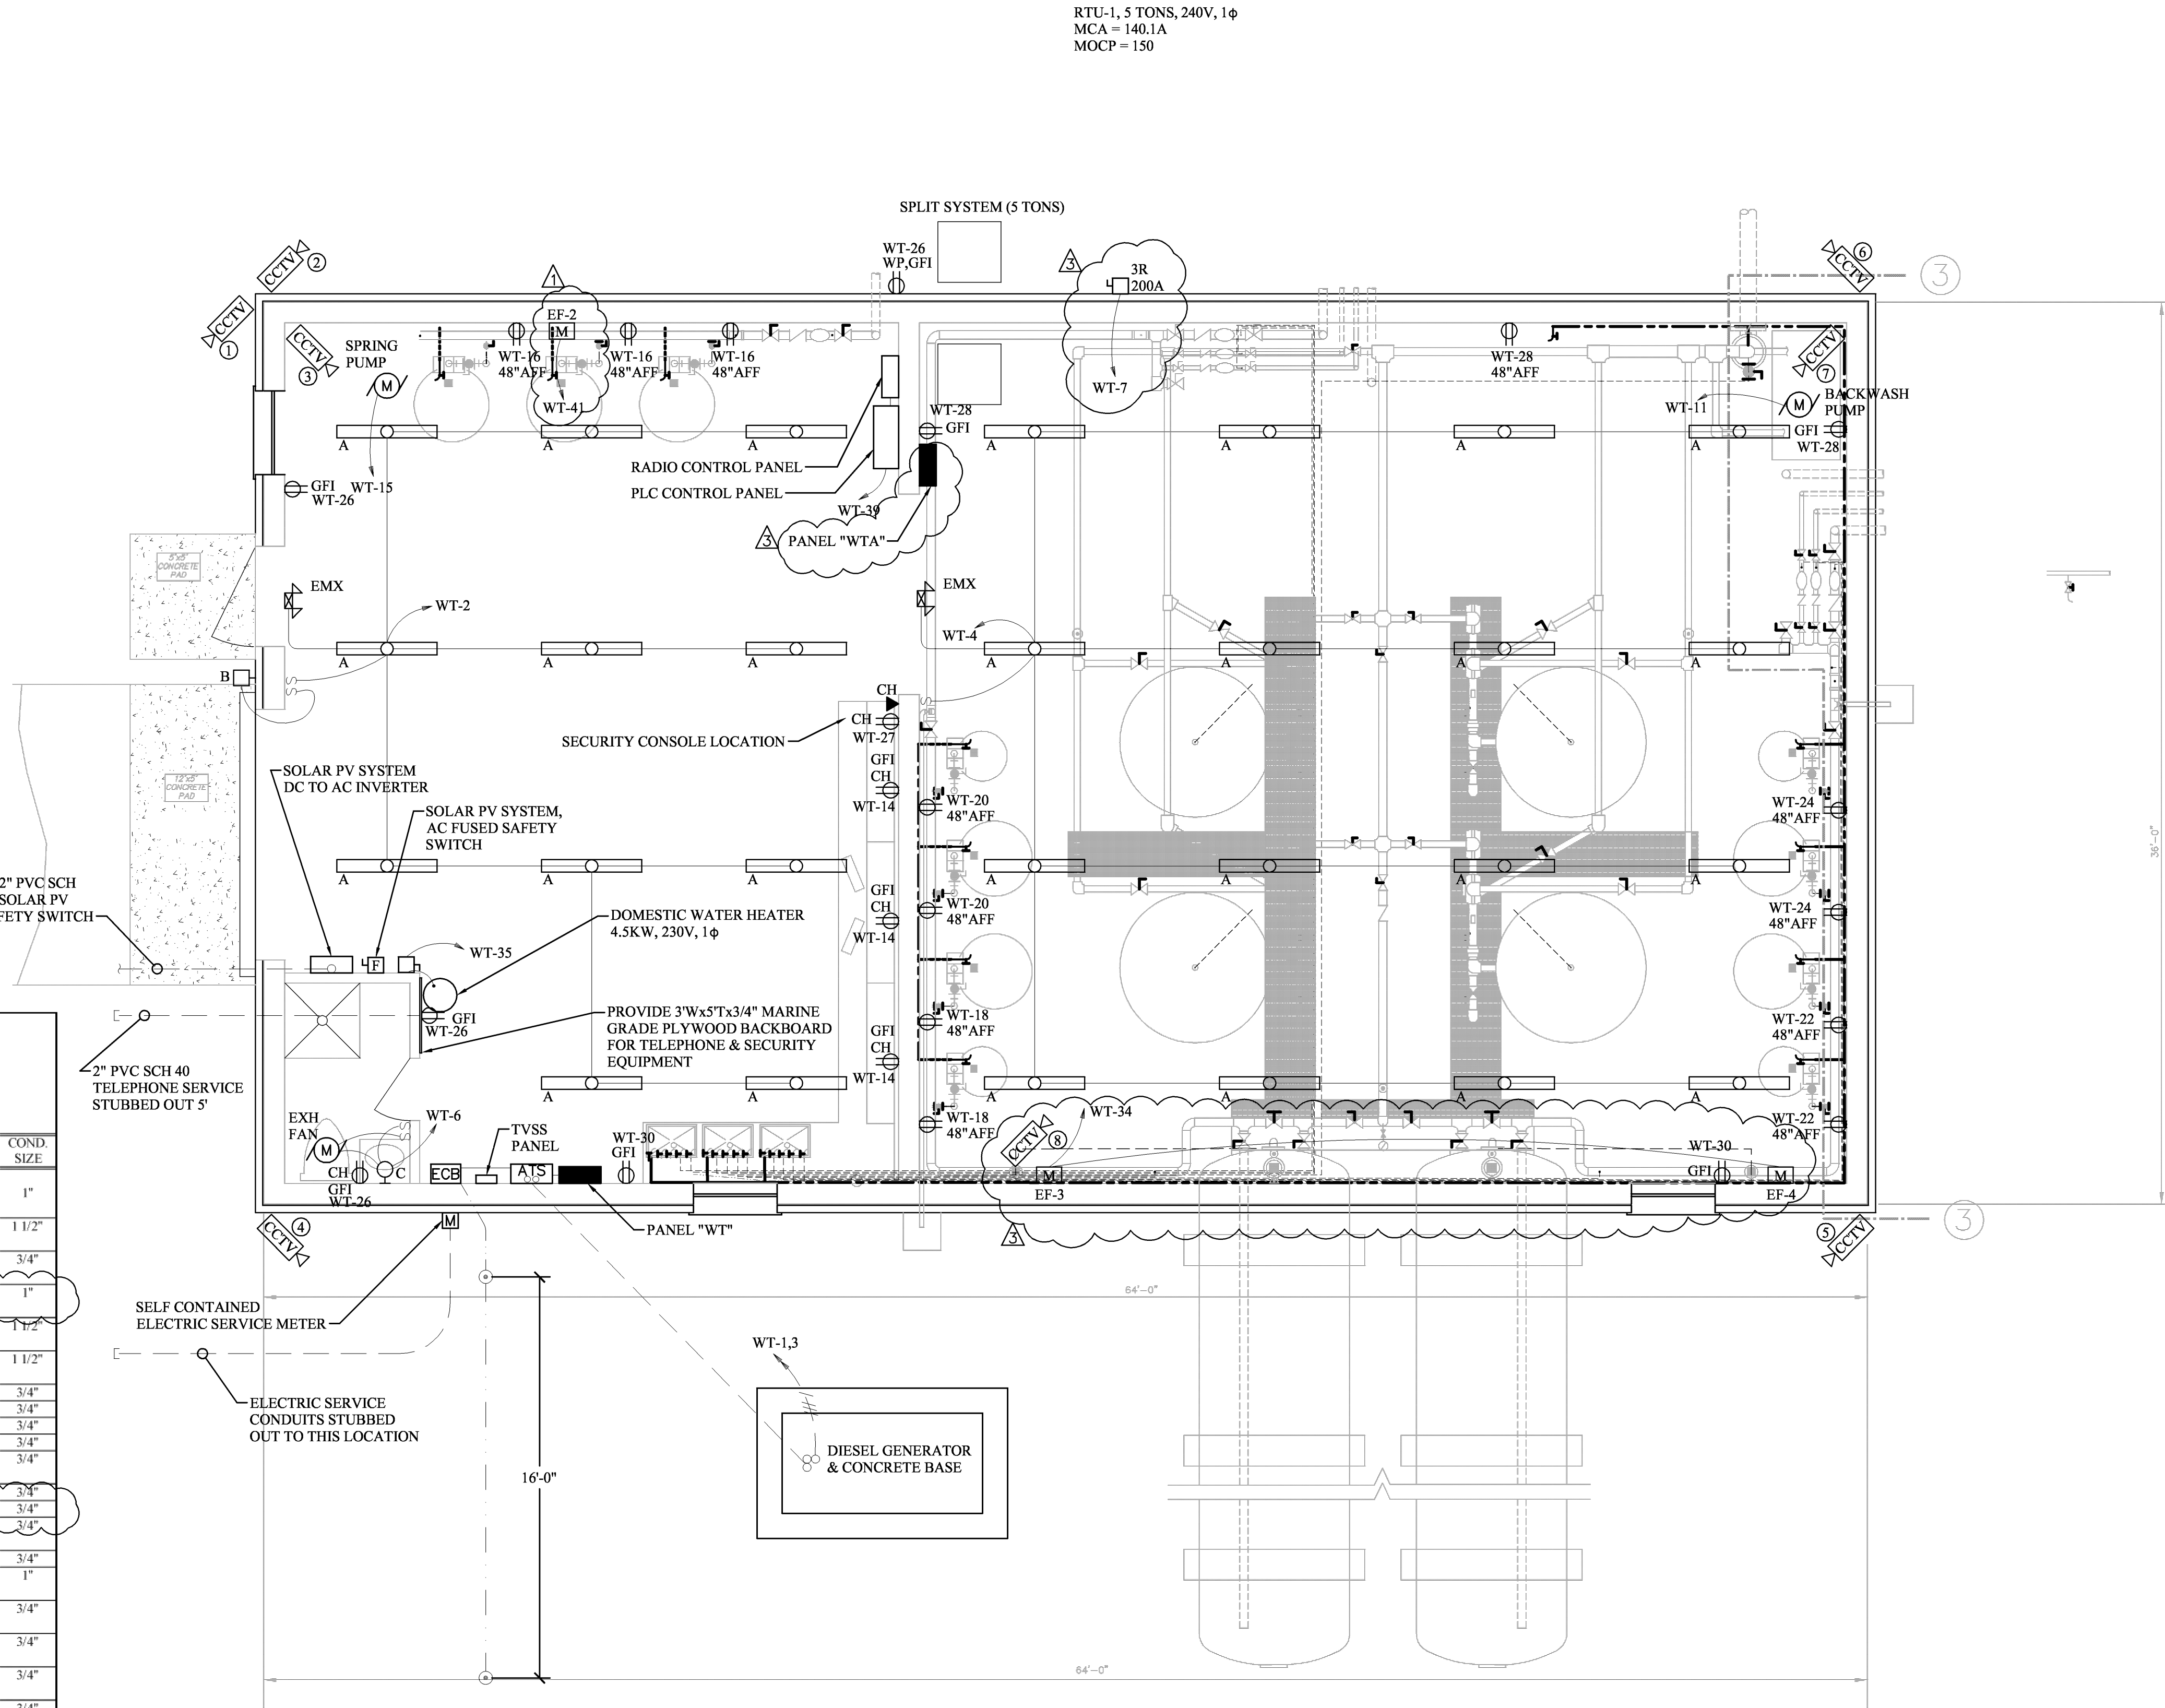

WATER TREATMENT BUILDING "WTB" POWER & LIGHTING PLAN

SCALE: 1/4" = 1'-0"

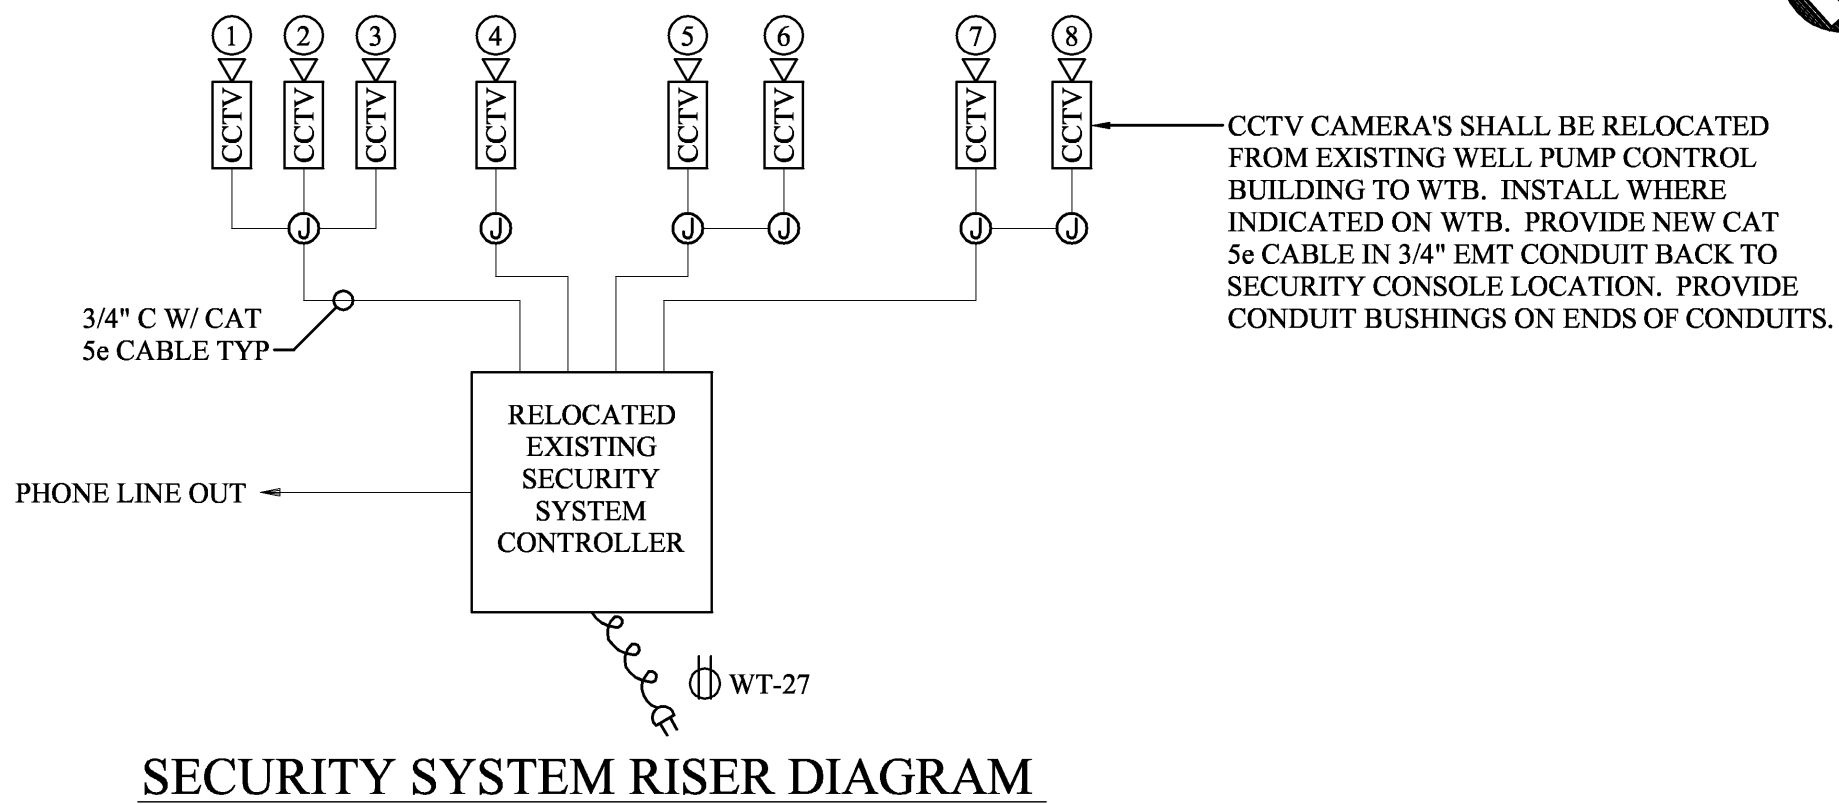

1	8/28/09	VDH/OWNER COMMENTS
2	9/3/09	OWNER COMMENTS
3	10/17/09	ADDENDUM #2
4	11/17/09	FRANKLIN COUNTY COMMENTS
5	3/14/12	ASBUILTS



ROOFTOP PACKAGE HEAT PUMP	
MARK	RTU-1
MANUFACTURER	TRANE
MODEL NUMBER	WSC060
DESIGNATION	RTU-1
POWER (V/PH/Hz) *	240/1/60
DRIVE	BELT
CFM	2,000
FAN MOTOR HP	1
EXTERNAL S.P.-IN. W.G.	5/8
COOLING CAPACITIES	
AMBIENT E.A.T., °F DB	95.0
EVAP. E.A.T.-°F DB/WB	79.0/65.0
NET SENSIBLE CAPY.-(MBH)	47.1
NET TOTAL CAPY.-(MBH)	59.7
HEATING CAPACITY	
COND. E.A.T.-°F DB	47.0
HEATING E.A.T.-°F DB	61.0
HEATING L.A.T.-°F DB	74.9
TOTAL HTG CAPY.-MBH	28.5
ELECTRIC RESISTANCE HEATER	
NO. STAGES	2
POWER (V/PH/Hz) *	240/1/60
TOTAL HTG CAPY.-KW	17.4
OUTSIDE AIR QTY (CFM)	400
REMARKS: HORIZONTAL DUCT CONNECTIONS; SINGLE-PT POWER CONN.; FACTORY-INSTALLED ELEC. DISCONN.; LOW AMBIENT CONTROLS; WALL-MTD THERMOSTAT W/ AUTO. SWITCHOVER CAPABILITY.	

EXHAUST FANS		
MARK	EF-1	EF-2; EF-3; EF-4
MANUFACTURER	GREENHECK	GREENHECK
MFR. MODEL NUMBER	SP-B90	SE1-10-428-P
FLOW RATE (CFM)	75	400
S.P. (IN. W.G.)	1/8	1/8
MOTOR POWER	50 W	1/20 HP
POWER *	120/1/60	120/1/60
REMARKS:	ELEC. DISCONNECT; HANGING VIBRATION ISOLATORS; GREENHECK MODEL WC-6 HOODED WALL CAP; SPEED CONTROLLER	ELEC. DISCONNECT; WALL HOUSING W/ HOUSING GUARD; GRAY. DAMPER; WEATHERHOOD W/ BIRD SCREEN; SPEED CONTROLLER


LOUVERS	
MARK	L-1
MANUFACTURER	RUSKIN
MFR. MODEL NO.	ELF375DX
SIZE	18" X 18"
FLOW RATE (CFM)	600
S.P. (IN. W.G.)	0.07
CONSTRUCTION	ALUMINUM
REMARKS:	EXTRUDED DRAINABLE BLADES; BIRD SCREEN; CLEAR ANODIZED FINISH.

ABBREVIATIONS:	
AFF	ABOVE FINISHED FLOOR
CD	CEILING MTD SUPPLY AIR DIFFUSER
DN	DOWN
EL	ELEVATION
O.A.	OUTSIDE AIR
RG	RETURN GRILLE
Ⓣ	THERMOSTAT
SD	SMOKE DETECTOR
Ⓜ	MANUAL STARTER

AIR INLETS / OUTLETS								
MARK	TYPE	SHAPE	CONSTRUCTION	FINISH	NECK SIZE	CFM RANGE	ACCESSORIES	SELECTION BASED ON
CD-1	CEILING LAY-IN ADJUSTABLE PATTERN	SQUARE	ALUMINUM	WHITE	8	135-270	OPPOSED BLADE BALANCING DAMPER	TITUS MODEL TDCA (12"X12" BACKPAN)
RG-1	SURFACE MOUNT GRILLE	SQUARE	HEAVY DUTY ALUMINUM	WHITE	18X18	100-900	N/A	TITUS MODEL 63FL
RG-2	SURFACE MOUNT GRILLE	SQUARE	HEAVY DUTY ALUMINUM	WHITE	24X20	100-1,600	N/A	TITUS MODEL 63FL

DRAWING NOTES:

- ① O.A. INTAKE LOUVER, GRAVITY DAMPER & GRILLE TO BE ATTACHED TO SHEETMETAL SLEEVE.
- ② CONCRETE PAD, MIN. 4" ABOVE GRADE; 4" LARGER THAN RTU, ALL SIDES.
- ③ ALL EXTERIOR DUCT 12" MIN. ABOVE GRADE.

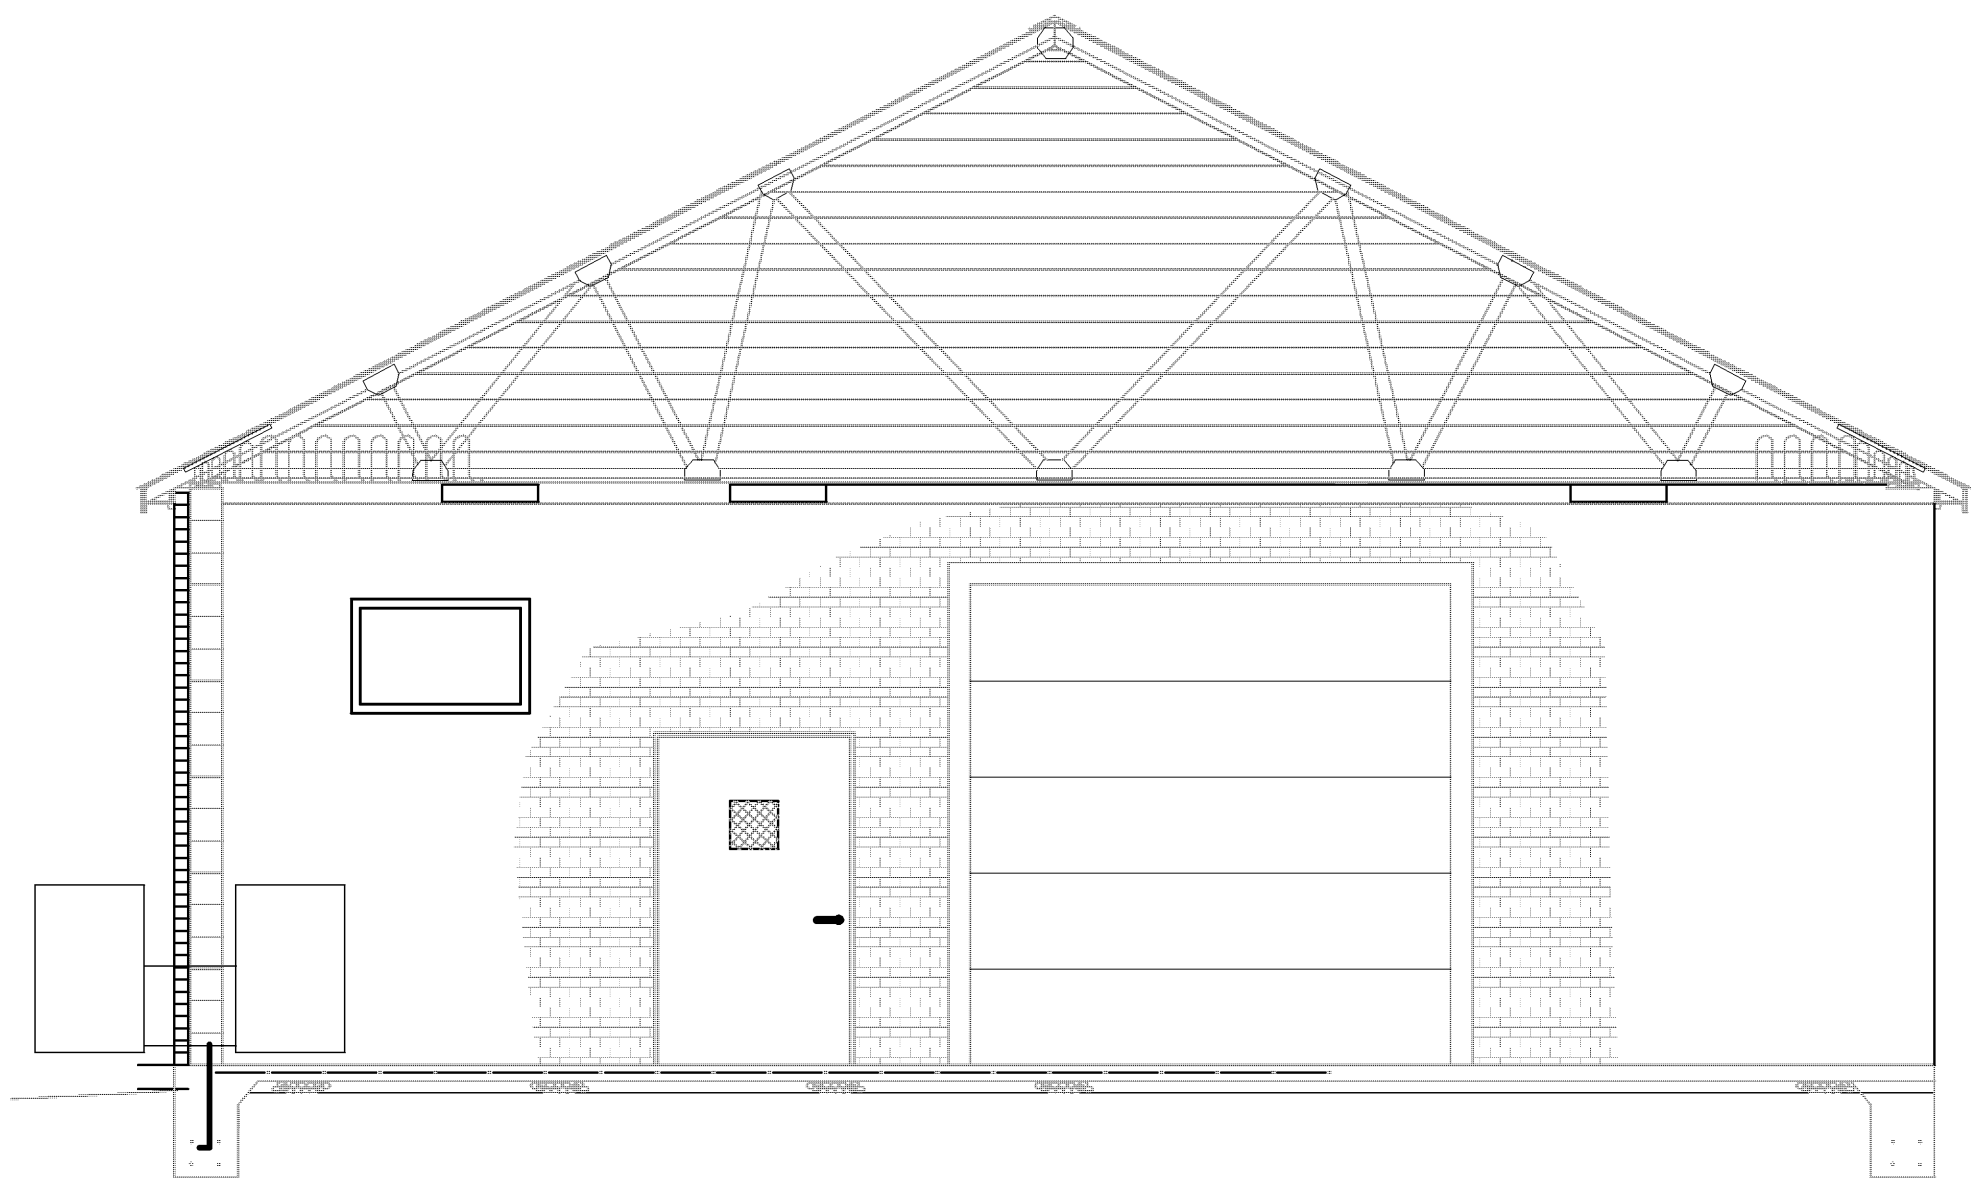

WATER TREATMENT BUILDING MECHANICAL SECTION

SCALE: 1/4" = 1'-0"

MECHANICAL NOTES:

- EXTENT OF THE WORK: CONTRACTOR SHALL FURNISH ALL LABOR, MATERIALS, EQUIPMENT, CONTROLS, & DEVICES NEEDED TO PROVIDE A COMPLETE SYSTEM TESTED AND OPERATING AS SHOWN ON PLANS AND AS SPECIFIED.
- COORDINATION: THE CONTRACTOR SHALL COORDINATE ALL WORK WITH THE BUILDING STRUCTURE AND WORK OF THE OTHER CONTRACTORS & INSTALLERS. THE CONTRACTOR SHALL INFORM OR SUPPLY THE OTHER TRADES WITH ALL APPLICABLE INFORMATION CONCERNING LOCATIONS AND SIZES OF ALL OPENINGS & CLEARANCES NEEDED FOR ALL EQPT, PIPING, & ACCESSORIES SO AS NOT TO HOLD UP BUILDING CONSTRUCTION.
- COMPLIANCE: ALL WORK & MATERIALS SHALL CONFORM TO ALL APPLICABLE CODES, APPLICABLE PROVISIONS OF LATEST EDITION OF NATIONAL FIRE PROTECTION ASSOCIATION, LOCAL UTILITY REGULATIONS, GOVERNMENTAL DEPARTMENTS HAVING JURISDICTION, LOCAL CODES AND MANUFACTURERS' WRITTEN INSTRUCTIONS.
- SUBMITTALS: SUBMIT DRAWINGS AND PRODUCT INFORMATION WHICH INCLUDE COMPLETE SUBMITTALS OF ASSOCIATED SYSTEMS, PRODUCTS, AND ACCESSORIES IN ONE COMPLETE SUBMITTAL.
- DRAWINGS: THESE DRAWINGS ARE ILLUSTRATIVE AND ONLY SHOW THE OVERALL ARRANGEMENT OF SYSTEMS AND WORK. IT IS NOT THE INTENT OF THE DRAWINGS TO INCLUDE EVERY ASPECT OF CONSTRUCTION.
- ACCESS: LOCATE ALL EQUIPMENT, CONTROLS & DAMPERS IN POSITIONS W/ EASY ACCESS FOR SERVICE & ADJUSTMENT.
- CLEANING: MECHANICAL SYSTEMS SHALL BE PROVIDED FREE OF ALL DIRT AND FOREIGN MATERIALS. FURNISH TEMPORARY FILTERS FOR ANY EQUIPMENT OPERATED DURING CONSTRUCTION. SEAL OPENINGS IN THE EQUIPMENT & DUCTWORK UNTIL THEY ARE INSTALLED. REMOVE ALL UNUSED MATERIAL AND WASTE FROM THE JOB SITE RESULTING FROM THE INSTALLATION OF MECHANICAL SYSTEMS.
- SYSTEM NOISE: SYSTEMS SHALL FUNCTION WITHOUT ABNORMAL OR EXCESSIVE NOISE AND/OR VIBRATION.
- TESTING & BALANCING: THE COMPLETE HVAC SYSTEM SHALL BE TESTED, BALANCED & ADJUSTED. A REPORT SHALL BE GIVEN TO THE PROJECT ENGINEER UPON COMPLETION OF WORK.
- OPERATION & MAINTENANCE INSTRUCTIONS: PROVIDE THE OWNER WITH 2 COMPLETE SETS OF OPERATIONS AND MAINTENANCE INSTRUCTIONS FOR THE EQUIPMENT AND SYSTEMS PROVIDED. MANUALS PROVIDED WITH THE EQUIPMENT SHALL BE LEFT WITH THE EQUIPMENT. A COPY OF THESE DOCUMENTS SHALL BE INCLUDED WITH THE SETS GIVEN TO THE OWNER.
- GARANTEE: EQUIPMENT, MATERIALS, AND LABOR REQUIRED BY THESE DRAWINGS AND SPECIFICATIONS SHALL BE GUARANTEED TO BE FREE FROM DEFECTIVE MATERIALS FOR ONE (1) YEAR AFTER FINAL ACCEPTANCE OF THE PROJECT UNLESS SPECIFIED FOR A LONGER PERIOD IN OTHER PORTIONS OF THESE SPECIFICATIONS. DEFECTIVE MATERIALS OR WORKMANSHIP OCCURRING DURING THIS PERIOD SHALL BE CORRECTED AT NO ADDITIONAL COST. ANY GUARANTEE GIVEN BY THE MANUFACTURERS SHALL BE HONORED (BY THE MANUFACTURER, MANUFACTURERS' REPRESENTATIVE, & INSTALLER) FOR THE PERIOD STATED IN THE MANUFACTURERS' LITERATURE.
- SQUARE & RECTANGULAR DUCTWORK:
  - GENERAL - DUCTWORK SHALL BE ZINC-COATED SHEET STEEL OR ALUMINUM, CONSTRUCTED AND INSTALLED AS RECOMMENDED BY THE LATEST EDITION OF SMACNA.
  - DUCT CLEARANCE SHALL BE ESTABLISHED AT THE JOB SITE BEFORE ANY DUCTS ARE FABRICATED.
  - MANUAL VOLUME CONTROL DAMPERS SHALL HAVE ACCESSIBLE OPERATING MECHANISM.
  - ANY DAMPERS IN SQUARE DUCT OVER 12" TO BE MANUFACTURED PARALLEL OR OPPOSED BLADE, COMPLETE W/ HAND QUADRANTS.
  - TURNING VANES SHALL BE PROVIDED IN ALL SQUARE ELBOWS. DOUBLE THICKNESS VANES TO BE PROVIDED IN DUCTWORK OVER 14".
  - PROVIDE FLEXIBLE DUCT CONNECTION BETWEEN THE SUPPLY AND RETURN DUCTS FROM AIR HANDLING EQUIPMENT.
  - ROUND DUCT TAKEOFFS IN SUPPLY ARE TO BE MADE WITH SIDE TAKEOFFS ONLY. NO SPIN-INS OR STAB-INS PERMITTED.
- INSULATION & SEALANT:
  - THE FINISHED DUCT SYSTEM SHALL MEET THE REQUIREMENTS OF NFPA 90A & 90B. ALL MATERIALS USED SHALL NOT HAVE A COMPOSITE FLAME SPREAD RATING OF OVER 25 AND A SMOKE DEVELOPED RATING EXCEEDING 50.
  - DUCT WRAP INSULATION SHALL MEET THE REQUIREMENTS OF ASTM C 1290, TYPE III, TO MAXIMUM SERVICE TEMPERATURE OF 250°F. FACING MATERIAL SHALL MEET THE REQUIREMENTS OF ASTM C 1136, TYPE II, WHEN SURFACE BURNING CHARACTERISTICS ARE DETERMINED IN ACCORDANCE WITH ASTM 84 WITH THE FOIL SURFACE OF THE MATERIAL EXPOSED TO THE FLAME AS IT IS IN THE FINAL COMPOSITE.
  - ALL EXTERIOR LOW PRESSURE DUCTWORK SHALL BE INSULATED WITH DUCT BOARD WITH AS-INSTALLED MIN. R-8 RATING. SEALED W/ WEATHER PROOF MASTIC SEALER & COVERED W/ A WATER-TIGHT 0.032" THK ALUMINUM JACKET W/ 2-1/2"X5/8" CORRUGATIONS.
  - ALL LOW PRESSURE SUPPLY, RETURN, & RELIEF DUCTWORK SHALL BE INSULATED W/ MIN. R-5 AS INSTALLED DUCT WRAP INSULATION, W/ KRAFT PAPER VAPOR BARRIER RETARDER WITH A 2" MIN. STAPLING & TAPING ON ONE EDGE. ALL JOINTS SHALL BE SEALED W/ PRESSURE SENSITIVE TAPE MATCHING THE INSULATION FACING.
  - ALL DUCTWORK IS TO BE SEALED WITH A WATER BASED SEALANT MEETING APPROPRIATE U.L. LISTINGS & ASTM REQUIREMENTS.
- SUPPLY AIR FLEX. DUCT & ROUND DUCT SIZE SHALL MATCH THAT OF ASSOCIATED CEILING DIFFUSER NECK.
- FLEX DUCT RUNOUT SHALL NOT EXCEED 8 FT. IN LENGTH.
- DUCT DIMENSIONS SHOWN ARE INSIDE CLEAR DIMENSIONS.

1	8/28/09	VDH/OWNER COMMENTS
2	9/3/09	OWNER COMMENTS
3	10/7/09	ADDENDUM #2
4	11/17/09	FRANKLIN COUNTY COMMENTS
5	3/14/12	ASBUILTS

WATER TREATMENT BUILDING MECHANICAL PLAN

SCALE: 1/4" = 1'-0"



LEGEND:

- SUPPLY DUCT SECTION
- RETURN, EXHAUST OR OUTSIDE AIR DUCT SECTION
- DUCT SIZE, INCHES, FIRST DIM. IS SIDE SHOWN
- MANUAL DAMPER
- GRAVITY BACKDRAFT DAMPER
- SQUARE ELBOW WITH MULTIPLE TURNING VANES
- ELBOW TURNING UP
- ELBOW TURNING DOWN
- RETURN OR EXHAUST REGISTER
- DIFFUSER W/ 4-WAY AIR PATTERN UNLESS INDICATED OTHERWISE
- XX-X/XXX INLET OR OUTLET "MARK"/CFM
- NEW DUCT

