


Boone Magisterial District, Franklin County, Virginia

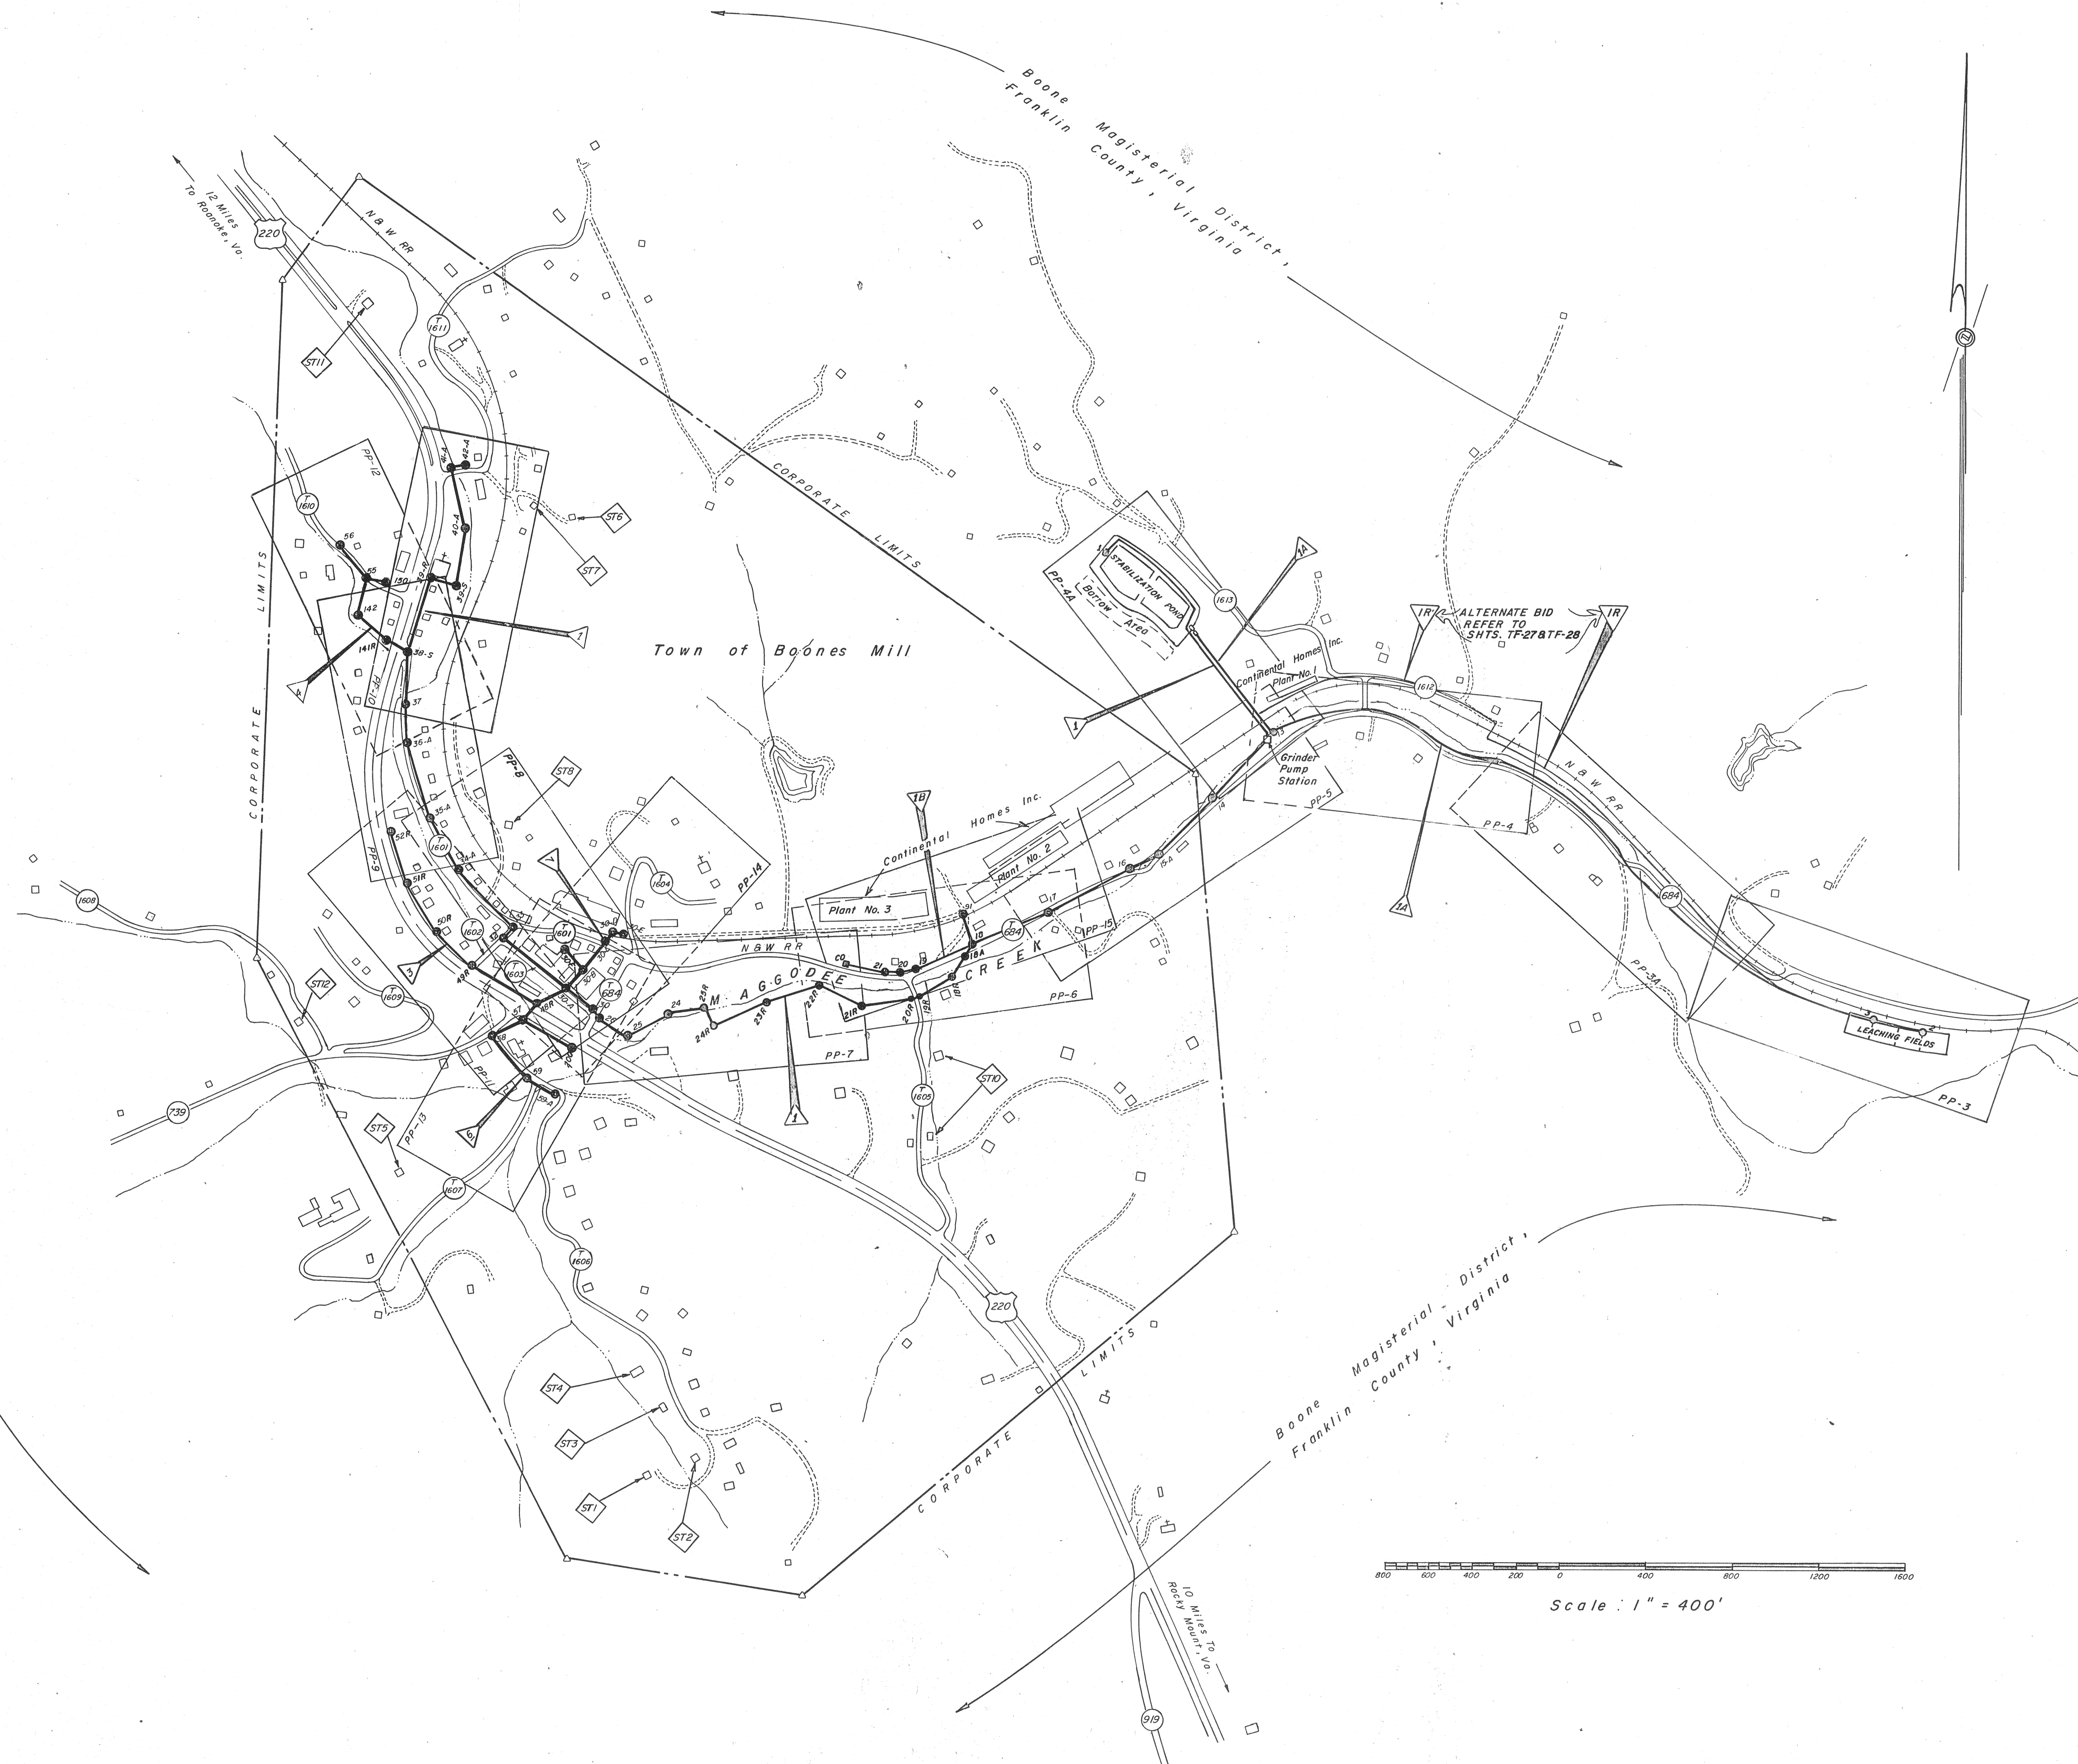


LEGEND:

- Property Line
- R/W Right-of-Way Line
- Edge of Pavement
- Power Line
- Power Pole
- Telephone Line
- Telephone Pole
- Proposed Sanitary Sewer Line
- Proposed Manhole
- Proposed Cleanout
- Creek
- Tree
- Scattered Hardwood Trees
- Thick Undergrowth
- Hedge
- Swampy
- Fence
- Water Line
- Water Meter
- Water Valve and Box
- Fire Hydrant
- Bench Mark
- Residences Requiring Septic Tank And Drainfield
- Sewer Line No.

"AS BUILT" PLANS

REVISIONS
3-6-85
6-3-85
8-1-85
9-23-88
"As Built"

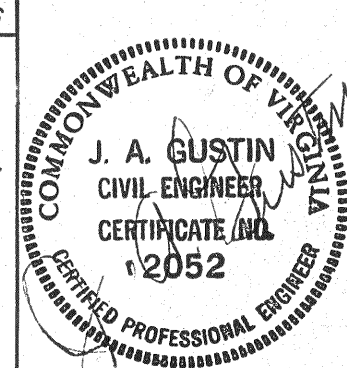

TOWN OF BOONES MILL	
INDEX SHEET	
J. A. GUSTIN & ASSOCIATES CONSULTING ENGINEERS MARTINSVILLE, VIRGINIA	
DESIGNED BY	SCALE As Noted
DRAWN BY RLD	DATE 11-23-81
CHECKED BY NRC, JAG	SHEET NO. IS-2