


DATE	
BY	
NO.	
PLAN	
REVISIONS	
NOTE BOOK	
ALIGNMENT CHECKED	
ST. OF WAY CHECKED	
NO.	

DATE	
BY	
NO.	
PROFILE	
REVISIONS	
NOTE BOOK	
GRADES CHECKED	
STRUCTURE NOTATIONS CHECKED	
NO.	

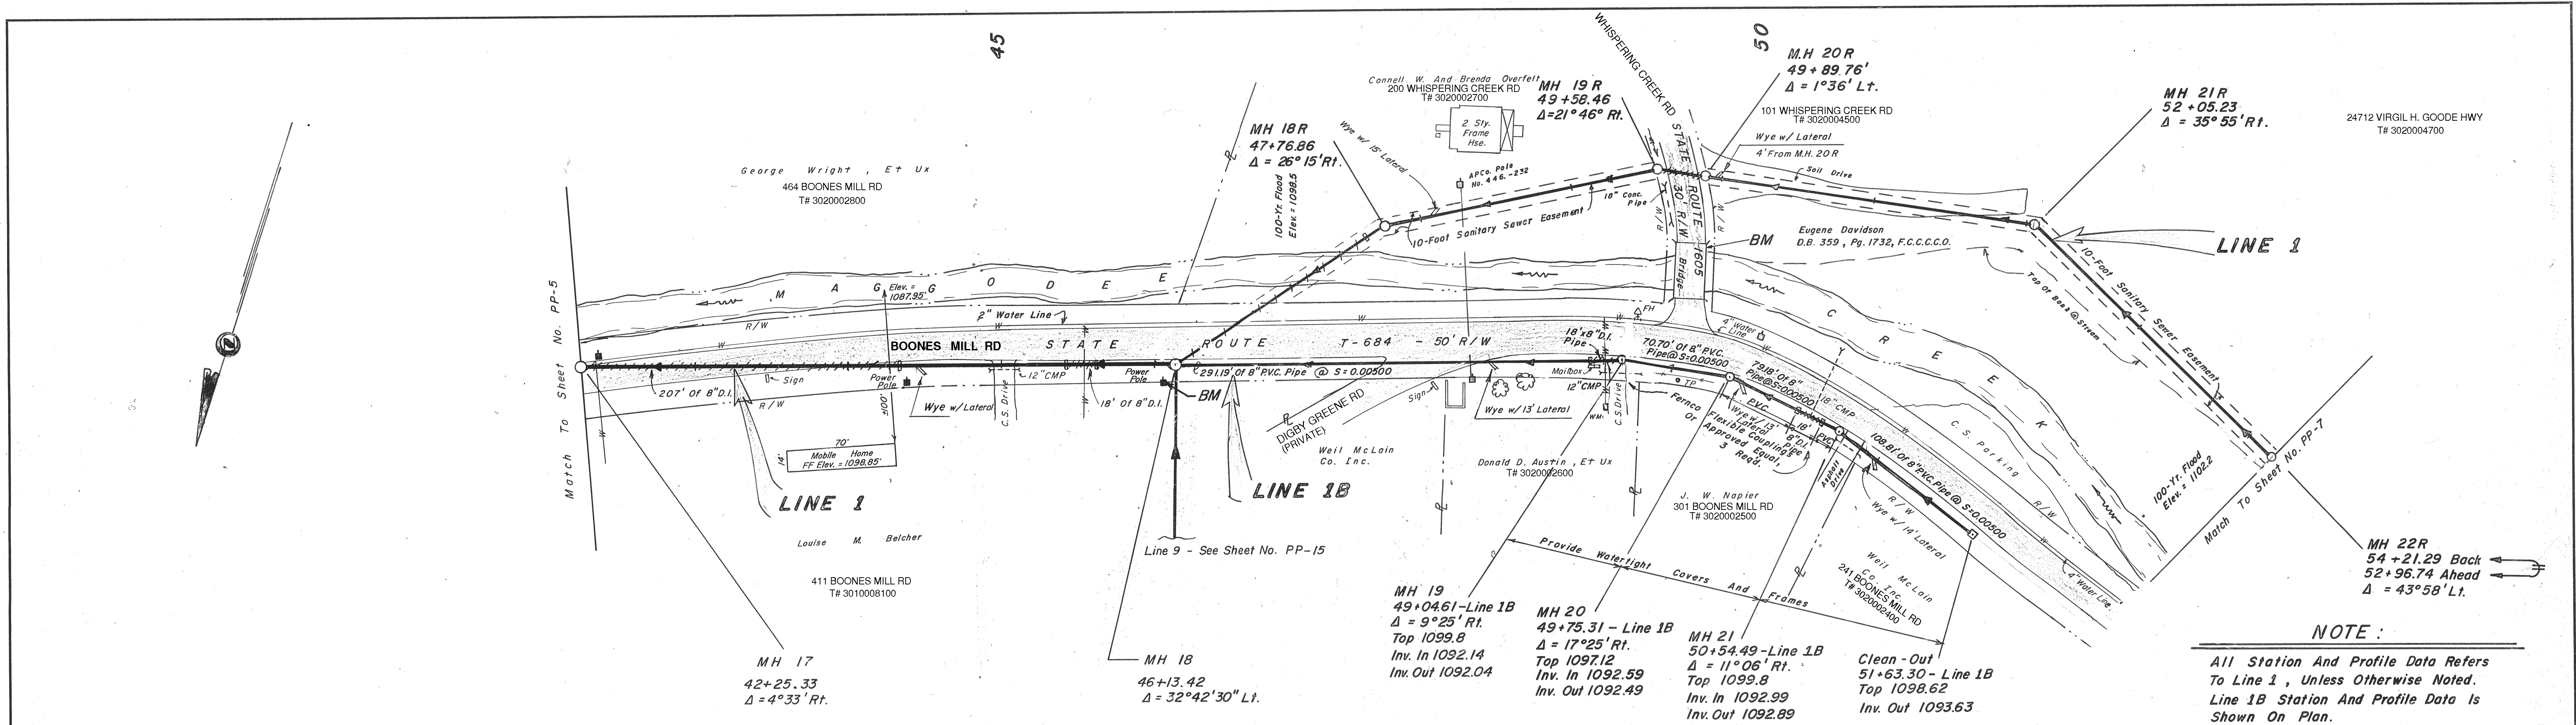

NOTE:
All Station and Profile Data Refers To Line 1, Unless Otherwise Noted. Line 1B Station and Profile Data Is Shown On Plan.


BENCH MARK:

Big Nail in Power Pole No. 446-230
15' From MH 19
Elev. = 1098.46'

BENCH MARK:

Chiseled "□" on the Southwest Corner
of the Bridge Abutment.
Elev. = 1098.78'

09/11/2018 - NEW INFO ADDED

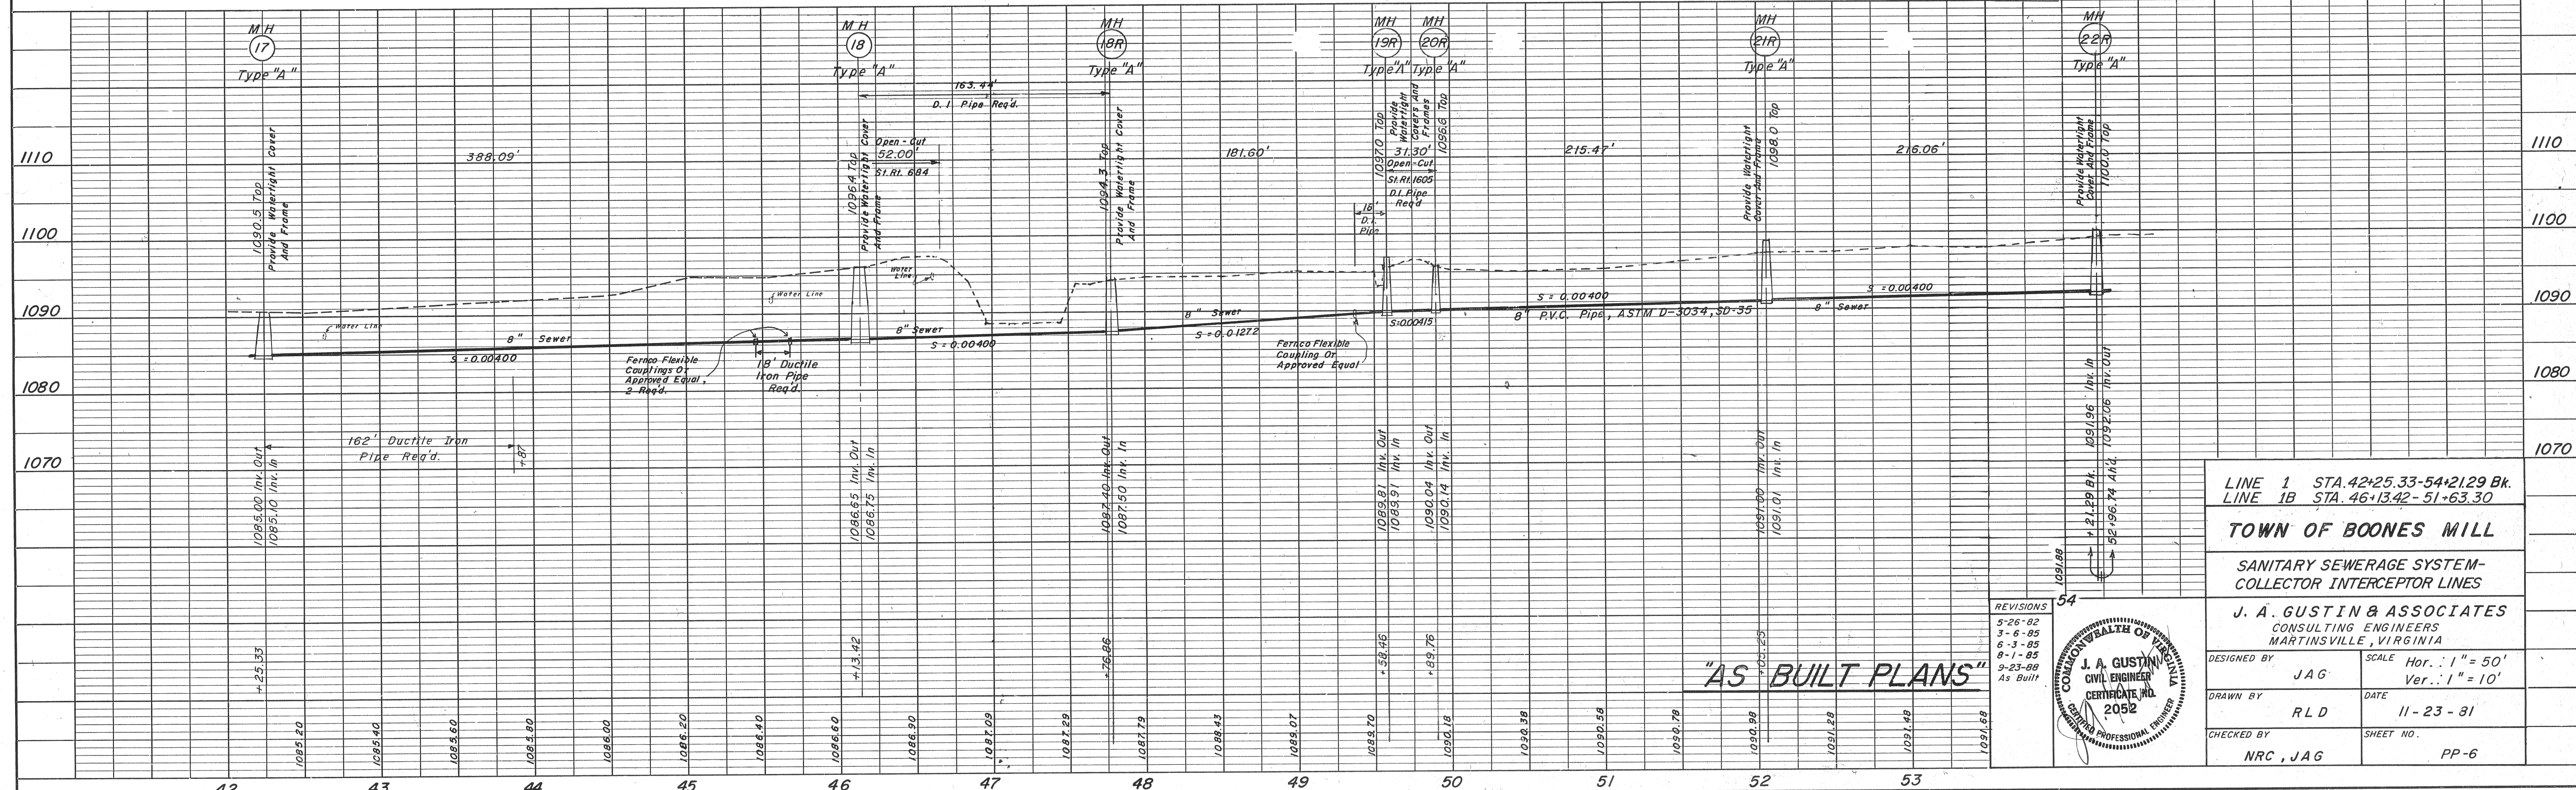


LINE 1 STA. 42+25.33-54+21.29 Bk.
LINE 1B STA. 46+13.42-51+63.30

TOWN OF BOONES MILL

SANITARY SEWERAGE SYSTEM-
COLLECTOR INTERCEPTOR LINES

J. A. GUSTIN & ASSOCIATES
CONSULTING ENGINEERS
MARTINSVILLE, VIRGINIA

DESIGNED BY	JAG	SCALE	Hor.: 1" = 50' Ver.: 1" = 10'
DRAWN BY	RLD	DATE	11-23-81
CHECKED BY	NRC, JAG	SHEET NO.	PP-6

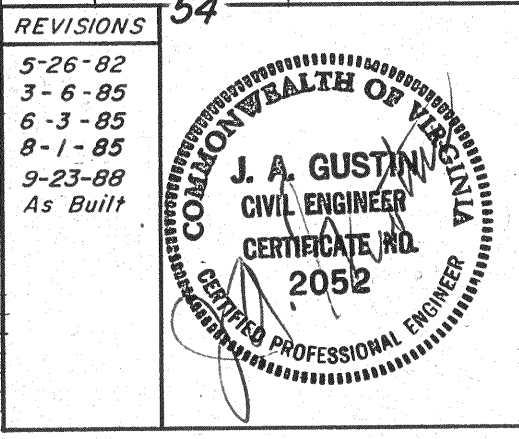

"AS BUILT PLANS"