
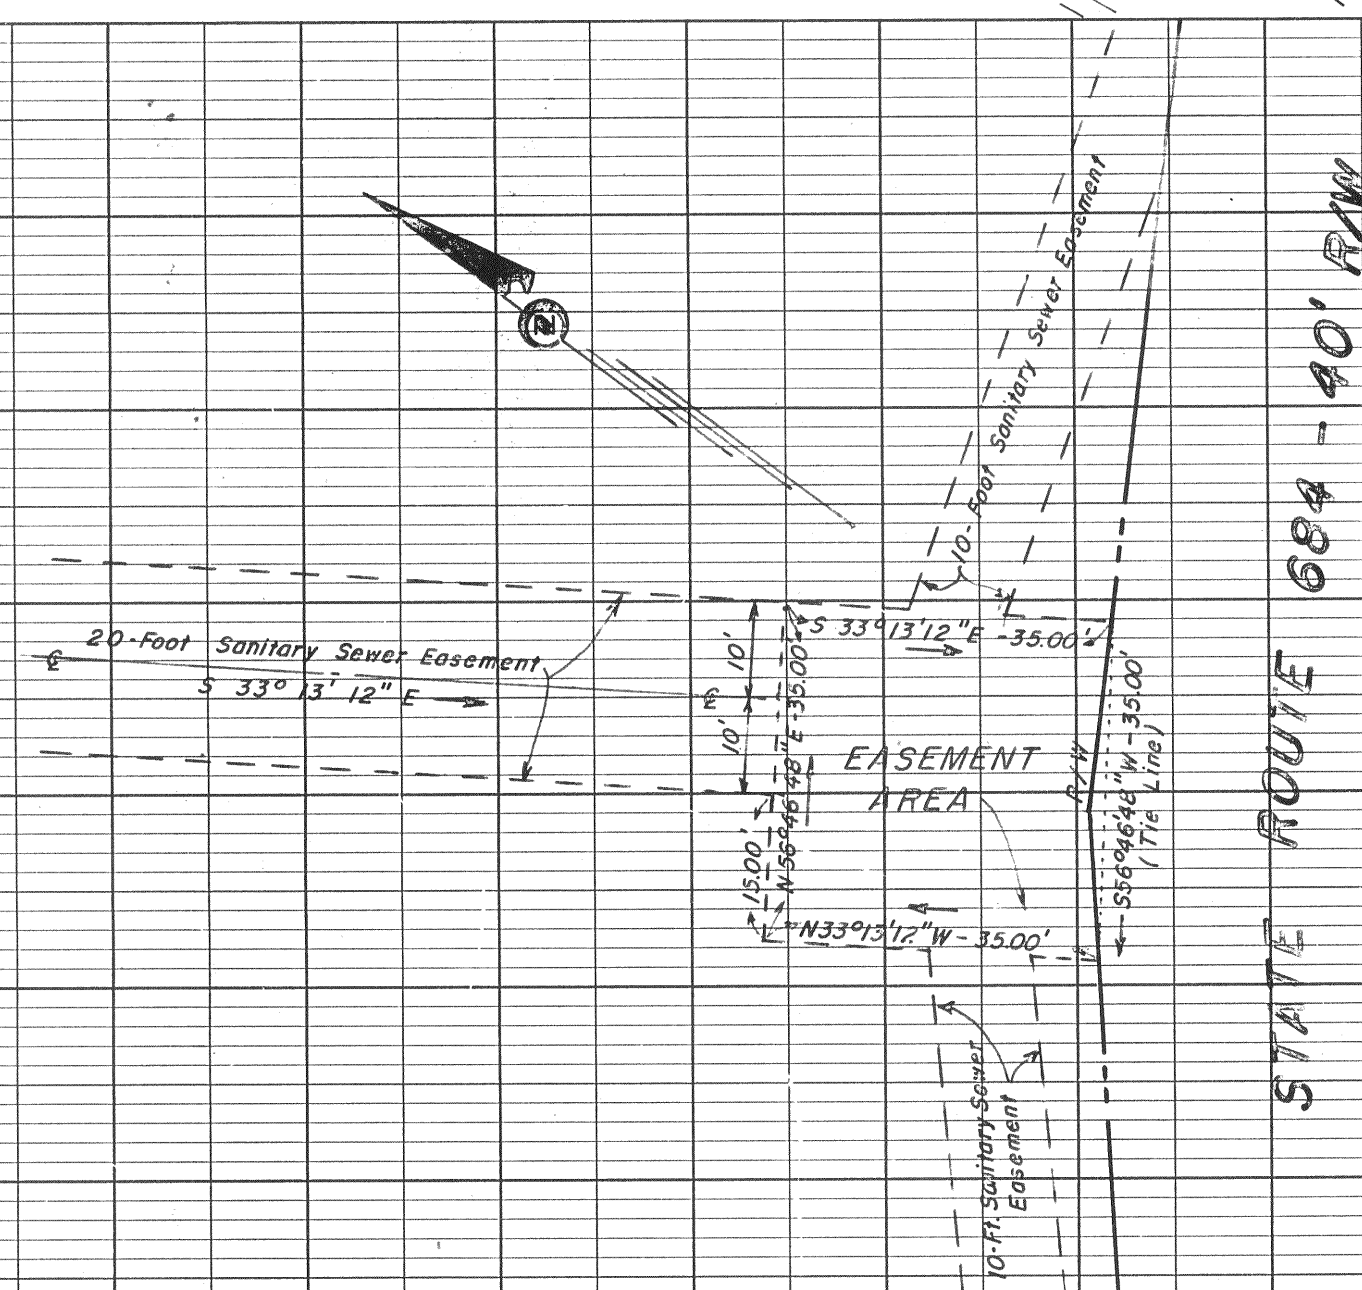




PROFILE	SURVEYED _____	BY _____	DATE _____
NOTE BOOK	PLOTTED _____		
	GRADES CHECKED _____		
	B. M.'S NOTED _____		
NO. _____	STRICTIONS NOTATIONS CH'KD _____		

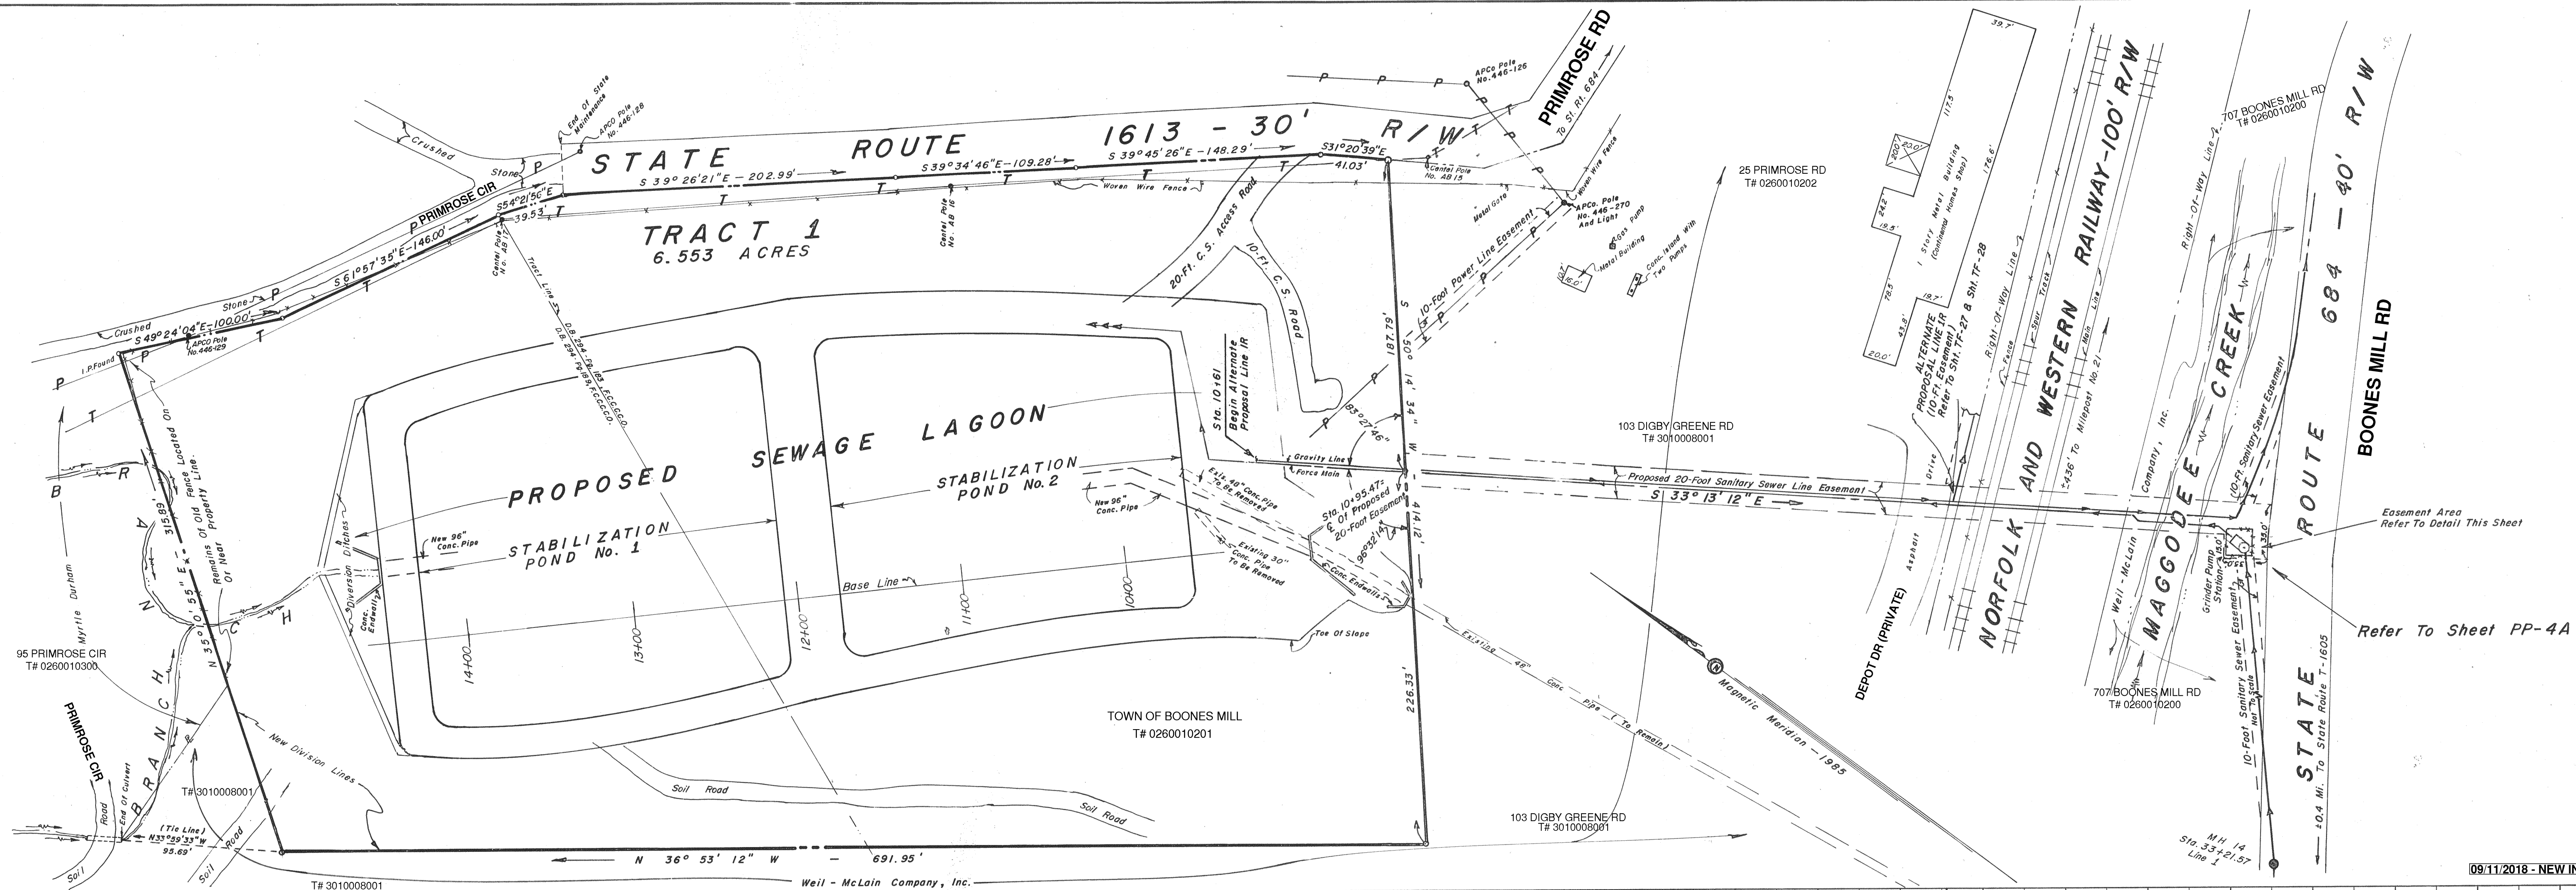

DETAIL @ GRINDER PUMP STA. EASEMENT AREA

Scale : 1" = 20'

"AS BUILT PLANS"

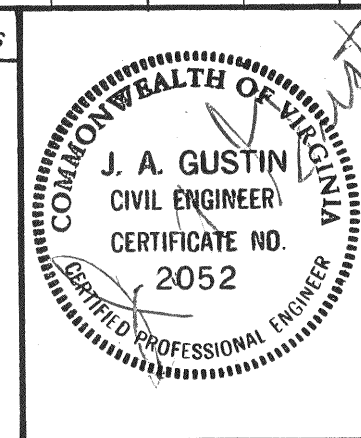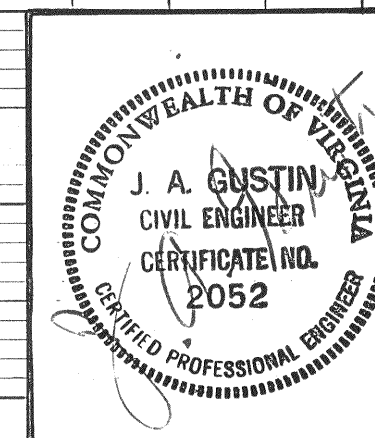

TOWN OF BOONES MILL PROPOSED TREATMENT PLANT SITE ON PROPERTY OF CONTINENTAL HOMES J. A. GUSTIN & ASSOCIATES CONSULTING ENGINEERS MARTINSVILLE, VIRGINIA	
DESIGNED BY: JAG, JRT	SCALE: Hor. : 1" = 50' Ver. : 1" = 10'
DRAWN BY: TAW	DATE: 6-3-85
CHECKED BY: JAG	SHEET NO. TF-16A