

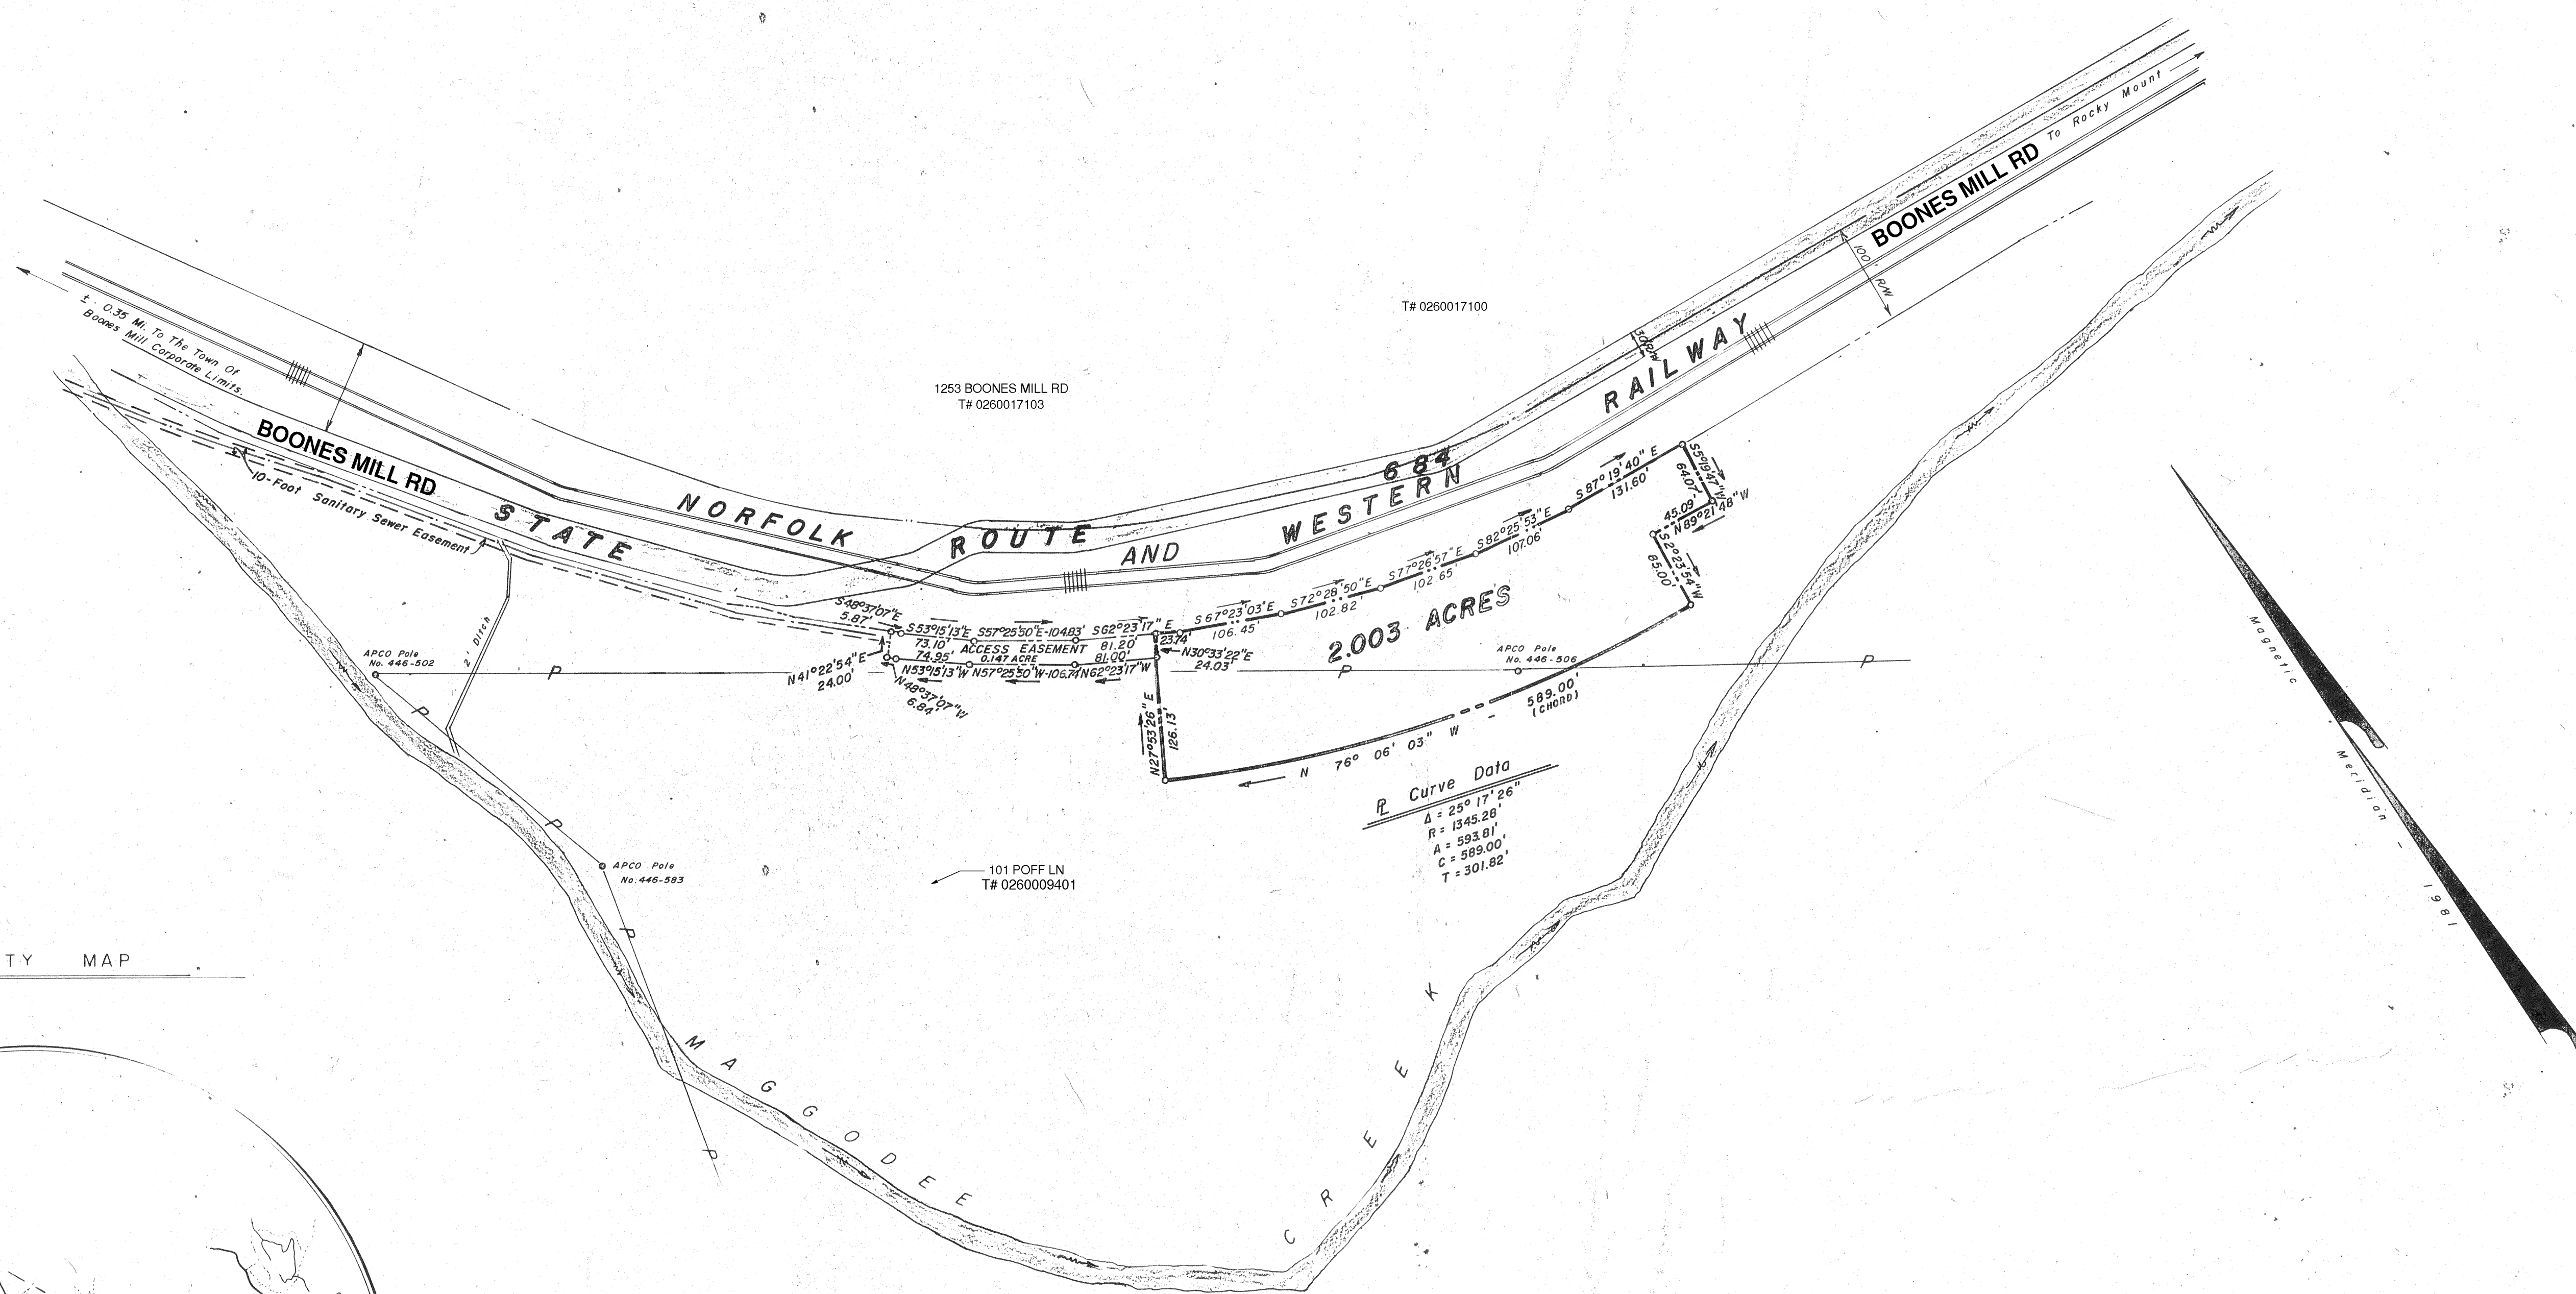


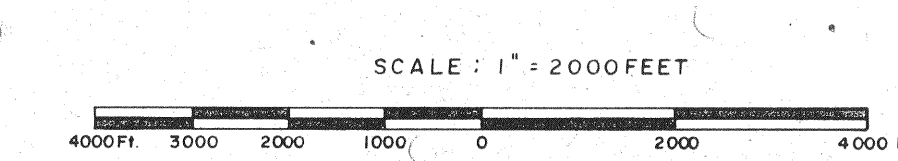

VICINITY MAP

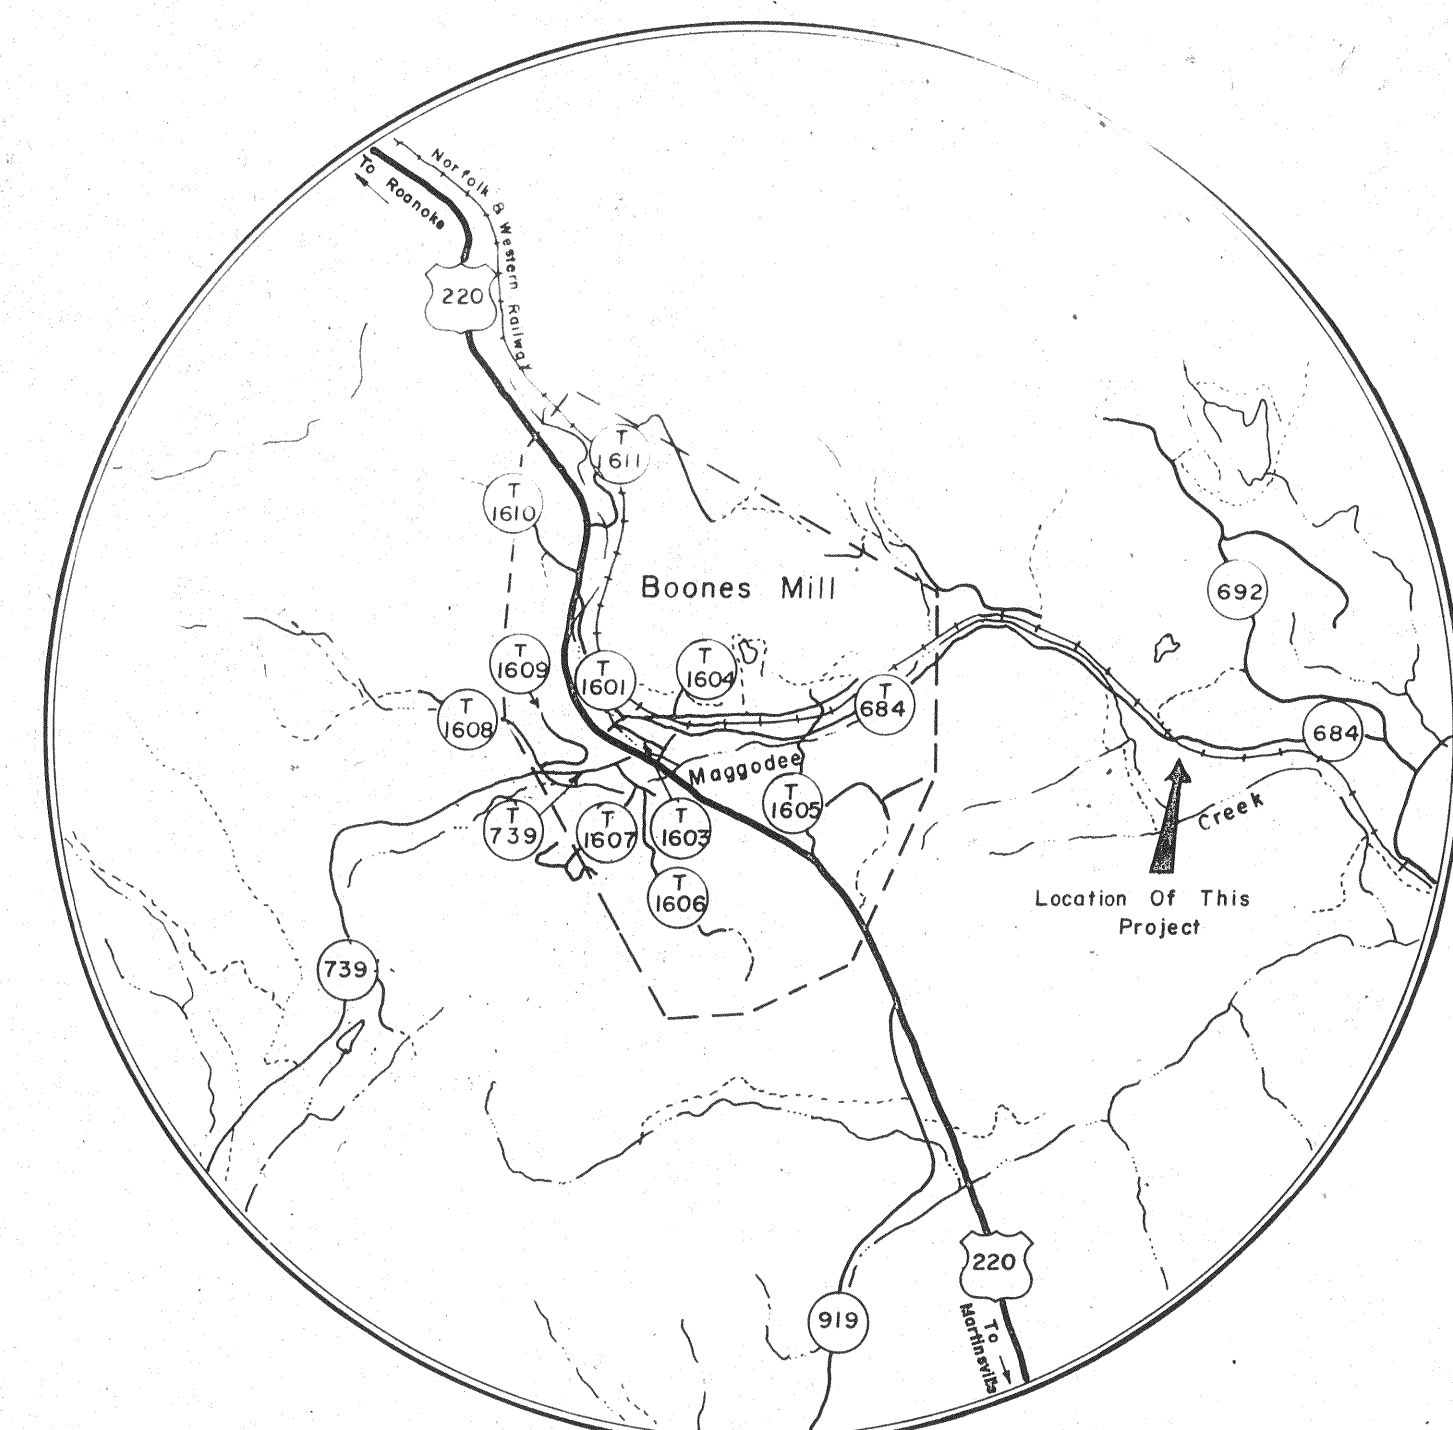

"AS BUILT PLANS"

		REVISIONS 6-3-85		TOWN OF BOONES MILL LEACHING FIELD SITE J.A. GUSTIN & ASSOCIATES CONSULTING ENGINEERS MARTINSVILLE, VIRGINIA
DESIGNED BY	SCALE		1" = 100'	
DRAWN BY	DATE		3-21-85	
CHECKED BY	SHEET NO.		TF-16B	
NRC, JAG				

09/11/2018 - NEW INFO ADDED