


DETAIL @ TEMPORARY SEDIMENT BASIN

SCALE : 1" = 5'

- ## NOTES:
1. STD. & SPEC. REFERENCES ARE FROM THE VIRGINIA EROSION AND SEDIMENT CONTROL HANDBOOK. CONSTRUCTION SHALL BE IN ACCORDANCE WITH THE RECITED STD. & SPEC. AND WITH THE PROJECT SPECIFICATION ARTICLE 23 SECTION 23.23.
 2. IF SITE CONDITIONS SHOW FURTHER EROSION AND SEDIMENT CONTROL MEASURES ARE REQUIRED THE CONTRACTOR SHALL PROCEED ACCORDING TO ARTICLE 23 SECTION 23.23 OF THE PROJECT SPECIFICATIONS.

PRIMROSE RD

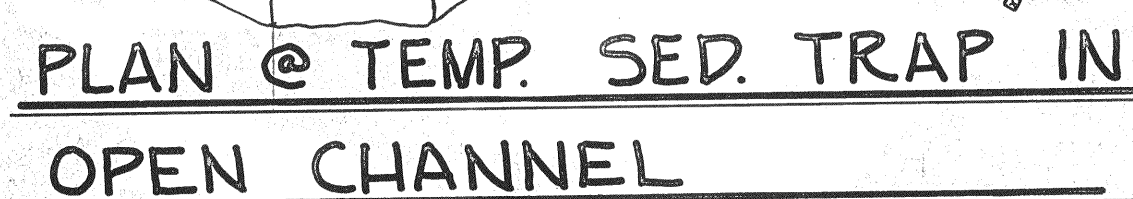

NOT TO SCALE



SCALE : 1" = 1'-0"

DIVERSION DITCH SHALL BE
CONSTRUCTED TO SUIT
FIELD CONDITIONS.

STABILIZATION POND EROSION AND SEDIMENT CONTROL PLAN

SCALE : 1" = 30

6" AGGR. COURSE, TYPE I

Col. Stop

1'-1" 3'-1" 3'-1" 1'-1"

6" 4' 10' 10' 4'

4' 7' 7' 4'

Stabilization Ponds

Leaching Fields

28' - Stabilization Ponds

23' - Leaching Fields

TYP. SECTION C. S. ACCESS ROAD

Scale: 1" = 10'

"AS BUILT PLANS"

COMMONWEALTH OF VIRGINIA
J. A. GUSTIN
CIVIL ENGINEER
CERTIFICATE NO.
2052

CHECKED BY	SHEET NO
JAG	TF-17C

TYP. SECTION @ EXISTING BRANCH CHANNEL

Scale 1" = 5'