



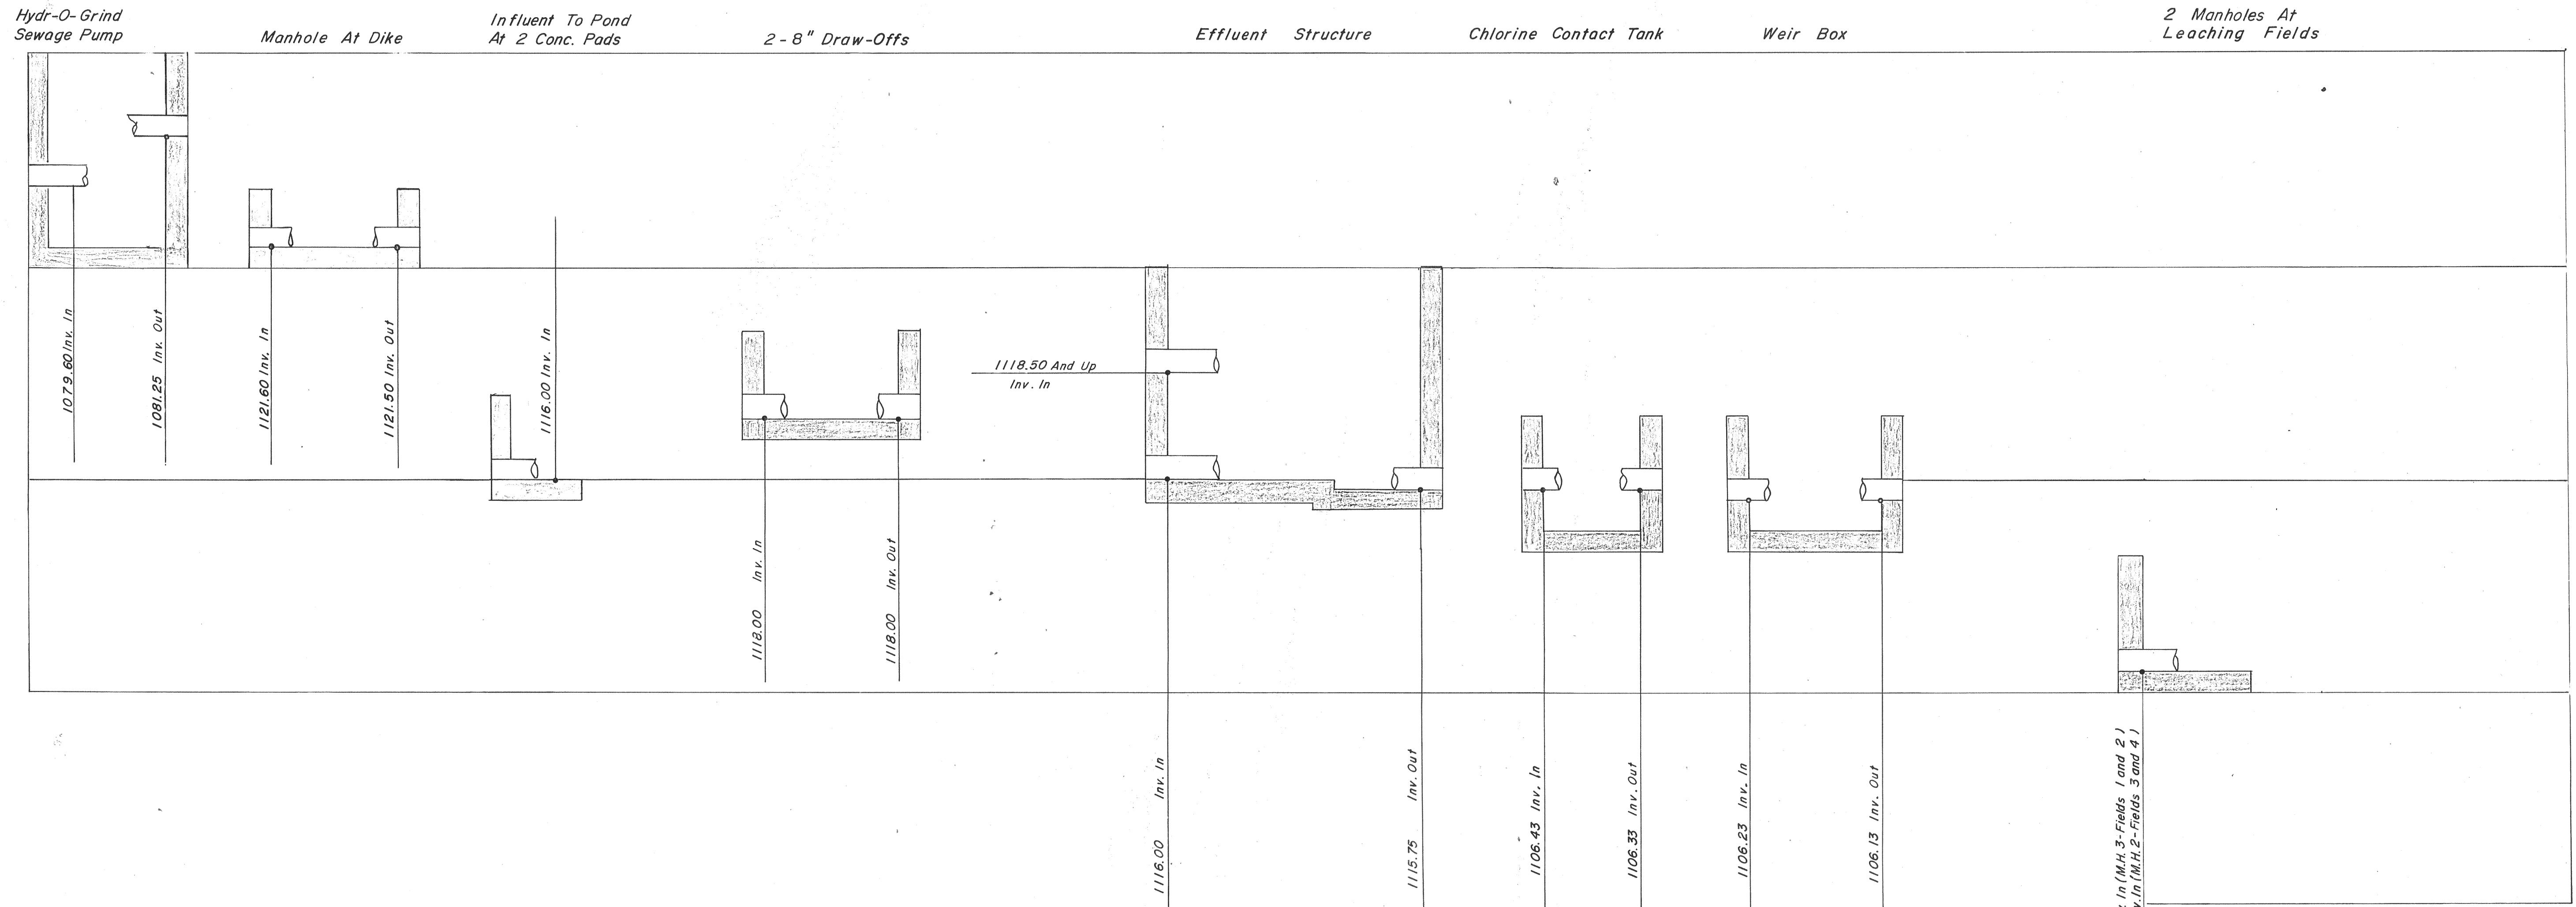

HYDRAULIC PROFILE

NOT TO SCALE

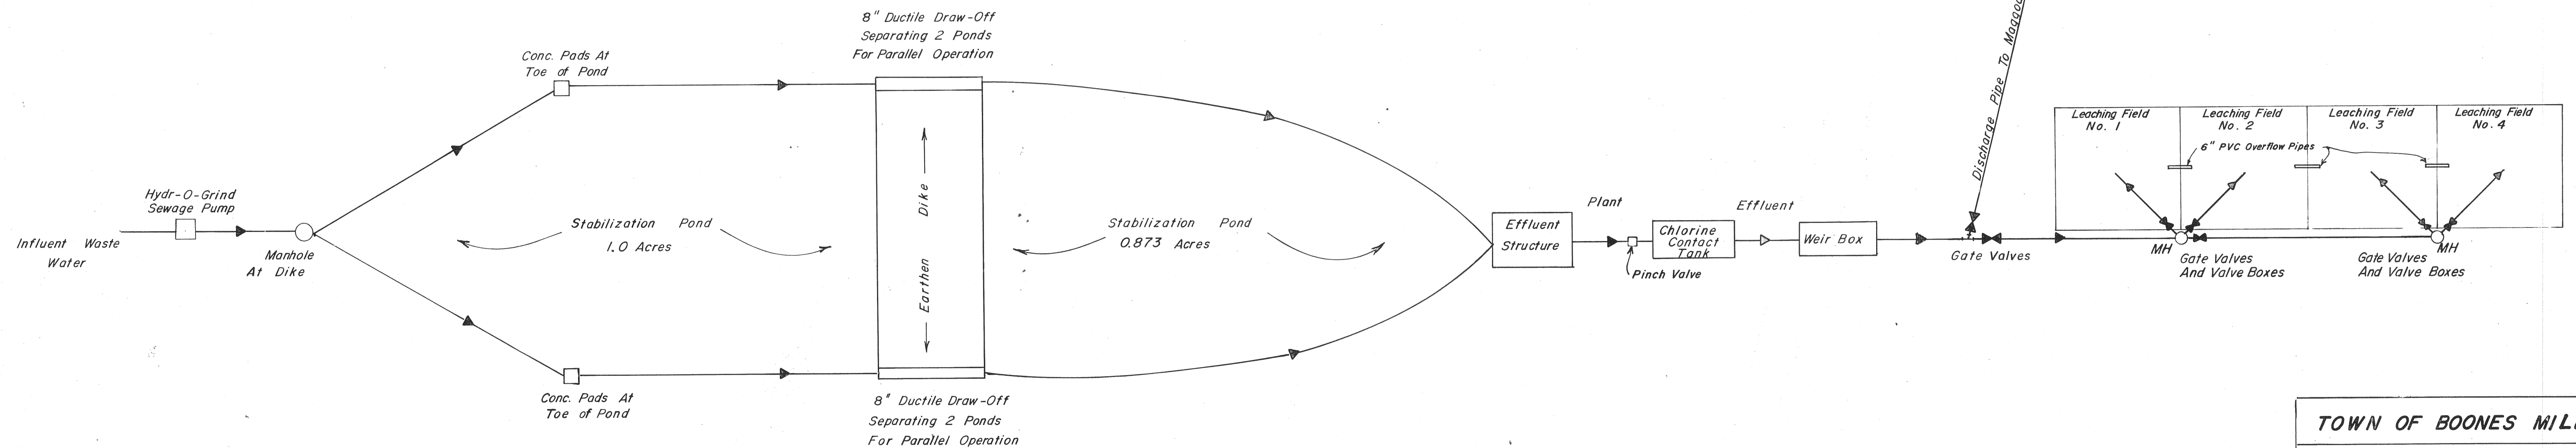

SCHEMATIC FLOW DIAGRAM

NOT TO SCALE

"AS BUILT PLANS"

TOWN OF BOONES MILL

STABILIZATION POND SITE

HYDRAULIC PROFILE AND  
SCHEMATIC FLOW DIAGRAM

J. A. GUSTIN & ASSOCIATES  
CONSULTING ENGINEERS  
MARTINSVILLE, VIRGINIA

DESIGNED BY  
RLD & JAG

SCALE  
None

DRAWN BY  
JRT & MAS

DATE  
11-23-81

CHECKED BY  
NRC, JAG

SHEET NO.  
TF-18

REVISIONS  
3-6-85  
6-3-85  
8-1-85

