

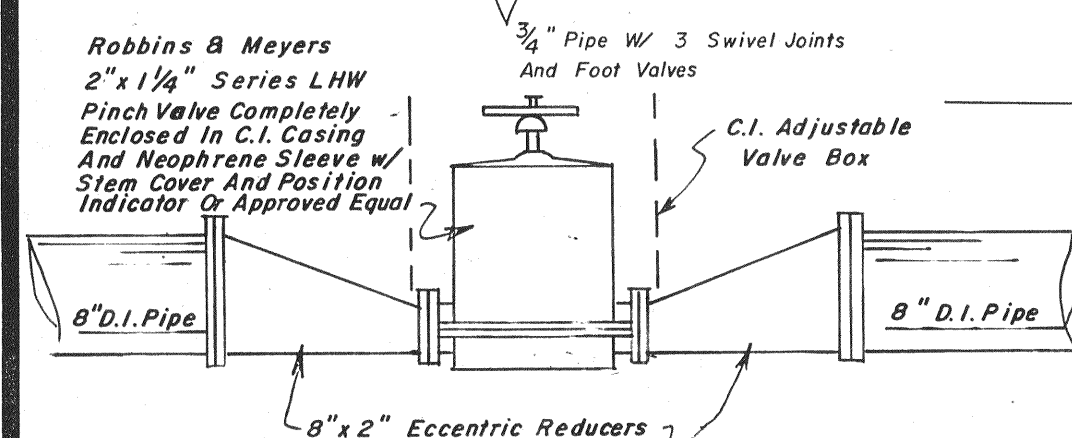


NOTE: Fiberglass Grating Shall Be McNichols Pultruded I-Beam Type w/ 1 1/2" Bars at 12" O.C. x 54" Wide. Fasteners Where Req'd Shall Be Saddle Clip Type T8F. Approved Equals Shall Be Acceptable.

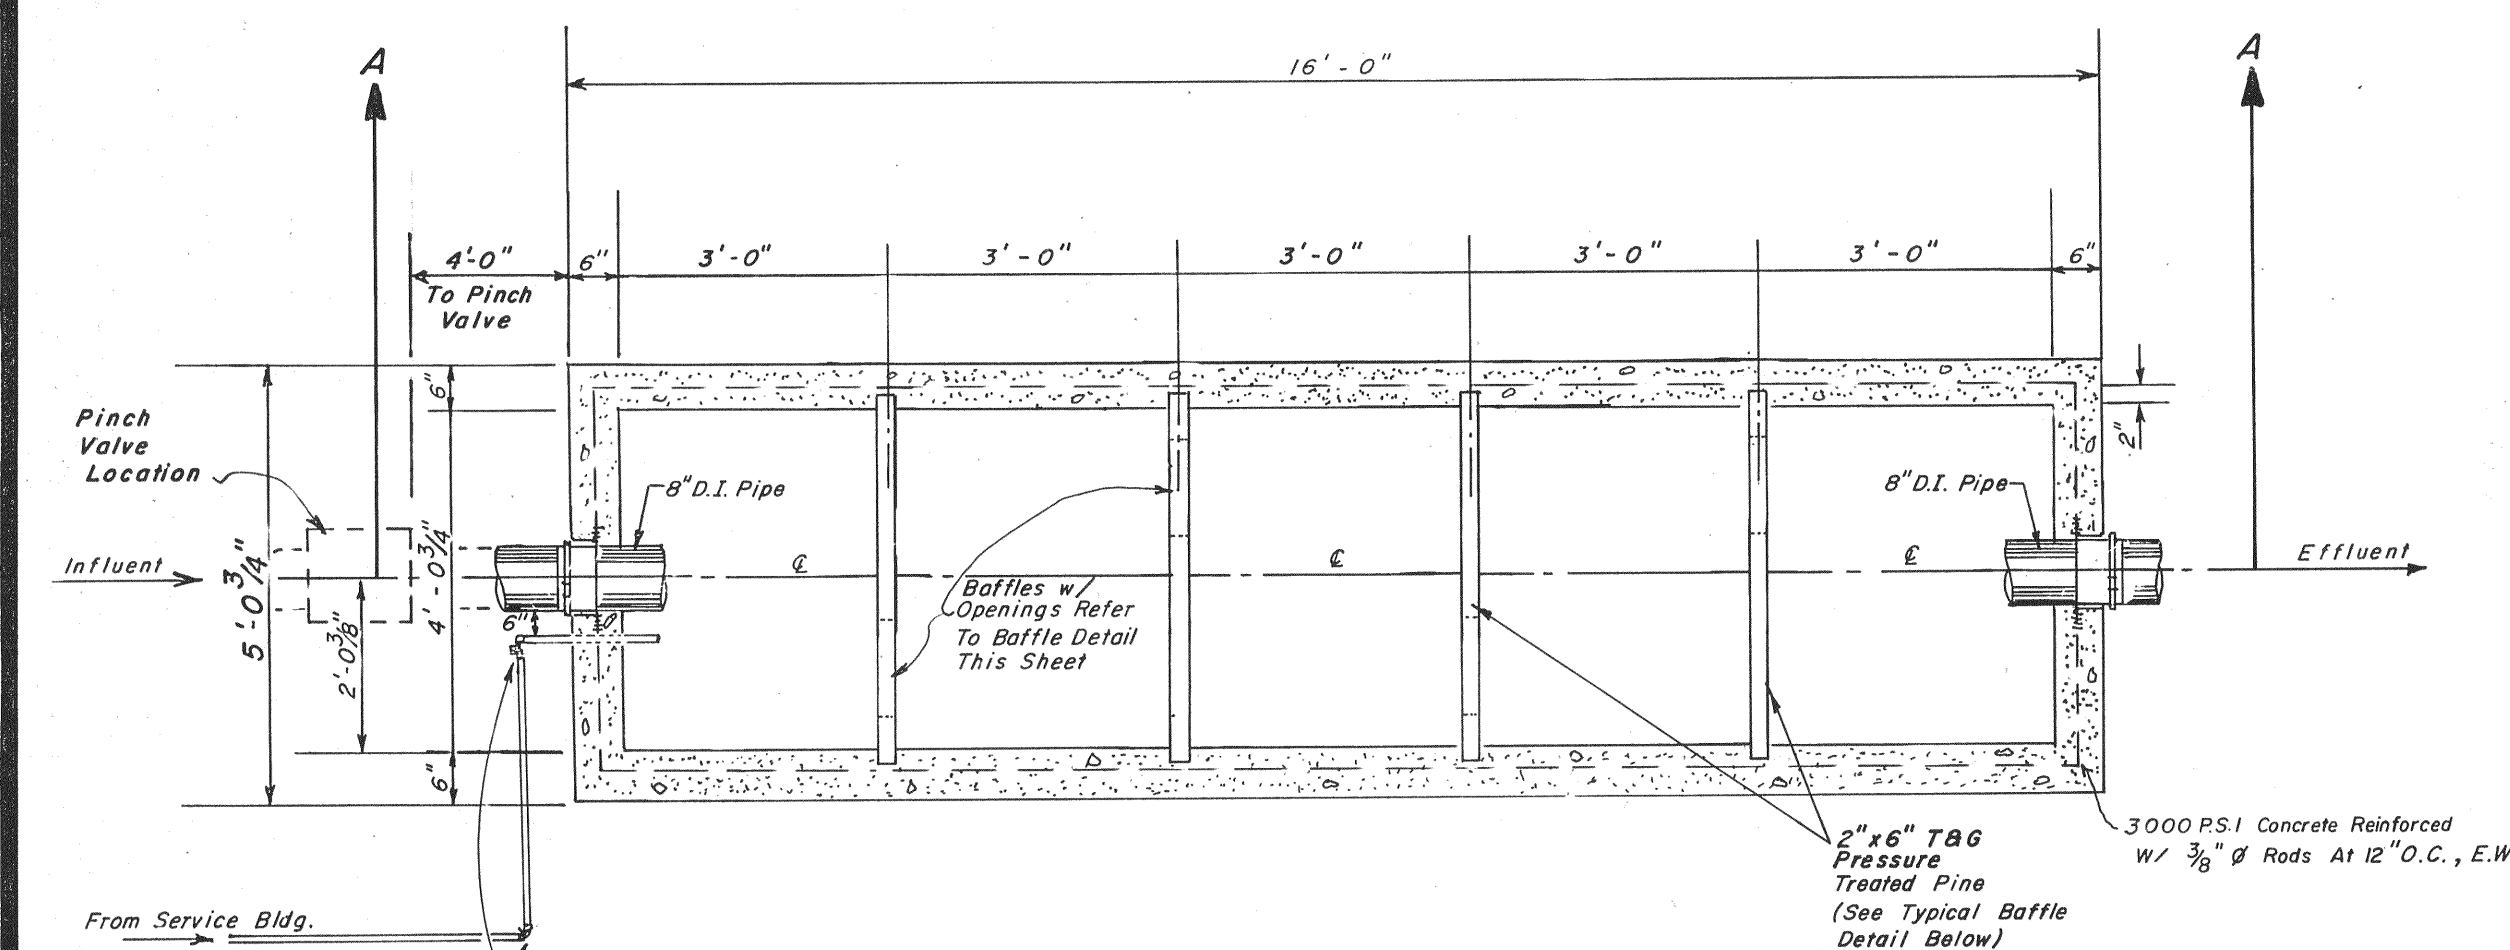


PINCH VALVE DETAIL

Not To Scale

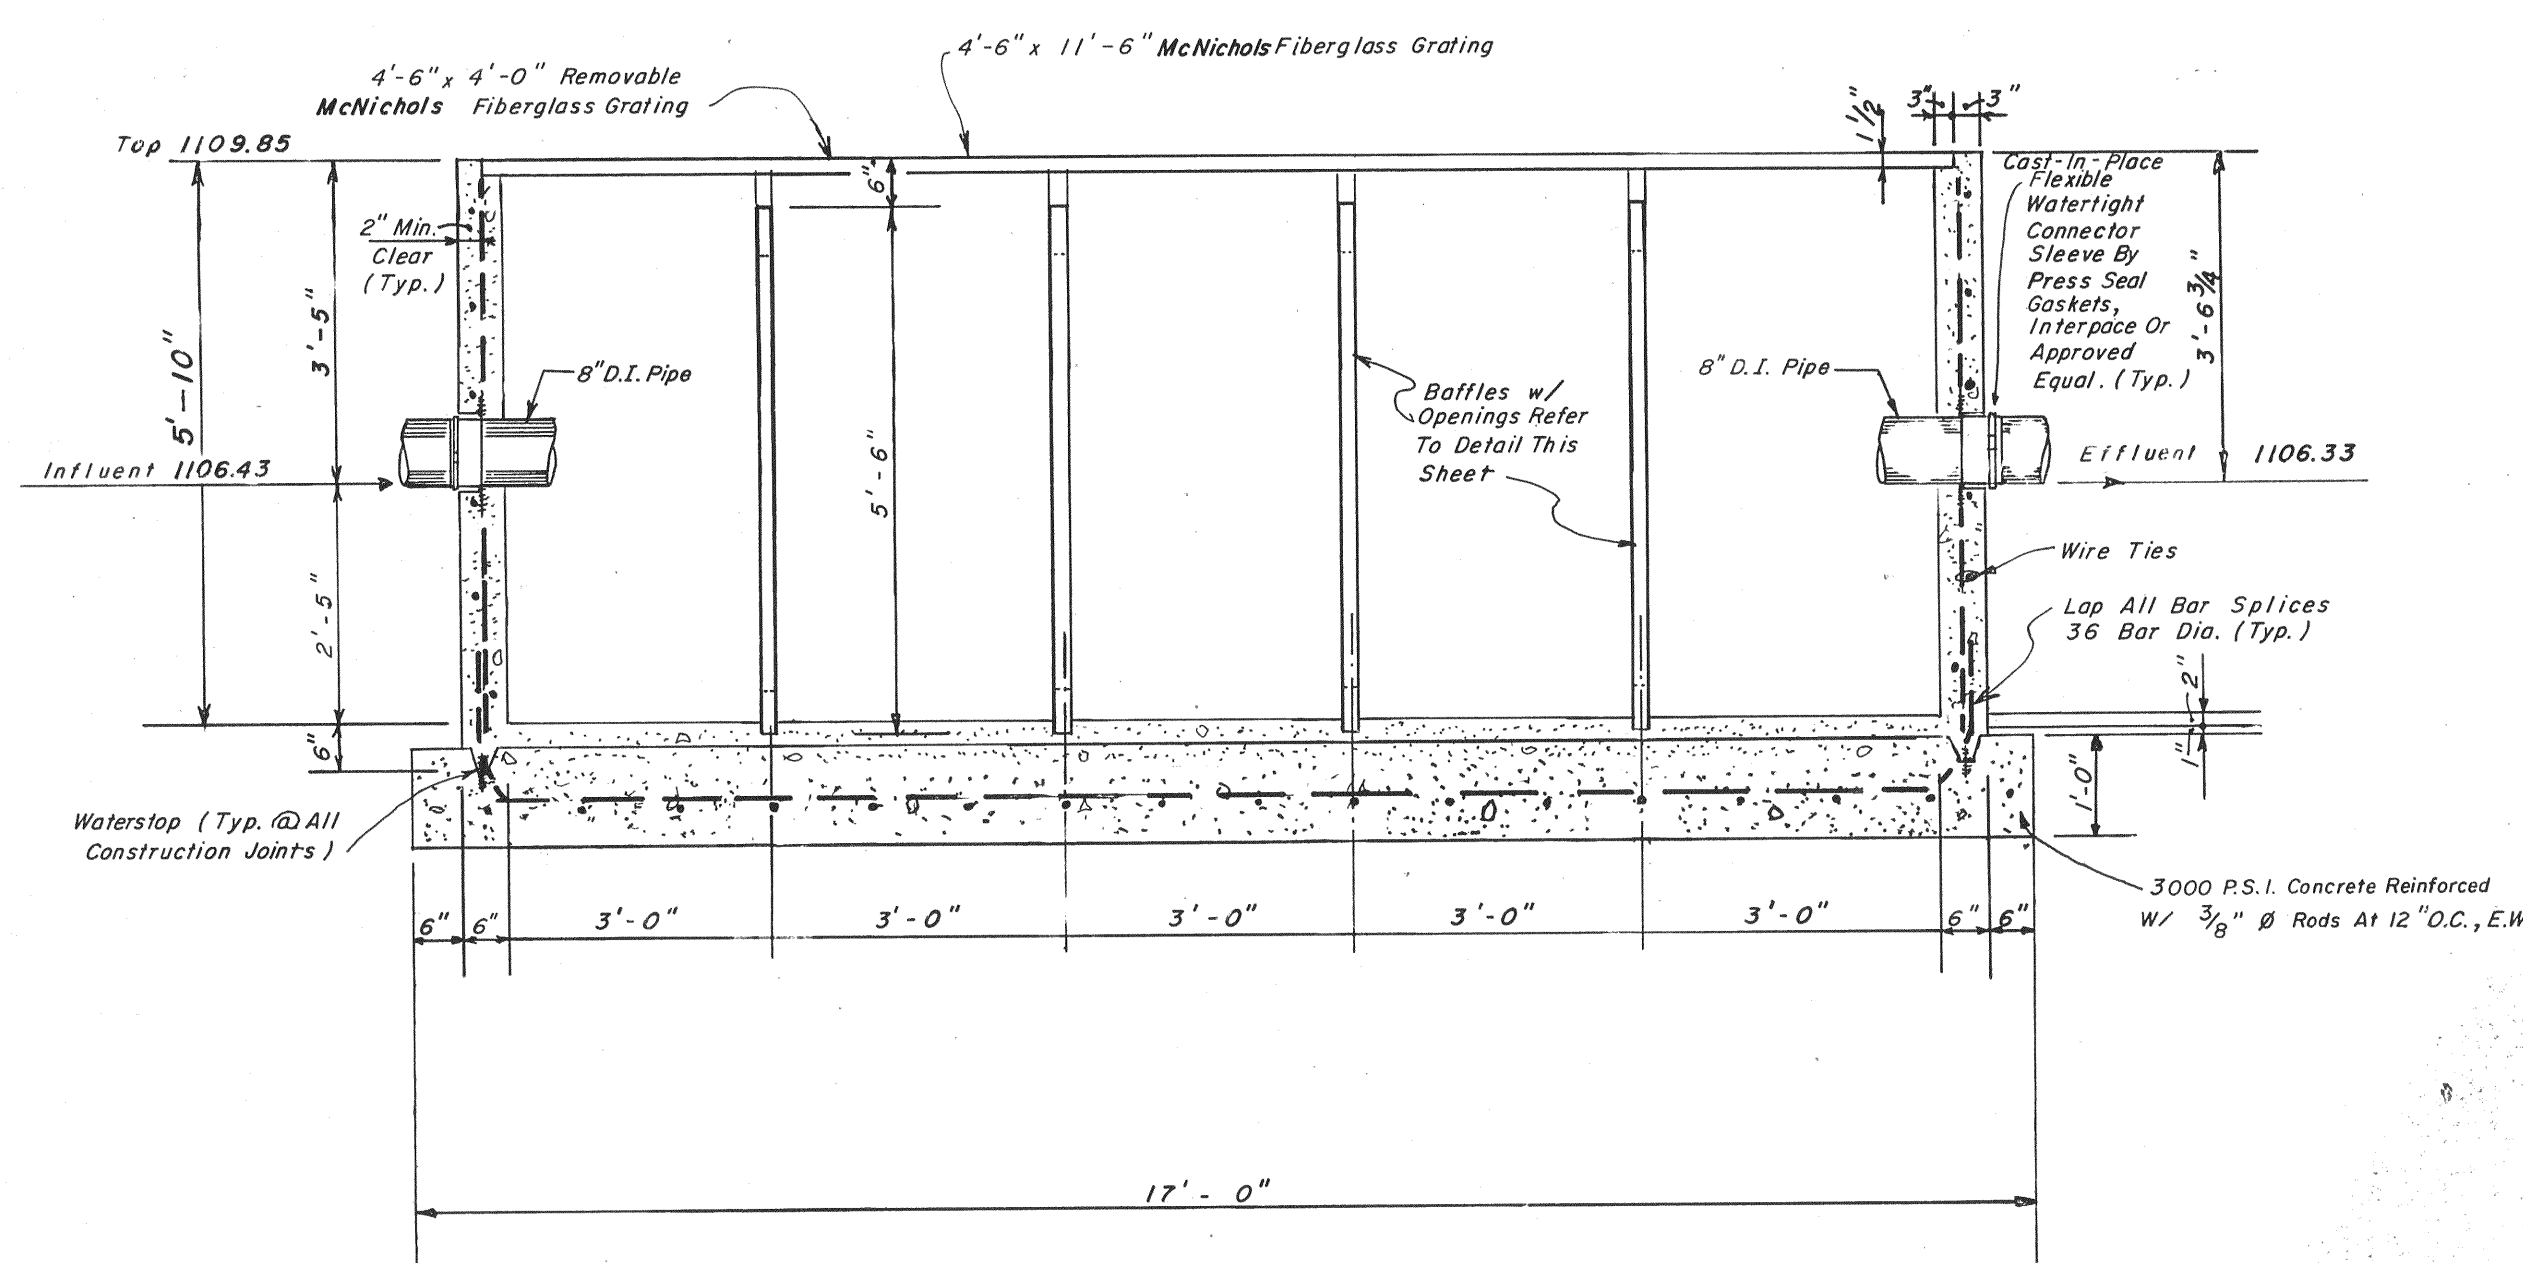


CHLORINE CONTACT TANK

SCALE: 1/2" = 1'

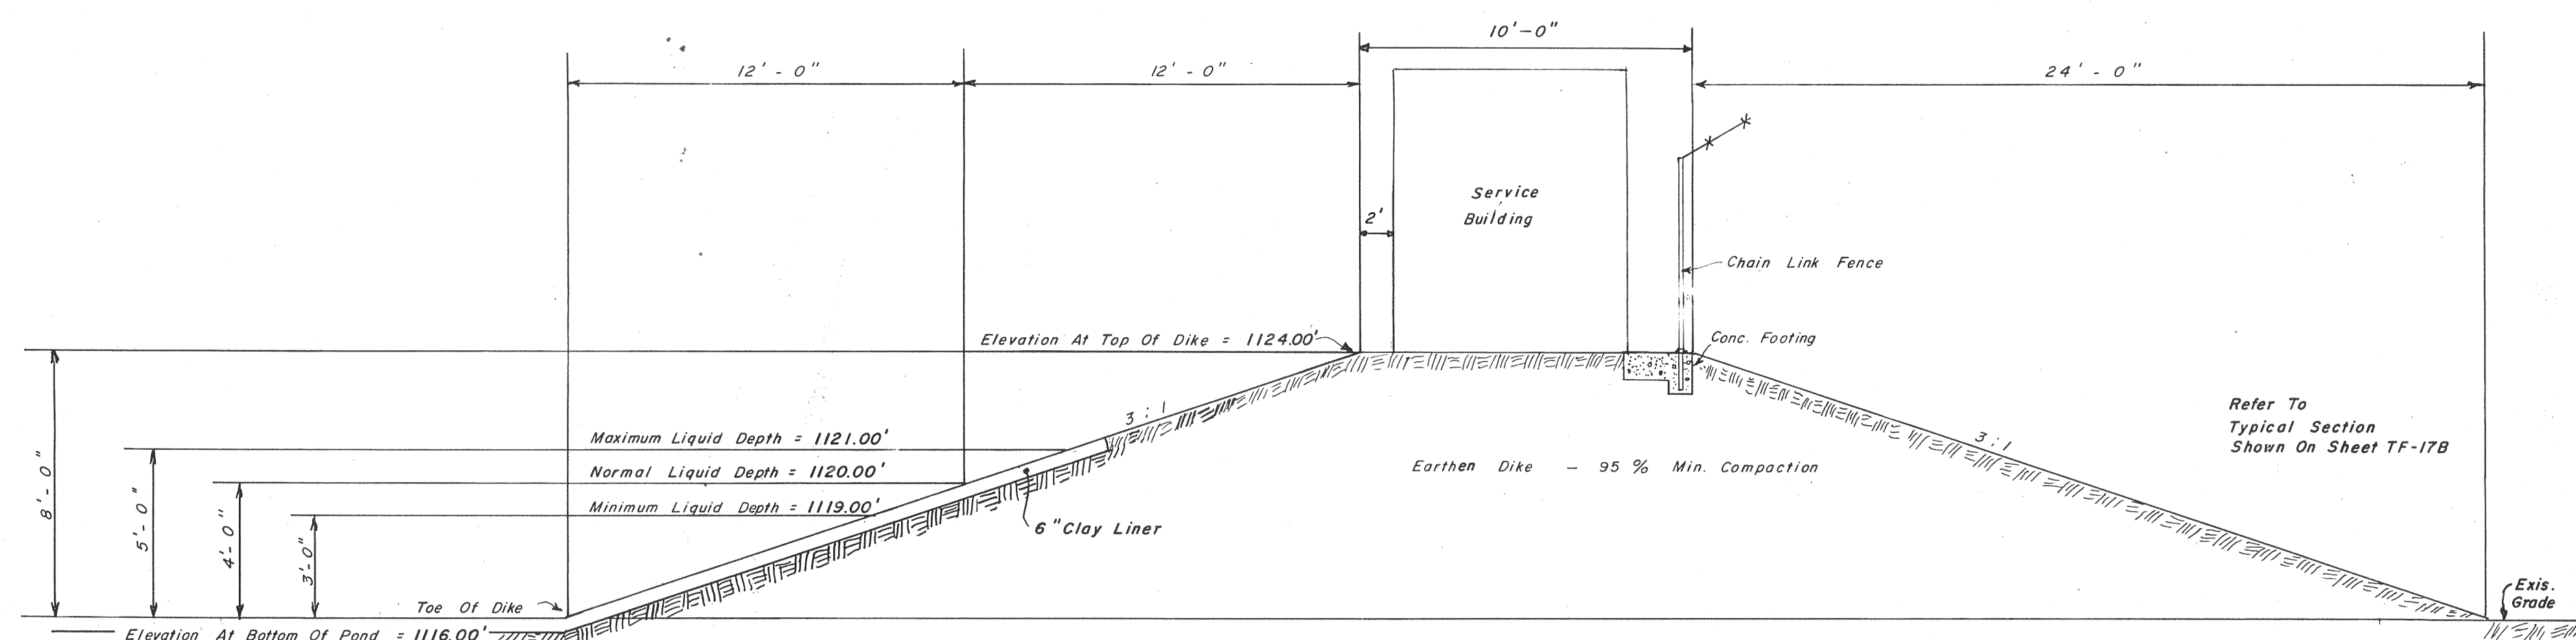


TYPICAL STABILIZATION POND - DIKE SECTION

NOT TO SCALE

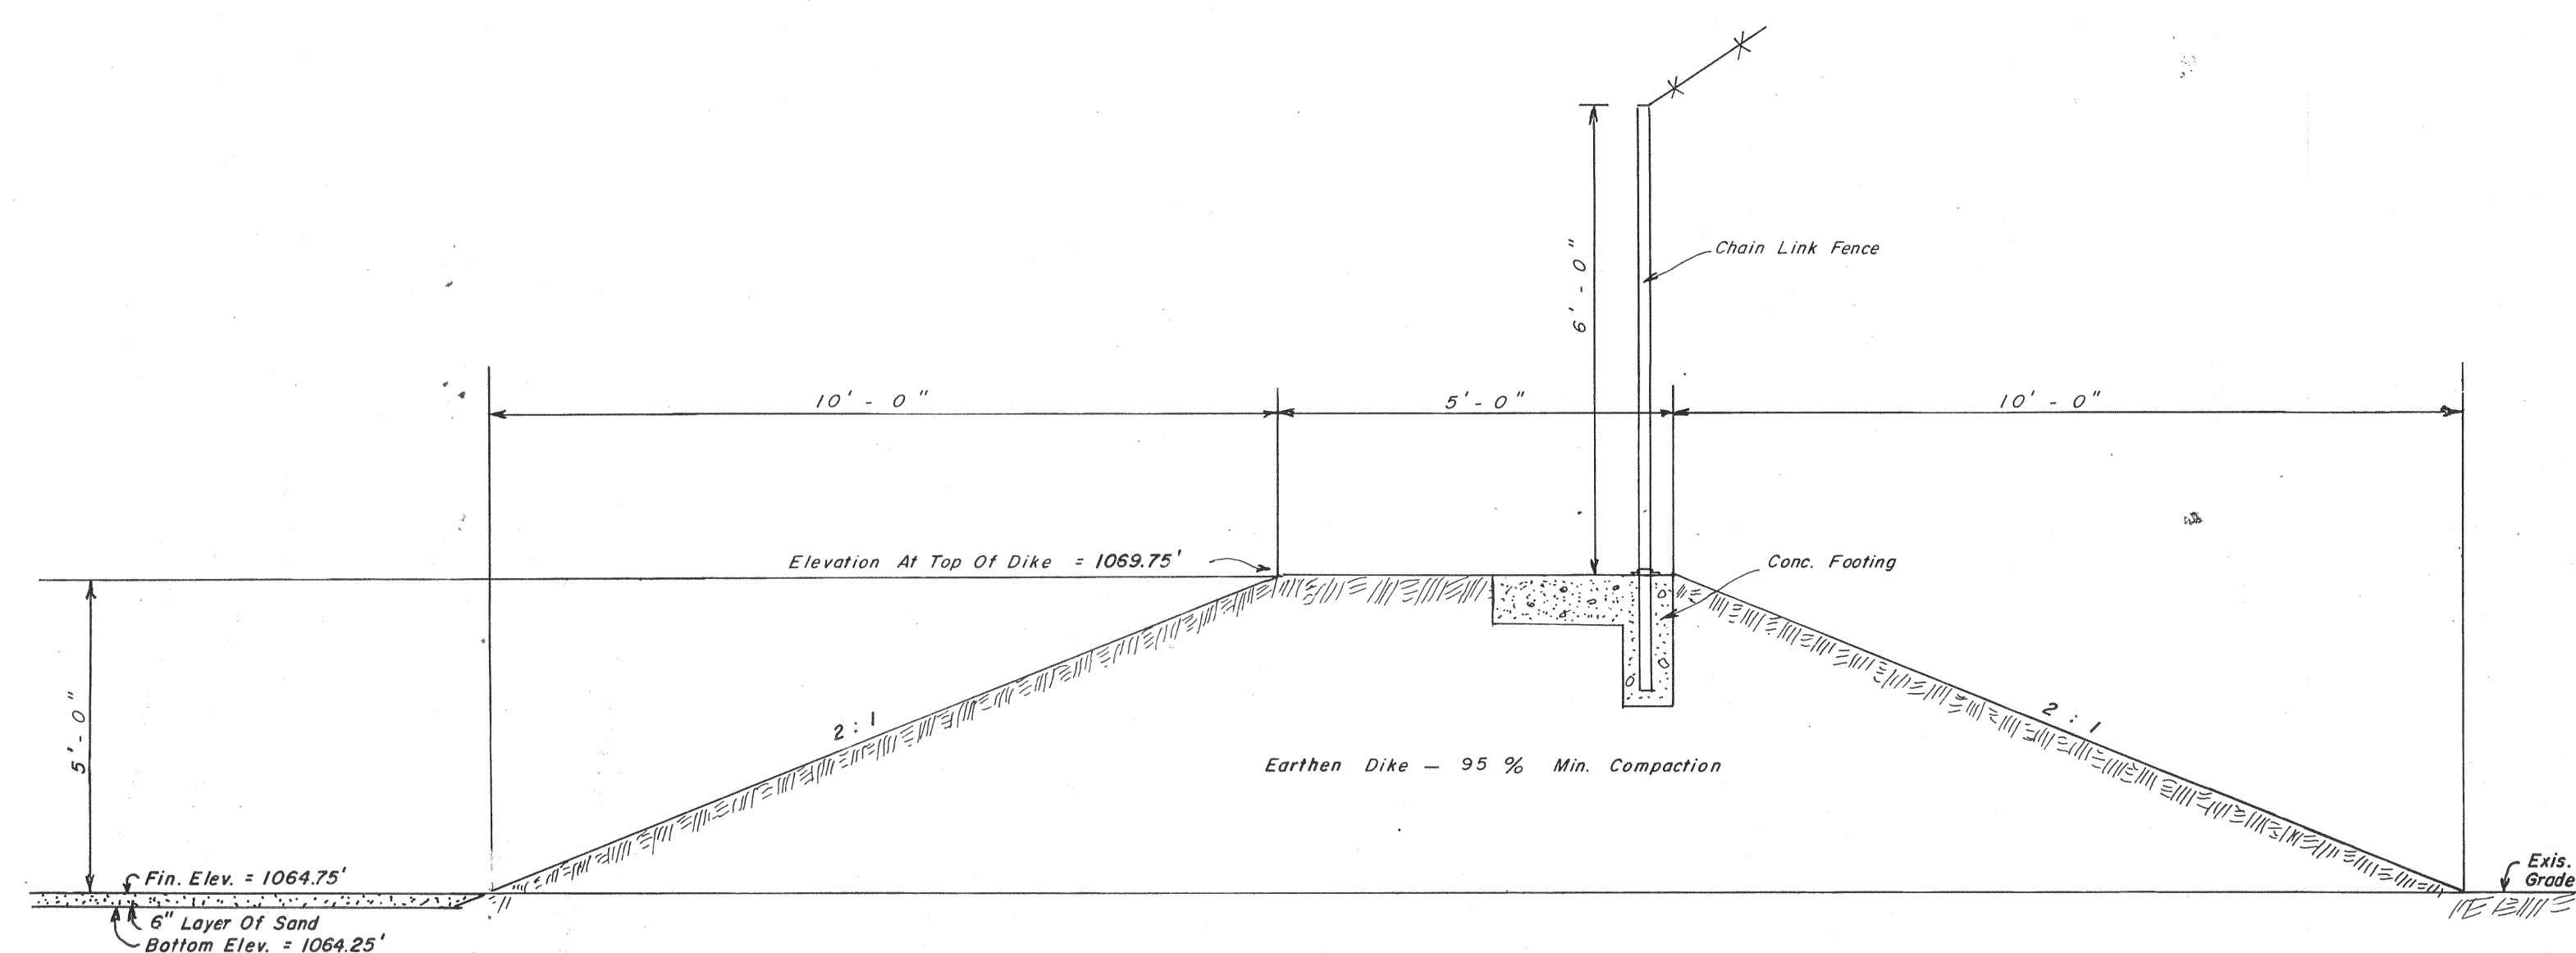

TYPICAL LEACHING FIELD - DIKE SECTION

NOT TO SCALE

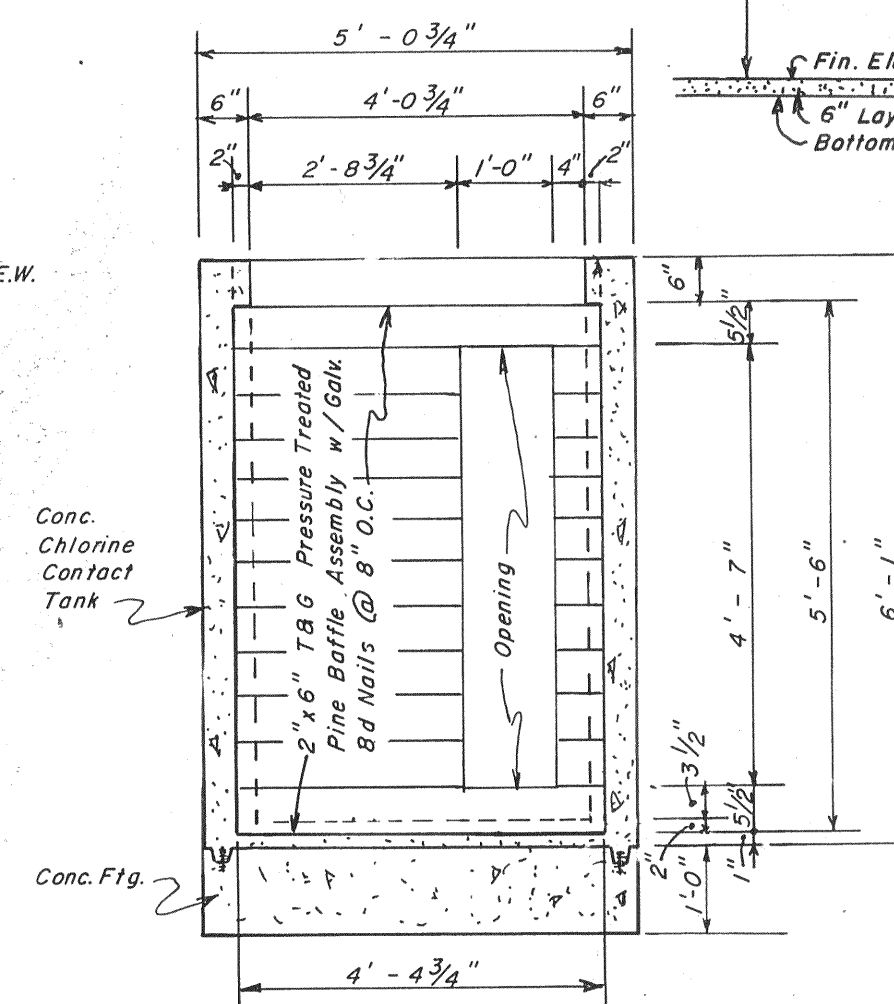

TYPICAL BAFFLE

(Not To Scale)

TOWN OF BOONES MILL

STABILIZATION POND

AUXILIARY DETAILS

J. A. GUSTIN & ASSOCIATES
CONSULTING ENGINEERS
MARTINSVILLE, VIRGINIA

DESIGNED BY

JAG & RLD

DRAWN BY

TAW & MAS

CHECKED BY

NRC, JAG

SCALE

As Noted


DATE

11-23-81

SHEET NO.

TF-21

REVISIONS
3-6-85
6-3-85
8-1-85

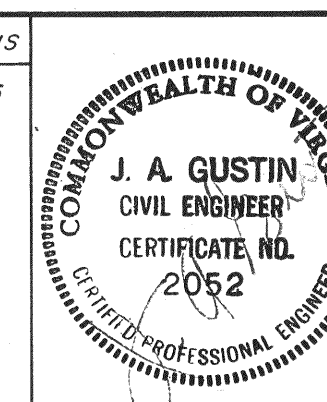

"AS BUILT PLANS"