


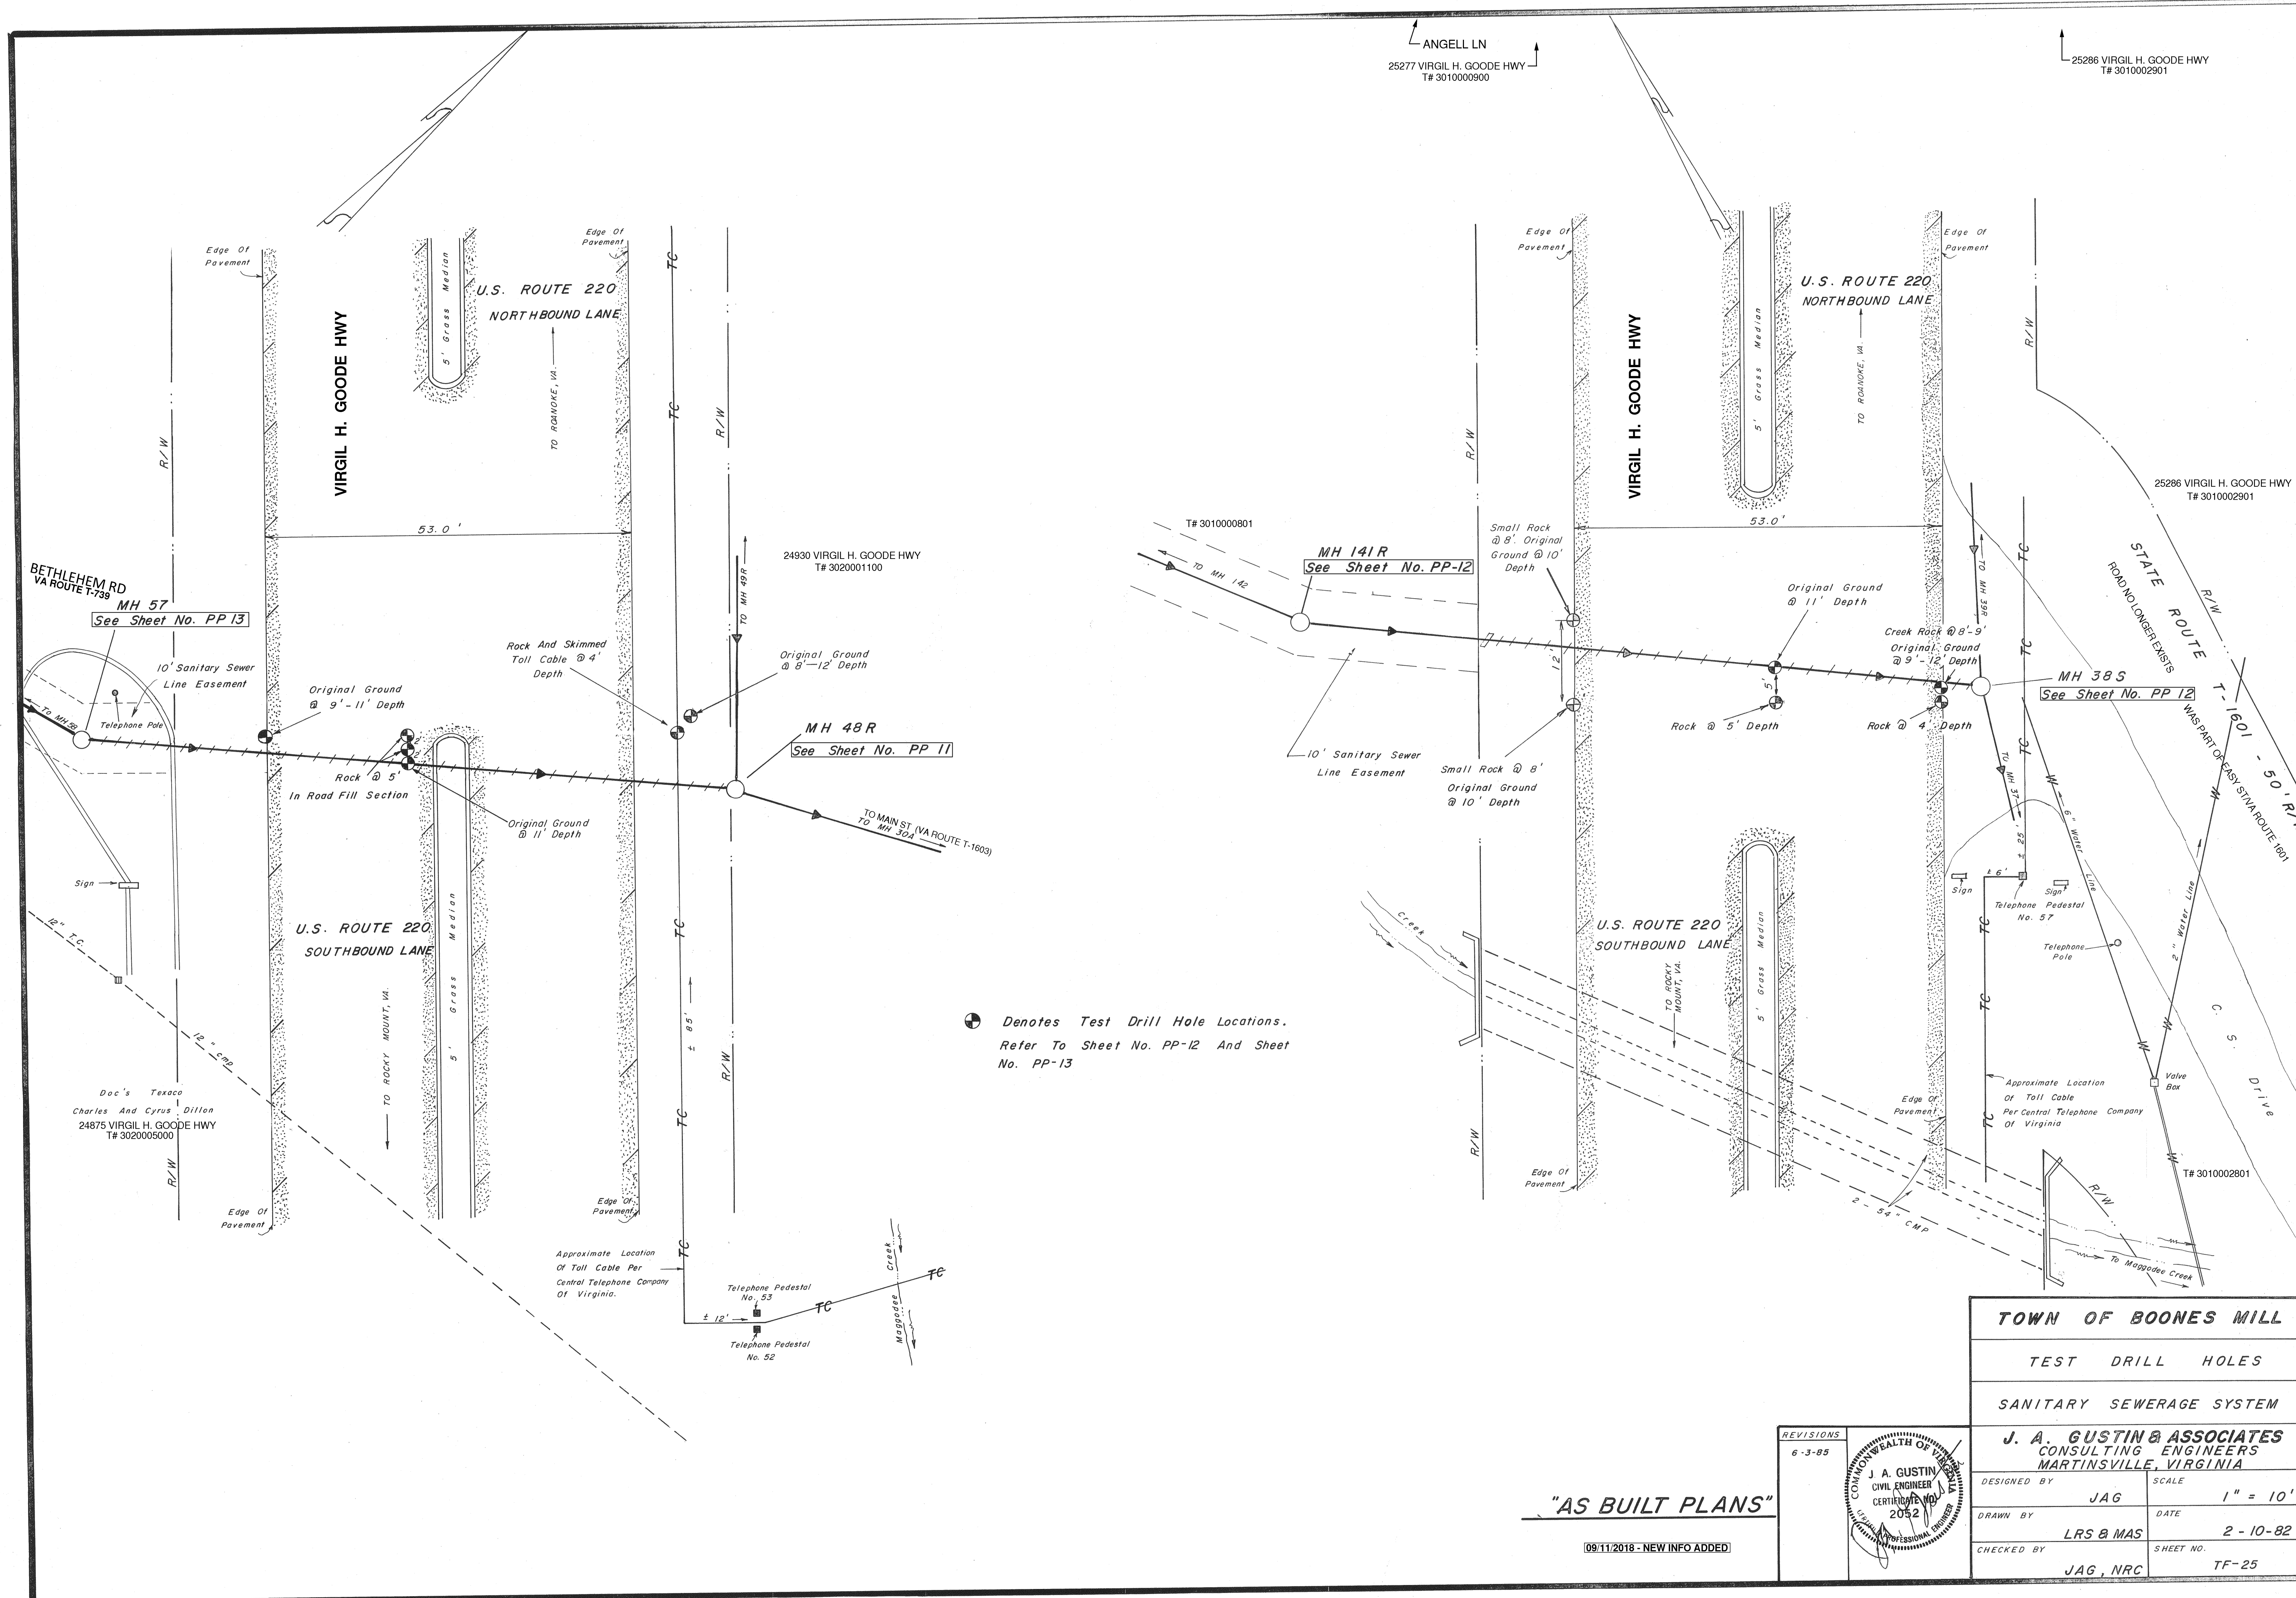

⊙ Denotes Test Drill Hole Locations.
Refer To Sheet No. PP-12 And Sheet
No. PP-13

"AS BUILT PLANS"

09/11/2018 - NEW INFO ADDED

TOWN OF BOONES MILL			
TEST DRILL HOLES			
SANITARY SEWERAGE SYSTEM			
J. A. GUSTIN & ASSOCIATES CONSULTING ENGINEERS MARTINSVILLE, VIRGINIA			
DESIGNED BY	JAG	SCALE	1" = 10'
DRAWN BY	LRS & MAS	DATE	2-10-82
CHECKED BY	JAG, NRC	SHEET NO.	TF-25

REVISIONS
6-3-85