

PLAN	DATE	BY	DATE
SURVEYED			
PLOTTED			
NOTE BOOK			
NO.			

PROFILE	DATE	BY	DATE
SURVEYED			
PLOTTED			
NOTE BOOK			
NO.			

BENCH MARK

Nail In APCo Pole No. 446-583
Elevation = 1071.37
(Not Shown, Refer To Sht. PP-3)

Mrs. W.B. Poff
Tommy Poff
W.B. Poff, Jr.

1# 0260009401

END ALTERNATE BID - LINE 1R
Sta. 42+34.16 - Match To Sht. PP-3

10-Foot Sanitary
Sewer Easement

STATE ROUTE 684

NORFOLK AND WESTERN RAILWAY - 100' R/W

1253 BOONES MILL RD
T# 0260017103

Sta. 868+67.7 NB W R/W
End Longitudinal Occupation Of Right-Of-Way

Sta. 863+71.7
NB W R/W

See Sheet 3A

(APPROXIMATE LOCATION)

Sta. 34+50.00
Emergency Discharge Assembly:
1 - 4" x 4" x 4" x 45° PVC Wye
2 - 4" Gate Valves and Valve Boxes
1 - Fernco Flexible Coupling (Or Approved Equal)
1 - 18" x 4" D.I. Discharge Pipe
1 - Wire Mesh Outlet Screen
Class II, Dry Rip Rap Splash Apron and
Erosion Control
1 - Thrust Block


Sta. 28+93.85 To Sta. 29+70.00
Class II, Dry Rip Rap
w/ Stabilization Fabric Beneath
Along Top Of Creek Bank

Sta. 32+85.00 To Sta. 34+70.00
Class II, Dry Rip Rap
w/ Stabilization Fabric Beneath
Along Top Of Creek Bank

NOTE:


20-Foot Sanitary Sewer Easement Abutts The Southerly Side Of
N & W Railway's Right-Of-Way And Is Located Entirely Inside
Said Right-Of-Way.

09/11/2018 - NEW INFO ADDED

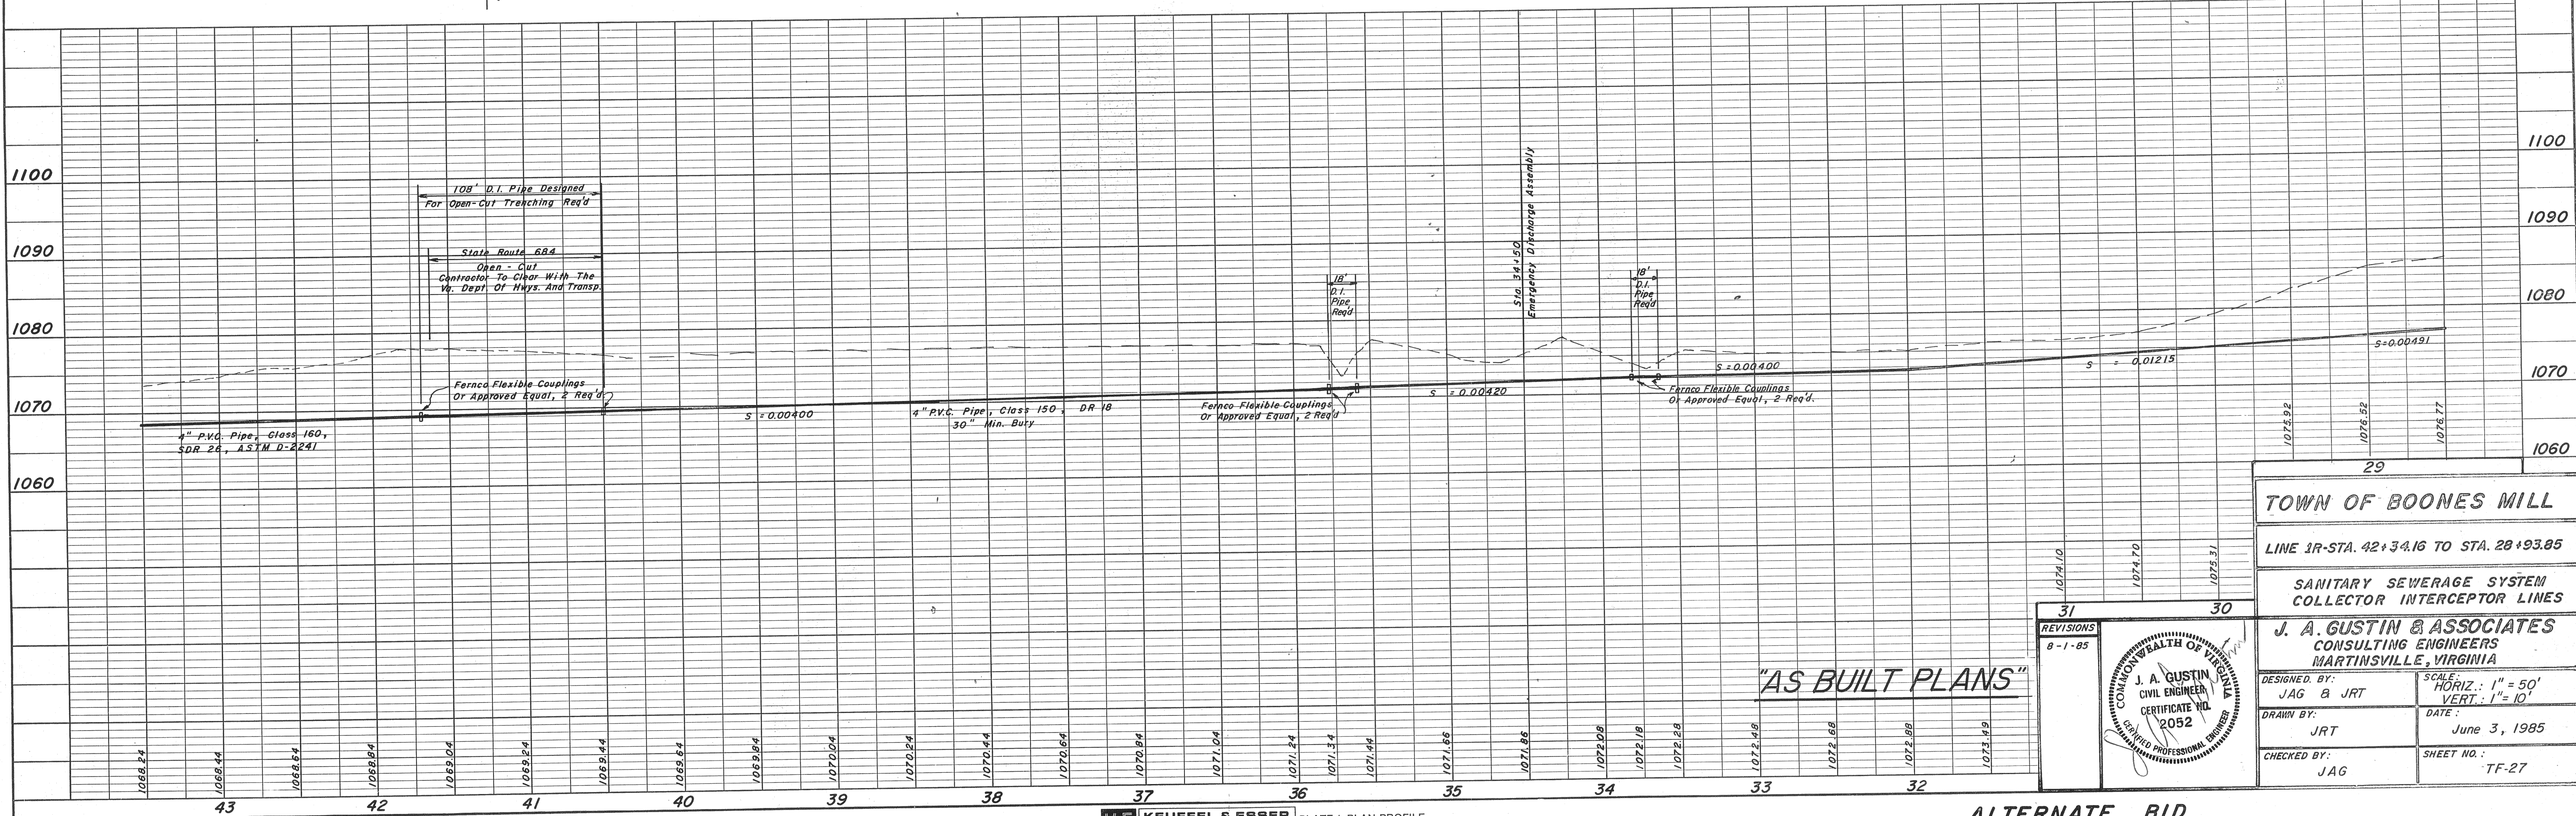

"AS BUILT PLANS"

REVISIONS	DATE	BY
8-1-85		

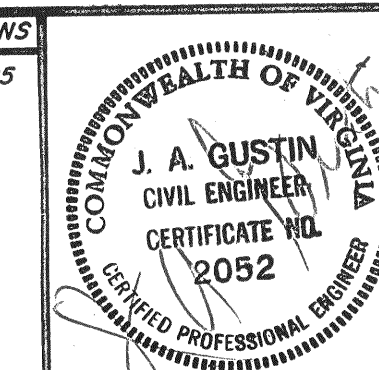

TOWN OF BOONES MILL	
LINE 1R-STA. 42+34.16 TO STA. 28+93.85	
SANITARY SEWERAGE SYSTEM COLLECTOR INTERCEPTOR LINES	
J. A. GUSTIN & ASSOCIATES CONSULTING ENGINEERS MARTINSVILLE, VIRGINIA	
DESIGNED BY: JAG & JRT	SCALE: HORIZ.: 1" = 50' VERT.: 1" = 10'
DRAWN BY: JRT	DATE: June 3, 1985
CHECKED BY: JAG	SHEET NO.: TF-27