


STATE ROUTE 122/BURNT CHIMNEY/SMITH MOUNTAIN LAKE WATER DISTRIBUTION SYSTEM PROJECT PHASE I

FOR THE
FRANKLIN COUNTY BOARD OF SUPERVISORS
(CONTRACTS I, II & III)

WITH FINANCIAL ASSISTANCE FROM
ENVIRONMENTAL PROTECTION AGENCY
STATE TRIBAL ASSISTANCE GRANT

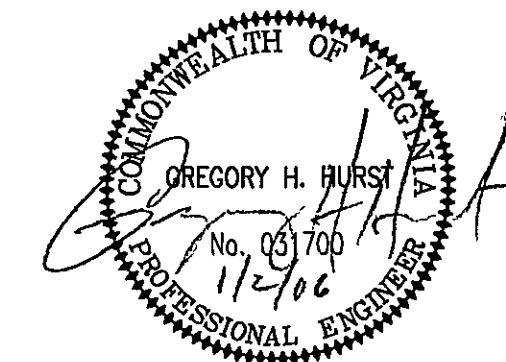

FRANKLIN COUNTY BOARD OF SUPERVISORS
40 EAST COURT STREET
ROCKY MOUNT, VIRGINIA 24151
(540) 483-3030

BONNIE N. JOHNSON - ASSISTANT COUNTY ADMINISTRATOR

PREPARED BY:
THOMPSON + LITTON
ENGINEERS - ARCHITECTS - PLANNERS
RADFORD, VIRGINIA

RECORD DRAWING NOTE

THE INFORMATION CONTAINED HEREIN REPRESENTS RECORD DRAWINGS FOR THE STATE ROUTE 122/BURNT CHIMNEY/SMITH MOUNTAIN LAKE WATER DISTRIBUTION SYSTEM PROJECT PHASE I - CONTRACTS I, II AND III AS CONSTRUCTED BY THE CONTRACTOR: BURLEIGH CONSTRUCTION (CONTRACT I), E C PACE COMPANY, INC. (CONTRACT II) AND RACO, INC. (CONTRACT III). THESE DRAWINGS SHOULD NOT BE INTERPRETED AS A VERIFICATION OF THE DESIGN OR ADEQUACY OF THE CONSTRUCTED IMPROVEMENTS. THESE DRAWINGS ARE BASED UPON DATA PROVIDED BY THE CONTRACTOR.

PROJECT NO. 7363-03

JULY, 2003

RECORD DOCUMENTS ISSUED
DECEMBER 02, 2005