


"AS-BUILT"

LAKESTONE CONDOMINIUMS

UNION HALL DIST. - FRANKLIN COUNTY
VIRGINIA

NOTES:

1. NO CHANGE IN THE SURVEY LINES ARE IN EXCESS OF 48" DRAWING ARE SHOWN.
2. NO CHANGE IN THE PREVIOUS CONDOMINIUM LINES OR THE DRAINAGE DRAINAGE ARE SHOWN.
3. PUMP STATION NO. 2 IS IN EXCESS OF 30' FROM SHORE LINE.

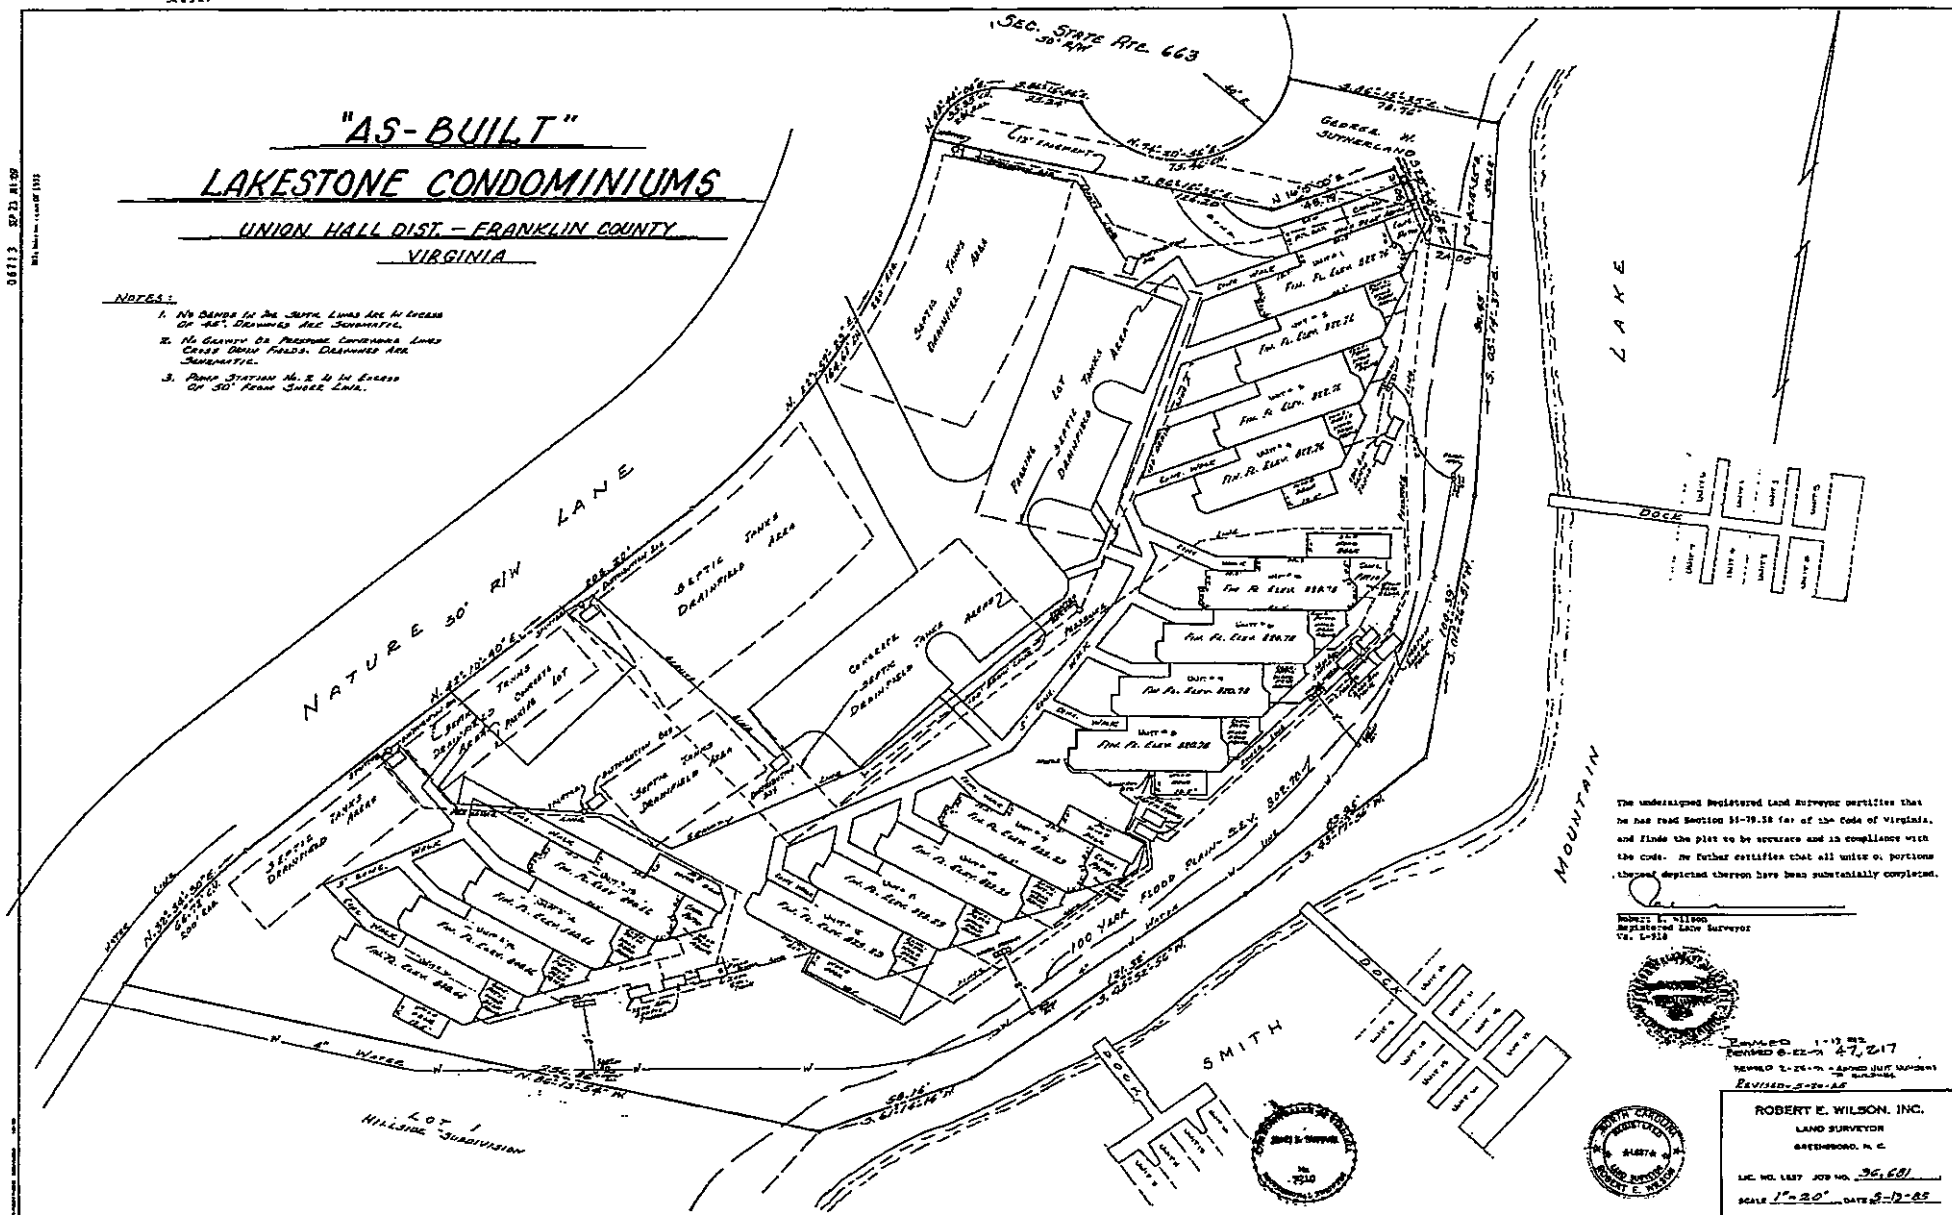

The undersigned Registered Land Surveyor certifies that he has read Section 51-79.58 of the Code of Virginia, and finds the plot to be accurate and in compliance with the code. He further certifies that all units or portions thereof depicted thereon have been substantially completed.

ROBERT E. WILSON
Registered Land Surveyor
Va. L-218



REVISION 1-12-85
REVISION 8-22-85
REVISION 2-25-86 - ADDED UNIT NUMBER
REVISION 5-20-86

ROBERT E. WILSON, INC.
LAND SURVEYOR
GREENSBORO, N. C.

LIC. NO. 1837 JOB NO. 35,681
SCALE 1"=20' DATE 8-12-85