


"AS BUILT"
LAKESTONE CONDOMINIUMS
 UNION HALL DIST. - FRANKLIN COUNTY
 VIRGINIA



The undersigned Registered Land Surveyor certifies that he has used Sections 50-75.00 and all the laws of Virginia, and State and local laws to the maximum and to the satisfaction of the public. He further certifies that all other laws and regulations of the State of Virginia have been strictly complied with.

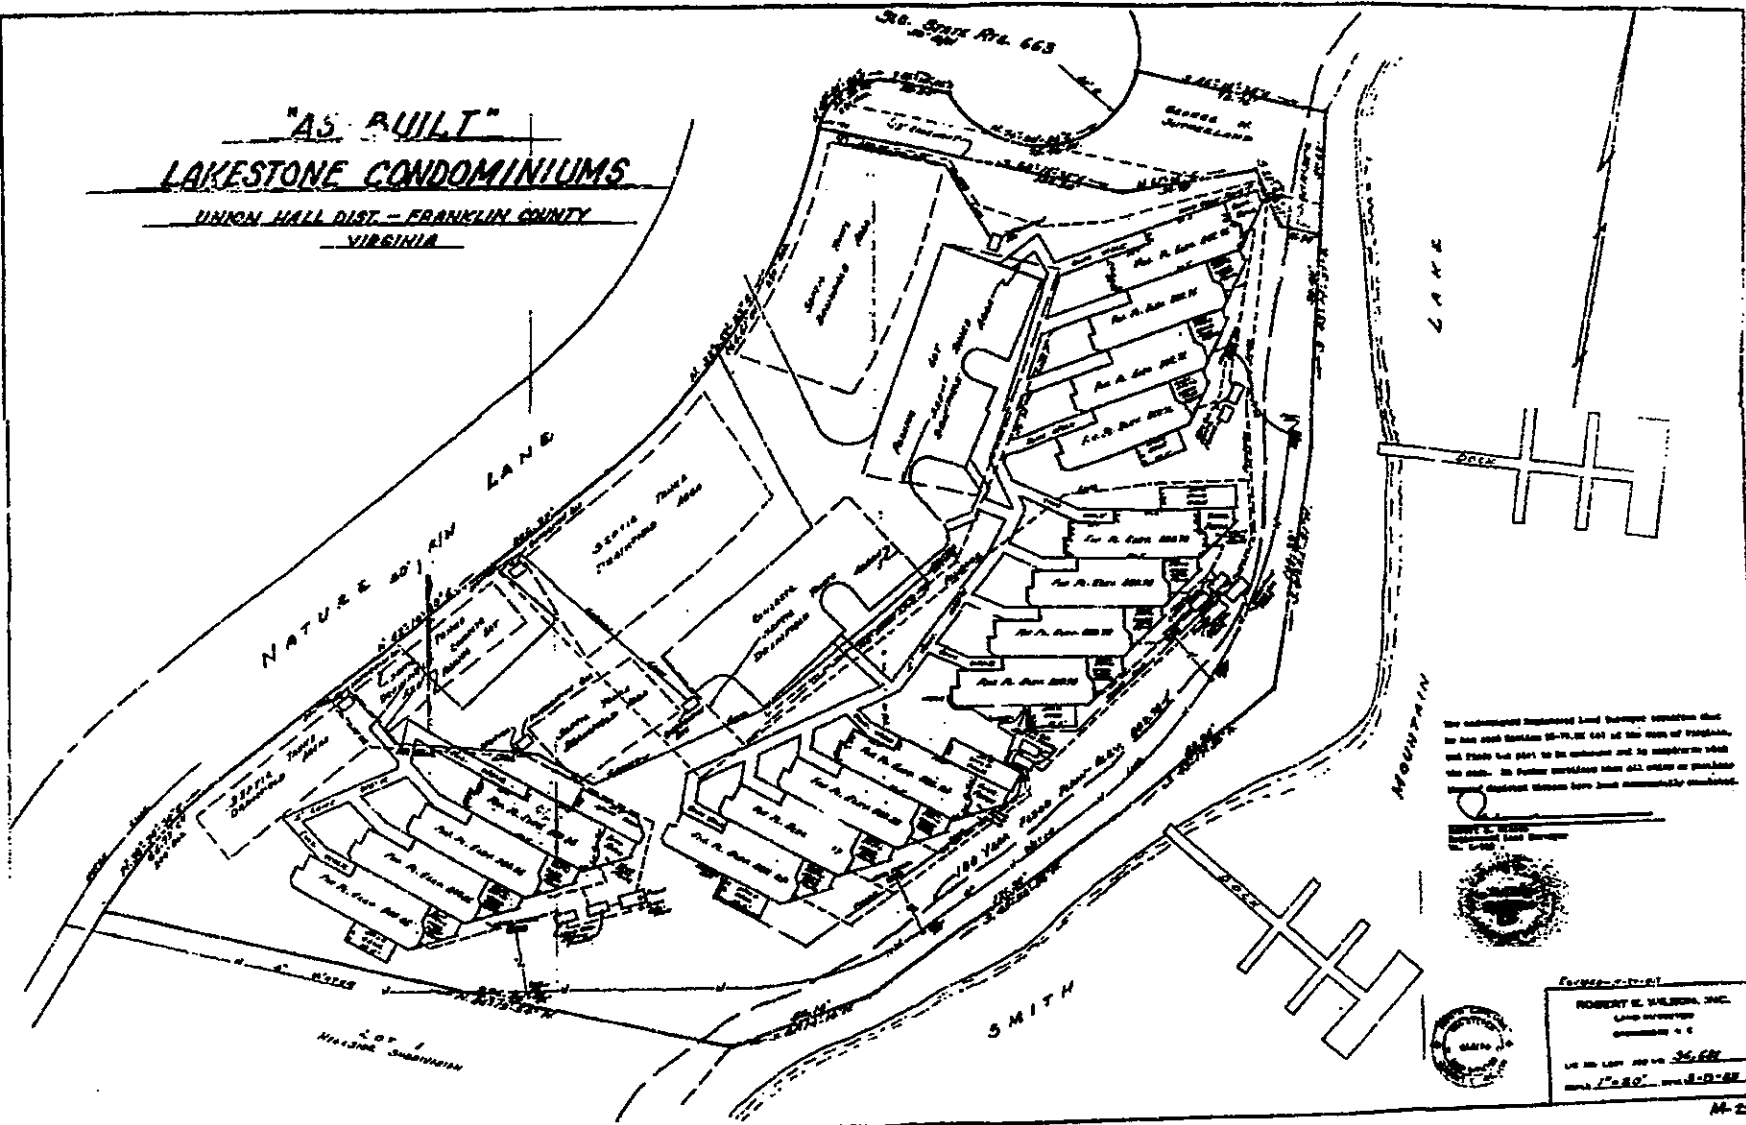

ROBERT E. SULLIVAN, INC.
 LAND SURVEYORS
 CHARTERED 1918
 100 N. LEE ST. SUITE 200
 FARMERSVILLE, VA 22434
 TEL. 703-801-1111 FAX 703-801-1112

44-2530

EXHIBIT A