
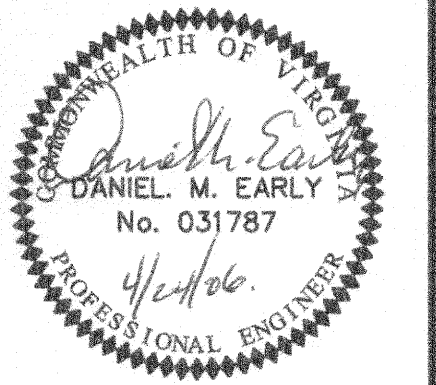


LAKEWATCH PLANTATION WATER DISTRIBUTION SYSTEM FRANKLIN COUNTY, VIRGINIA RECORD DRAWING

SHEET INDEX

- | | |
|-------|---------------------------------|
| C1.0 | TITLE SHEET |
| C1.1 | PROJECT SCHEMATIC/ SHEET INDEX |
| C1.2 | WATER LINE W-100 PLAN & PROFILE |
| C1.3 | WATER LINE W-100 PLAN & PROFILE |
| C1.4 | WATER LINE W-200 PLAN & PROFILE |
| C1.5 | WATER LINE W-200 PLAN & PROFILE |
| C1.6 | WATER LINE W-300 PLAN & PROFILE |
| C1.7 | WATER LINE W-300 PLAN & PROFILE |
| C1.8 | WATER LINE W-300 PLAN & PROFILE |
| C1.9 | WATER LINE W-300 PLAN & PROFILE |
| C1.10 | WATER LINE W-400 PLAN & PROFILE |
| C1.11 | WATER LINE W-400 PLAN & PROFILE |

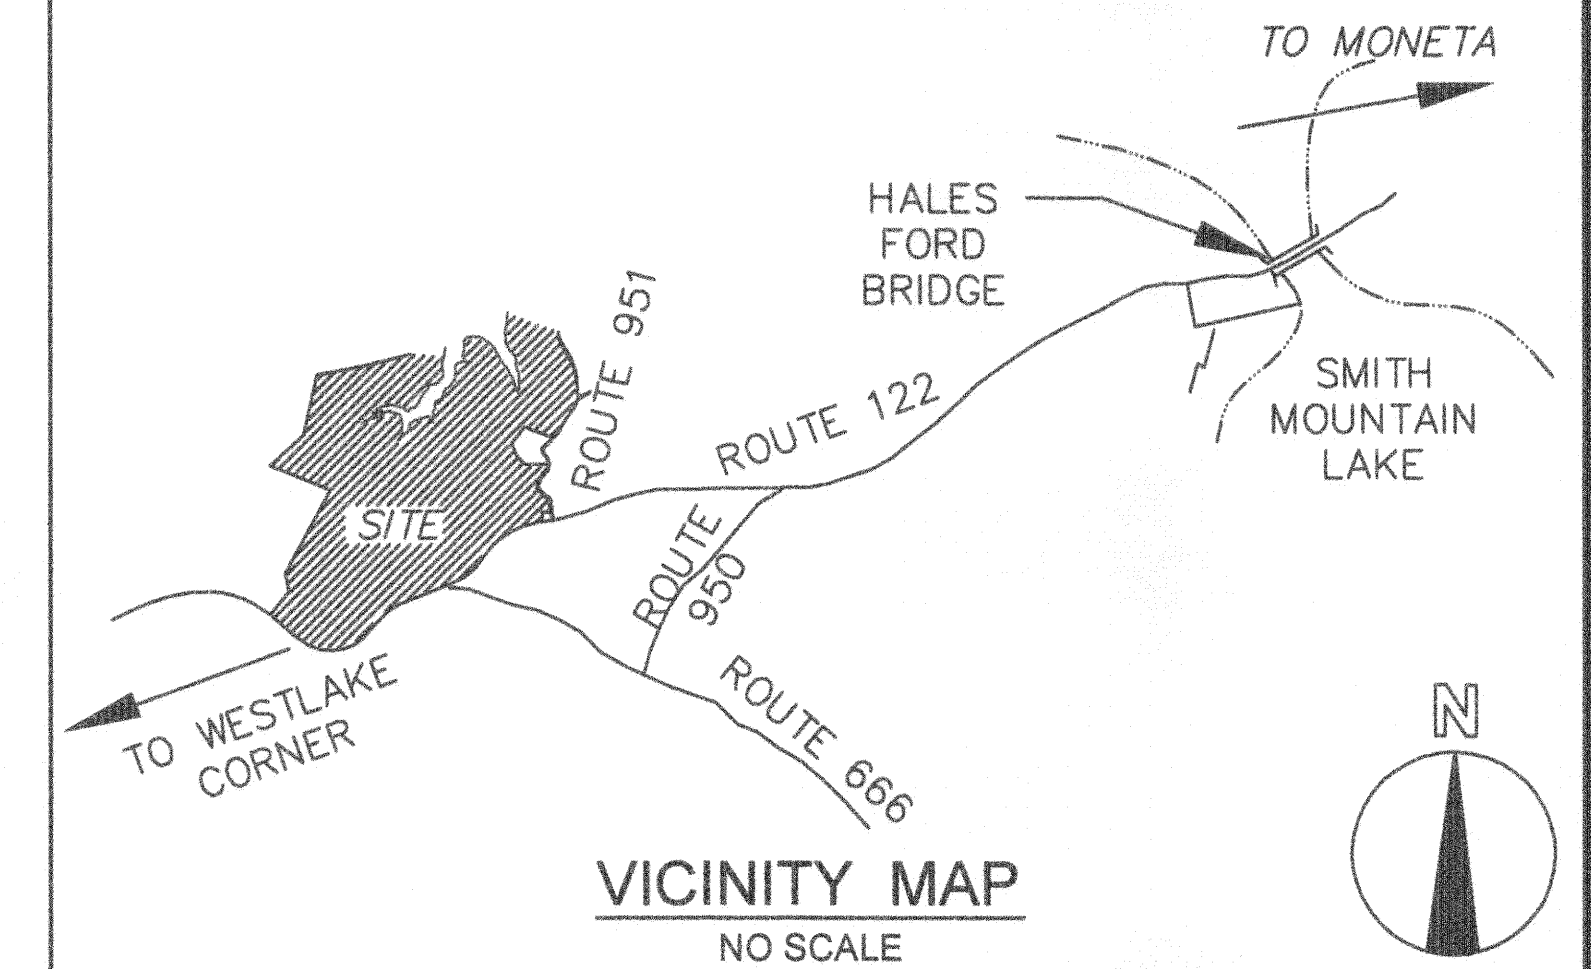

ENGINEER'S SEAL

"The Record Drawings indicated herein were developed from documentation provided by and conversations with the General Contractor after construction was completed. The drawings were prepared for general reference only for use in future planning, maintenance, and extension as may be required. Dimensions and locations of water system installation shall not be considered exact, but rather approximate."

ABBREVIATIONS		EXISTING		NEW		DESCRIPTION
ABAN	ABANDON, ABANDONED	MECH	MECHANICAL MANUFACTURER			
ABUT	ABUTMENT	MFR	MANHOLE			BUILDING WITH PORCH OR STOOP
ADJ	ADJACENT	MH	MINIMUM			FOUNDATION ONLY
AGGR	AGGREGATE	MN	MECHANICAL JOINT			
ALUM	ALUMINUM	MJ	MONUMENT			CONTOUR, CONTOUR WITH ELEVATION
ANC	ANCHOR	MON	METAL			SPOT ELEVATION
APPROX	APPROXIMATE	N	NAIL AND CAP			CONCRETE CURB
BDRM	BEDROOM	N & C	NOT IN CONTRACT			CONCRETE CURB & GUTTER
BIT	BITUMINOUS	NIC	NUMBER			CONCRETE WALK OR SLAB
BL	BELL JOINT	NO	NOT TO SCALE			PAVEMENT
BEG	BEGIN, BEGINNING	NPW	NON POTABLE WATER			UNPAVED OR GRAVEL ROAD
BLDG	BUILDING	NTS	NOT TO SCALE			
BM	BENCH MARK	OS	ON CENTER			
BSP	BLACK STEEL PIPE	OD	OUTSIDE DIAMETER			
BV	BUTTERFLY VALVE	OHE	OVERHEAD ELECTRIC			
EVCE	BEGIN VERTICAL CURVE ELEVATION	OPEN	OPENING			
EVCS	BEGIN VERTICAL CURVE STATION	OSB	ORIENTED STRAND BOARD			
C & G	CURB & GUTTER	PMIT	PAVEMENT			
CI	CAST IRON	PC	POINT OF CURVE			
CL	CENTER LINE	PCC	POINT OF COMPOUND CURVE			
CLG	CENTER LINE	PER	PERIMETER			
CLO	CLOSE	PERP	PERFORATED			
CONST	CONSTRUCTION	PERP	PERPENDICULAR			
CMP	CORRUGATED METAL PIPE	PRE-HUNG	PRE-HUNG			
CMU	CONCRETE MASONRY UNITS	PI	POINT OF INTERSECTION			
CND	CONDUIT	PL	PLATE, PROPERTY LINE			
CO	CLEANOUT	PLST	PLYWOOD			
COL	COLUMN	PLWD	PLYWOOD			
COMB	COMBINATION	POL	POINT ON LINE			
CONC	CONCRETE (PORTLAND CEMENT)	POT	POINT OF TANGENCY			
CONV	CONNECT, CONNECTION	POT	POINT ON TANGENT			
CONTR	CONTRACTOR	PR	POWER POLE			
CONV	CONVEYOR	PRC	POINT OF REVERSE CURVE			
COR	CORNER	PSI	POUNDS PER SQUARE INCH			
CPT	CARPET	PT	POINT OF TANGENT			
CR STONE	CRUSHED STONE	PVC	POLYVINYL CHLORIDE			
CULV	CULVERT	PIV	POINT OF VERTICAL INTERSECTION			
CULV	CULVERT	PUE	PUBLIC UTILITY EASEMENT			
DE	DEPTH OR DEGREE OF CURVE, DRYER	R	RADIUS, RISER			
DI	DROP INLET, DUCTILE IRON	RR	RAILROAD			
DM	DIMENSION	RCP	REINFORCED CONCRETE PIPE			
DISC	DISCONNECT	RD	ROAD			
DN	DOWN	RDR	REDUCER			
DN	DOWN	REIN	REINFORCE, REINFORCEMENT			
DN	DOWN	REF	REFERENCE, REFRIGERATION			
DN	DOWN	REL	RELOCATED			
DTL	DETAIL	REQD	REQUIRED			
DW, D/W	DRIVEWAY, DISHWASHER	REV	REQUIRED			
DW	DRIVEWAY	RM	ROOM			
DHL	DWELLING	RTE	ROUTE			
DNG	DRAINING	R	RIGHT			
E	EACH	RUB	RUBBER			
E.B.L.	EASTBOUND LANE	R/W	RIGHT OF WAY			
EL. ELEV	ELEVATION	SS	SANITARY SEWER			
ELEC	ELECTRICAL	SAN	SANITARY			
ENGR	ENGINEER	SBL	SIDEWALK			
ENTR	ENTRANCE	SD	STORM DRAIN			
EOL	END OF LINE	SE	SLOPE EASEMENT			
EP	EDGE OF PAVEMENT	SEC	SECTION			
EQ	EQUAL	SER	SERVICE			
EQPT	EQUIPMENT	SH	SHEET			
EVCE	END VERTICAL CURVE ELEVATION	SIM	SIMILAR			
EVCS	END VERTICAL CURVE STATION	SPEC	SPECIFICATION			
EW	EACH WAY, ENDWALL	SPECS	SPECIFICATIONS			
EXIST, EXIST	EXISTING	SQ	SQUARE			
EXT	EXTERIOR	SSTL	STAINLESS STEEL			
EXT	EXTENDED END SECTION	STR	STREET			
FF	FINISH FLOOR	STA	STATION			
FF	FINISHED FLOOR ELEVATION	STD	STANDARD			
FIG	FIGURE	STL	STEEL			
FIN	FINISH	STRUCT	STRUCTURAL			
FL	FLOOR	SUR	SURVEY			
FLEX	FLEXIBLE	SUR	SURVEY			
FLO	FLANGE	TOP & B	TOP AND BOTTOM			
FT	FOOT	TELE	TELEPHONE			
FTG	FOOTING	TEMP	TEMPORARY			
FUT	FUTURE	THK	THICK			
GA	GAUGE	TRD	TELEPHONE POLE			
GAL	GALLON	TRD	TREATED			
GALV	GALVANIZED	TV	TELEVISION			
GAR	GARAGE	TW	TOP OF WALL			
GND	GROUND	TV	TELEVISION			
GR	GRAVEL	TV	TELEVISION			
GOVT	GOVERNMENT	UE	UNDERGROUND			
GRW	GALLONS PER MINUTE	UG	UNDERGROUND			
GRG	GRATING	UL	UNDERWRITER LABORATORY			
GV	GATE VALVE	UNL	UNLESS OTHERWISE NOTED			
GWB	GYPSSUM BOARD	USCN	UNITED STATES COAST AND			
H&T	HUB AND TAC	USC&GS	GEODETIC SURVEY			
H&T	HANDICAPPED	V	VALVE, VENT			
H&T	HOLLOW METAL	V	VALVE, VENT			
HORIZ	HORIZONTAL	VAR	VARIABLE			
HPT	HIGH POINT	VERT	VERTICAL CURVE			
HPT	HOUR	VERT	VERTICAL			
HYD	HYDRANT	VESCR	VERMONT EROSION AND SEDIMENT			
ID	INSIDE DIAMETER	VESCR	CONTROL REGULATIONS			
INCH	INCH	VNL	VOLUME			
INSUL, INS.	INSULATION	VDL	VOLUME			
INT	INTERIOR	VDOT	VIRGINIA DEPARTMENT OF TRANSPORTATION			
INV	INVERT	V.S.D.	VERTICAL SIGHT DISTANCE			
IT	IRON PIN (FOUND OR SET NOTED)	W.B.L.	WESTBOUND LANE			
LF	LENGTH, LONG	W	WIDE FLANGE, WIDE, WASTE, WATER, WASHER			
LG	LEGAL FOOT	W	WITH			
LC	LONG	WH	WATER HEATER			
LP	LIGHT POLE	W	WATER LINE			
LR	LONG RADIUS, LIVING ROOM	W/O	WITHOUT			
LT	LEFT	WS	WATER SURFACE			
MAS	MASONRY	WS	WATERRIGHT, HEIGHT			
MATL	MATERIAL	WVHD	WEST VIRGINIA DEPARTMENT			
MAX	MAXIMUM	WVHD	OF HIGHWAYS			
MB	MAIL BOX	AD	ALGEBRAIC DIFFERENCE			
MB	MINIMUM BUILDING LINE					