


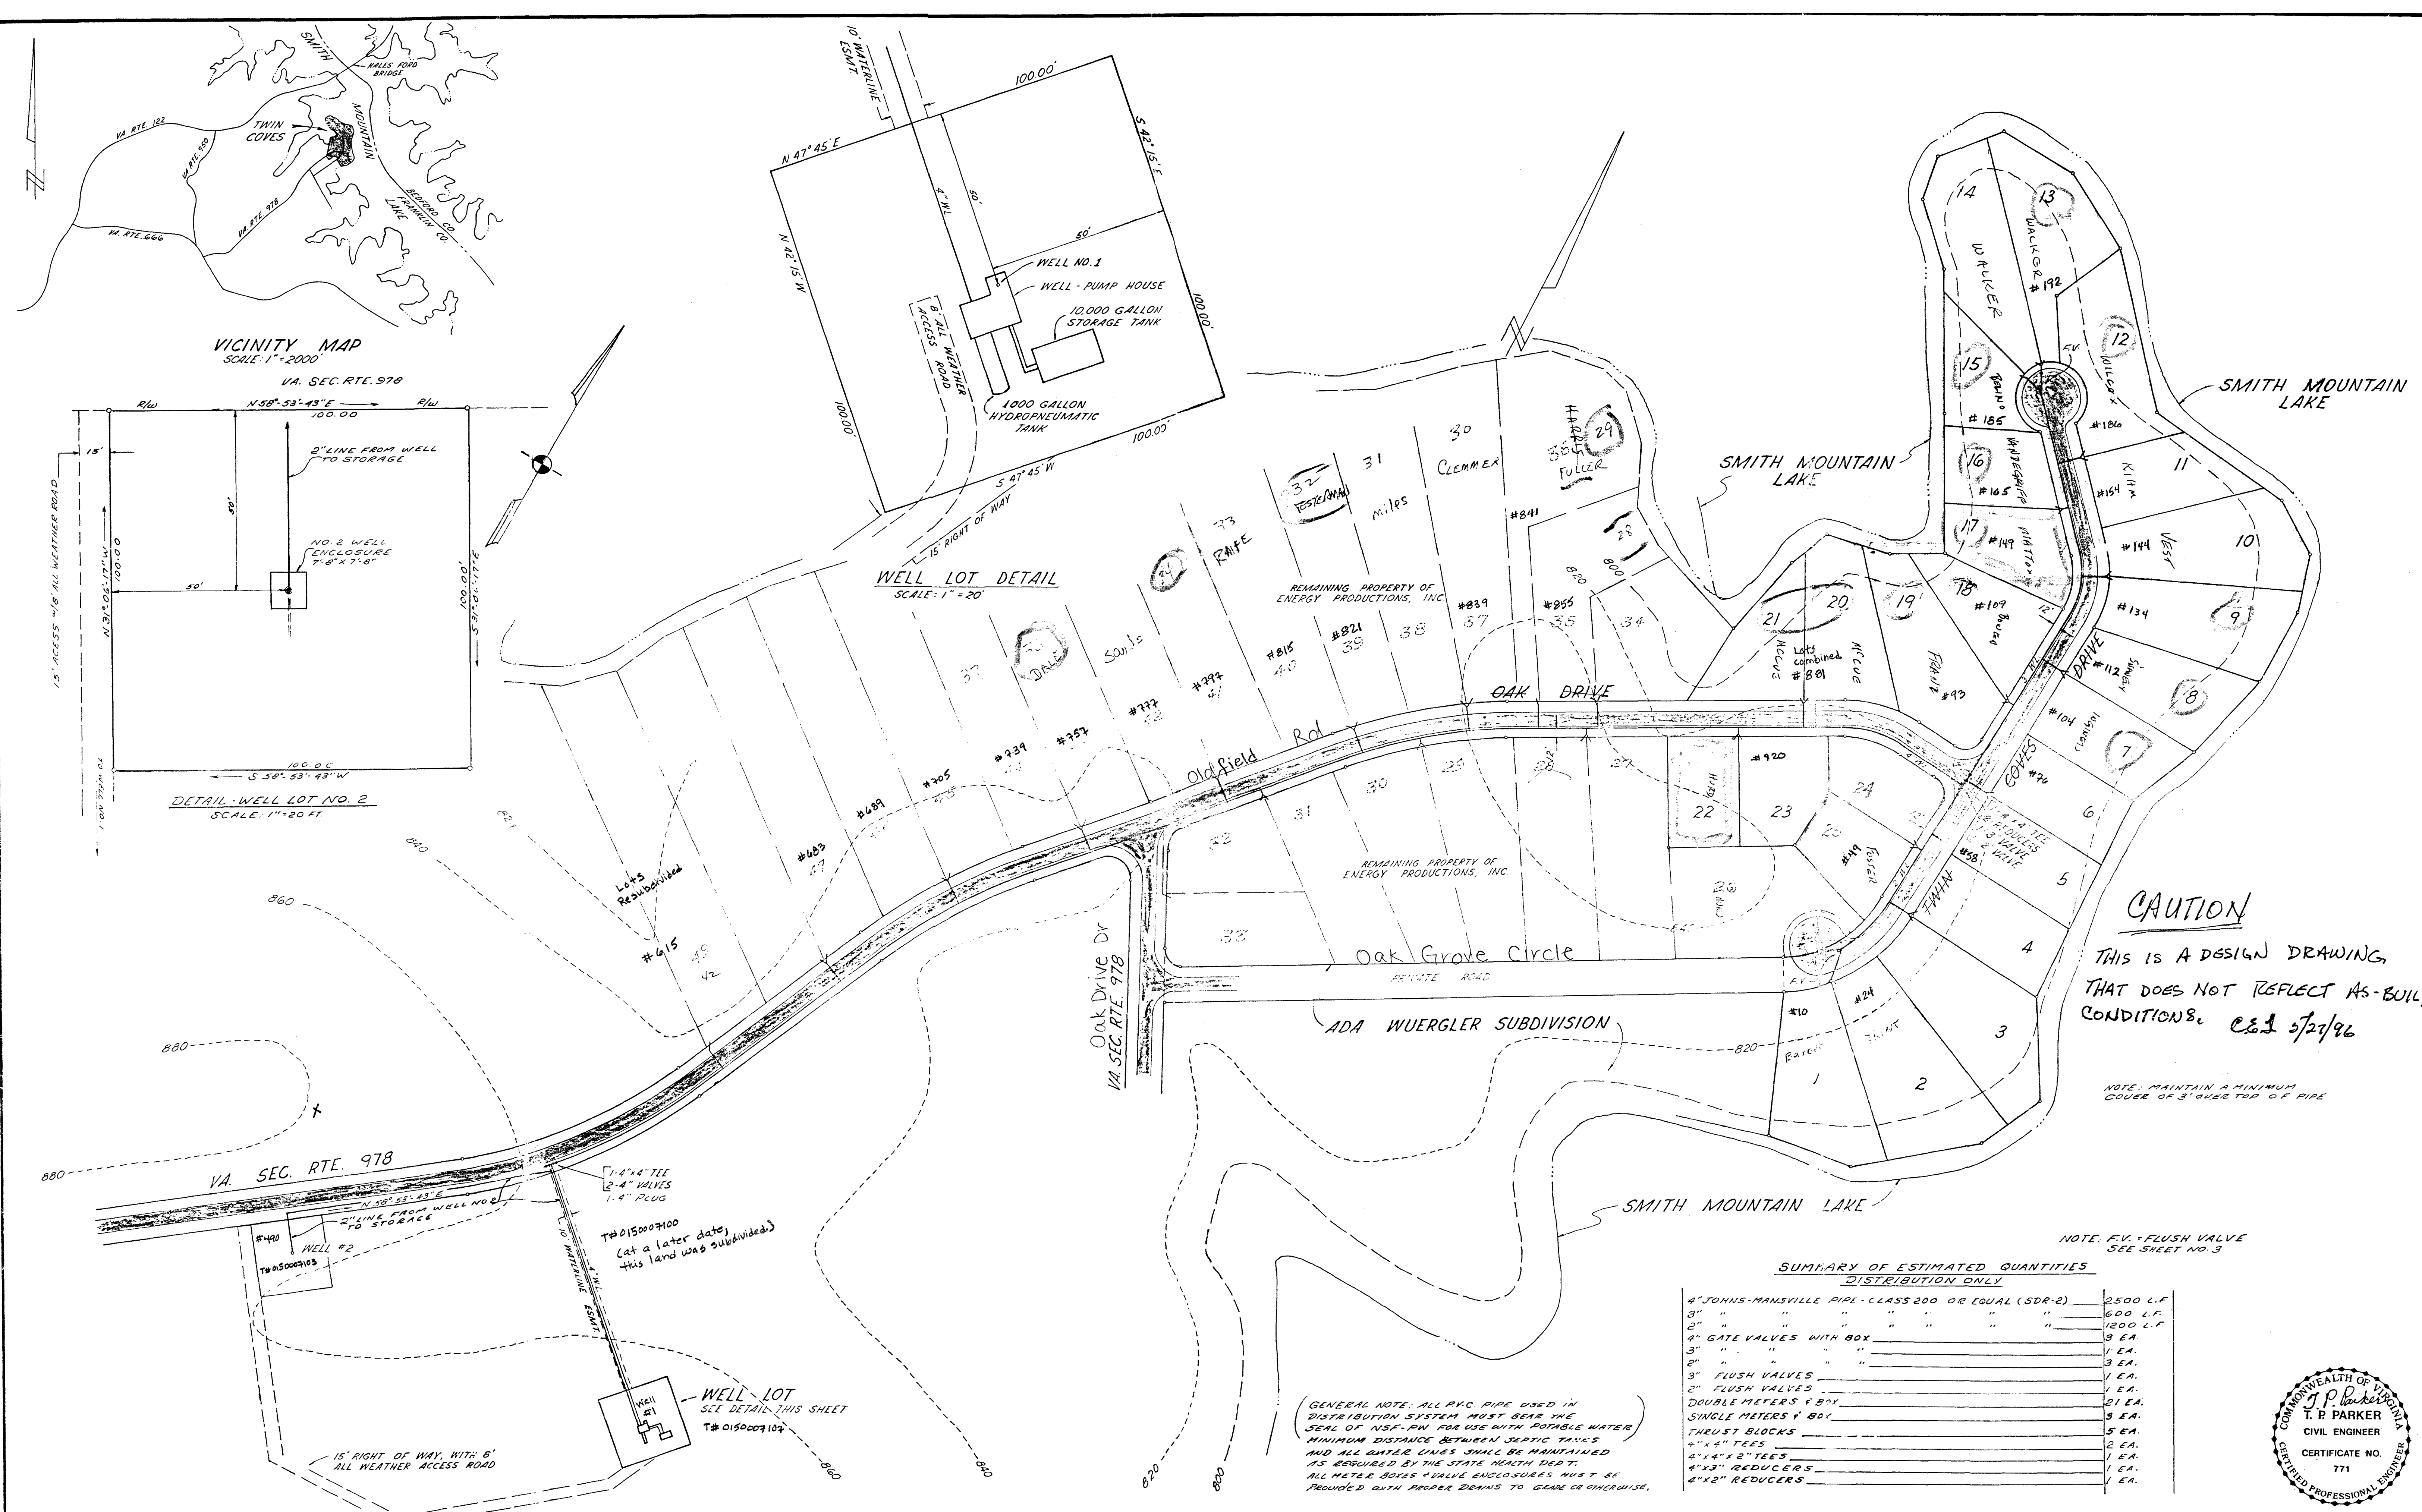

CAUTION
THIS IS A DESIGN DRAWING
THAT DOES NOT REFLECT AS-BUILT
CONDITIONS. C.E. 5/27/96

NOTE: MAINTAIN A MINIMUM
COVER OF 3' OVER TOP OF PIPE

NOTE: F.V. = FLUSH VALVE
SEE SHEET NO. 3

**SUMMARY OF ESTIMATED QUANTITIES
DISTRIBUTION ONLY**

4" JOHNS-MANSVILLE PIPE - CLASS 200 OR EQUAL (SDR-2)	2500 L.F.
8" " " " " " " " " " " "	600 L.F.
2" " " " " " " " " " " "	1200 L.F.
4" GATE VALVES WITH BOX	3 EA.
3" " " " " " " " " " " "	1 EA.
2" " " " " " " " " " " "	3 EA.
3" FLUSH VALVES	1 EA.
2" FLUSH VALVES	1 EA.
DOUBLE METERS & BOX	21 EA.
SINGLE METERS & BOX	3 EA.
THURST BLOCKS	5 EA.
4" x 4" TEES	2 EA.
4" x 2" TEES	1 EA.
4" x 3" REDUCERS	1 EA.
4" x 2" REDUCERS	1 EA.

(GENERAL NOTE: ALL PVC PIPE USED IN
DISTRIBUTION SYSTEM MUST BEAR THE
SEAL OF NSF-PW FOR USE WITH POTABLE WATER
MINIMUM DISTANCE BETWEEN SEPTIC TANKS
AND ALL GATE LINES SHALL BE MAINTAINED
AS REQUIRED BY THE STATE HEALTH DEPT.
ALL METER BOXES & VALVE ENCLOSURES MUST BE
PROTECTED WITH PROPER DRAINS TO GRADE OR OTHERWISE.

DRAWN BY:	REVISIONS		
	DATE	REMARKS	BY
CKD BY:			
APPROVED:			
DATE:			

T. P. PARKER & SON
engineers & surveyors
TELEPHONE (703) 387-1153
PO BOX 367, SALEM, VIRGINIA, 24153

**WATER SYSTEM
DISTRIBUTION LINES**

SCALE: 1" = 100'
FEBRUARY 22, 1978

SECTION ONE
TWIN COVES
FRANKLIN COUNTY, VIRGINIA
PROPERTY OF
ENERGY PRODUCTION, INC.

