



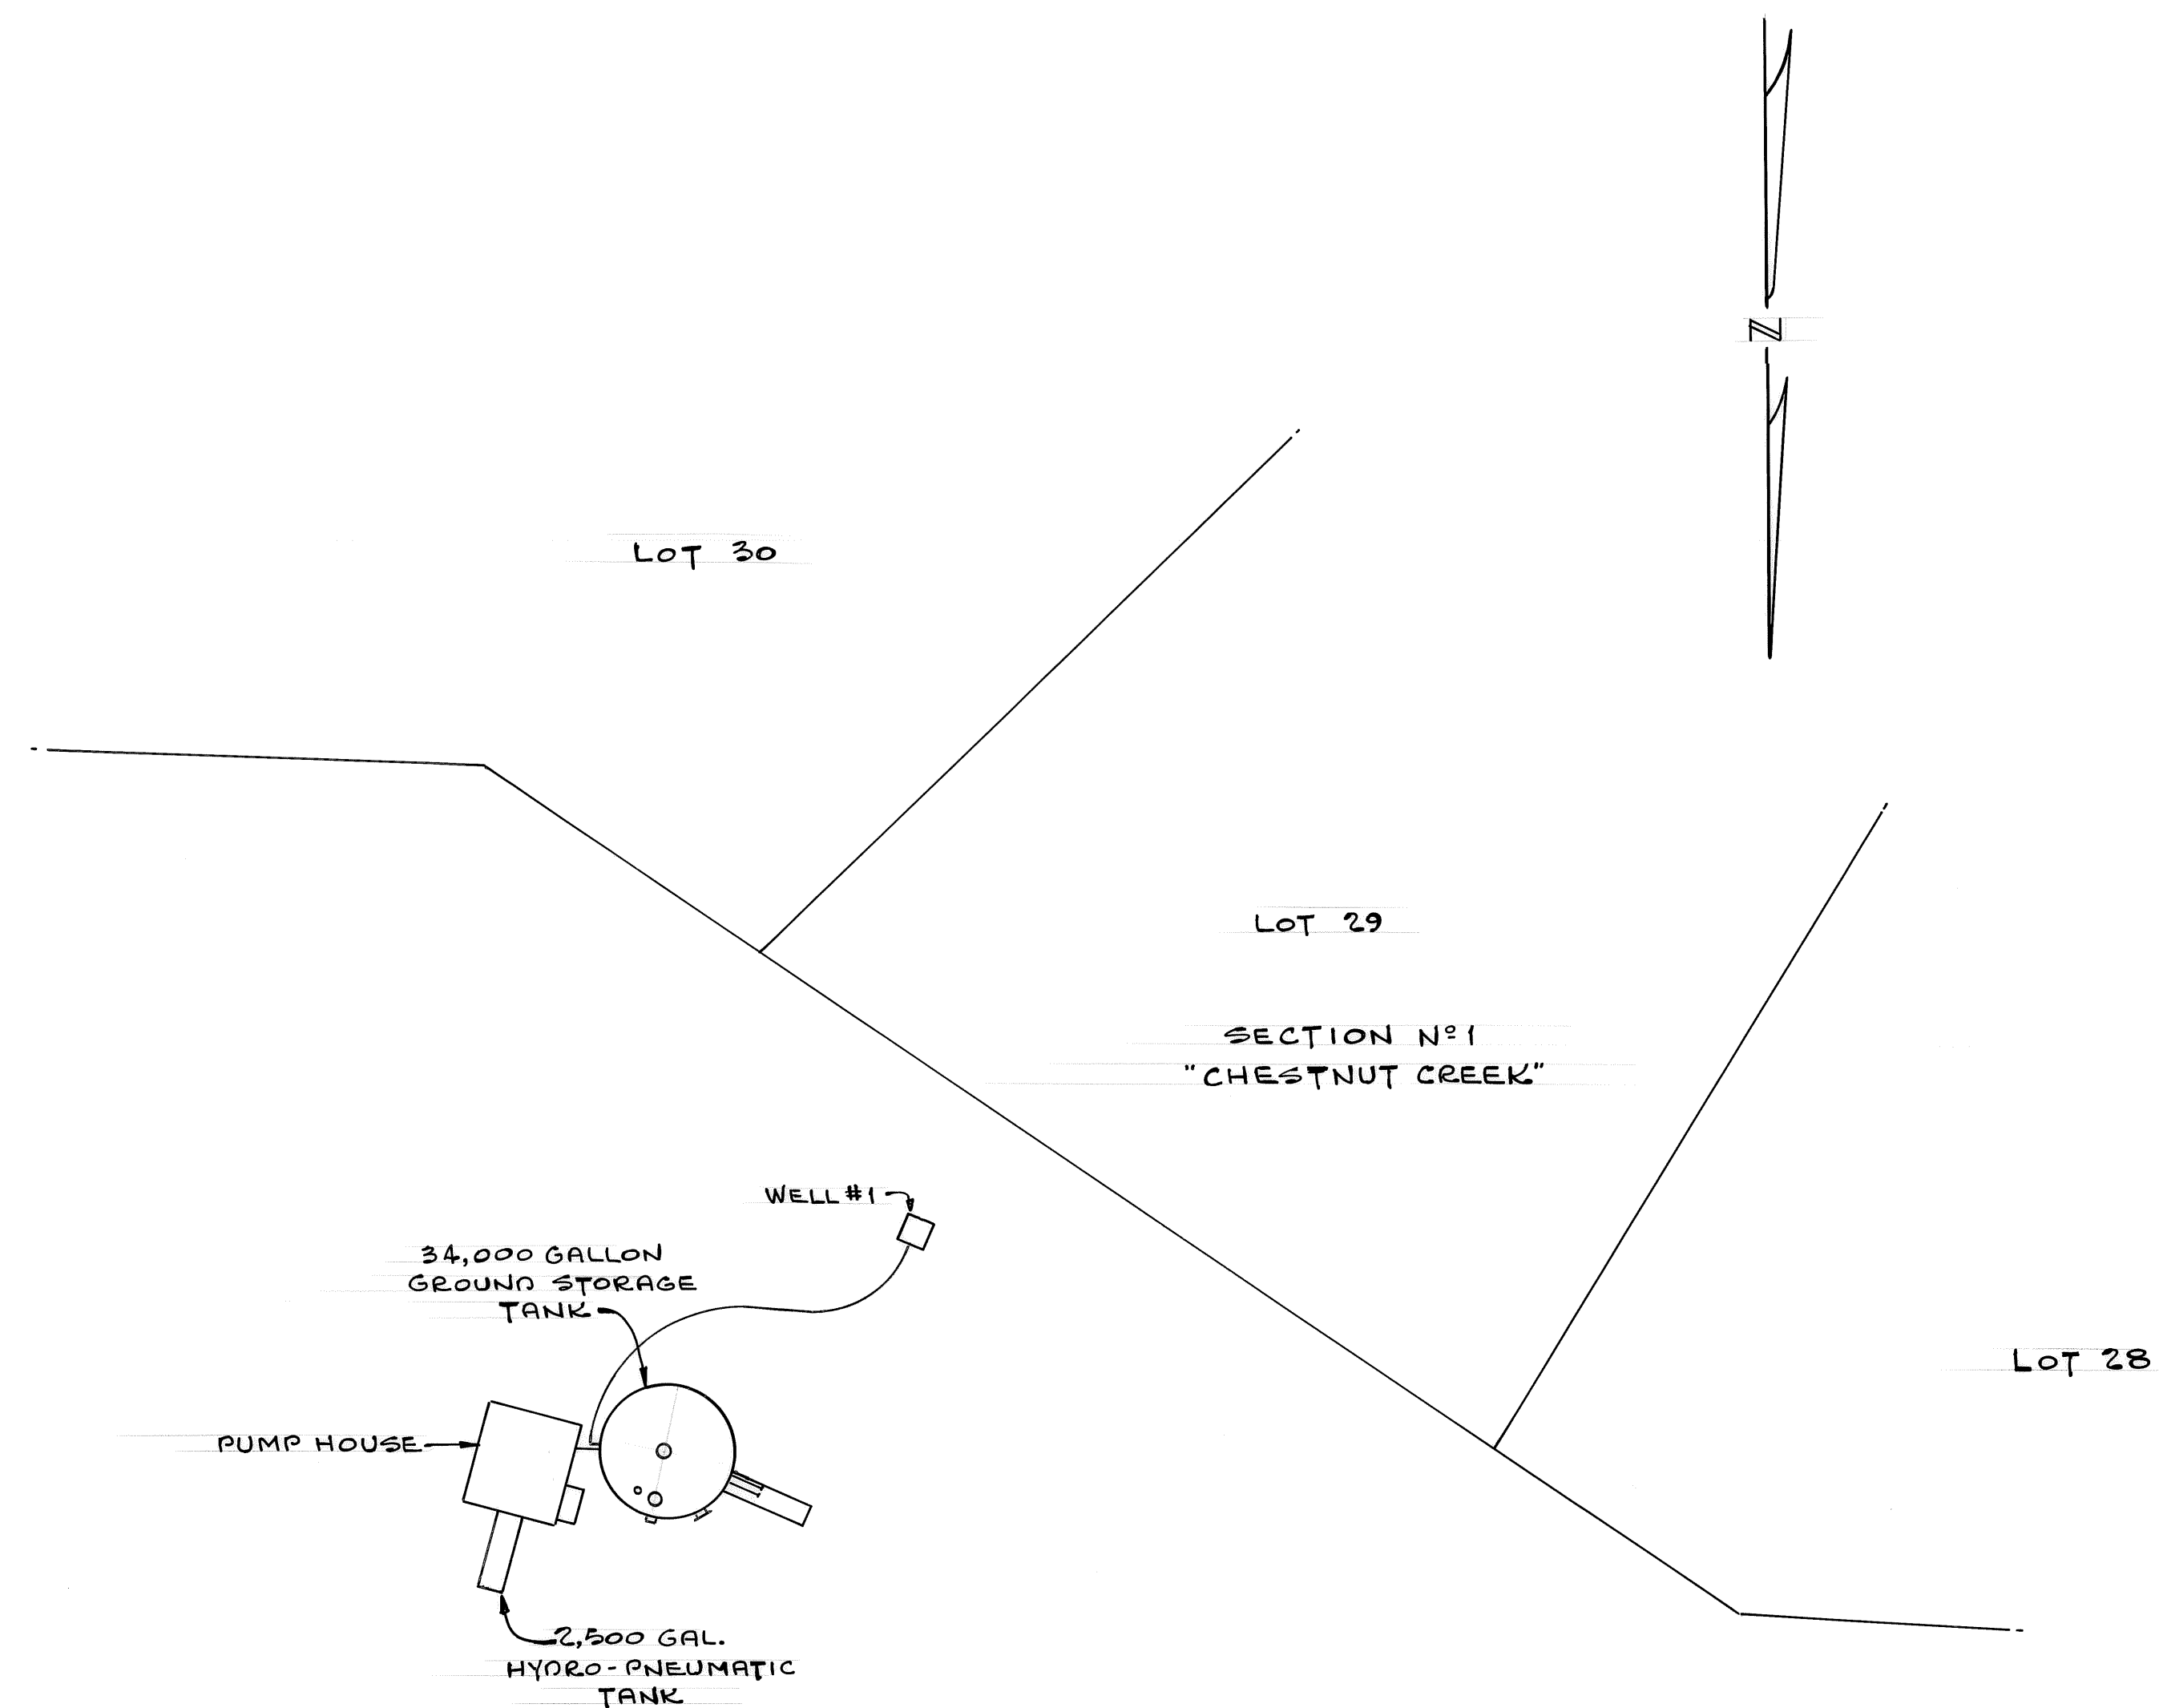


AS-BUILT SITE PLAN OF WATER FACILITIES

SCALE: 1"=30'

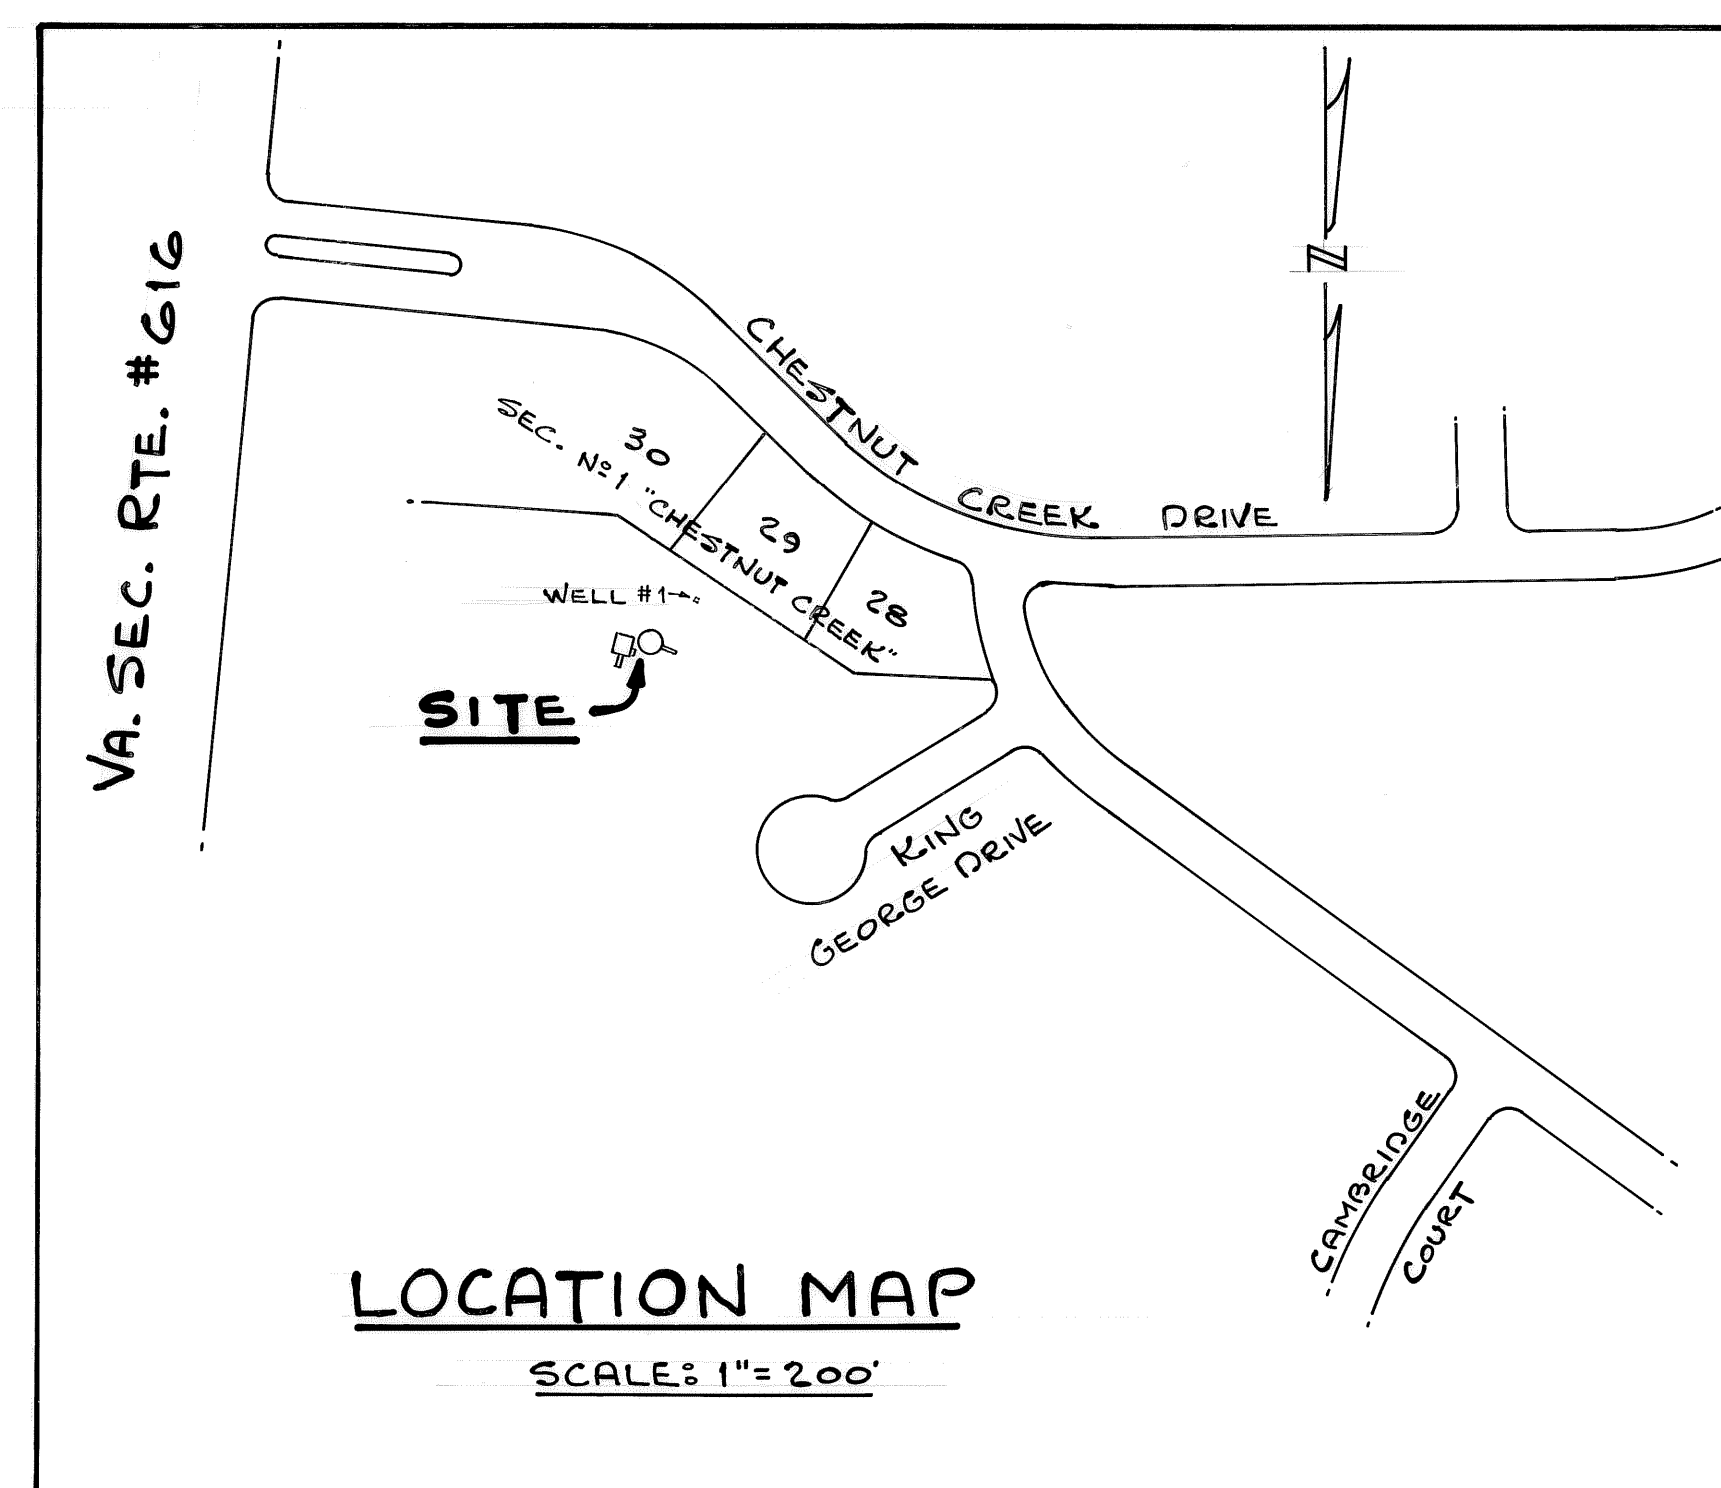


LOCATION MAP

SCALE: 1"=200'

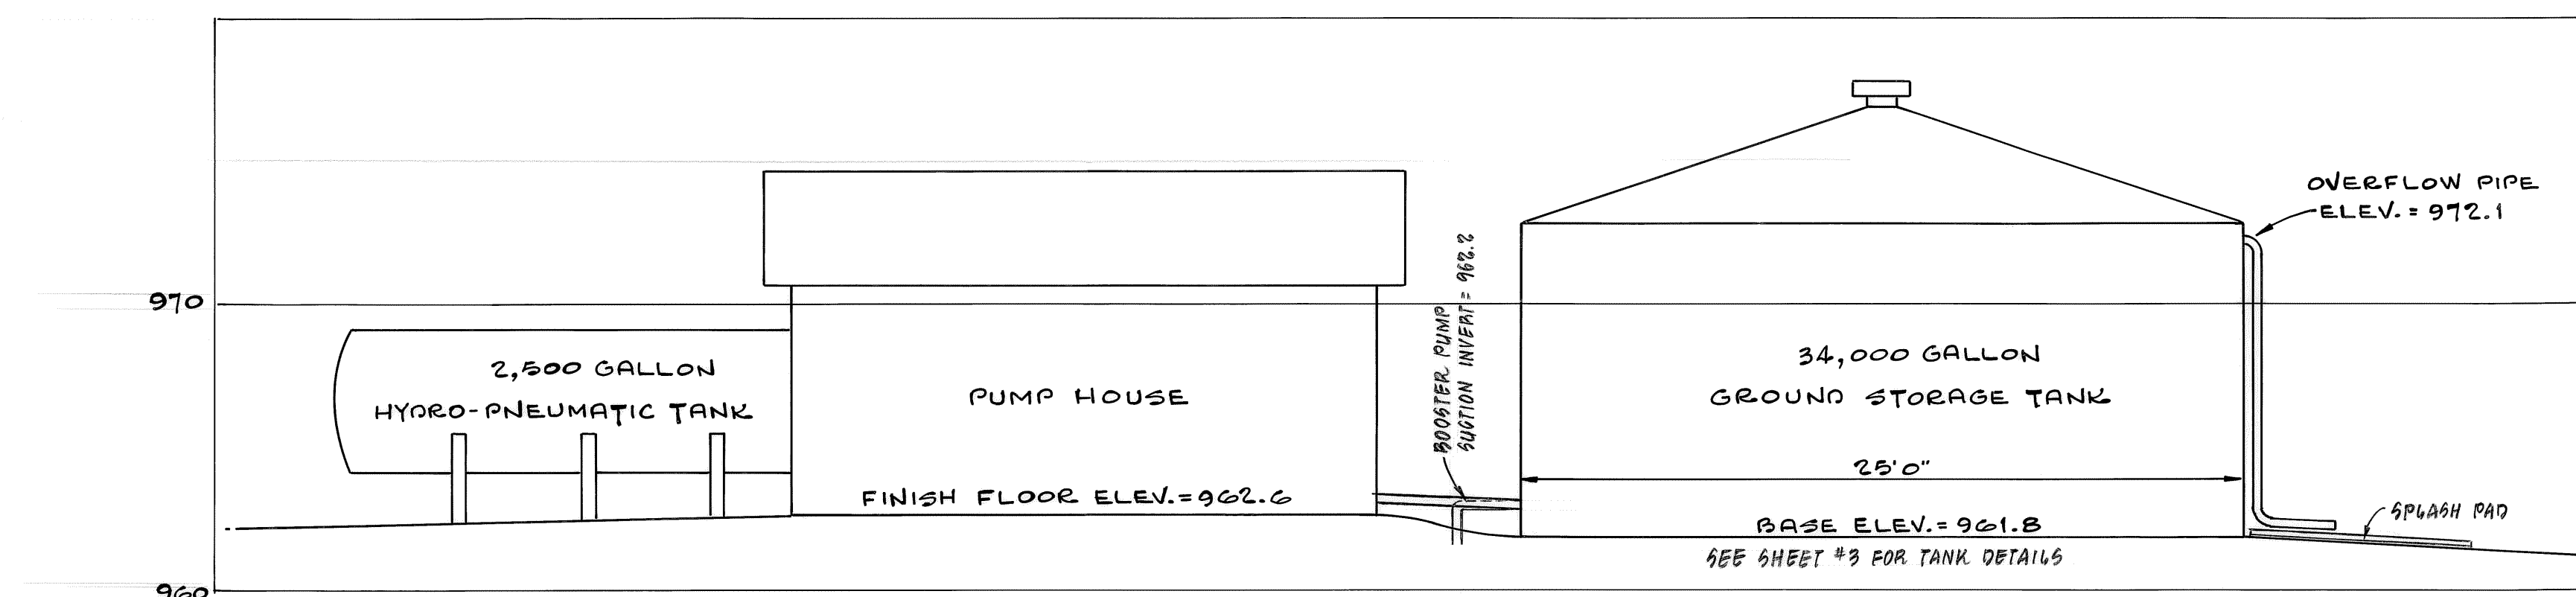

AS-BUILT PROFILE OF WATER FACILITIES

SCALE: HORIZ. ~ 1" = 5'
VERT. ~ 1" = 5'

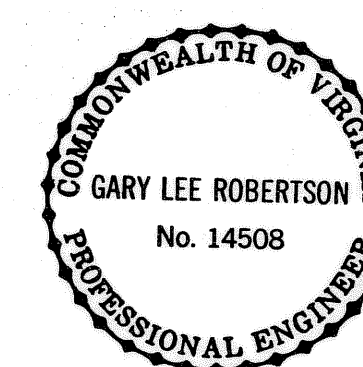

REVISION	DATE	DESCRIPTION
DESIGNED		
DRAWN	MM	
CHECKED		
"AS-BUILT WATER FACILITIES FOR STORAGE TANK & BOOSTER STATION SECTION No. 1, CHESTNUT CREEK PREPARED FOR CHESTNUT CREEK PROPERTIES, INC. FRANKLIN COUNTY, VIRGINIA		
LUMSDEN ASSOCIATES, P.C. ENGINEERS-SURVEYORS-PLANNERS ROANOKE, VIRGINIA		SCALE: AS SHOWN COMM: #27-453 DATE: 10 JAN. 1991 SHEET 2 of 2